


OAK POINT CONDOMINIUMS No. 2 *Sec. 26*

BEING LOT NO. 6 OF OAK POINT SUBDIVISION, VILLAGE OF MINSTER, AUGLAIZE COUNTY, OHIO

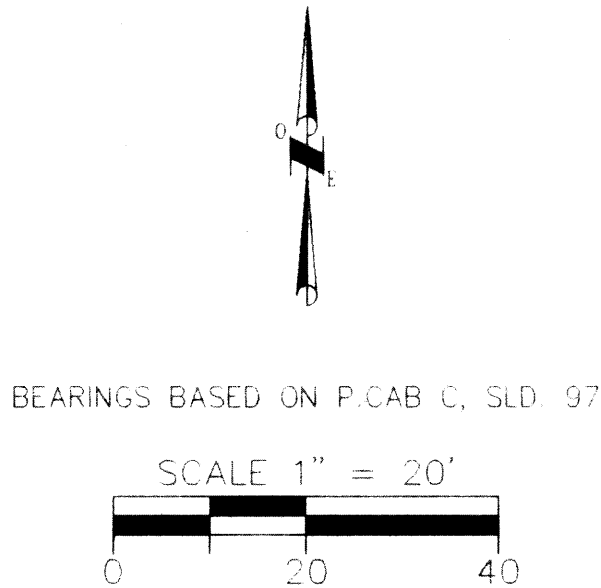


LEGEND

○ IRON PIN FOUND

ENABLING DECLARATION ESTABLISHING A PLAN FOR CONDOMINIUM OWNERSHIP RECORDED IN
___ VOL. ___, PAGE ___

BYLAWS OF OAK POINT CONDOMINIUMS ARE RECORDED IN
___ VOL. ___, PAGE ___


OWNER LOT NO. 6: JULIANA M. WEIGANDT, VOL. 160, PG. 66
OAK POINT SUBDIVISION RECORDED IN PLAT CAB. C, SLIDE 97
OAK POINT SUBDIVISION AMENDED PLAT RECORDED IN PLAT CAB. ___, SLIDE ___

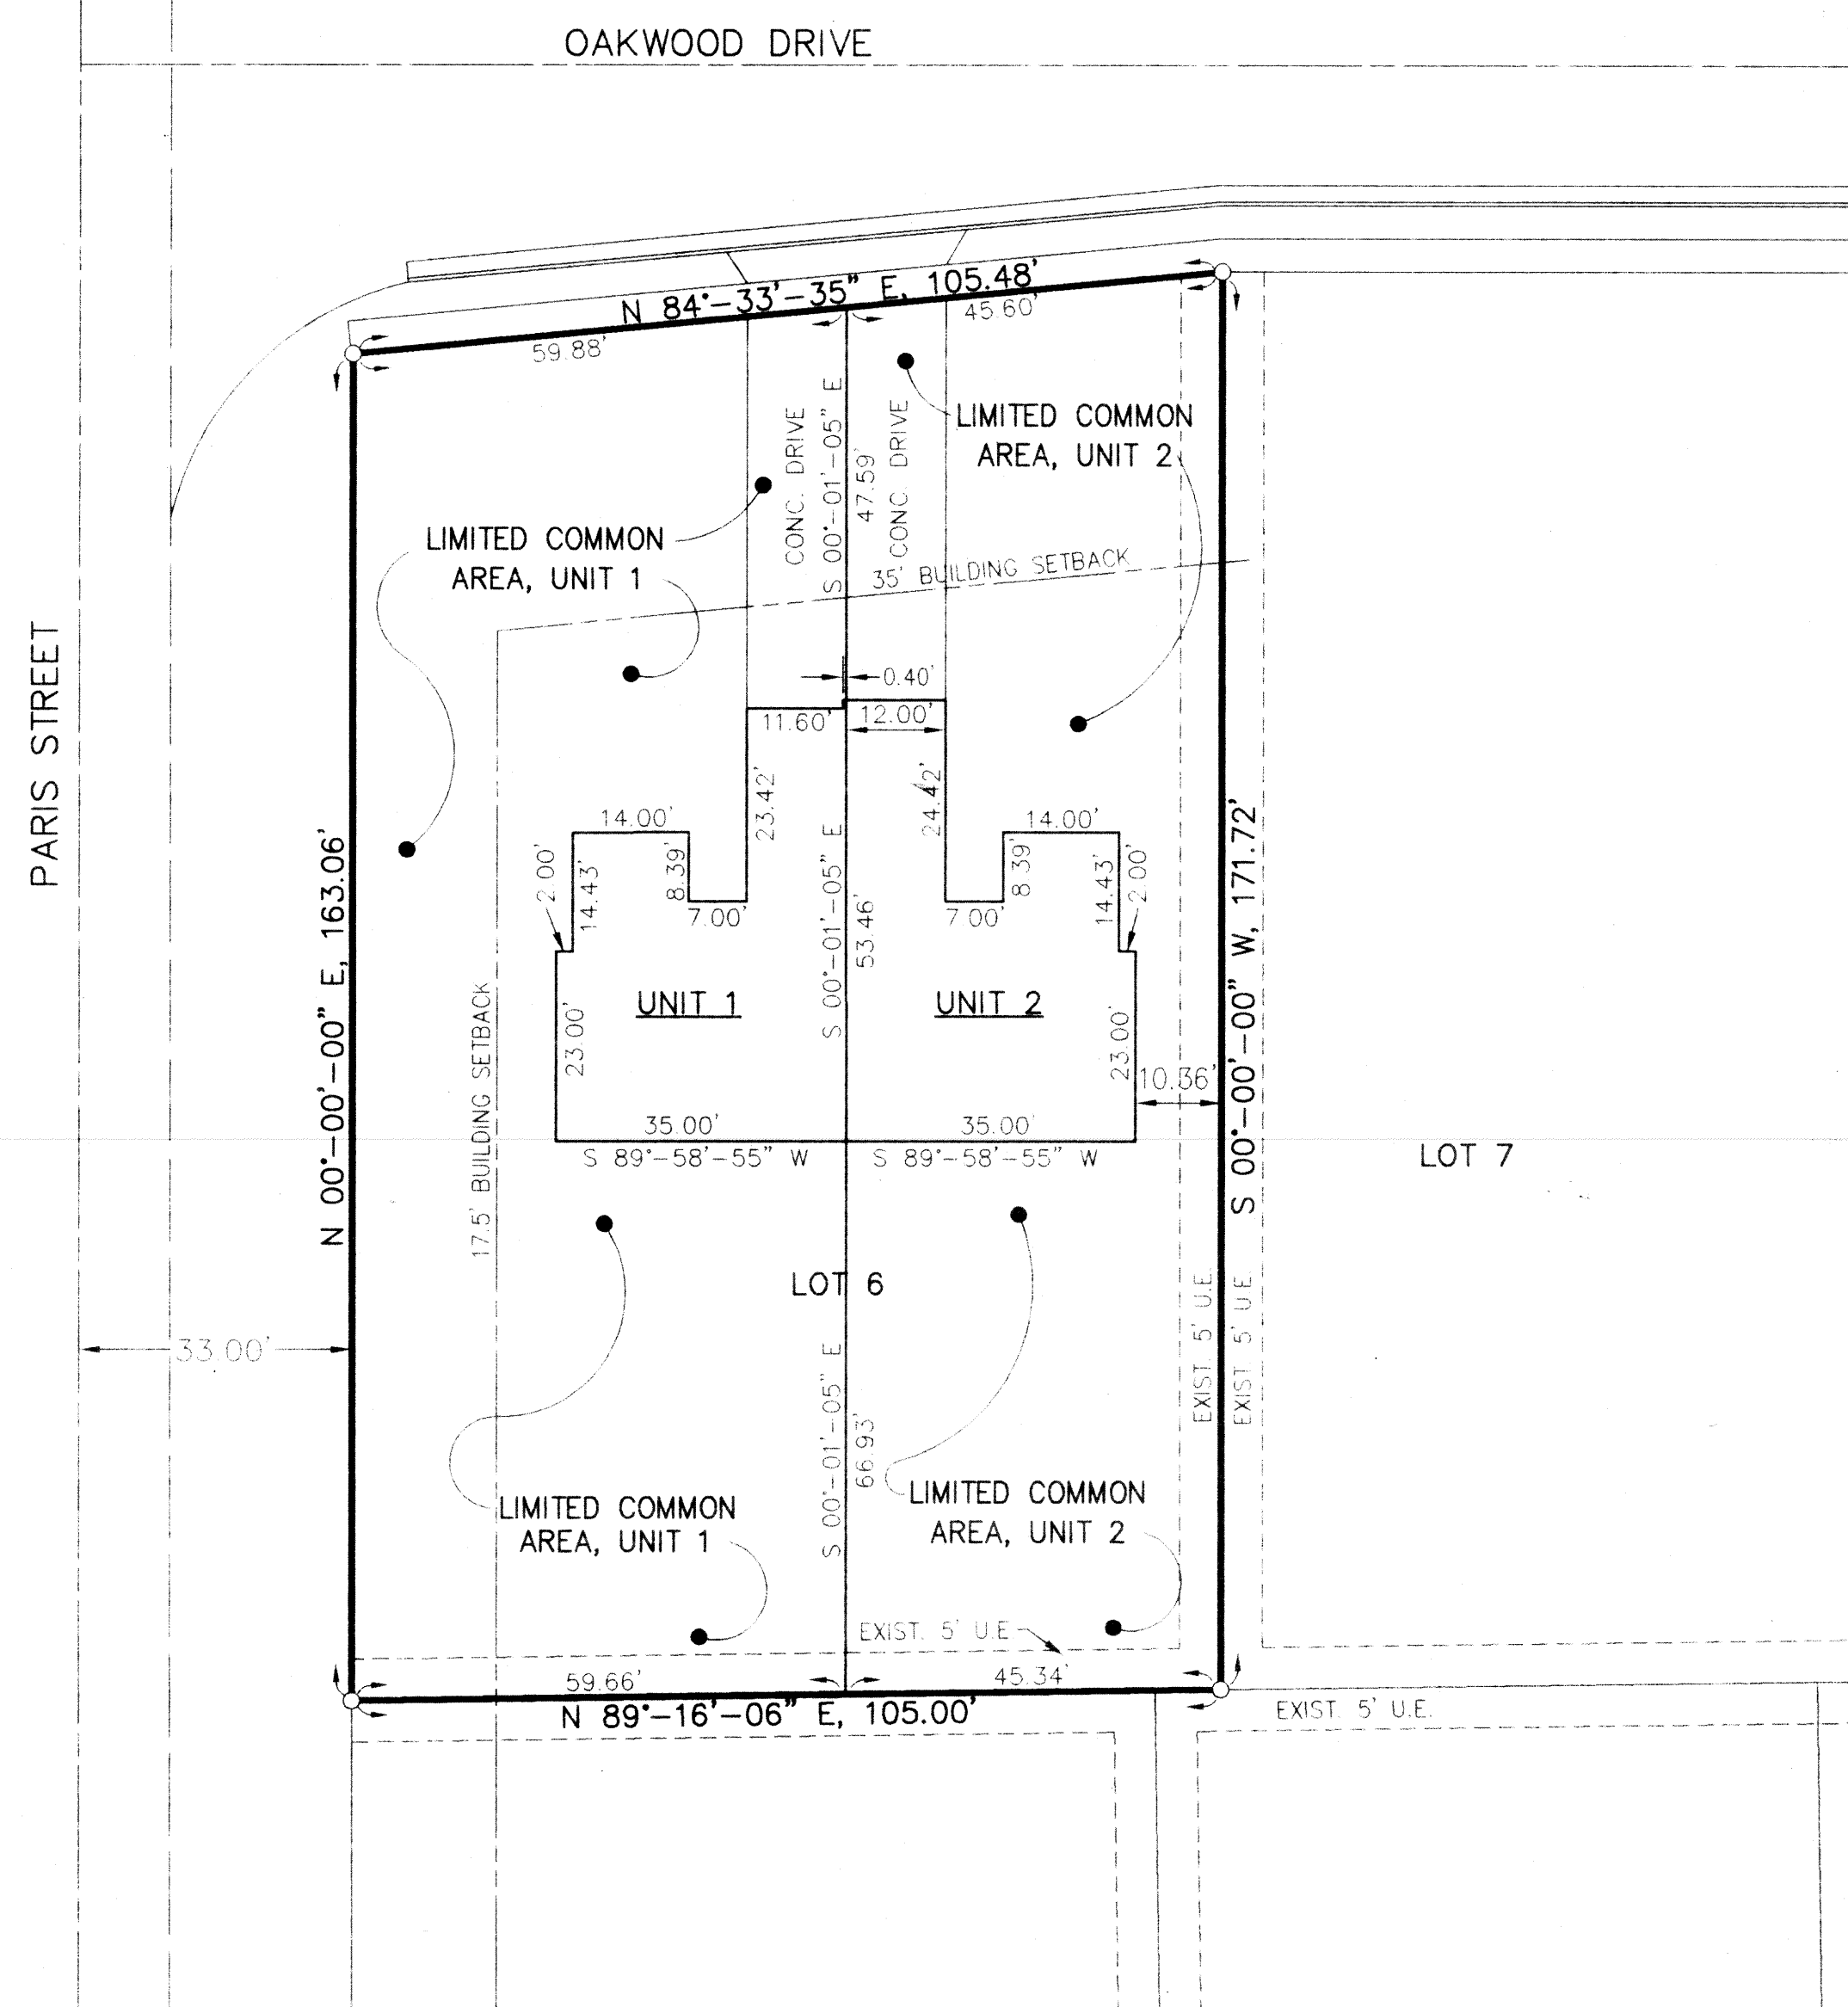

CERTIFICATION

THE DIMENSIONS SHOWN ON THE UNITS ARE FOR THE FINISHED EXTERIOR AS CONSTRUCTED UPON LOT 6 AND ARE ACCURATELY SHOWN HEREON.



Eric C. Thomas
ERIC C. THOMAS, P.E. #053924
7-31-98
DATE

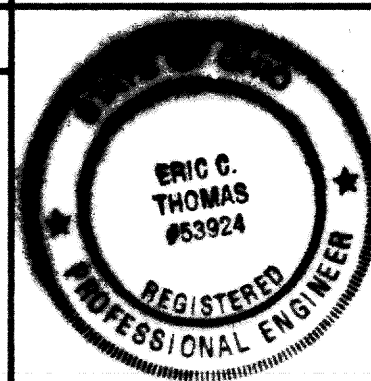

CERTIFICATION

THE DIMENSIONS SHOWN ON THE UNITS ARE FOR THE FINISHED EXTERIOR AS CONSTRUCTED UPON LOT 6 AND ARE ACCURATELY SHOWN HEREON.

Steven E. Bowersox
STEVEN E. BOWERSOX, P.S. #7059
7-28-1998
DATE

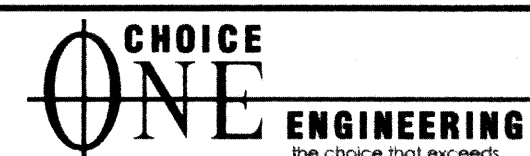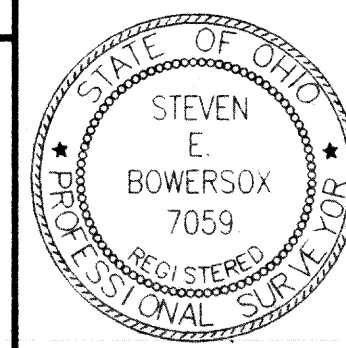

440 HOEWISHER ROAD
SIDNEY, OHIO 45365
(937) 497-0200 • FAX (937) 497-0300
www.choiceoneengineering.com

date: 07-28-98	drawn by: seb	job number: 97196
-------------------	------------------	----------------------