

AN IRON PIN WAS FOUND AT THE N.E. COR. OF SEC. 10 AS SET IN 1930's THE PORTION OF LAND AS INDICATED BY ARROWS, WAS LAID OFF & ESTABLISHED FROM THIS CORNER

DEED BOOK	Pg.
227	809
227	455
126	182
151	182
227	486

Scale:
1" = 100'

LEGEND

IRON PIN SET : ○
IRON PIN FD. : ✕
R.R. SPIKE FD. : ✕
P.K. NAIL SET. : ✕
P.K. NAIL FD. : ✕
CONC. POST. : □

SURVEY RECORDED IN
SURVEY BOOK B PAGE 343
OF THE AUGLAIZE CO. SURVEYS

THE LANDS SURVEYED AS SHOWN HEREON ARE DEFINATE AS TO THE PLACE OF BEGINNING, WHICH IS THE N.W. COR. OF LOT #1, SAID POINT BEING 150' WEST OF THE WEST R/W LINE OF MAIN STREET. AN ERROR WITHIN DEED 184, PAGE 711 EXISTS, SO SENIOR RIGHTS & CALLS WERE HONORED.

DEED BOOK 125
PAGE 179

DEED BOOK 205
PAGE 389


DEED BOOK 184
PAGE 711

N.W. COR. LOT #1


RECORD PLAT "B"
PAGE 184

RECORD PLAT "B"
PAGE 268

RECORD PLAT "B"
PAGE 260

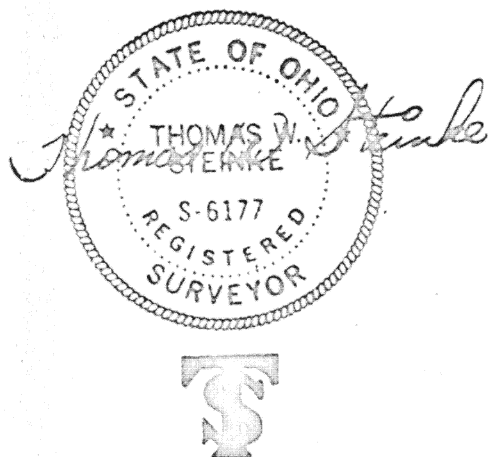

BUCKLAND - OHIO
AUGLAIZE COUNTY

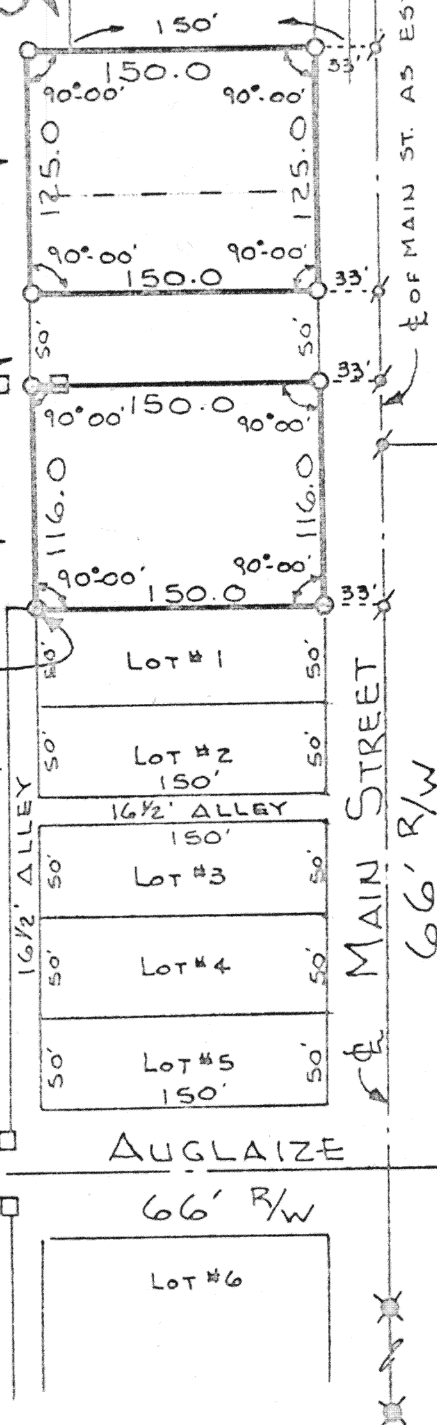

HIGH STREET
66' R/W

RECORD PLAT "B"
PAGE 226

AUGLAIZE STREET
66' R/W

Signature by a representative of the County Engineer's Dept. denotes that this plat meets tax map plat requirements.
Signed: _____ Date: _____

Signature by a (representative of the) County Commissioner(s) denotes approval of this plat.
Signed: _____ Date: _____

Signature by a representative of the County Health Dept. denotes compliance with Health Regulations.
Signed: _____ Date: _____

Signature by a representative of the Auglaize County Regional Planning Commission denotes approval of this plat.
Signed: _____ Date: _____

Thomas W. Stinke
LAND SURVEYING
WAPAKONETA & BOTKINS, OHIO

Client BUCKLAND CHRISTIAN CHURCH
County AUGLAIZE Twp. LOGAN Sec. 10
Drawn by JES Scale 1" = 100' Drwg. No. 76-198
Checked by JES Date SEPT 1976
Sheet 1 of 1

343

(T 343 R 3 E)