


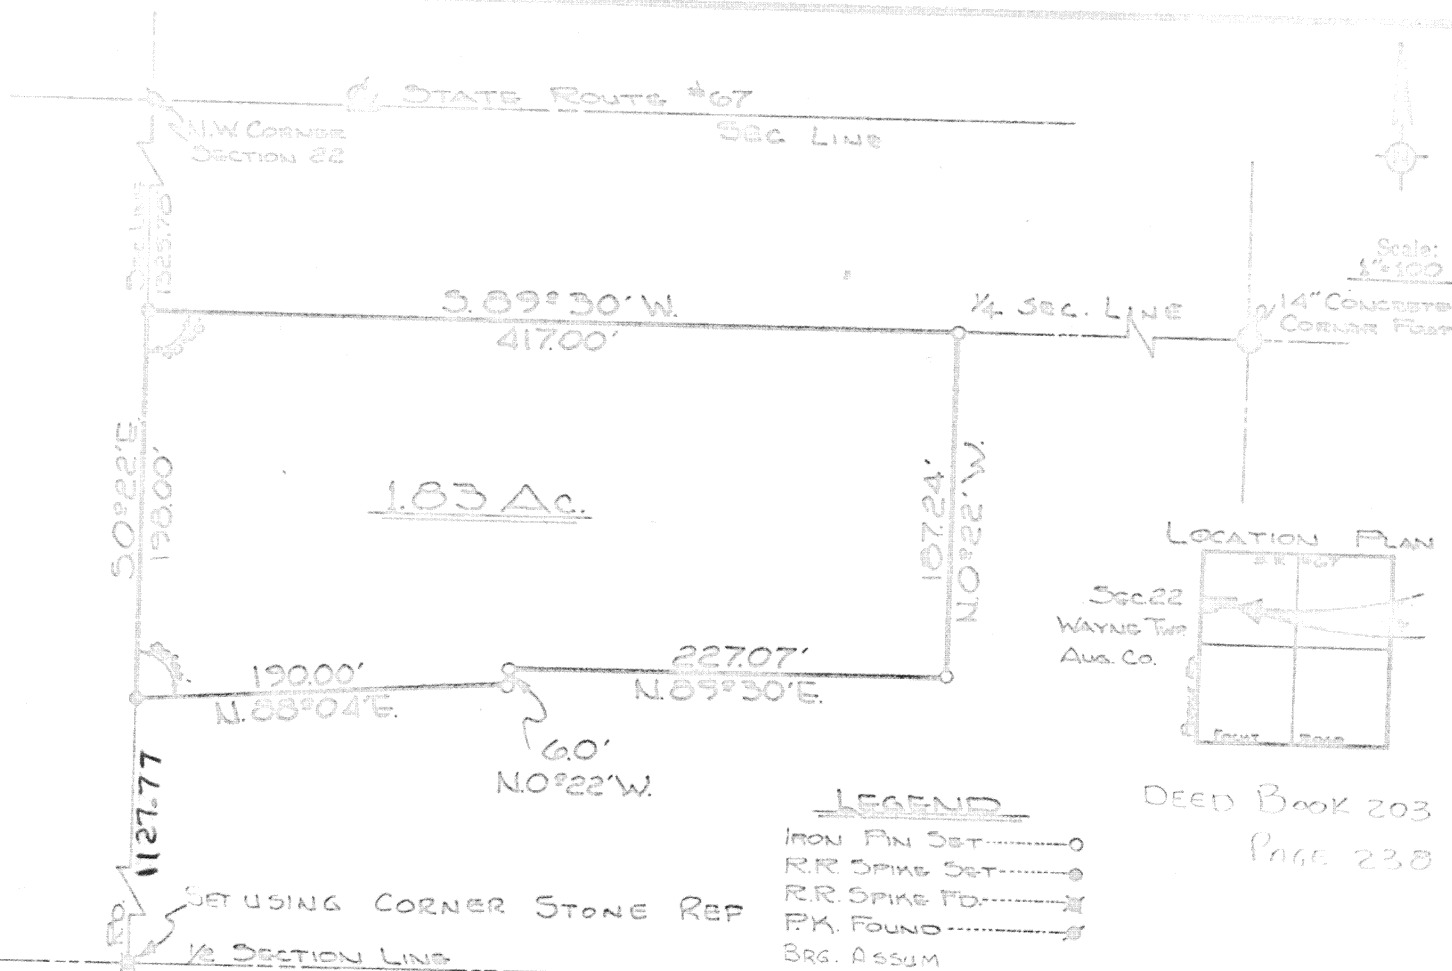

Being 1.83 Acres located in the North-West quarter of Section 22, T-5-S, R-6-E, Wayne Township, Auglaize County, Ohio and being further described as follows: Commencing at P.K. nail at the center line intersection of State Route # 67 and Pepple Road T.R. # 281 also being the North-West corner of Section 22. Thence South 00° 22' East, with the center of T.R. # 281 and the west line of Section 22, a distance of 1225.78 feet to a railroad spike and PLACE OF BEGINNING. Thence South 00° 22' East, a distance of 198.00 feet to a railroad spike. Thence North 88° 04' East, a distance of 190.00 feet to an iron pin. Thence North 00° 22' West, a distance of 6.00 feet to an iron pin. Thence North 89° 30' East, a distance of 227.07 feet to an iron pin. Thence North 00° 22' West, a distance of 187.24 feet to an iron pin. Thence South 89° 30' West, a distance of 417.00 feet to a railroad spike and PLACE OF BEGINNING. Containing in 1.83 Acres and being subject to all legal easements and R/W of record Survey recorded in Survey Book B Page 347 of the Auglaize County Survey Records

Survey and description prepared by Thomas W. Steinke Reg. Surveyor # 6177

Signature by a representative of the County Engineer's Dept. denotes that this plat meets tax map plat requirements.
Signed: _____ Date _____

Signature by a (representative of the) County Commissioner(s) denotes approval of this plat.
Signed: _____ Date _____

Signature by a representative of the County Health Dept. denotes compliance with Health Regulations.
Signed: _____ Date _____

Signature by a representative of the Auglaize County Regional Planning Commission denotes approval of this plat.
Signed: _____ Date _____

Thomas W. Steinke
LAND SURVEYING
AUGLAIZE & BUTLER CO., OHIO

Client JOHN CRANE
County AUGLAIZE Twp. WAYNE Sec. 22
Drawn by JOHN J. Scale 1"=100' Drwg. No. 70-016
Checked by JS Date SEPT. 1970
Sheet 1 of 1

347

347