




Thomas W. Steinke & Assoc. Inc.
 LAND SURVEYORS - LAND CONSULTANTS
 123 W. AUGLAIZE ST. - WAPAKONETA, OHIO

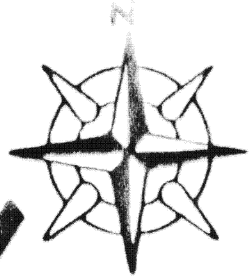

B. ENGLE SURVEY

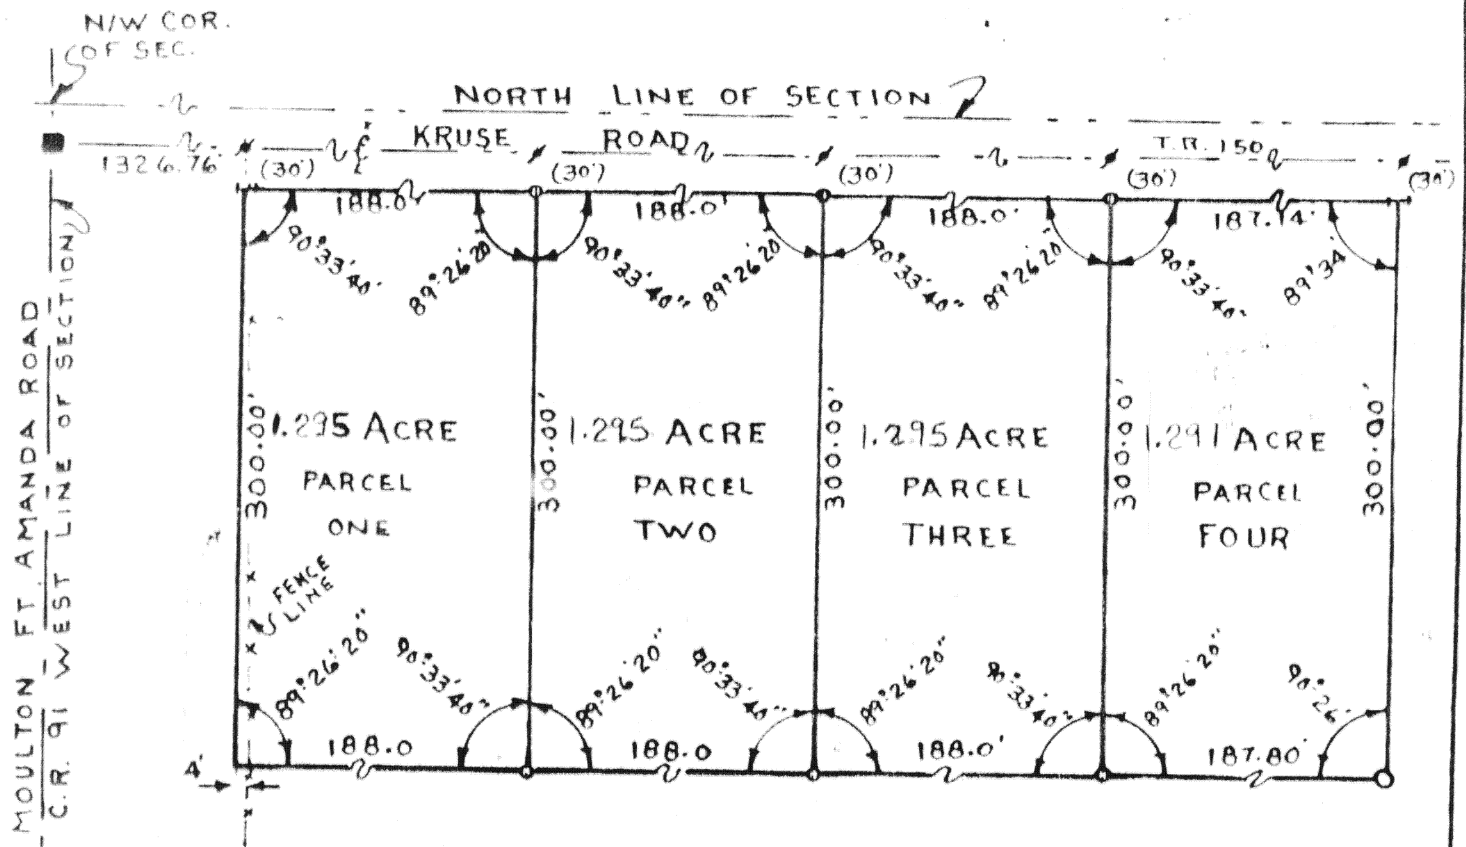

LOCATION

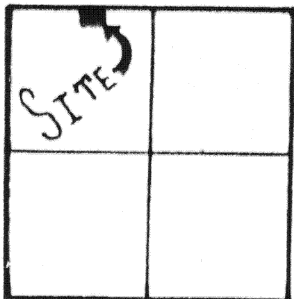

MOULTON TWP.
 SECTION 33
 T-5-S-R-5-E
 AUGLAIZE Co.O.

LEGEND

- ✱ P.K. NAIL
- IRON PIPE
- MONUMENT BOX
- I-BEAM

File No 80-965

This survey is recorded in Book E Page 263 of the Auglaize Co. Engs. Office

TOWN 5 SOUTH RANGE 5 EAST SCALE: 1" = 100'

AUGLAIZE COUNTY HEALTH DEPT.

AUGLAIZE COUNTY PLANNING COMM.

signature _____ date _____

signature _____ date _____

JURISDICTION 3 MILE LIMIT OR TOWNSHIP

AUGLAIZE COUNTY ENGINEER

signature _____ date _____

signature _____ date _____

CLIENT: BOB ENGLE

DATE: MAY 21, 1980

COUNTY: AUGLAIZE TOWNSHIP: MOULTON SECTION: 33

THOMAS W. STEINKE & ASSOC., INC.
LAND SURVEYING LAND DEVELOPMENT
123 W. AUGLAIZE ST. - WAPAKONETA, OHIO 45895
PHONE: 419-738-7421

DESCRIPTION OF 1.295 ACRES Parcel ~~ONE~~ ³³

Being 1.295 Acres located in the west half of Section ~~seventeen~~ ³³ Moulton Township T-5-S--R-6-E Auglaize County Ohio and being further described as follows.

Beginning at the north/west corner of Section ~~seventeen~~ ³³, said corner also being on the west line of said section and the centerline of Moulton Port Amanda Road (C-R 91) .

Thence in a southerly direction along said west line of section and said centerline a distance of 30.00 feet to a Auglaize County Monument Box, said Monument Box being located at the intersection of Kruse Road (150) and Moulton Port Amanda Road (C-R 91) .

Thence in a easterly direction with the centerline of Kruse Road (T-R 150) and parallel to the north line of section ~~seventeen~~ ³³ a distance of 1514.76 to a I.K. Nail.

Thence in a southerly direction with an angle to the left of 89° 20' 20" a distance of 30.0 feet to a iron pipe and the PLACE OF BEGINNING for the parcel of land herein described.

Thence continuing in a southerly direction with last described course a distance of 300.00 feet to a iron pipe.

Thence in a westerly direction with an interior angle of 90° 33' 40" a distance of 188.0 feet to a iron pipe.

Thence in a northerly direction with an interior angle of 89° 20' 20" a distance of 300.00 feet to a iron pipe.

Thence in a easterly direction with an interior angle of 90° 33' 40" a distance of 188.0 feet to a iron pipe which is the PLACE OF BEGINNING .

Containing in all 1.295 Acres and being subject to any and all easements and Right-of-Way of record.

This survey is recorded in Book **E** Page **263** of the Auglaize Co. Gen. Office

Survey and description prepared by Thomas W. Steinke and Assoc. Inc.

123 West Auglaize Street Wapakoneta Ohio this 21st day of May 1950.



THOMAS W. STEINKE & ASSOC., INC.
LAND SURVEYING LAND DEVELOPMENT
123 W. AUGLAIZE ST. - WAPAKONETA, OHIO 45895
PHONE: 419-738-7421

DESCRIPTION OF 1.225 ACRES Parcel Three

being 1.225 Acres located in the west half of Section ~~seventeen~~ ³³ Moulton Township T-5-S--R-5-E Auglaize County Ohio and being further described as follows.

Commencing at the north/west corner of Section ~~seventeen~~ ³³, said corner also being the the west line of said section and the centerline of Moulton Fort Amanda Road (C-R 91) .

Thence in a southerly direction along said west line of section and said centerline a distance of 30.00 feet to a Auglaize County Monument Box, said Monument Box being located at the intersection of Kruse Road (150) and Moulton Fort Amanda Road (C-R 91) .

Thence in a easterly direction with the centerline of Kruse Road (T-R 150) and parallel to the north line of section ~~seventeen~~ ³³ a distance of 1890.76 feet to a P.K. Nail.

Thence in a southerly direction with an angle to the left of $89^{\circ}26'20''$ a distance of 30.0 feet to a iron pipe and the PLACE OF BEGINNING for the parcel herein described.

Thence continuing in a southerly direction with last described course a distance of 300.00 feet to a iron pipe.

Thence in a westerly direction with an interior angle of $90^{\circ}33'40''$ a distance of 188.0 feet to a iron pipe.

Thence in a northerly direction with an interior angle of $89^{\circ}26'20''$ a distance of 300.00 feet to a iron pipe.

Thence in a easterly direction with an interior angle of $90^{\circ}33'40''$ a distance of 188.0 feet to a iron pipe, which is the PLACE OF BEGINNING.

Containing in all 1.225 Acres and being subject to any and all easements and Right-of-Way of record.

This survey is recorded in Book E Page 243 of the Auglaize Co, Engs. Office.

Survey and description prepared by Thomas W. Steinke and Assoc. Inc.

123 West Auglaize Street Wapakoneta Ohio this 21st day of May 1980.