

SURVEY FOR: FRANCIS BROWN


SECTION 24 TOWN 6-S RANGE 5-E

WASHINGTON TOWNSHIP


AUGLAIZE COUNTY

DEED BOOK ~~232~~

PAGE ~~837~~

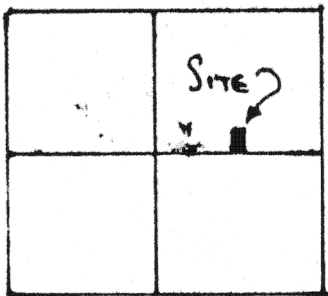

SECTION 24

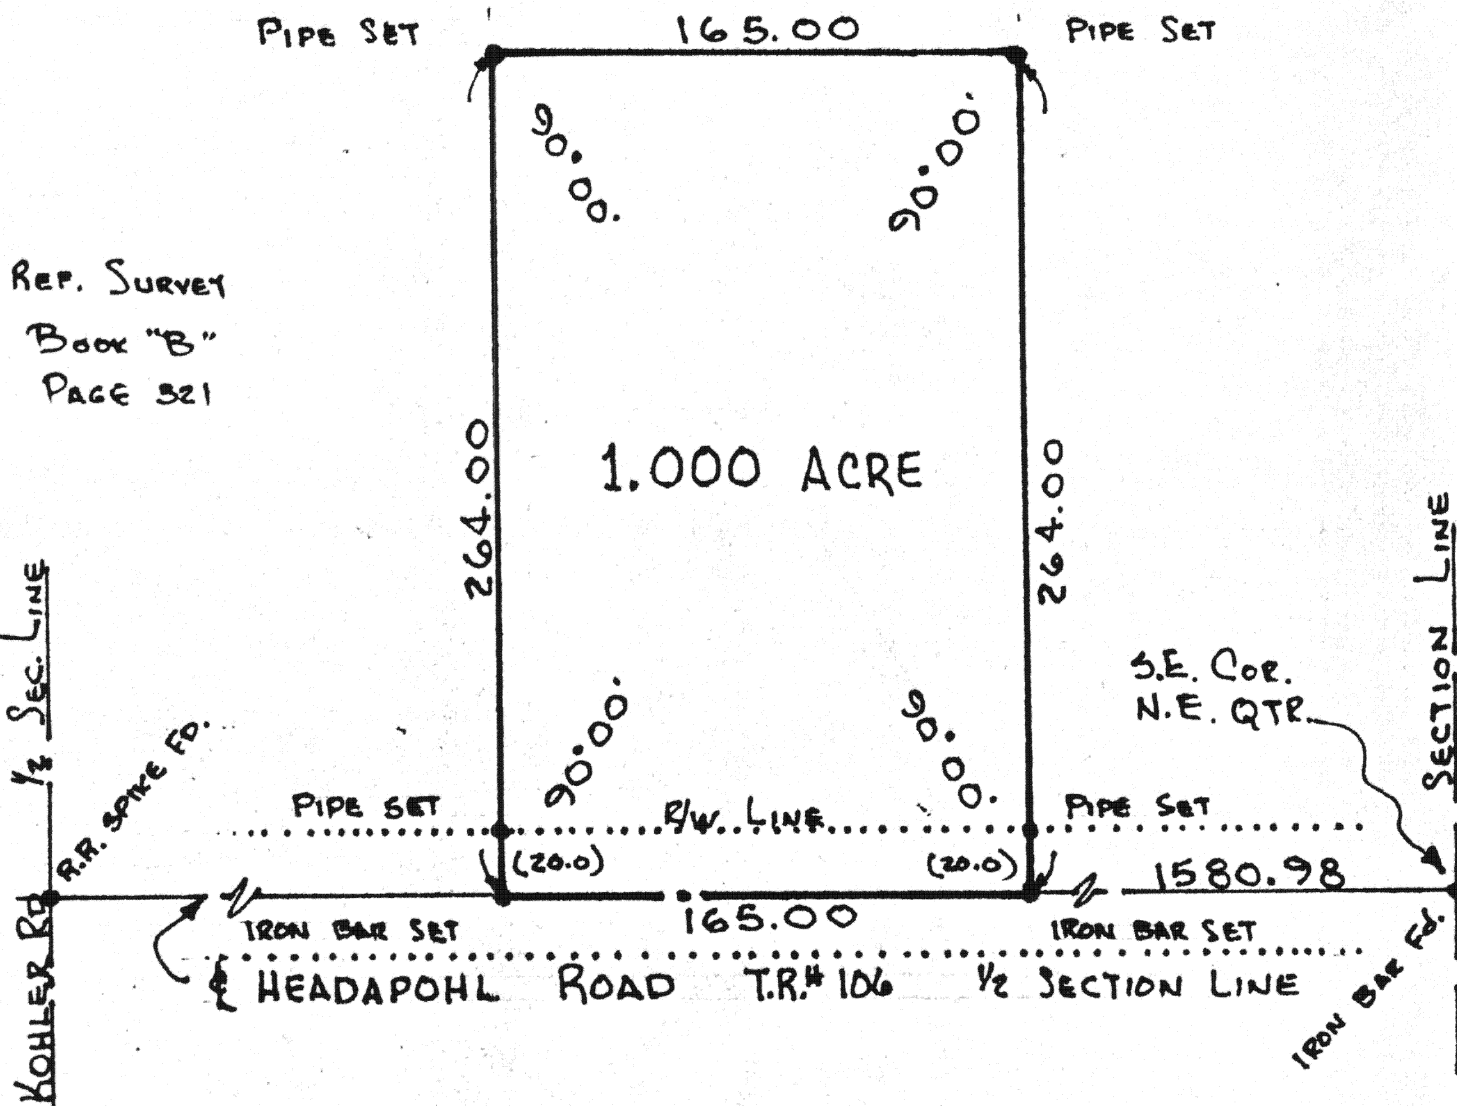

THIS SURVEY RECORDED IN SURVEY BOOK ~~F~~ PAGE ~~240~~

Date: MAY 13, 1982

Scale: 1" = 60'

File No.: 82-1200

Prepared By:
Thomas W. Steinke & Assoc.
Land Surveyors

16454 CR 25-A
Botkins O 45306

Ph (513) 693-4819

Thomas W. Steinke

240

240

THOMAS W. STEINKE & ASSOC.
LAND SURVEYORS
LAND CONSULTANTS



Francis Brown
Section 24
Washington Township
Auglaize County
82-1200

Being 1.000 Acre located in the north-east quarter of Section 24, Town 6-S, Range 5-E, Washington Township, Auglaize County, Ohio and being further described as follows:

Commencing at the south-east corner of the north-east quarter of Section 24, said point being marked by an iron bar.

Thence west along the center line of Headapohl Road, T.R.# 106, and the east-west half section line of Section 24, a distance of 1580.98 feet to an iron bar and the PLACE OF BEGINNING for the parcel herein described.

Thence continuing west with said center line and section line, a distance of 165.00 feet to an iron bar.

Thence north with an interior angle to this parcel of $90^{\circ} 00'$, a distance of 264.00 feet to an iron pipe, passing through an iron pipe at 20 ft.

Thence east with an interior angle to this parcel of $90^{\circ} 00'$, a distance of 165.00 feet to an iron pipe.

Thence south with an interior angle to this parcel of $90^{\circ} 00'$, a distance of 264.00 feet to an iron bar in the center line of T.R.# 106 and the PLACE OF BEGINNING, passing through an iron pipe at 244.0 feet.

Containing in all 1.000 Acre and being subject to all legal easements and rights-of-way of record.

Survey and description prepared by Thomas W. Steinke, Registered Surveyor # 6177, this 13th day of May, 1982 and recorded in Survey Book F Page 240 of the Auglaize County Engineer's Office.

P.O. BOX 14 BOTKINS, OHIO
PHONE: (513) 693-4819

P.O. BOX 366 WAPAKONETA, OHIO