

Scale:

1"=100'


LEGEND

✱ Iron Pin Fd.

● Iron Pin Set

▲ Railroad Spike Fd.

SECTION 15
T6S, R5E

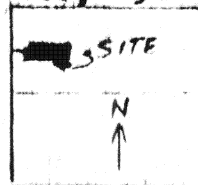

Washington Twp.
Auglaize County

ATTEST: *Doug Reinhart*
Doug Reinhart
Professional Surveyor
#6507

Mon. Box at SW Corner
NW 1/4 Sec. 15
T. 6 S. R. 5 E. # 1162



Survey filed in Plat Book F, Page 379, Auglaize County Engineers Office.

Signature by a representative of the County Health Dept.
denotes compliance with Health Regulations.
Signed _____ Date _____


Signature by a representative of the Auglaize County Regional
Planning Commission denotes approval of this plat.
Signed _____ Date _____

Signature by a representative of City with 3 mile limit juris-
diction or Twp. Trustees or Village with zoning jurisdiction
denotes approval of this plat. Signed _____ Date _____
for political S. D. of _____

Signature by a representative of the County Engineer's Dept.
denotes that this plat meets tax map plat requirements.
Signed _____ Date _____

Client Jim Miller
County Auglaize Twp. Washington Sec. 15
Drawn by _____ Scale 1"=100' Drwg. No. 83-321
Checked by _____ Date 4-18-83
Sheet 1 of 3 **F379 REVISED** (T 6 S. R 5 E)

REVISED F379

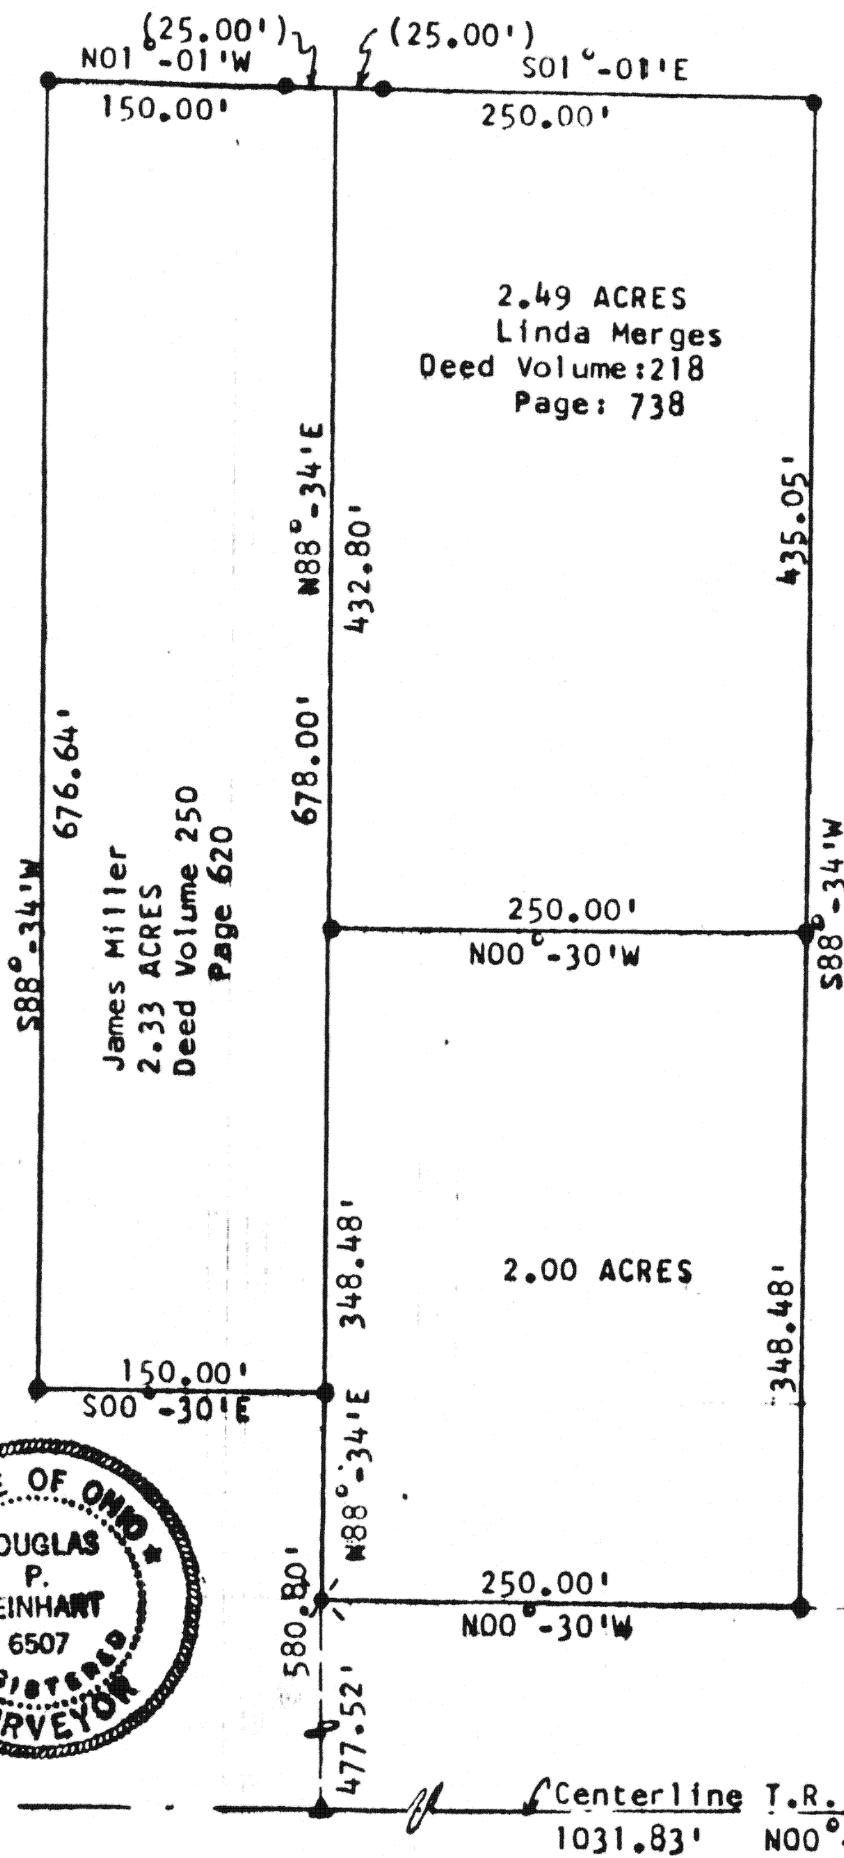


Scale:
1"=100'

LEGEND

- ⊗ Iron Pin Fd.
- Iron Pin Set
- ▲ Railroad Spike Fd.

SECTION 15
T6S, R5E

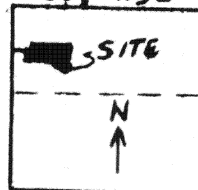

Washington Twp.
Auglaize County

ATTEST *Doug Reinhart*
Doug Reinhart
Professional Surveyor
#6507

Survey filed in Plat Book F, Page 379, Auglaize County Engineers Office.

Signature by a representative of the County Health Dept.
denotes compliance with Health Regulations.
Signed: _____ Date: _____

Signature by a representative of the Auglaize County Regional
Planning Commission denotes approval of this plat.
Signed: _____ Date: _____

Signature by a representative of City with 3 mile limit juris-
diction or Twp. Trustees or Village with zoning jurisdiction
denotes approval of this plat. Signed: _____
for political S. D. of: _____ Date: _____

Signature by a representative of the County Engineer's Dept.
denotes that this plat meets tax map plat requirements.
Signed: _____ Date: _____

F379

SEE REVISED
SURVEY

Client Jim Miller
County Auglaize Twp. Washington Sec. 15
Drawn by _____ Scale 1"=100' Drwg. No. 83-321
Checked by _____ Date 4-18-83
Sheet 1 of 3 F379a (T 6 S; R 5 E)

SURVEYORS DESCRIPTION

CORRECTIVE DESCRIPTION
FOR

2.33 ACRE PARCEL



Scale: _____

The following described parcel of ground is part of the Northwest Quarter of Section 15, Washington Township, Township Six (6) South, Range Five (5) East, Auglaize County, Ohio and is more particularly described as follows:

Commencing at a monument box at the Southwest corner of the Northwest Quarter of Section 15, Washington Township, Thence along the west line of Section 15 a distance of ~~1181.53~~ feet to a spike in the centerline of Township Road # 101 (Bay Road); said section line having a bearing of N00°-30'W;

Thence N88°-34'E a distance of 580.80 feet to an iron pin and the PLACE OF BEGINNING;

Thence continuing N88°-34'E a distance of 678.00 feet;

Thence N01°-01'W through an iron pin at 25.00 feet to an iron pin at a total distance of 150.00 feet;

Thence S88°-34'W a distance of 676.64 feet to an iron pin;

Thence S00°-30'E a distance of 150.00 feet to an iron pin and the PLACE OF BEGINNING.

The above described parcel of ground contains 2.33 acres and is subject to all easements of record. Survey distances and bearings based upon Survey # 70-5574 completed by Stimmel & Associates. Previous Deed reference: Volume 250, Page 620, Auglaize County Recorders Office. Survey found in Plat Book F, Page 372, Auglaize County Engineers Office.

CORRECTIVE DESCRIPTION
FOR

2.49 ACRE PARCEL

The following described parcel of ground is part of the Northwest Quarter of Section 15, Washington Township, Township Six (6) South, Range Five (5) East, Auglaize County, Ohio and is more particularly described as follows:

Commencing at a monument box at the Southwest corner of the Northwest Quarter of Section 15, said box being in the centerline of Township Road # 101 (Bay Road); Thence N00°-30'W along the West line of Section 15 and the centerline of T.R. # 101 a distance of ~~1181.53~~ feet to a spike; Thence N88°-34'E a distance of 826.00 feet to an iron pin and the PLACE OF BEGINNING;

Thence continuing N88°-34'E a distance of 432.80 feet;

Thence S01°-01'E through an iron pin at 25.00 feet for a total distance of 250.00 feet to an iron pin;

Signature by a Representative of the County Health Dept.
denotes compliance with Health Regulations.
Signed: _____ Date: _____

Signature by a representative of the Auglaize County Regional
Planning Commission denotes approval of this plat.
Signed: _____ Date: _____

Signature by a representative of City with 3 mile limit juris-
diction or Twp. Trustees or Village with zoning jurisdiction
denotes approval of this plat. Signed: _____ Date: _____

Signature by a representative of the County Engineer's Dept.
denotes that this plat meets tax map plat requirements.
Signed: _____ Date: _____

ATTEST: Doug Reinhart
Doug Reinhart
Professional Surveyor #

Client James Miller
County Auglaize Twp. Washington Sec. 15
Drawn by _____ Scale _____ Drwg. No. 83-321
Checked by _____ Date 4-18-83
Sheet 2 of 3 **F380 REVISED** (T 6 S 5 E)

6507
REVISED **F380**

SURVEYORS DESCRIPTION

CORRECTIVE DESCRIPTION
FOR
2.33 ACRE PARCEL



Scale: _____

The following described parcel of ground is part of the Northwest Quarter of Section 15, Washington Township, Township Six (6) South, Range Five (5) East, Auglaize County, Ohio and is more particularly described as follows:

Commencing at a monument box at the Southwest corner of the Northwest Quarter of Section 15, Washington Township, Thence along the west line of Section 15 a distance of 1031.83 feet to a spike in the centerline of Township Road # 101 (Bay Road); said section line having a bearing of N00°-30'W;

Thence N88°-34'E a distance of 580.80 feet to an iron pin and the PLACE OF BEGINNING;

Thence continuing N88°-34'E a distance of 678.00 feet;

Thence N01°-01'W through an iron pin at 25.00 feet to an iron pin at a total distance of 150.00 feet;

Thence S88°-34'W a distance of 676.64 feet to an iron pin;

Thence S00°-30'E a distance of 150.00 feet to an iron pin and the PLACE OF BEGINNING.

The above described parcel of ground contains 2.33 acres and is subject to all easements of record. Survey distances and bearings based upon Survey # 70-5574 completed by Stimmel & Associates. Previous Deed reference: Volume 250, Page 620, Auglaize County Recorders Office. Survey found in Plat Book F, Page 379, Auglaize County Engineers Office.

CORRECTIVE DESCRIPTION
FOR
2.49 ACRE PARCEL

The following described parcel of ground is part of the Northwest Quarter of Section 15, Washington Township, Township Six (6) South, Range Five (5) East, Auglaize County, Ohio and is more particularly described as follows:

Commencing at a monument box at the Southwest corner of the Northwest Quarter of Section 15, said box being in the centerline of Township Road # 101 (Bay Road); Thence N00°-30'W along the West line of Section 15 and the centerline of T.R. # 101 a distance of 1031.83 feet to a spike; Thence N88°-34'E a distance of 826.00 feet to an iron pin and the PLACE OF BEGINNING;

Thence continuing N88°-34'E a distance of 432.80 feet;

Thence S01°-01'E through an iron pin at 25.00 feet for a total distance of 250.00 feet to an iron pin;

Signature by a representative of the County Health Dept. denotes compliance with Health Regulations.
Signed: _____

Signature by a representative of the Auglaize County Regional Planning Commission denotes approval of this plat.
Signed: _____ Date _____

Signature by a representative of City, Village, Township, or County denotes approval of this plat. Signed: _____
for political S. D. of: _____

Signature by a representative of the County Engineer's Dept. denotes that this plat meets tax map plat requirements.
Signed: _____ Date _____

ATTEST: Doug Reinhart
Doug Reinhart
Professional Surveyor #
F380 6507
SEE REVISED SURVEY

Client James Miller
County Auglaize Twp. Washington Sec. 15
Drawn by _____ Scale _____ Drwg. No. 83-321
Checked by _____ Date 4-18-83
Sheet 2 of 3 F380a (T 6 S; R 5 E)

SURVEYORS DESCRIPTION



Thence S88°-34'W a distance of 435.05 feet to an iron pin
 Thence N00°-30'W a distance of 250.00 feet to an iron pin
 and the PLACE OF BEGINNING. Scale _____

The above described parcel of ground contains 2.49 Acres and is subject to all easements of record. Survey distances and measurements based upon survey # 70-5574 completed by Stimmel & Associates. Previous deed reference: Volume 218, Page 738, Auglaize County Recorders Office. Survey filed in Plat Book E, Page 379, Auglaize County Engineers Office.

WITNESSES: Doug Reinhart
 Doug Reinhart
 Professional Surveyor # 6507



Signature by a representative of the County Health Dept. denotes compliance with Health Regulations.
 Signed: _____ Date: _____

Signature by a representative of the Auglaize County Regional Planning Commission denotes approval of this plat.
 Signed: _____ Date: _____

Signature by a representative of City with 3 mile limit jurisdiction or Twp. Trustees or Village with zoning jurisdiction denotes approval of this plat. Signed: _____
 for political S. D. of: _____ Date: _____

Signature by a representative of the County Engineer's Dept. denotes that this plat meets tax map plat requirements.
 Signed: _____ Date: _____

F381 REVISED

Client James Miller
 County Auglaize Twp. Washington Sec. 15
 Drawn by _____ Scale _____ Drwg. No. 83-321
 Checked by _____ Date 4-13-83
 Sheet 3 of 3 F381 REVISED (P. C. S. R. S. E.)

SURVEYORS DESCRIPTION



Thence S88°-34'W a distance of 435.05 feet to an iron pin;
 Thence N00°-30'W a distance of 250.00 feet to an iron pin
 and the PLACE OF BEGINNING. Scale: _____

The above described parcel of ground contains 2.49 Acres
 and is subject to all easements of record. Survey distances
 and measurements based upon survey # 70-5574 completed by
 Stimme & Associates. Previous deed reference: Volume 218,
 Page 738, Auglaize County Recorders Office. Survey filed in
 Plat Book F, Page 379, Auglaize County Engineers Office.

AATTEST: *Doug Reinhart*
 Doug Reinhart
 Professional Surveyor # 6507



Signature by a representative of the County Health Dept. denotes compliance with Health Regulations. Signed: _____ Date: _____	Signature by a representative of the Auglaize County Regional Planning Commission denotes approval of this plat. Signed: _____ Date: _____
Signature by a representative of City with 3 mile limit juris- diction or Twp. Trustees or Village with zoning jurisdiction denotes approval of this plat. Signed: _____ for political S. D. of: _____ Date: _____	Signature by a representative of the County Engineer's Dept. denotes that this plat meets tax map plat requirements. Signed: _____ Date: _____

<p style="text-align: center; font-weight: bold; font-size: 1.2em;">F381</p> <p style="text-align: center;"><i>See Revised Survey</i></p> <p style="text-align: center;"><i>F-381</i></p>	Client <u>James Miller</u> County <u>Auglaize</u> Twp. <u>Washington</u> Sec. <u>15</u> Drawn by _____ Scale _____ Drwg. No. <u>83-321</u> Checked by _____ Date <u>4-18-83</u> Sheet <u>3</u> of <u>3</u> F381a (T 6 S; R 5 E)
---	---