



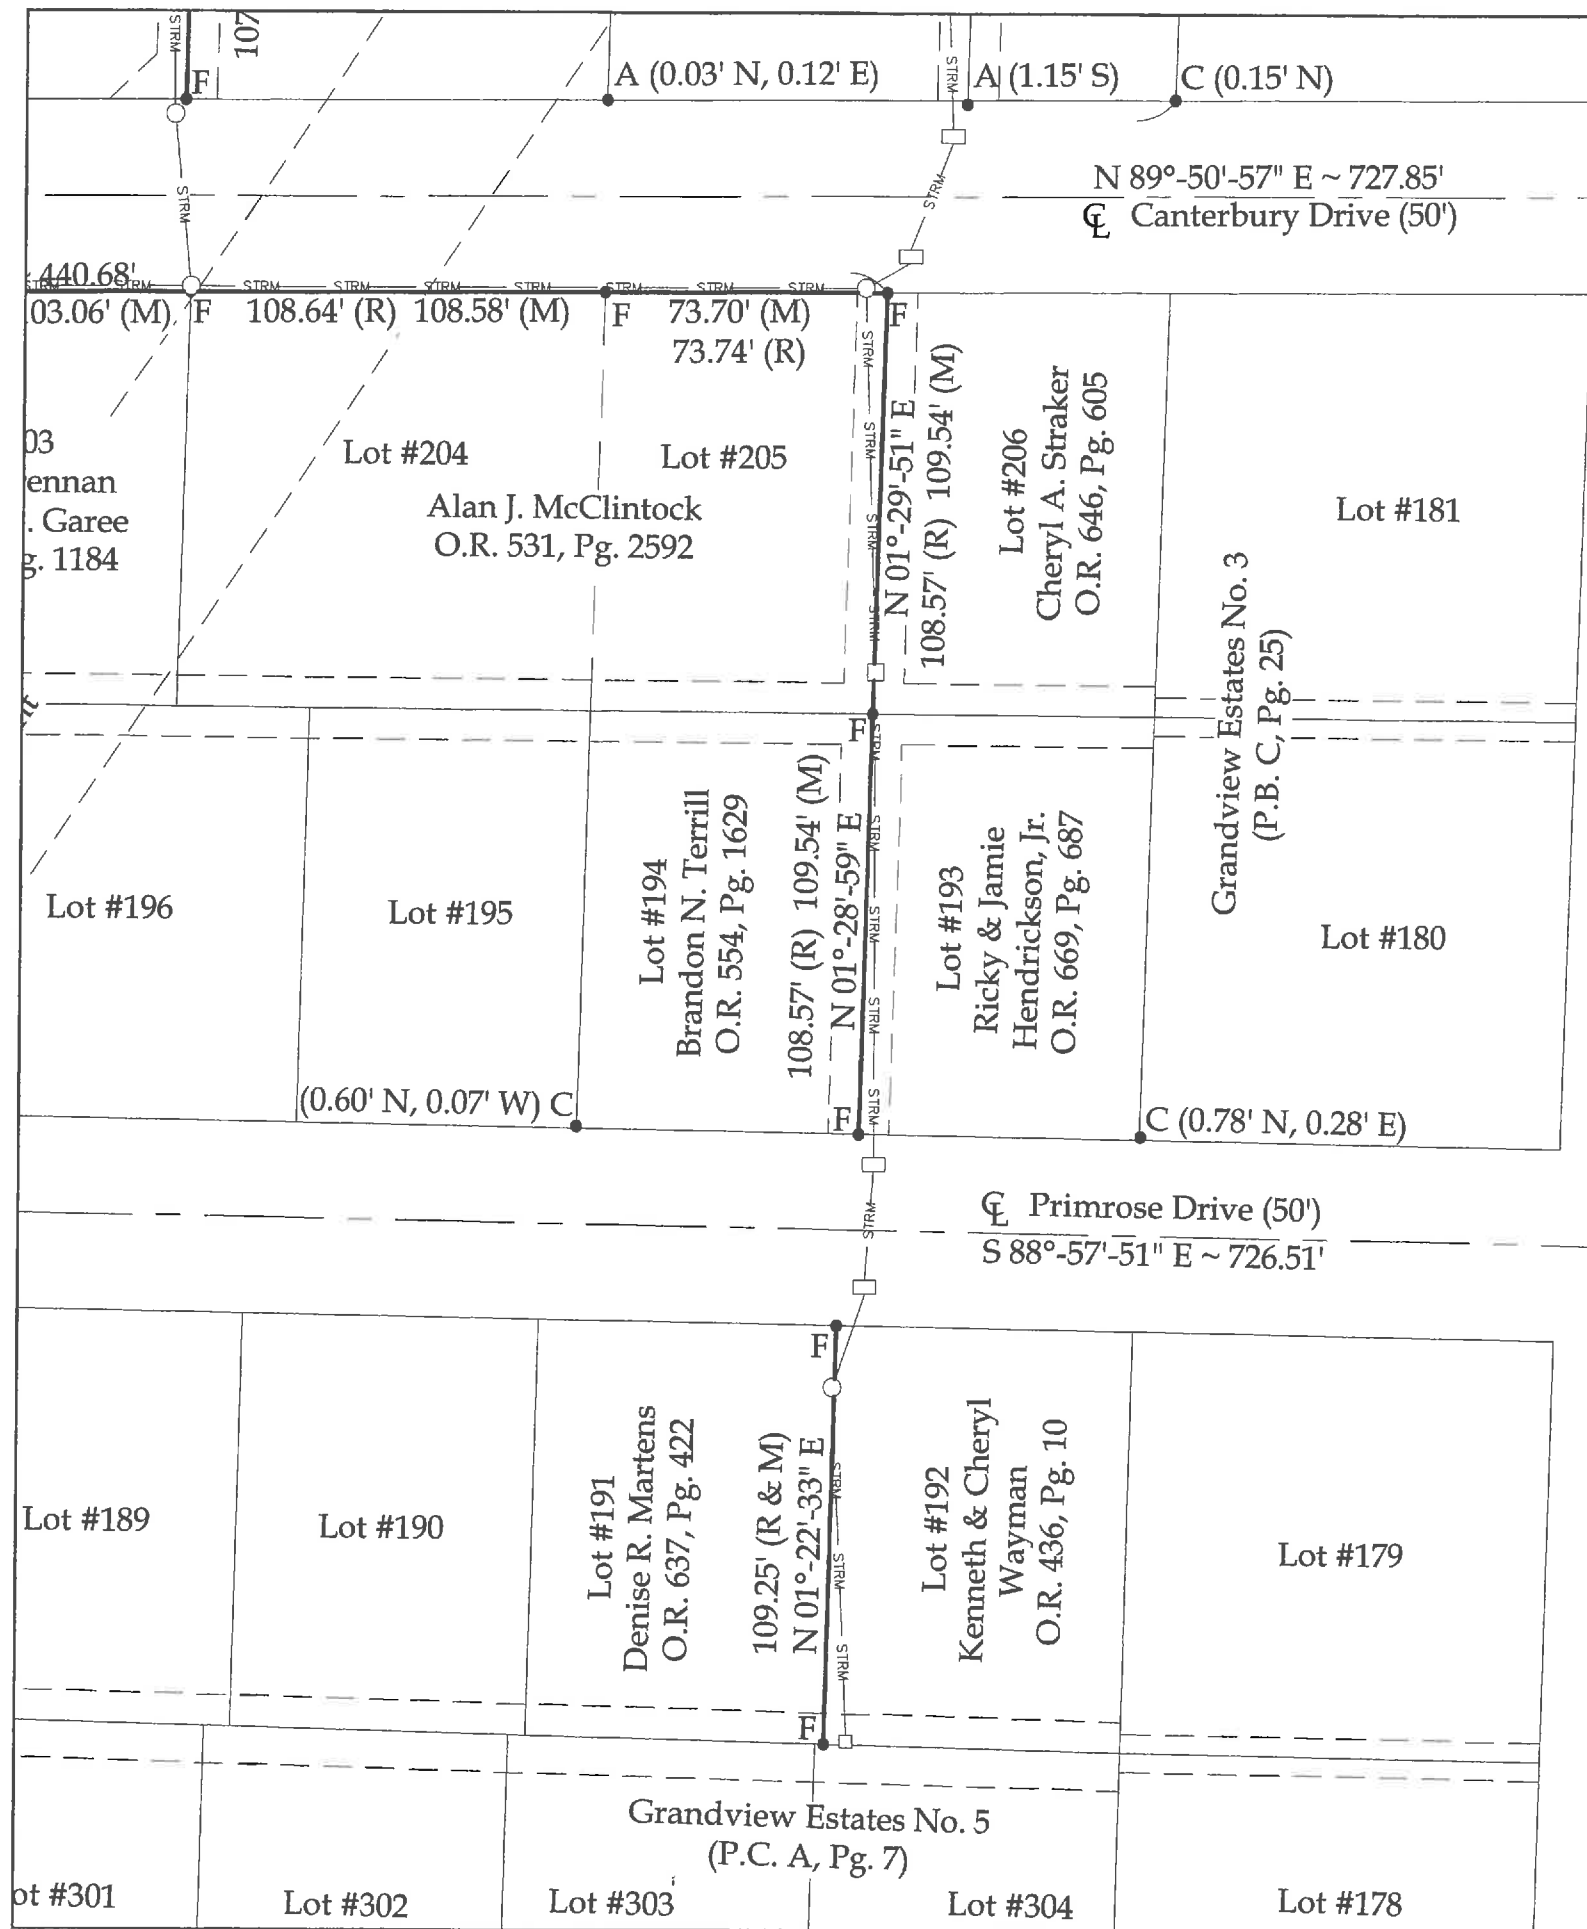

Asbuilt location the City of Wapakoneta's new storm sewer line and the replacement of property pins for part of Grandview Estates, No. 4 (P.B. C, Pg. 35) and being located in the E 1/2 of Section 30, Town 5 South, Range 6 East, Duchouquet Township, Auglaize County, Ohio.

Legend

- A = Existing #5 Rebar encased in Concrete
- B = Existing #4 Rebar
- C = Existing #5 Rebar
- D = Existing Railroad Spike
- E = Existing Mag Nail
- F = Set #5 Rebar
- G = Set Mag Spike

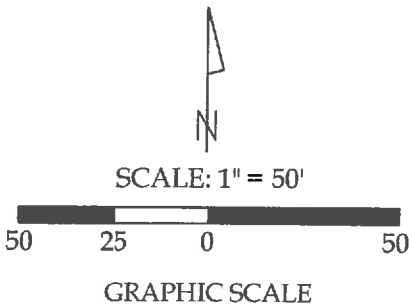

Line Data

- L - 1 = S 89°-21'-13" W ~ 7.40'
- L - 2 = S 19°-37'-27" W ~ 1.47'
- L - 3 = S 87°-49'-13" E ~ 1.84'

This plat represents an actual boundary survey completed under my direct supervision on November 15, 2020.

Kyle J. Binkley, P.S. #8587


Note: All distances shown are measured unless otherwise noted.

This plat is recorded in Survey Book "U", Page 301, in the Auglaize County Engineer's Office.

BASIS OF BEARINGS: The system of bearings for this plat and legal description is based on the Ohio State Plane - North Coordinate System NAD 83 (2011).



CLIENT: City of Wapakoneta			
SURVEYED BY: T.J.S./T.E.W.	DATE: 11-15-2020	DRAWN BY: K.J.B.	CHECKED BY: K.J.B.
SCALE: 1" = 50'		PAGE 1	OF 4 PAGES

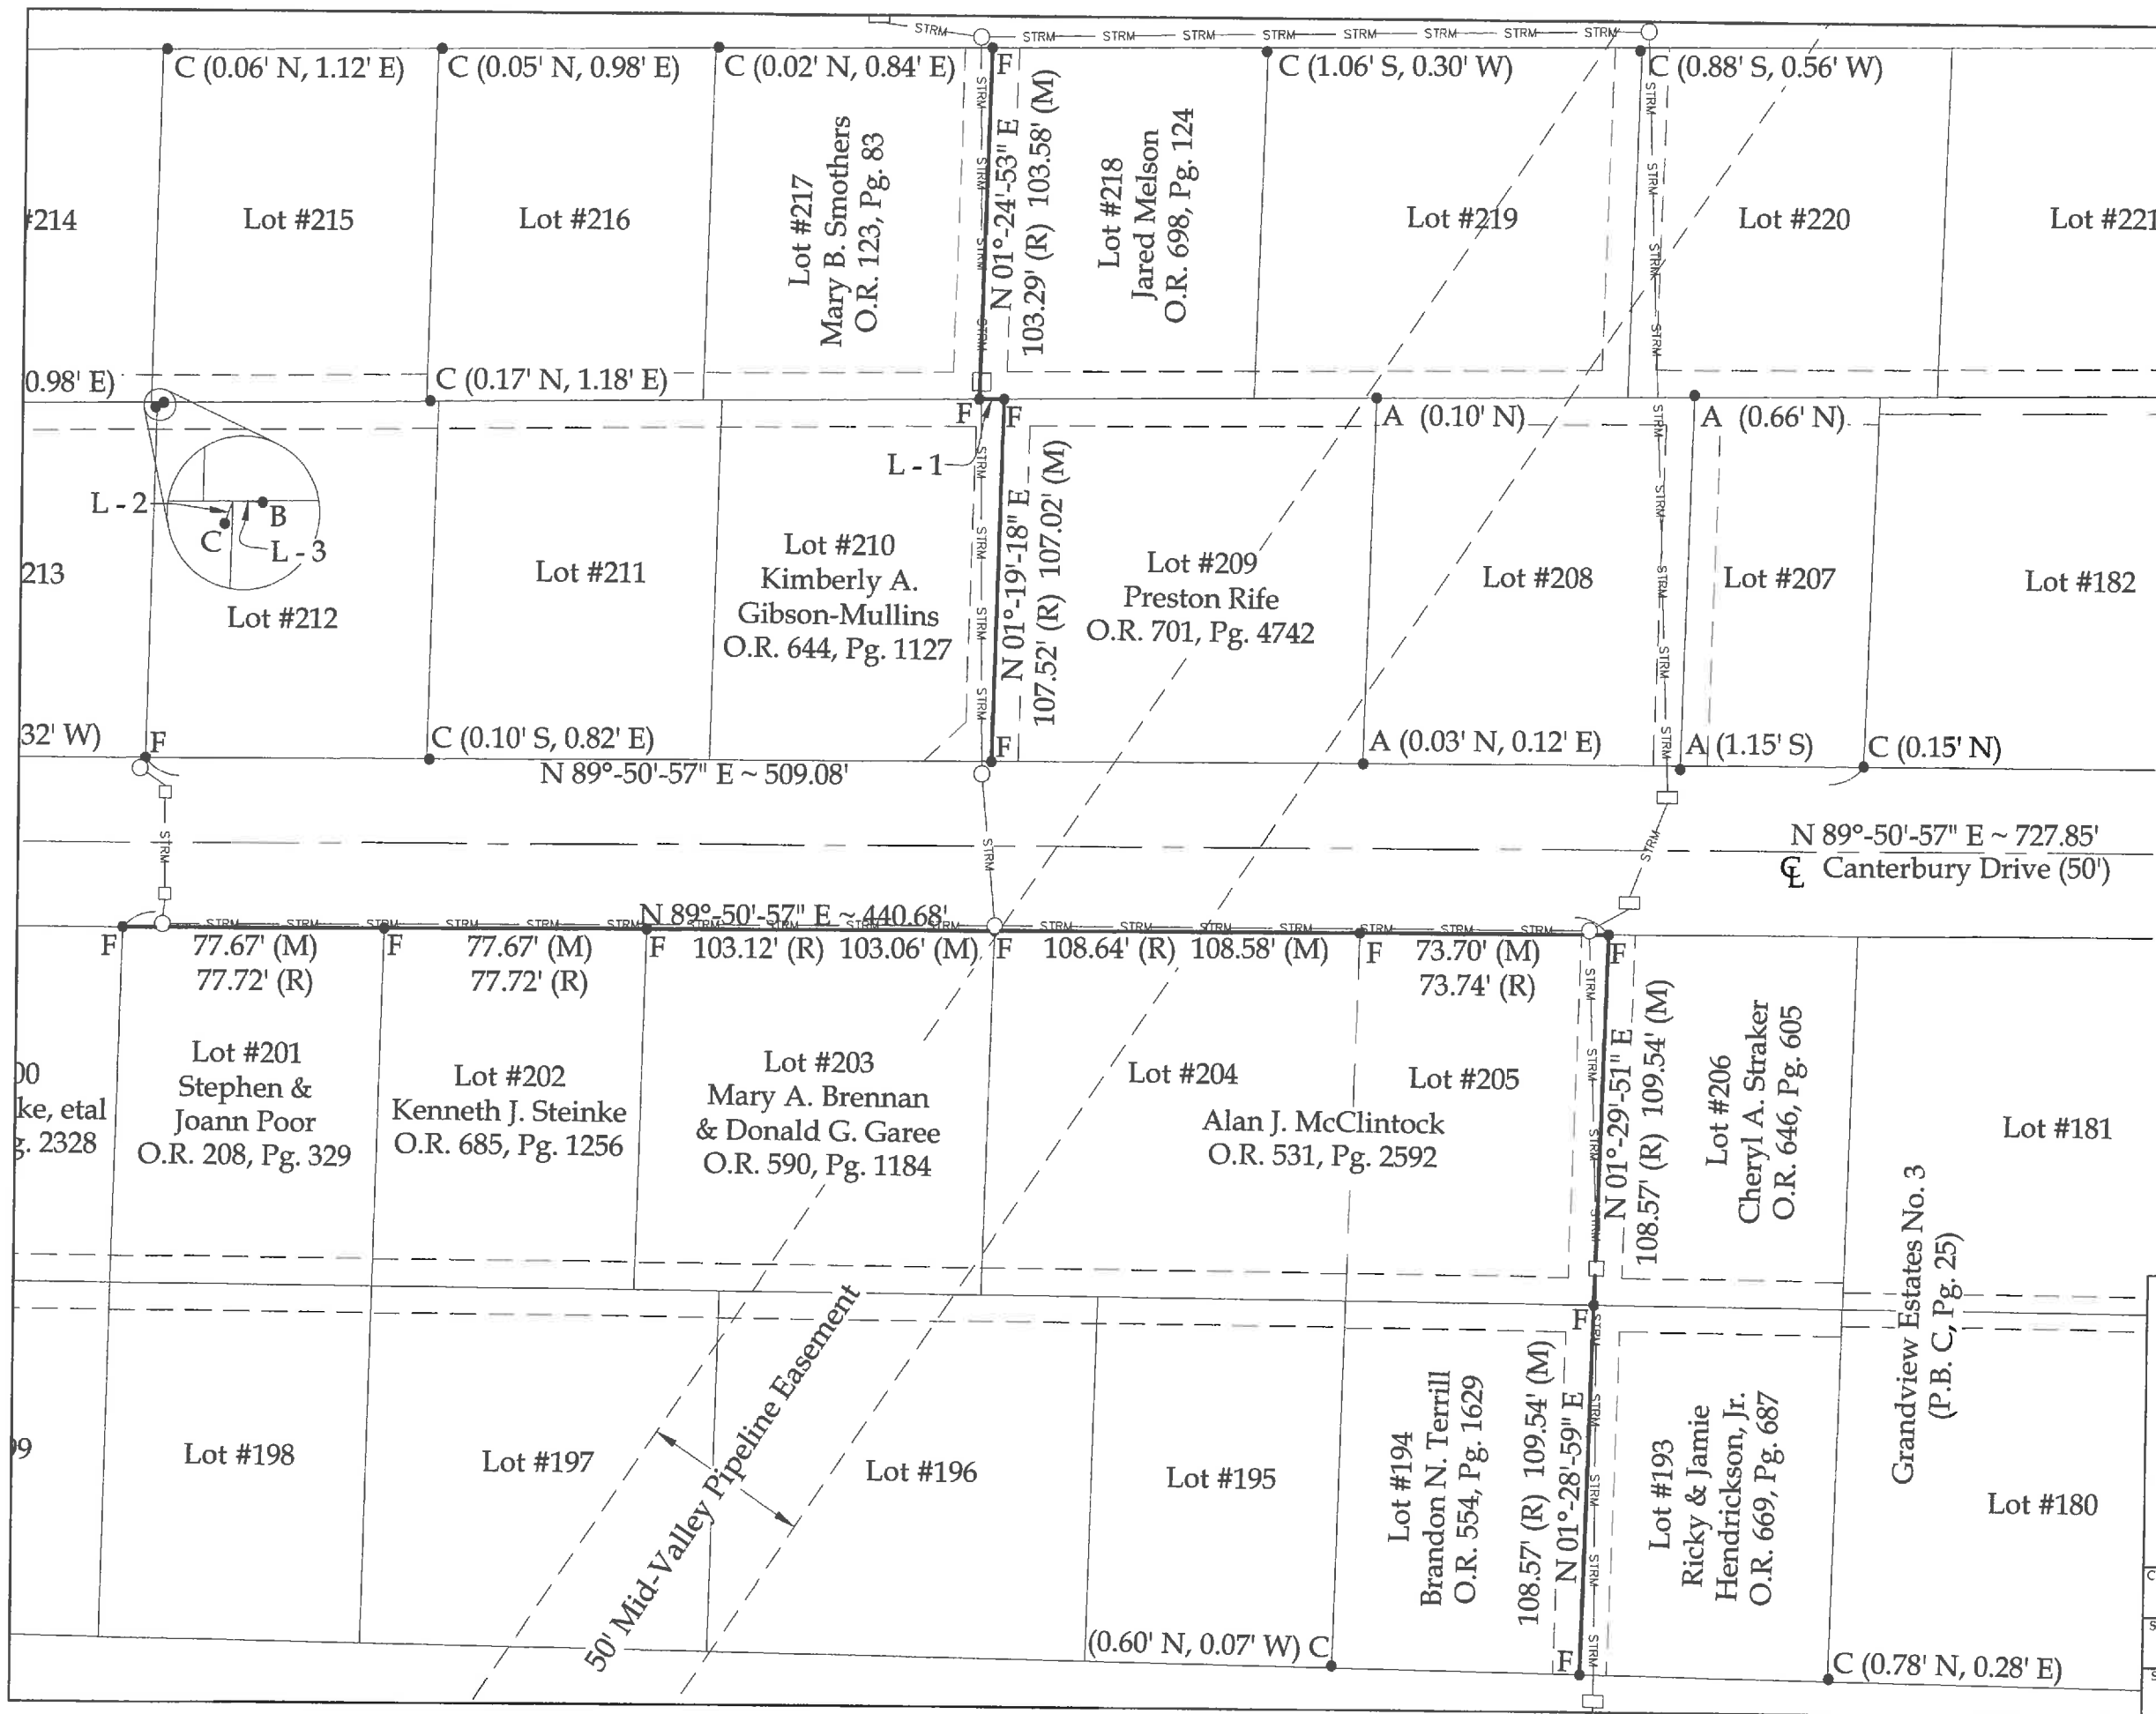



Binkley



LAND SURVEYING, LLC

121 W. Auglaize Street
Wapakoneta, Ohio 45895
(419) 236-3768

CLIENT: City of Wapakoneta			
SURVEYED BY: T.J.S./T.E.W.	DATE: 11-15-2020	DRAWN BY: K.J.B.	CHECKED BY: K.J.B.
SCALE: 1" = 50'		PAGE 2	OF 4


U-302

David P. &
Amy F. Schlenker
O.R. 626, Pg. 2187

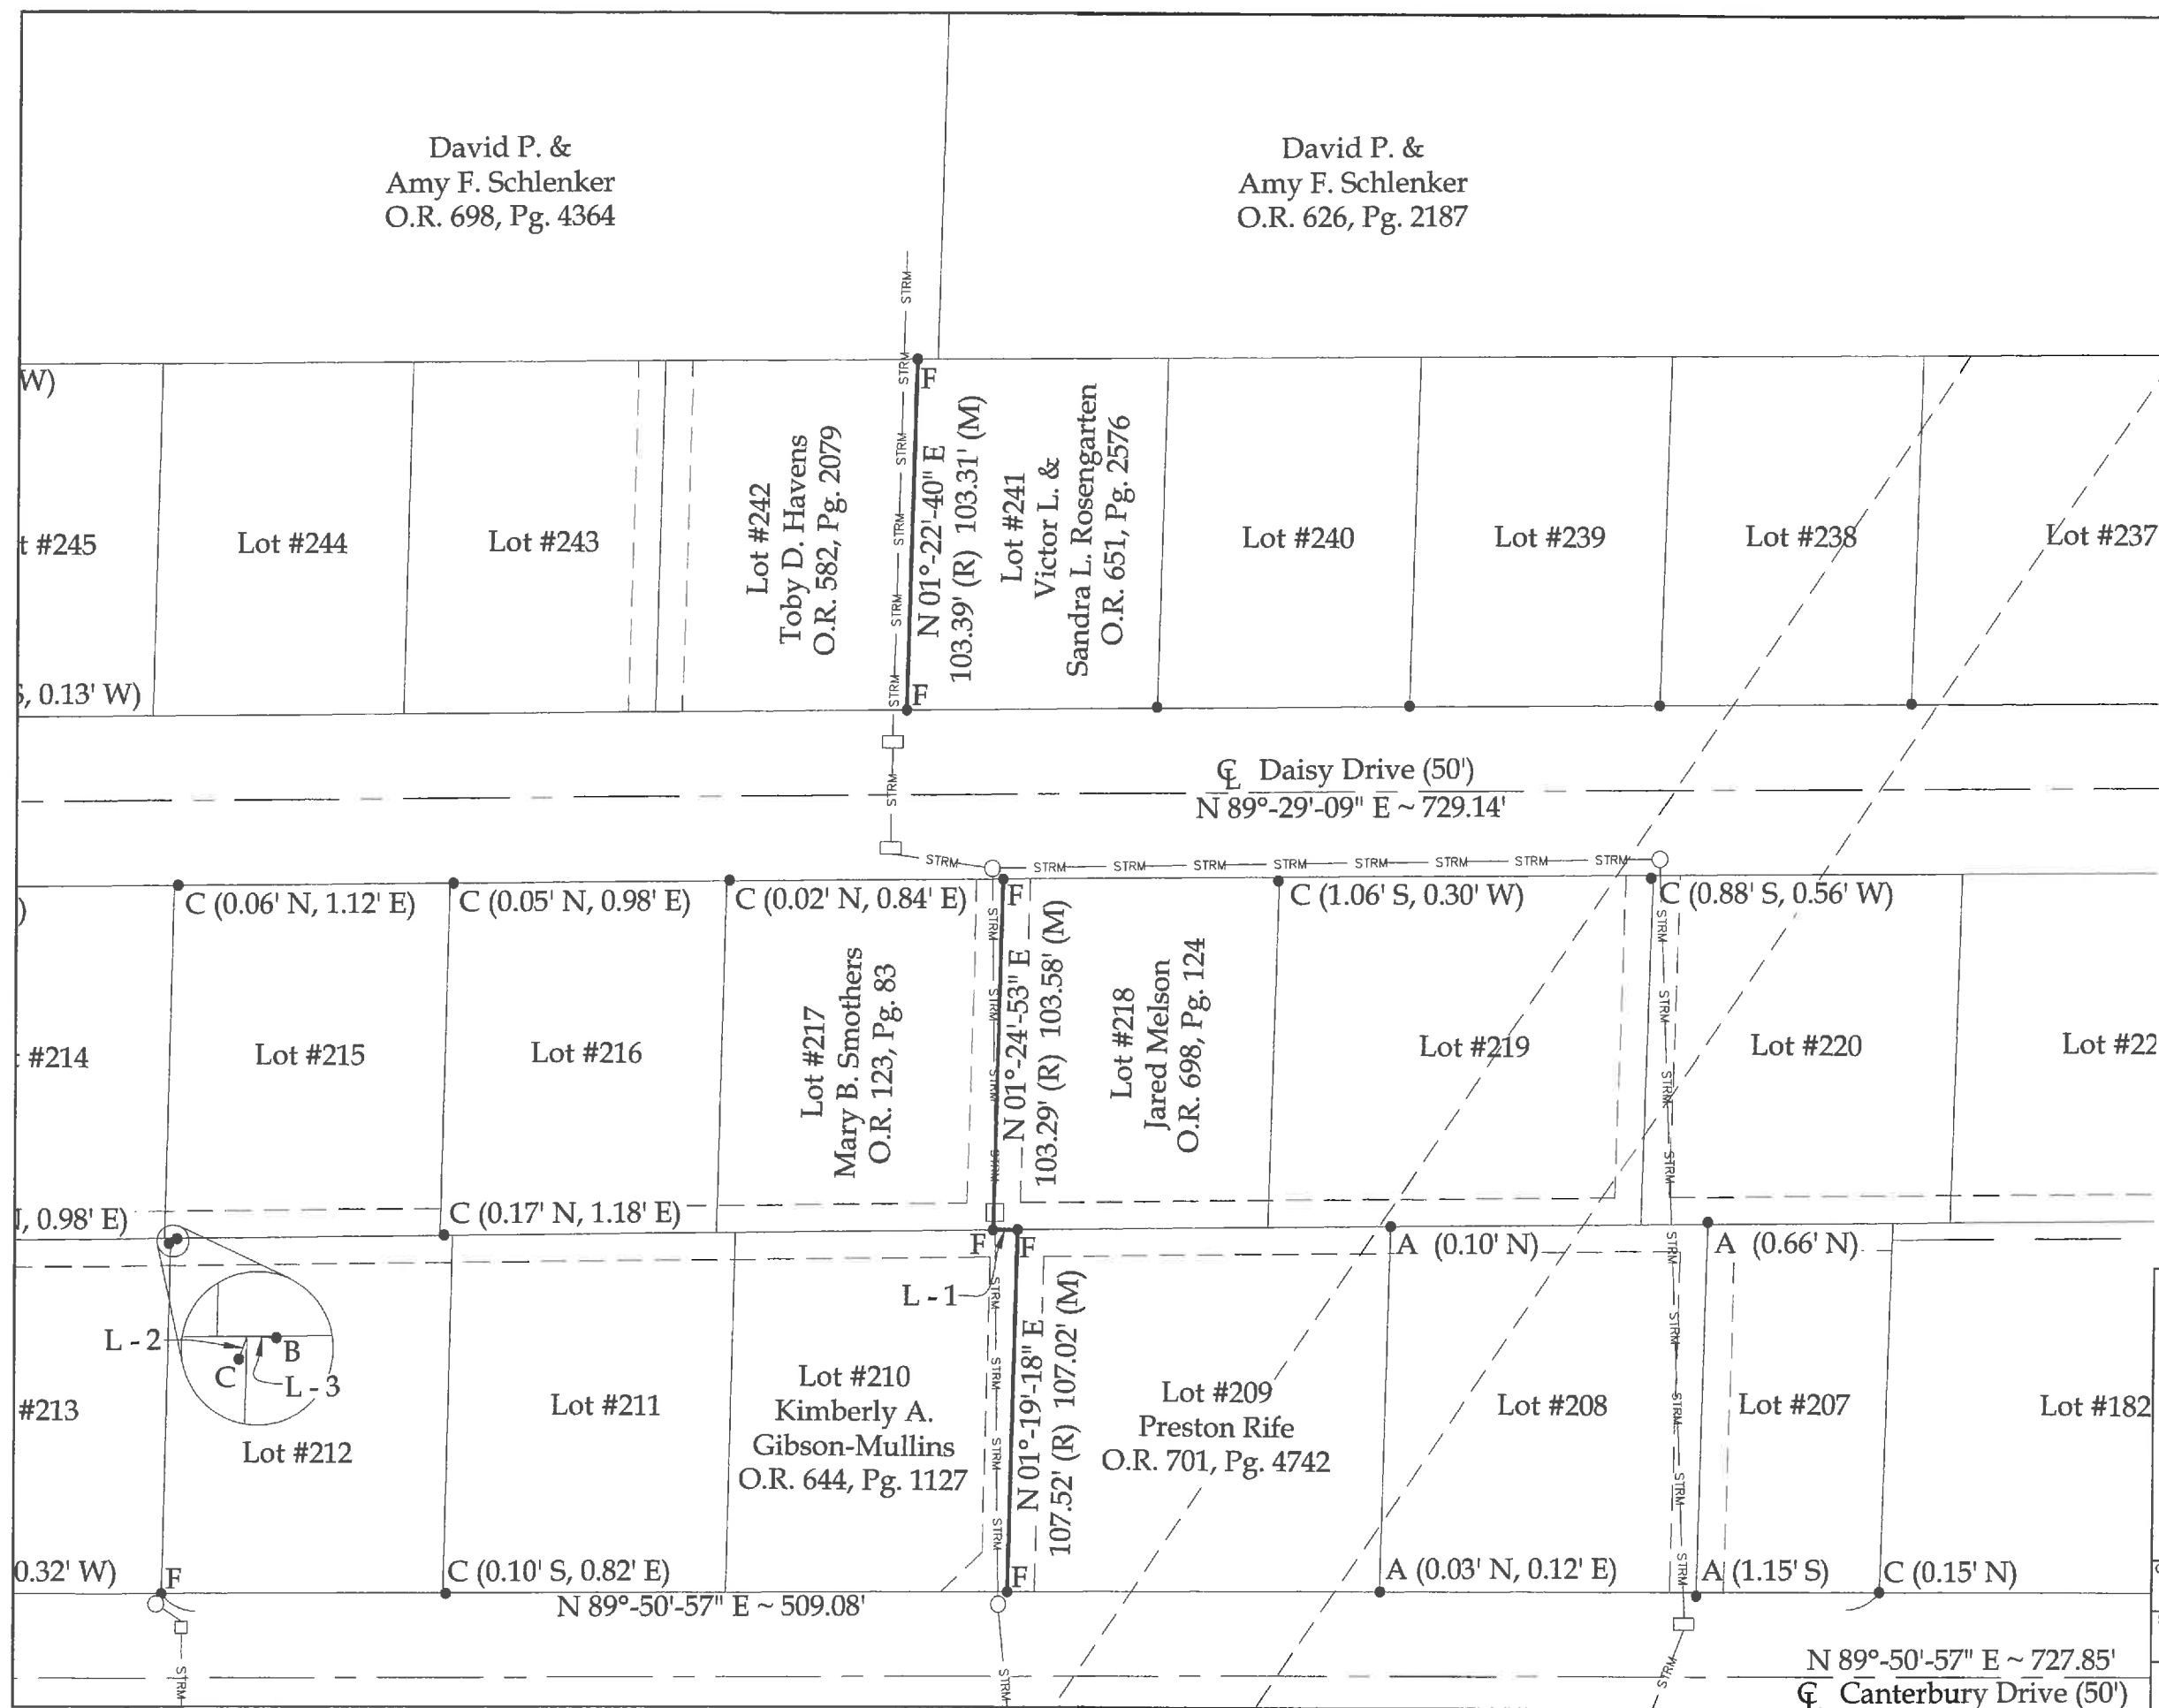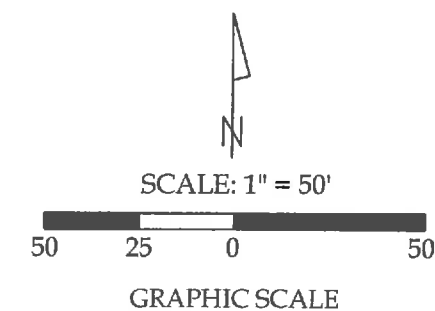

Woodland Hills
Subdivision No. 4
(P.C. C, Pg. 126)

Grandview Estates No. 5
(P.B. A, Pg. 7)

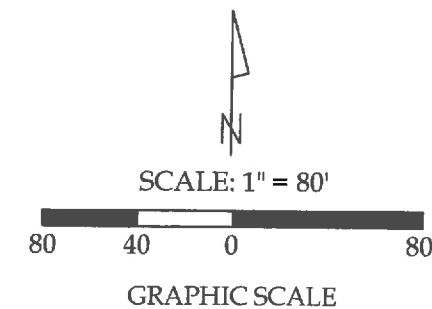



Binkley
LAND SURVEYING, LLC

121 W. Auglaize Street
Wapakoneta, Ohio 45895
(419) 236-3768

CLIENT: City of Wapakoneta			
SURVEYED BY: T.J.S./T.E.W.	DATE: 11-15-2020	DRAWN BY: K.J.B.	CHECKED BY: K.J.B.
SCALE: 1" = 80'		PAGE 4	OF PAGES 4

U-304