


Elliott's East Addition to Wapakoneta.

Black ink - original numbers

Red Ink - new numbers.

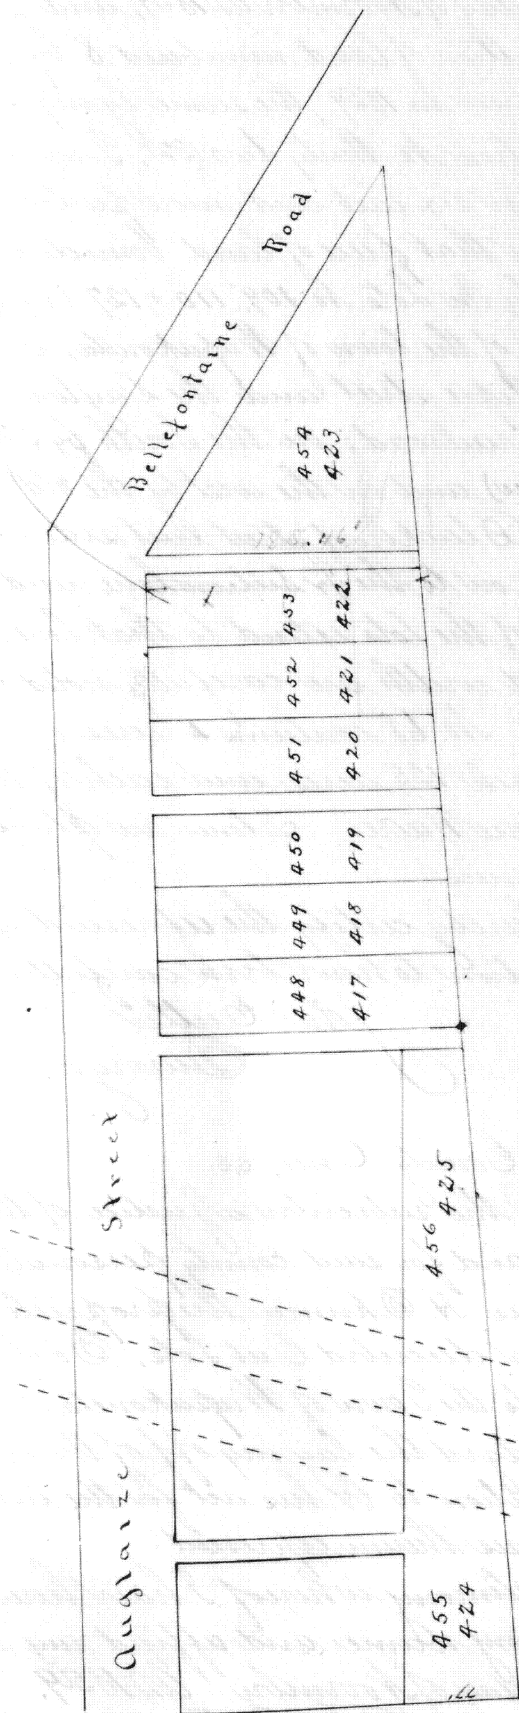

The above plat represents James Elliott's East Addition to Wapakoneta as laid out on the South West quarter of the South East quarter of Section twenty nine (29), T5S. R6E.

Lots 448, 449, 450, 451, 452 + 453, are each 50 feet front on Auglaize Street and extending South to the Section line. Lot 454 is 2.81 chains on the West

4.32 chains on the south and 5.17 chains on the Bellefontaine road. Lot 455 is 77 feet front on Park street, extending east to the railroad.

Lot 456 comprises all between lots 171, 172, 173 + 174 and the section line from the railroad to lot 448.

Drawn by me at the request of James Elliott
Nov. 21st. 1855. John C. Williams

Surveyor.

I acknowledge the above as specified.
James Elliott.

The State of Ohio, Auglaize County, ss.

Personally appeared James Elliott before me and acknowledged the signing of the above and that it was laid out as an addition to the Town of Wapakoneta at his request.

John C. Williams
Notary Public.

Filed December 8th 1855

Refiled October 25, 1854

And recorded same day

Edward Meyer
Recorder A. Co. O.