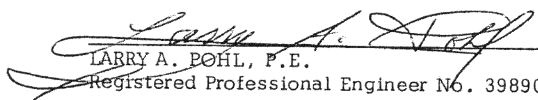
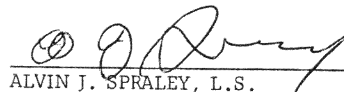



CERTIFICATE

We, the undersigned, hereby certify that the drawings of Hogenkamp Condominiums filed at Plat Cabinet A, Page 42 of the Auglaize County Records, consisting of the drawing list contained below, accurately show the buildings as constructed.

Drawing List:	1 of 1	E-76002-1
	2	E-76002-2
	7	E-76002-3
		E-76002-4

 Date: 9 Feb '77
LARRY A. POHL, P.E.
Registered Professional Engineer No. 39890

 Date: FEB. 26, 1977
ALVIN J. SPRALEY, L.S.
Registered Land Surveyor No. 5016

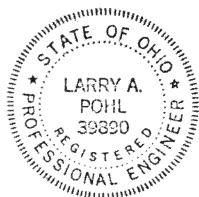


HOGENKAMP CONDOMINIUM
MINSTER, OHIO

WE, THE UNDERSIGNED, HEREBY CERTIFY THAT THE ATTACHED DRAWINGS, LISTED AS FOLLOW, SHOW THE CONDOMINIUM UNITS AS ORIGINALLY CONSTRUCTED.
DRAWING LIST: 1 of 1 E-76002-1
2 E-76002-2
7 E-76002-3
E-76002-4


146472

11:06
State of Ohio Auglaize County, S. S.
Received OCT. 21 19 76
at 11:06 O'clock A. M.
Recorded OCT. 21 19 76
CABINET Vol. No. A Page A-42
8³⁰ Le Roy H. Kneel
Recorder, Auglaize Co., Ohio
8,30

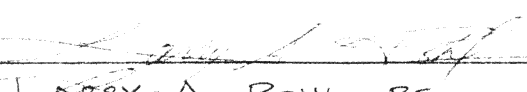


LARRY A. POHL, P.E.
REGISTERED PROFESSIONAL ENGINEER No. 39890

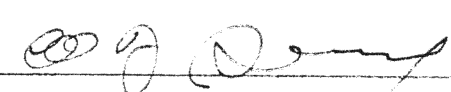


ALVIN J. SPRALEY, L.S.
REGISTERED LAND SURVEYOR No. 5016

- A CONDOMINIUM UNIT
A-B-C-D-E-F-G
- P PATIO
LIMITED COMMON AREA
- S STORAGE
COMMON AREA





ALL LAND SHOWN WITHIN THIS
CONDOMINIUM PLAN, EXCEPT
AS IDENTIFIED TO THE CONTRARY,
CONSTITUTES COMMON AREA.

THE MEASUREMENTS ARE CERTIFIED TO
BE CORRECT AND THESE DRAWINGS
ACCURATELY SHOW THE BUILDINGS AS
CONSTRUCTED.

Larry A. Pohl
LARRY A. POHL, REGISTERED ENGINEER-39890

Alvin J. Spraley
ALVIN J. SPRALEY, REGISTERED SURVEYOR-50140

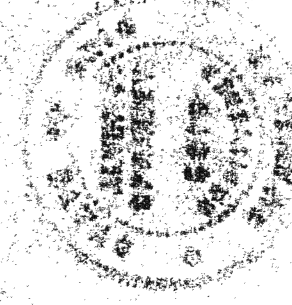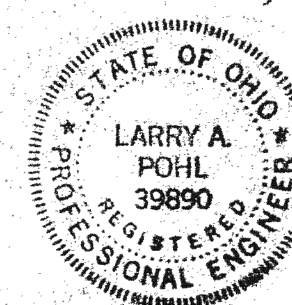

HOGENKAMP CONDOMINIUM

IN LOTS 31 AND 32 OF BLOCK "F"
JACKSON TOWNSHIP • VILLAGE OF MINSTER • AUGLAIZE COUNTY • OHIO

WE, THE UNDERSIGNED, BEING ALL OF THE OWNERS AND
LIENHOLDERS, DO HEREBY CONSENT TO AND JOIN IN
THE SUBMISSION OF THE LANDS HEREIN DESCRIBED
AND THEIR INTERESTS THEREIN TO THE CONDOMINIUM
PLAN KNOWN AS HOGENKAMP CONDOMINIUM AS SET
FORTH IN THE DECLARATION OF SUCH CONDOMINIUM TO
BE FILED WITH THE RECORDER OF AUGLAIZE COUNTY,
OHIO, UNDER THE CONDOMINIUM STATUTES OF THE
STATE OF OHIO.

HOGENKAMP CONDOMINIUM, INC.

BY: *Nicholas A. Hogenkamp*
NICHOLAS A. HOGENKAMP - PRESIDENT

BY: *Roger Bornhorst*
ROGER BORNHORST - VICE PRESIDENT

MINSTER STATE BANK

BY: *Melvin G. Vallo*
MELVIN G. VALLO - PRESIDENT

BY: *Lester Prenger*
LESTER PRENGER - ASST. CASHIER

STATE OF OHIO

BE IT REMEMBERED THAT ON THIS 15 DAY OF October, 1976,
BEFORE ME, THE UNDERSIGNED, A NOTARY PUBLIC IN AND
FOR SAID STATE, PERSONALLY CAME HOGENKAMP CONDOMINIUM,
INC. BY NICHOLAS A. HOGENKAMP - PRESIDENT, AND ROGER
BORNHORST - VICE PRESIDENT, AND MINSTER STATE BANK BY
MELVIN G. VALLO - PRESIDENT, AND LESTER PRENGER, ASSISTANT
CASHIER, ALL OF WHOM ACKNOWLEDGED THE SIGNING AND
EXECUTION OF THE FOREGOING PLAN TO BE THEIR
VOLUNTARY ACT AND DEED. IN TESTIMONY WHEREOF, I HAVE SET
MY HAND AND NOTORIAL SEAL ON THIS DAY AND DATE ABOVE WRITTEN.

146473

11:09
State of Ohio Auglaize County, S. S.
Received OCT-21 1976
at 11:09 O'clock A. M.
Recorded OCT-21 1976
CABINET No. A Page A-42

Le Roy H. Knusel
Recorder, Auglaize Co., Ohio

NOTARY PUBLIC

MY COMMISSION EXPIRES

HOGENKAMP CONDOMINIUM
FOR


HOGENKAMP CONDOMINIUM, INC.
MINSTER, OHIO

L.A. POHL ENGINEERING LTD.
LIMA, OHIO

DATE:
AUG. 1976

DRAWN BY: LAP
SCALE: 1"=20'

SHEET NO:
1 of 1

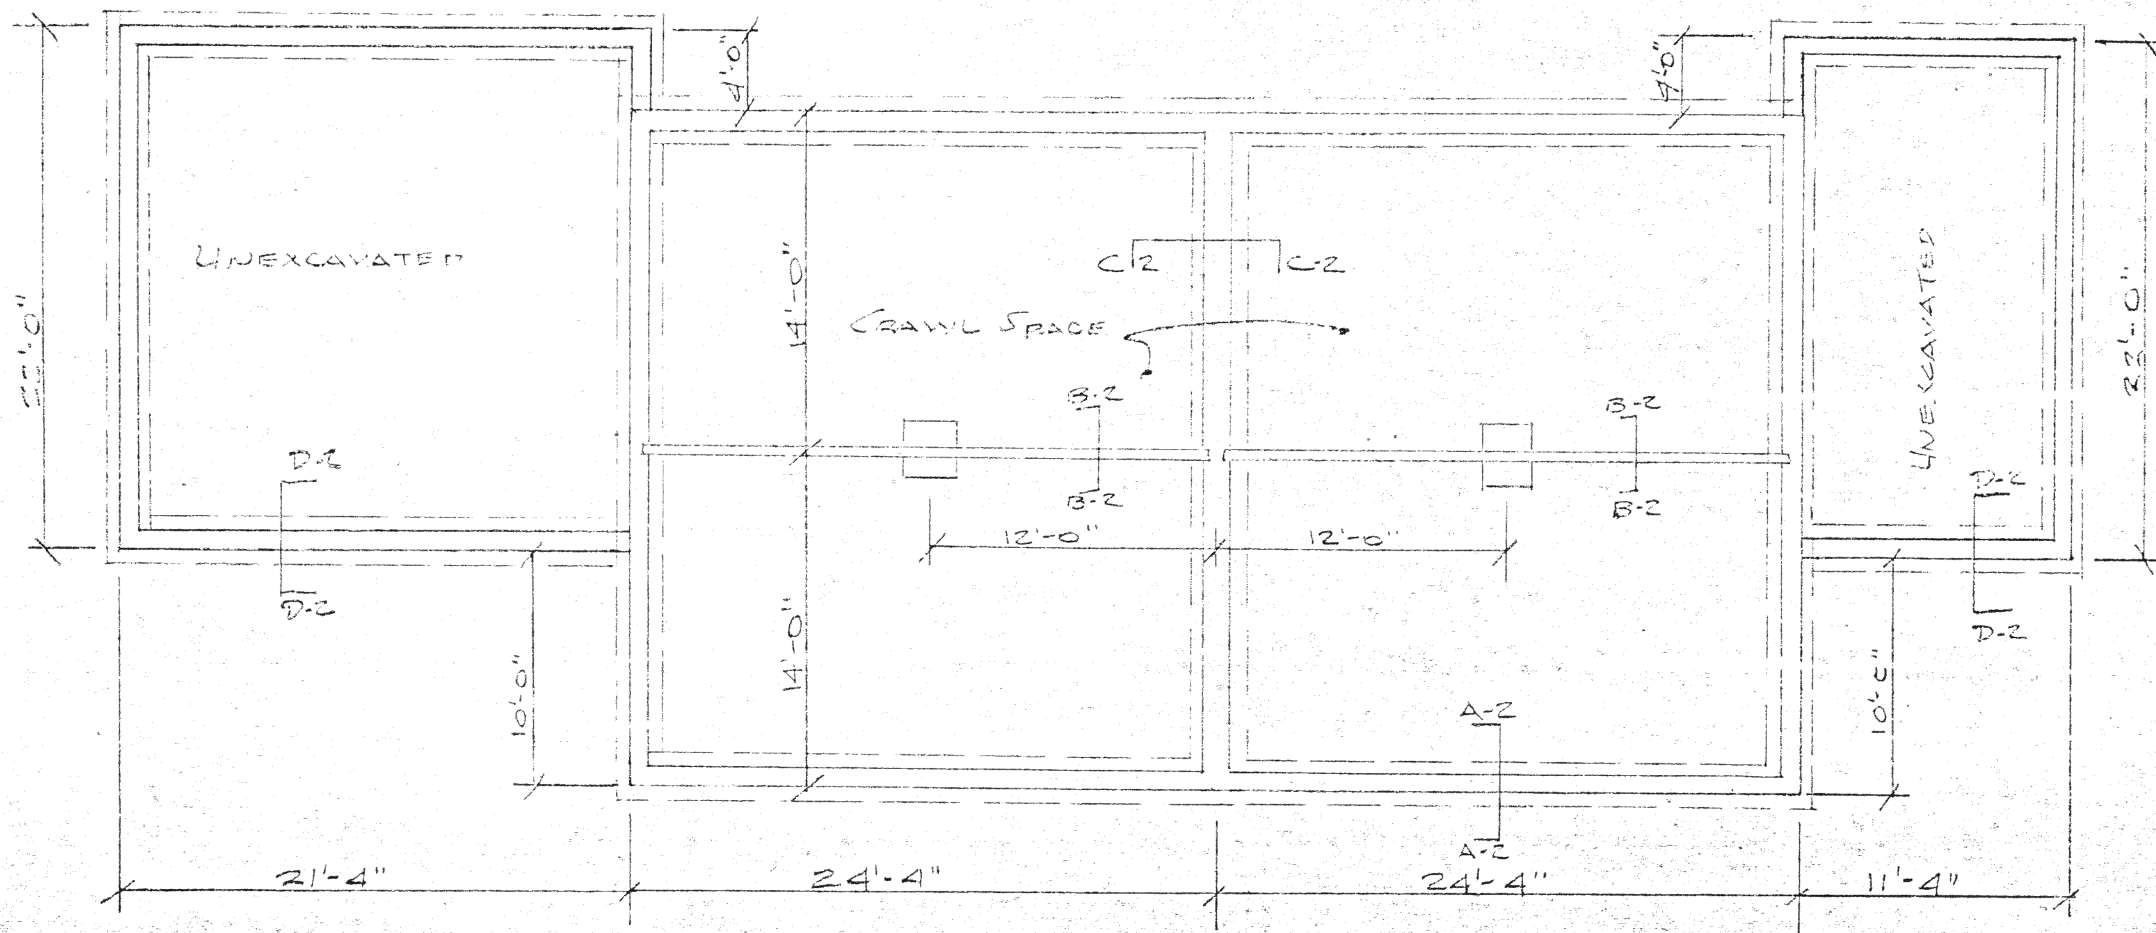

HOGENKAMP CONDOMINIUM


FOUNDATION PLAN FOR UNITS

L. A. POHL ENGINEERING LTD.
LIMA, OHIO


E-76

REVISIONS			Honey Kamp Condominium		
NO.	DATE	BY	DRAWN BY	SCALE	MATERIAL
1			P. FB		
2			CHK'D	DATE 2-10-76	DRAWING NO.
3			TRACED	APP'D	2


1. All requirements for footings and foundations under Chapt. BB-31 will be met.
2. All masonry construction will comply with all requirements of Chapter BB-35 of the Ohio Building Code.
3. All wood construction will comply with all requirements of Chapter BB-39 of the Ohio Building Code.
4. Exit door hardware will comply with Section BB-53-13 of the Ohio Building Code.
5. Fire extinguishing equipment will comply with Section BB-53-32 of the Ohio Building Code.
6. Toilets will be adequately ventilated to comply with Section BB-47-23 of the OBC.

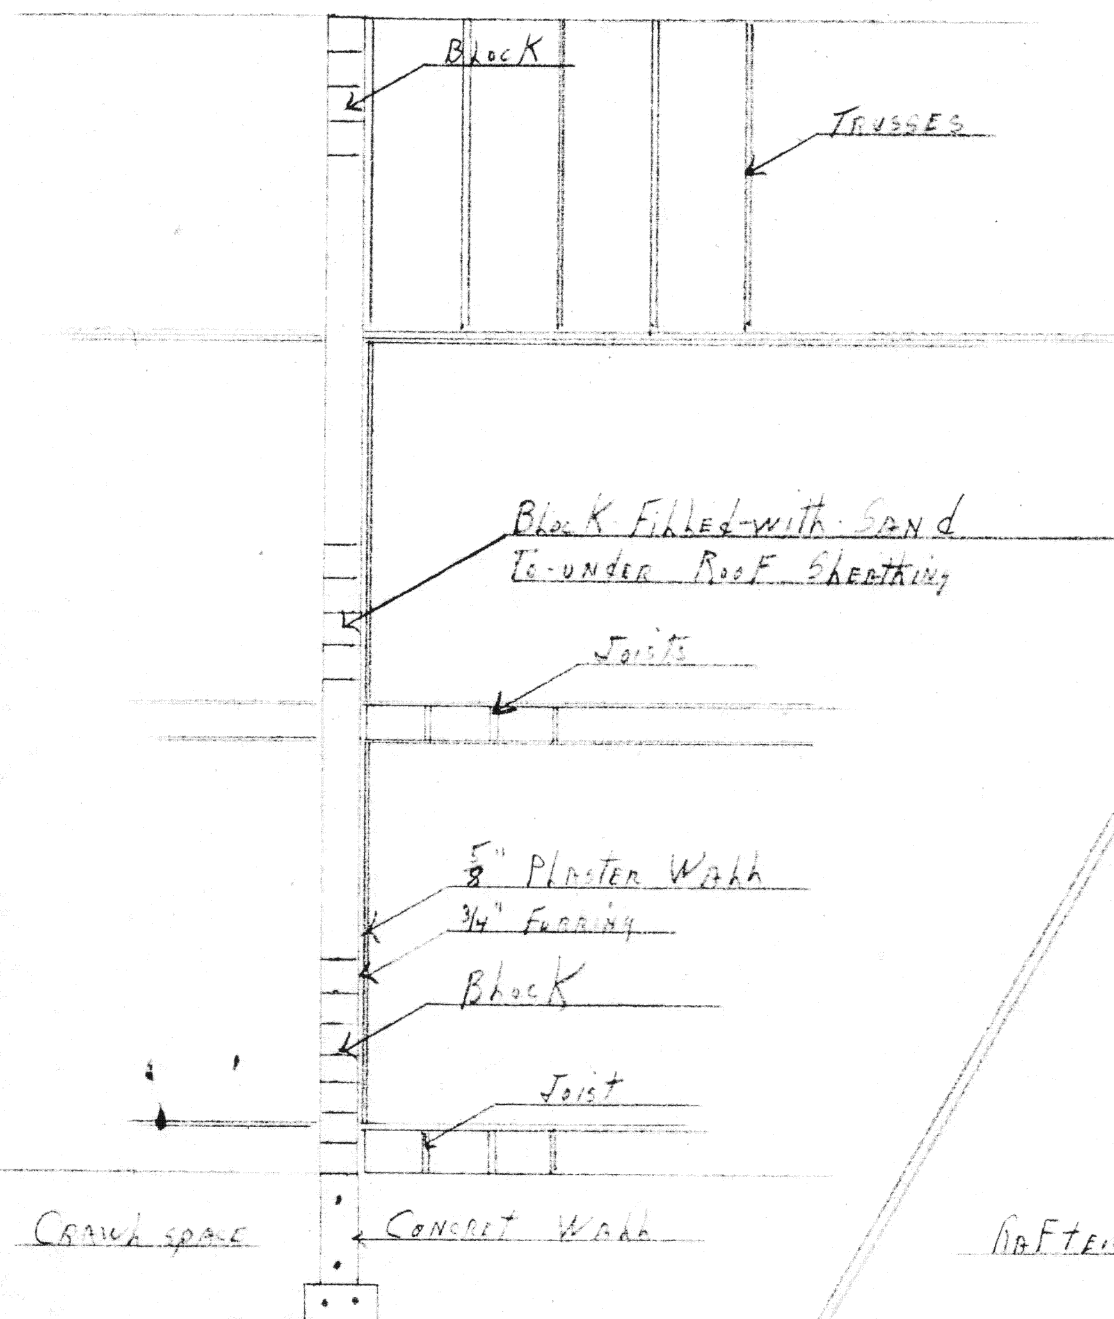

Section E - E
Firewall and Ground
Wall Detail
Scale 1/4" = 1'0"

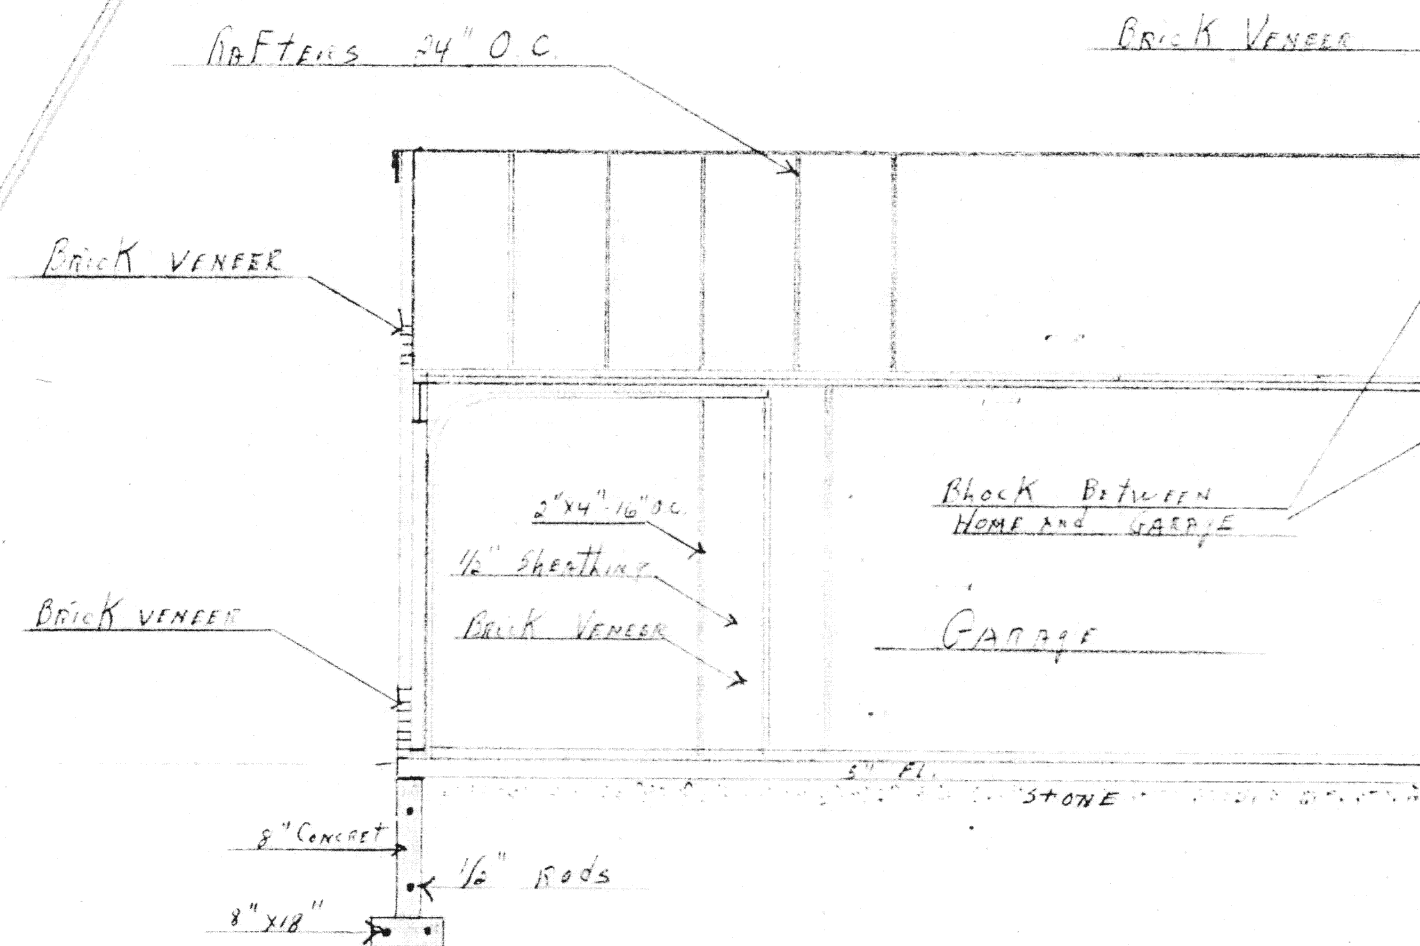


Through Wall Section Unit C.
Scale 1/4" = 1'0"

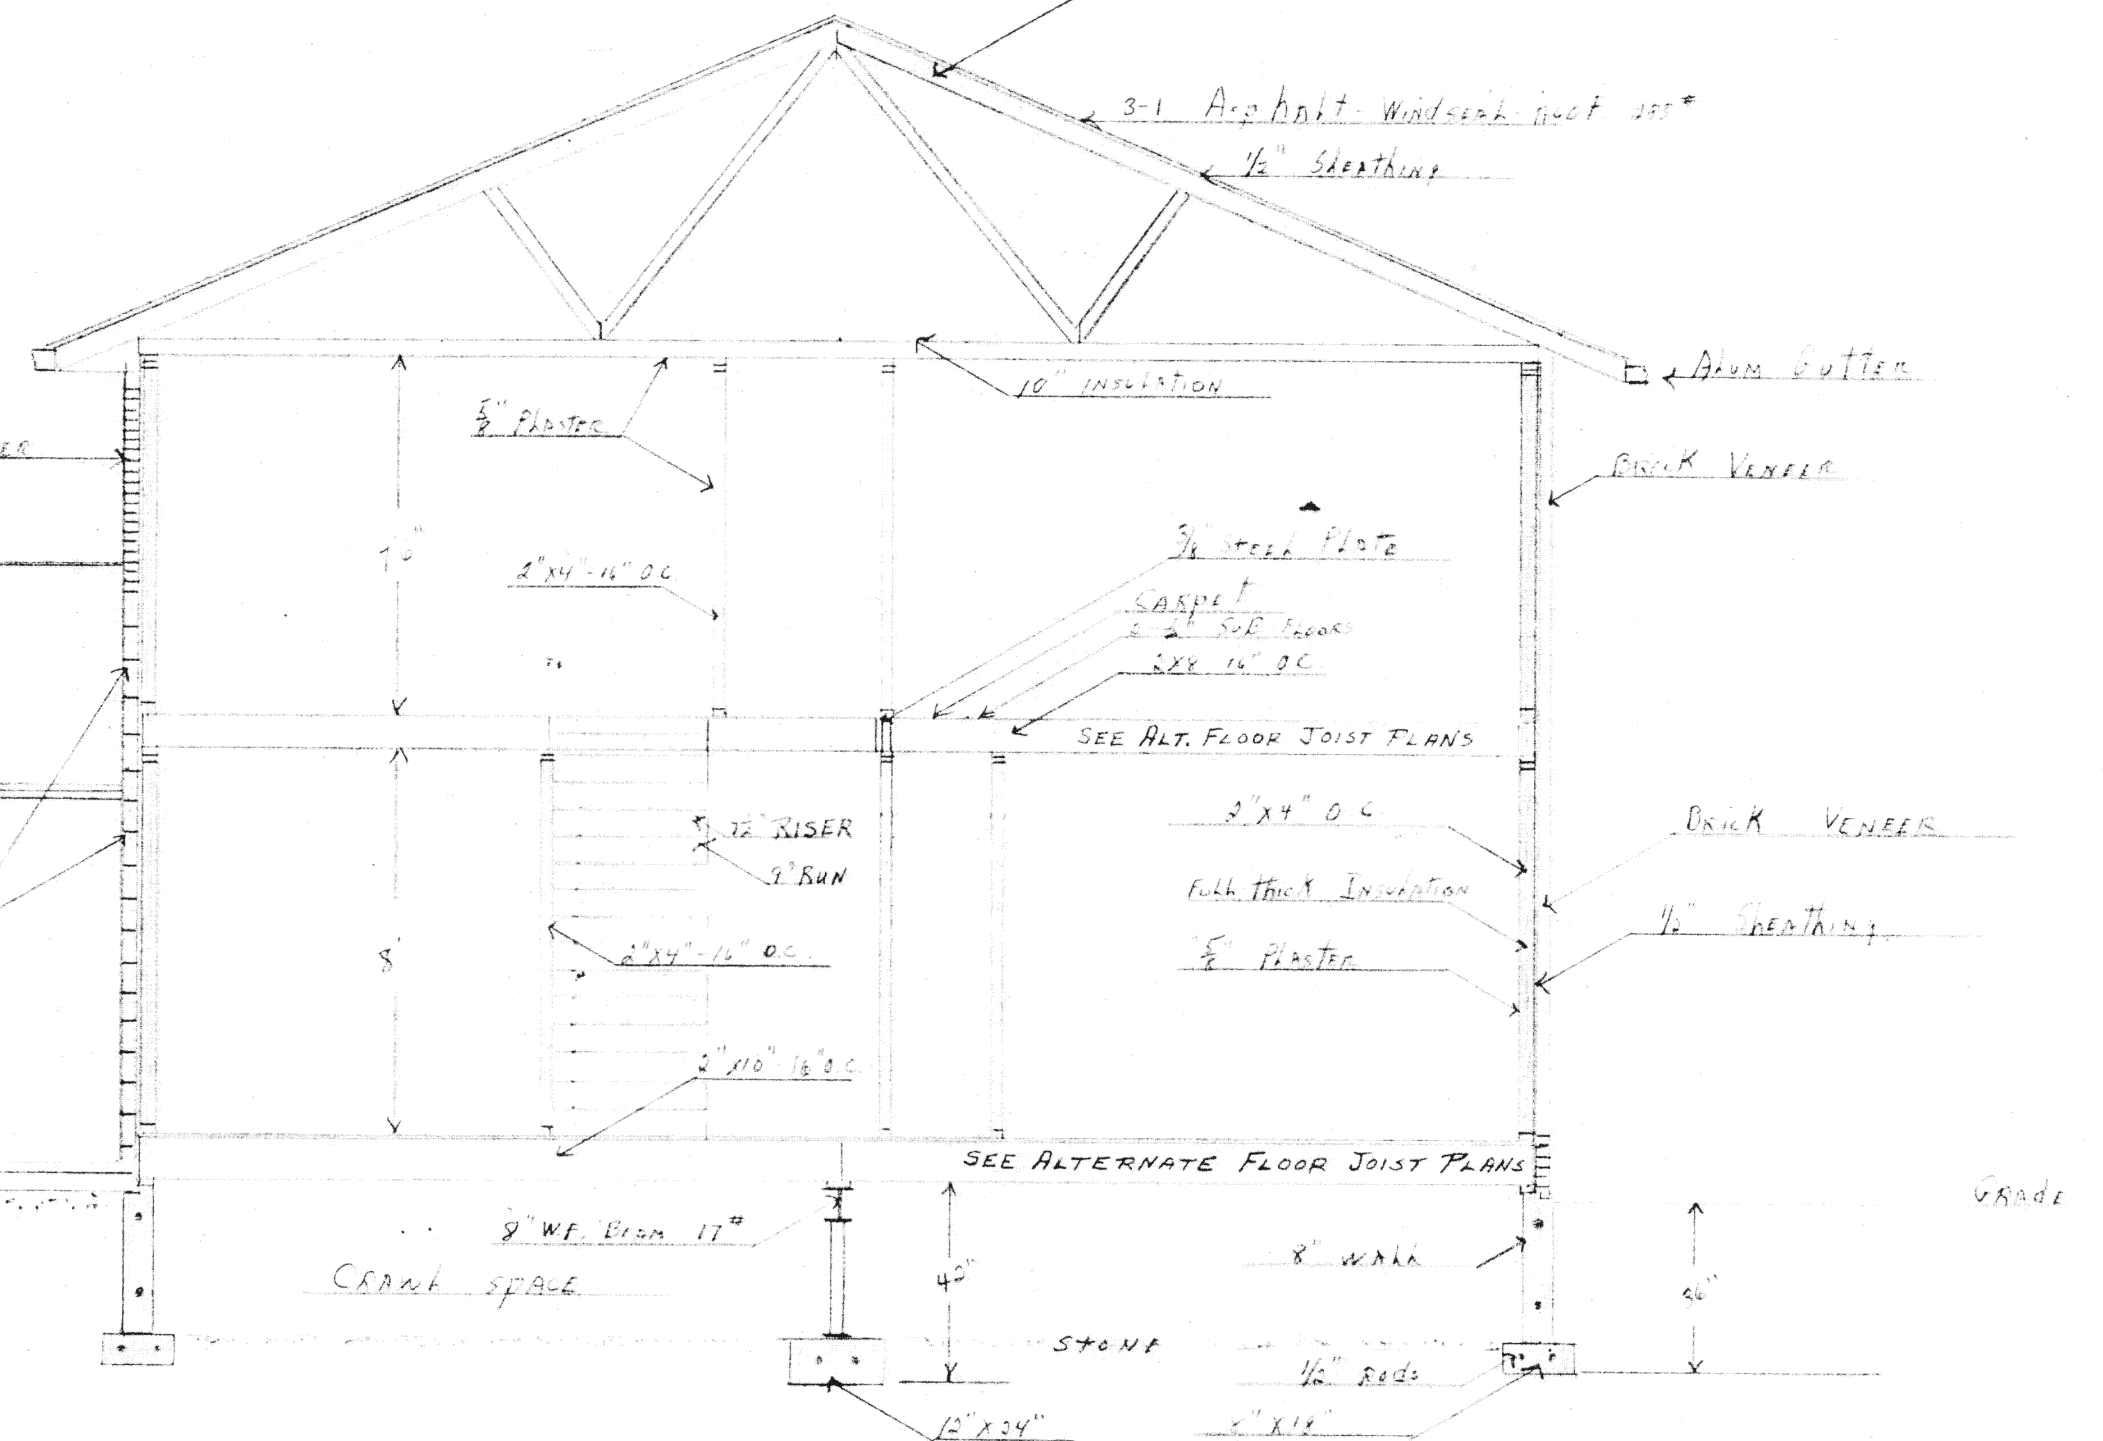


11.17
State of Ohio Auglaize County, S. S.
Received Oct 21 1976
at 11:17 O'clock A. M.
Recorded Oct 21 1976
CABINET No. A Page A-42
830 Le Roy H. Kuse
Recorder, Auglaize Co., Ohio


REVISIONS			Hogson Kamp Condominium		
NO.	DATE	BY	DRAWN BY	SCALE	MATERIAL
1			FFB		
2			CHK'D	DATE	DRAWING NO.
3			TRACED	APP'D	
4					
5					

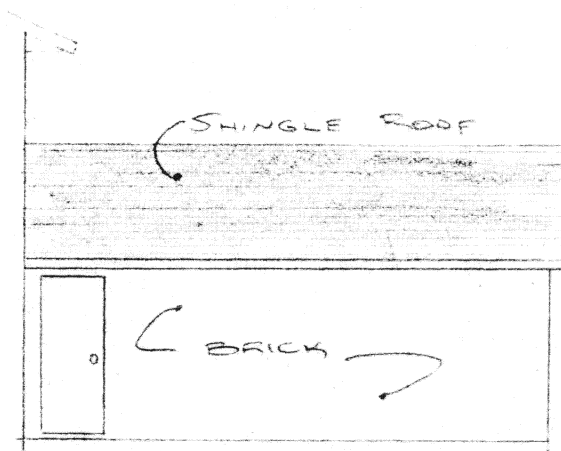


GARAGE - C EAST ELEVATION
SCALE: 1/8" = 1'-0"

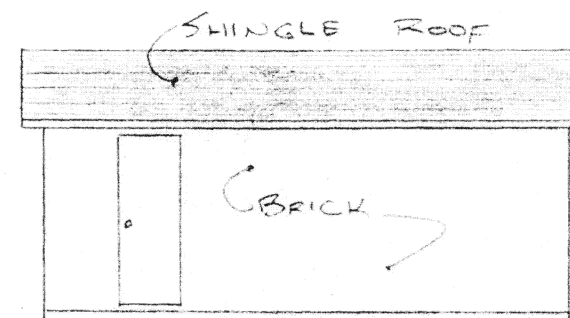


GARAGE - A SOUTH ELEVATION
SCALE: 1/8" = 1'-0"

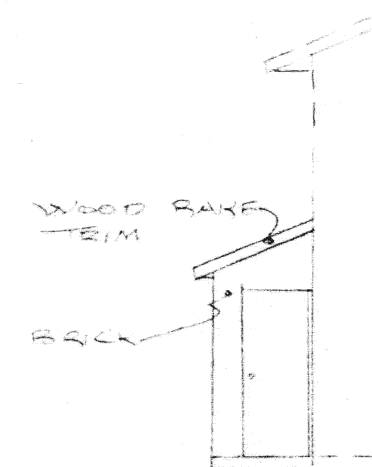


GARAGE - G NORTH ELEVATION
SCALE: 1/8" = 1'-0"

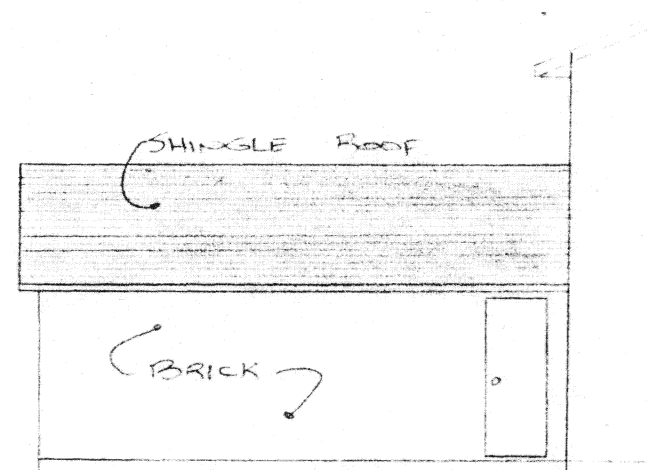


GARAGE - D WEST ELEVATION
SCALE: 1/8" = 1'-0"

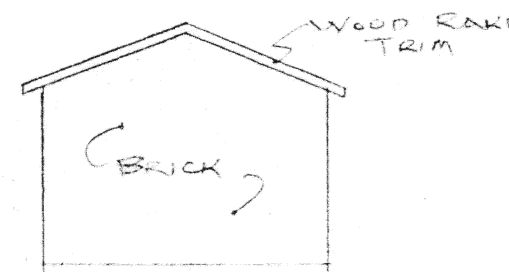

GARAGE - A EAST ELEVATION
SCALE: 1/8" = 1'-0"

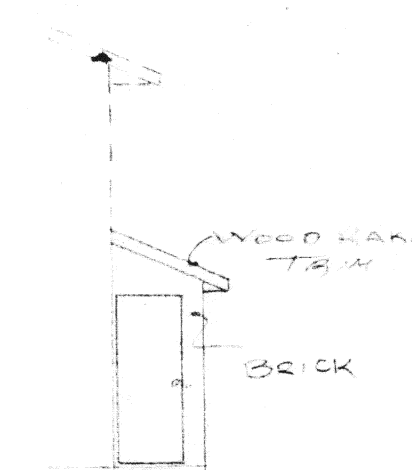

GARAGE - F SOUTH ELEVATION
SCALE: 1/8" = 1'-0"

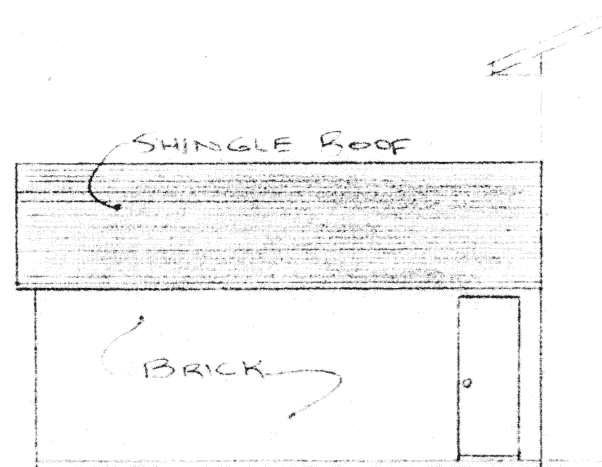

GARAGE - B WEST ELEVATION
SCALE: 1/8" = 1'-0"

146476

11:14

State of Ohio Auglaize County, S. S.

Received O.C.T. 21 1976

at 11:14 O'clock A, M.

Recorded O.C.T. 21 1976

Vol. No. A Page A-42

CABINET

7 839 Le Roy H. Knuse

Recorder, Auglaize Co., Ohio


HOGENKAMP CONDOMINIUMS
MINSTER, OHIO

GARAGE ELEVATIONS


L. A. POHL ENGINEERING LTD.
LIMA, OHIO

DATE
17 Oct 76


DRAWING No.
E-76002-4

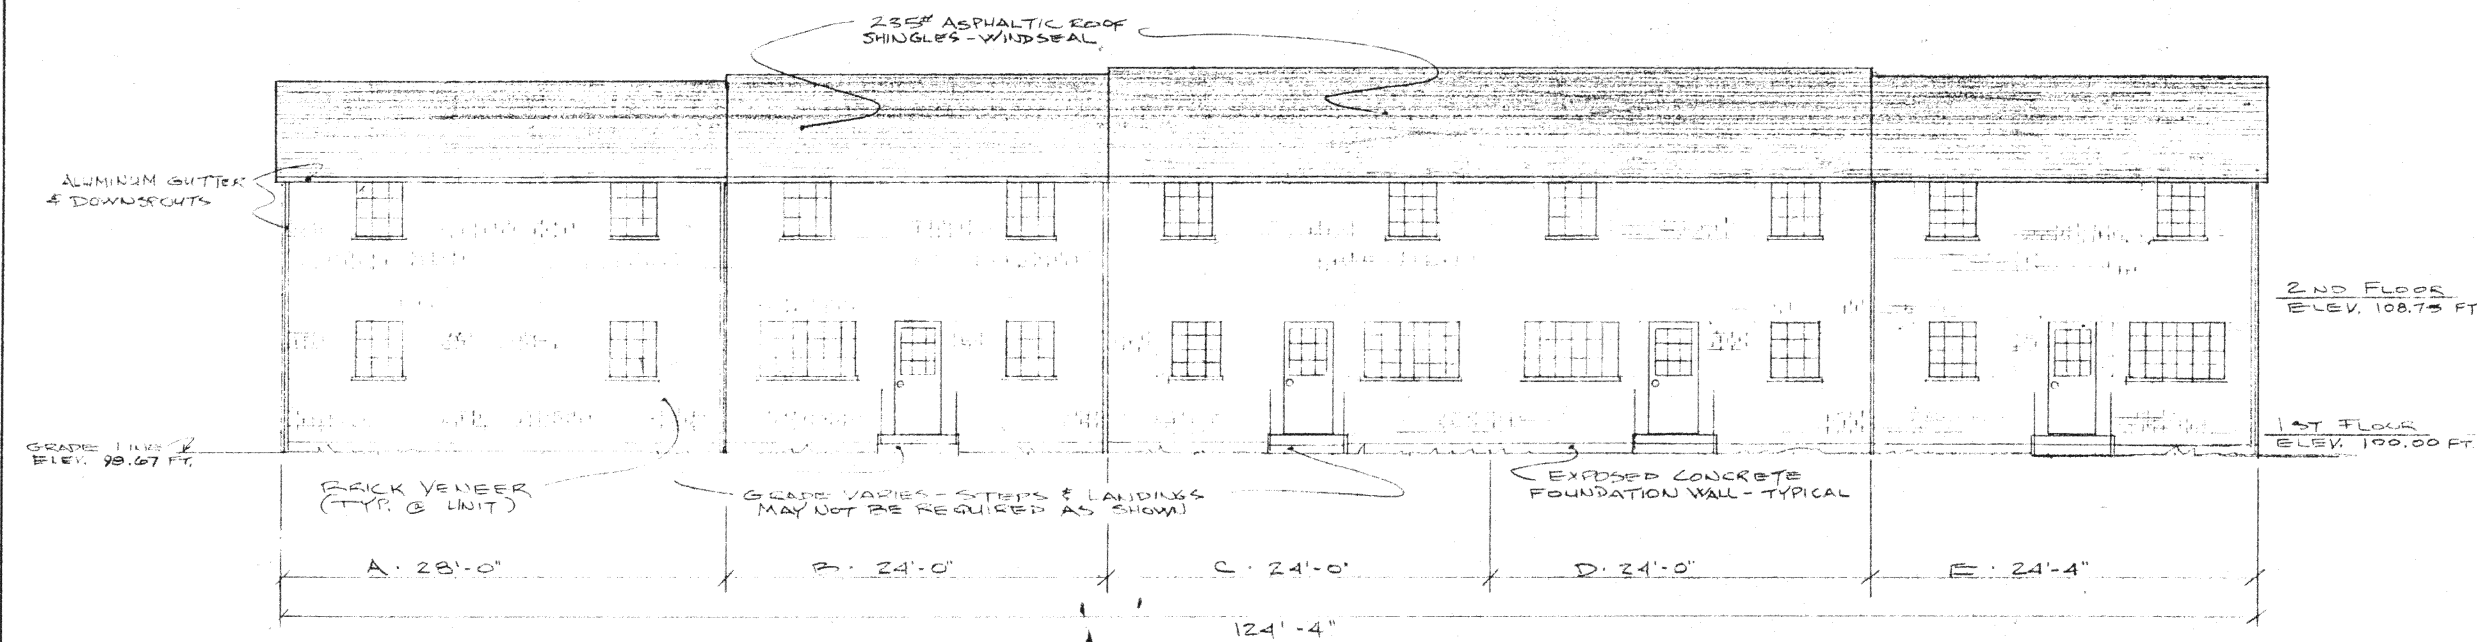

SOUTH ELEVATION
SCALE: 1/8" = 1'-0"

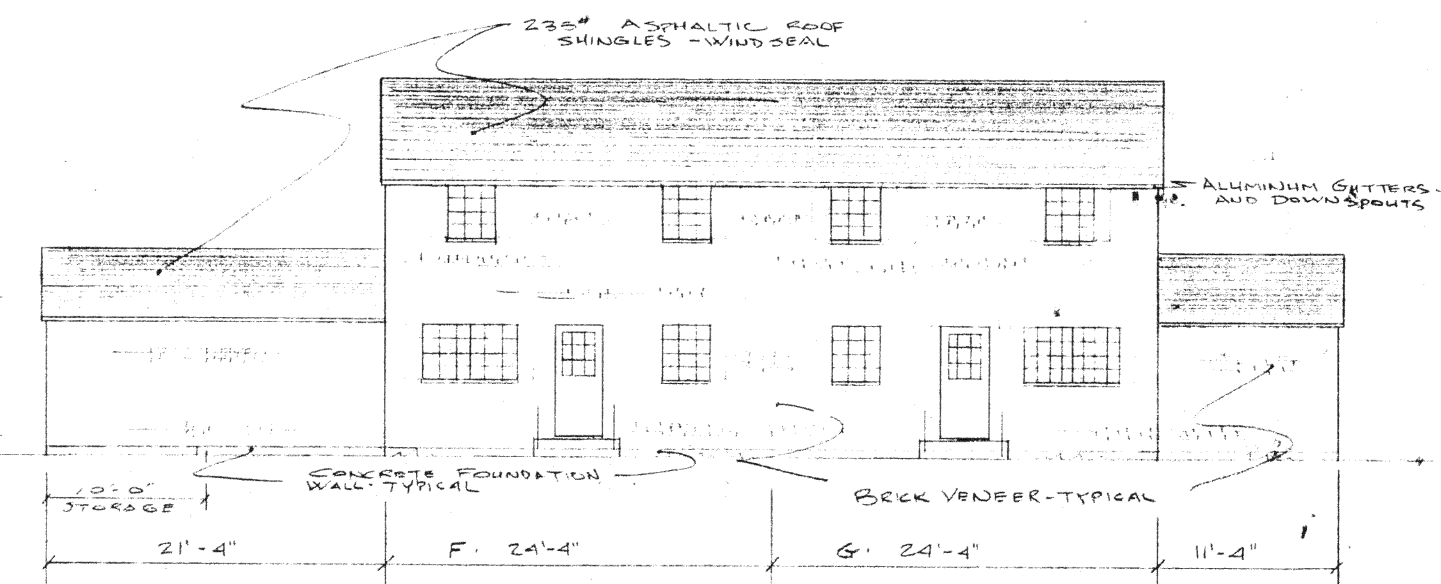


WEST ELEVATION
SCALE: 1/8" = 1'-0"

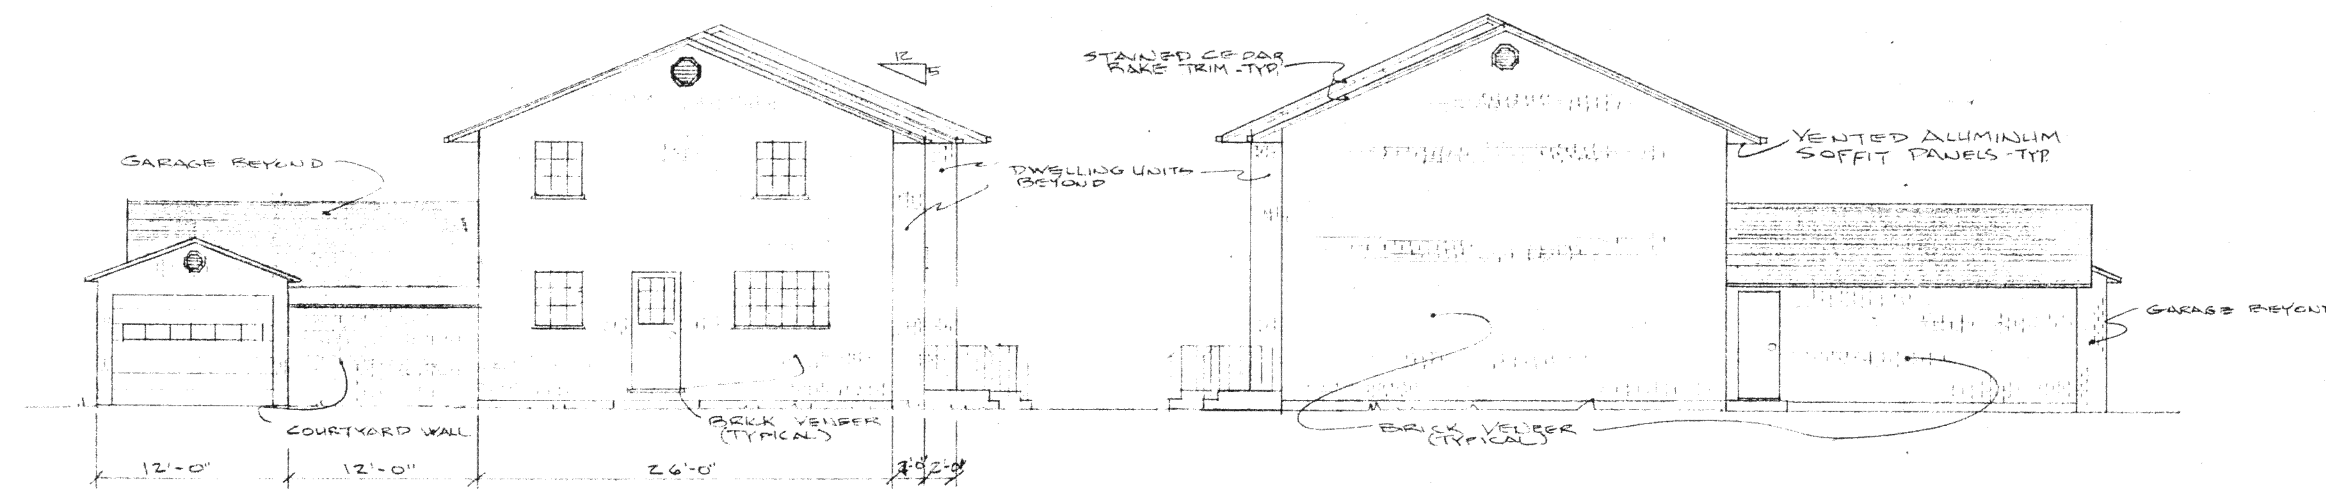


WEST ELEVATION
SCALE: 1/8" = 1'-0"

EAST ELEVATION
SCALE: 1/8" = 1'-0"

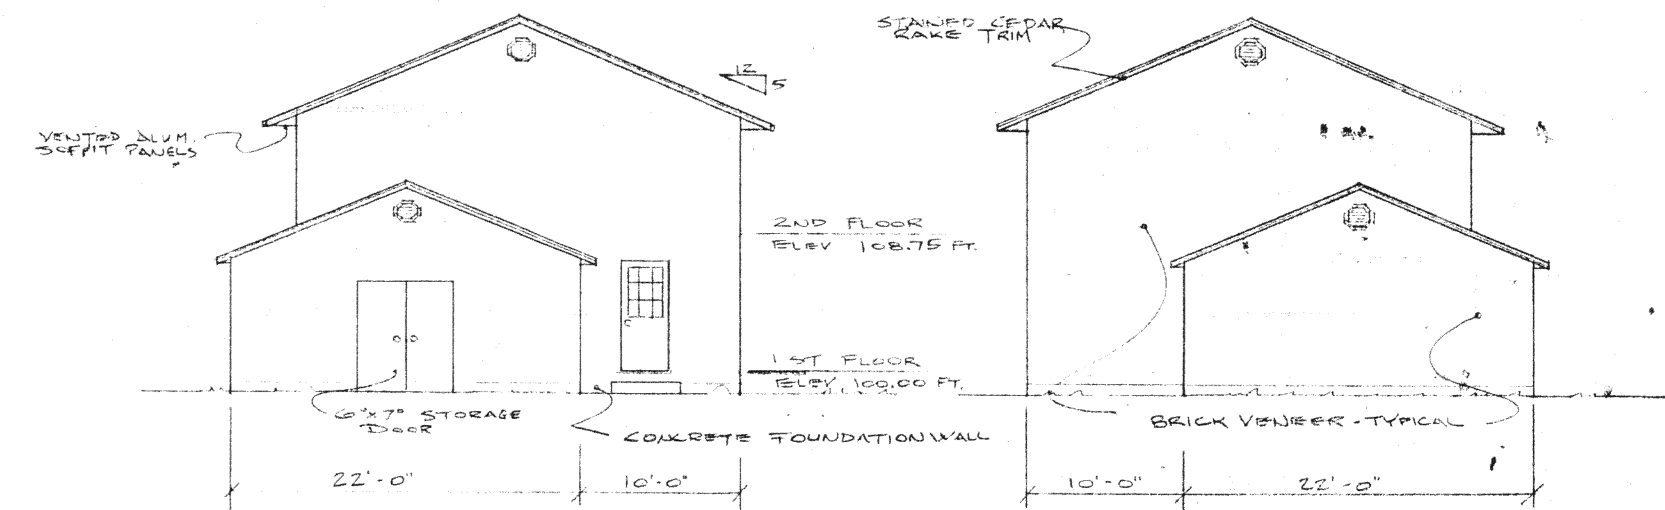


NORTH ELEV.
SCALE: 1/8" = 1'-0"

SOUTH ELEV.
SCALE: 1/8" = 1'-0"

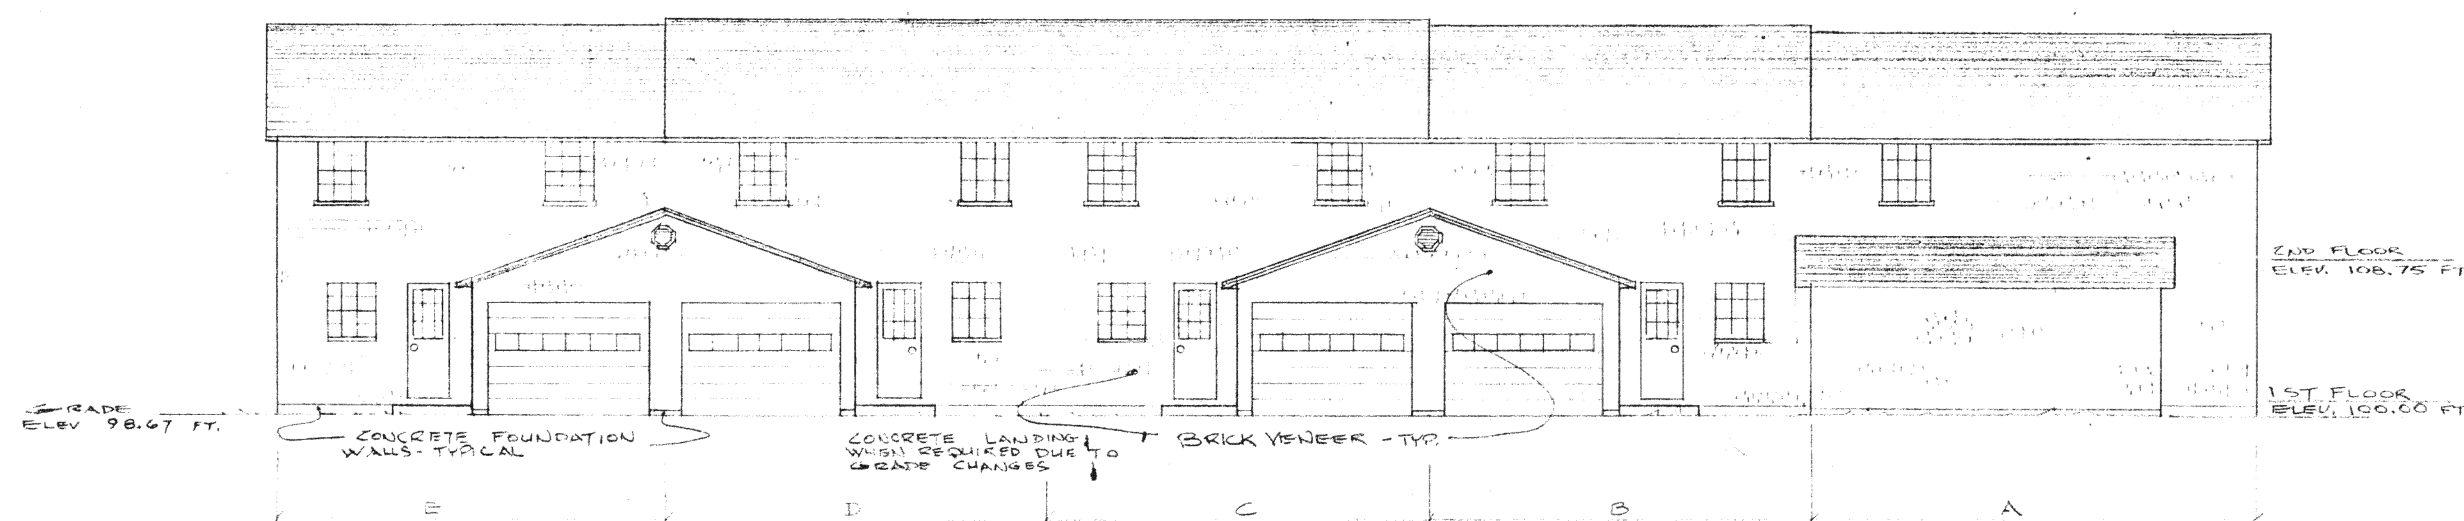

NORTH ELEVATION
SCALE: 1/8" = 1'-0"

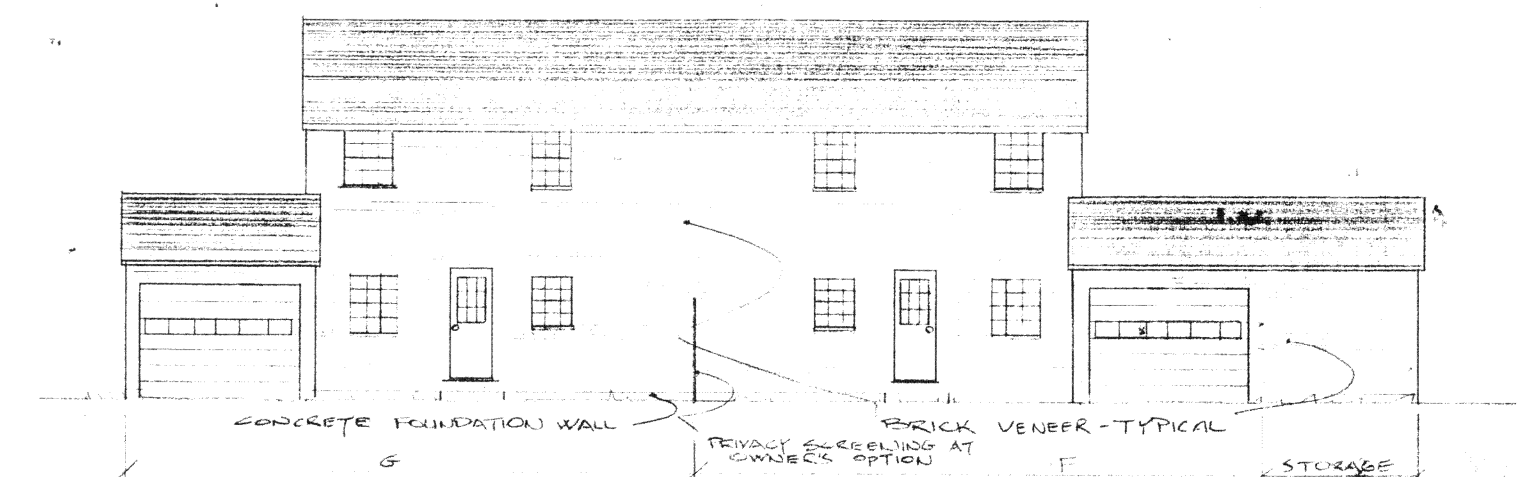

EAST ELEVATION
SCALE: 1/8" = 1'-0"


BUILDING NO. 1 - A, B, C, D, E

146477

BUILDING NO. 2 - F, G

11:16
State of Ohio Auglaize County, S. S.
Received Oct. 21 1976
at 11:16 O'clock A.M.
Recorded Oct. 21 1976
CABINET No. A Page A-42
8/8
Recorder, Auglaize Co., Ohio

HOGENKAMP CONDOMINIUMS		DATE: 13 APR 76	DRAWING NO: E-76002-1
MINSTER, OHIO	OHIO	APPROVED:	
ROGER BORNHORST	MINSTER, OHIO	SCALE: AS NOTED	
L.A. POHL ENGINEERING LTD.	LIMA, OHIO		

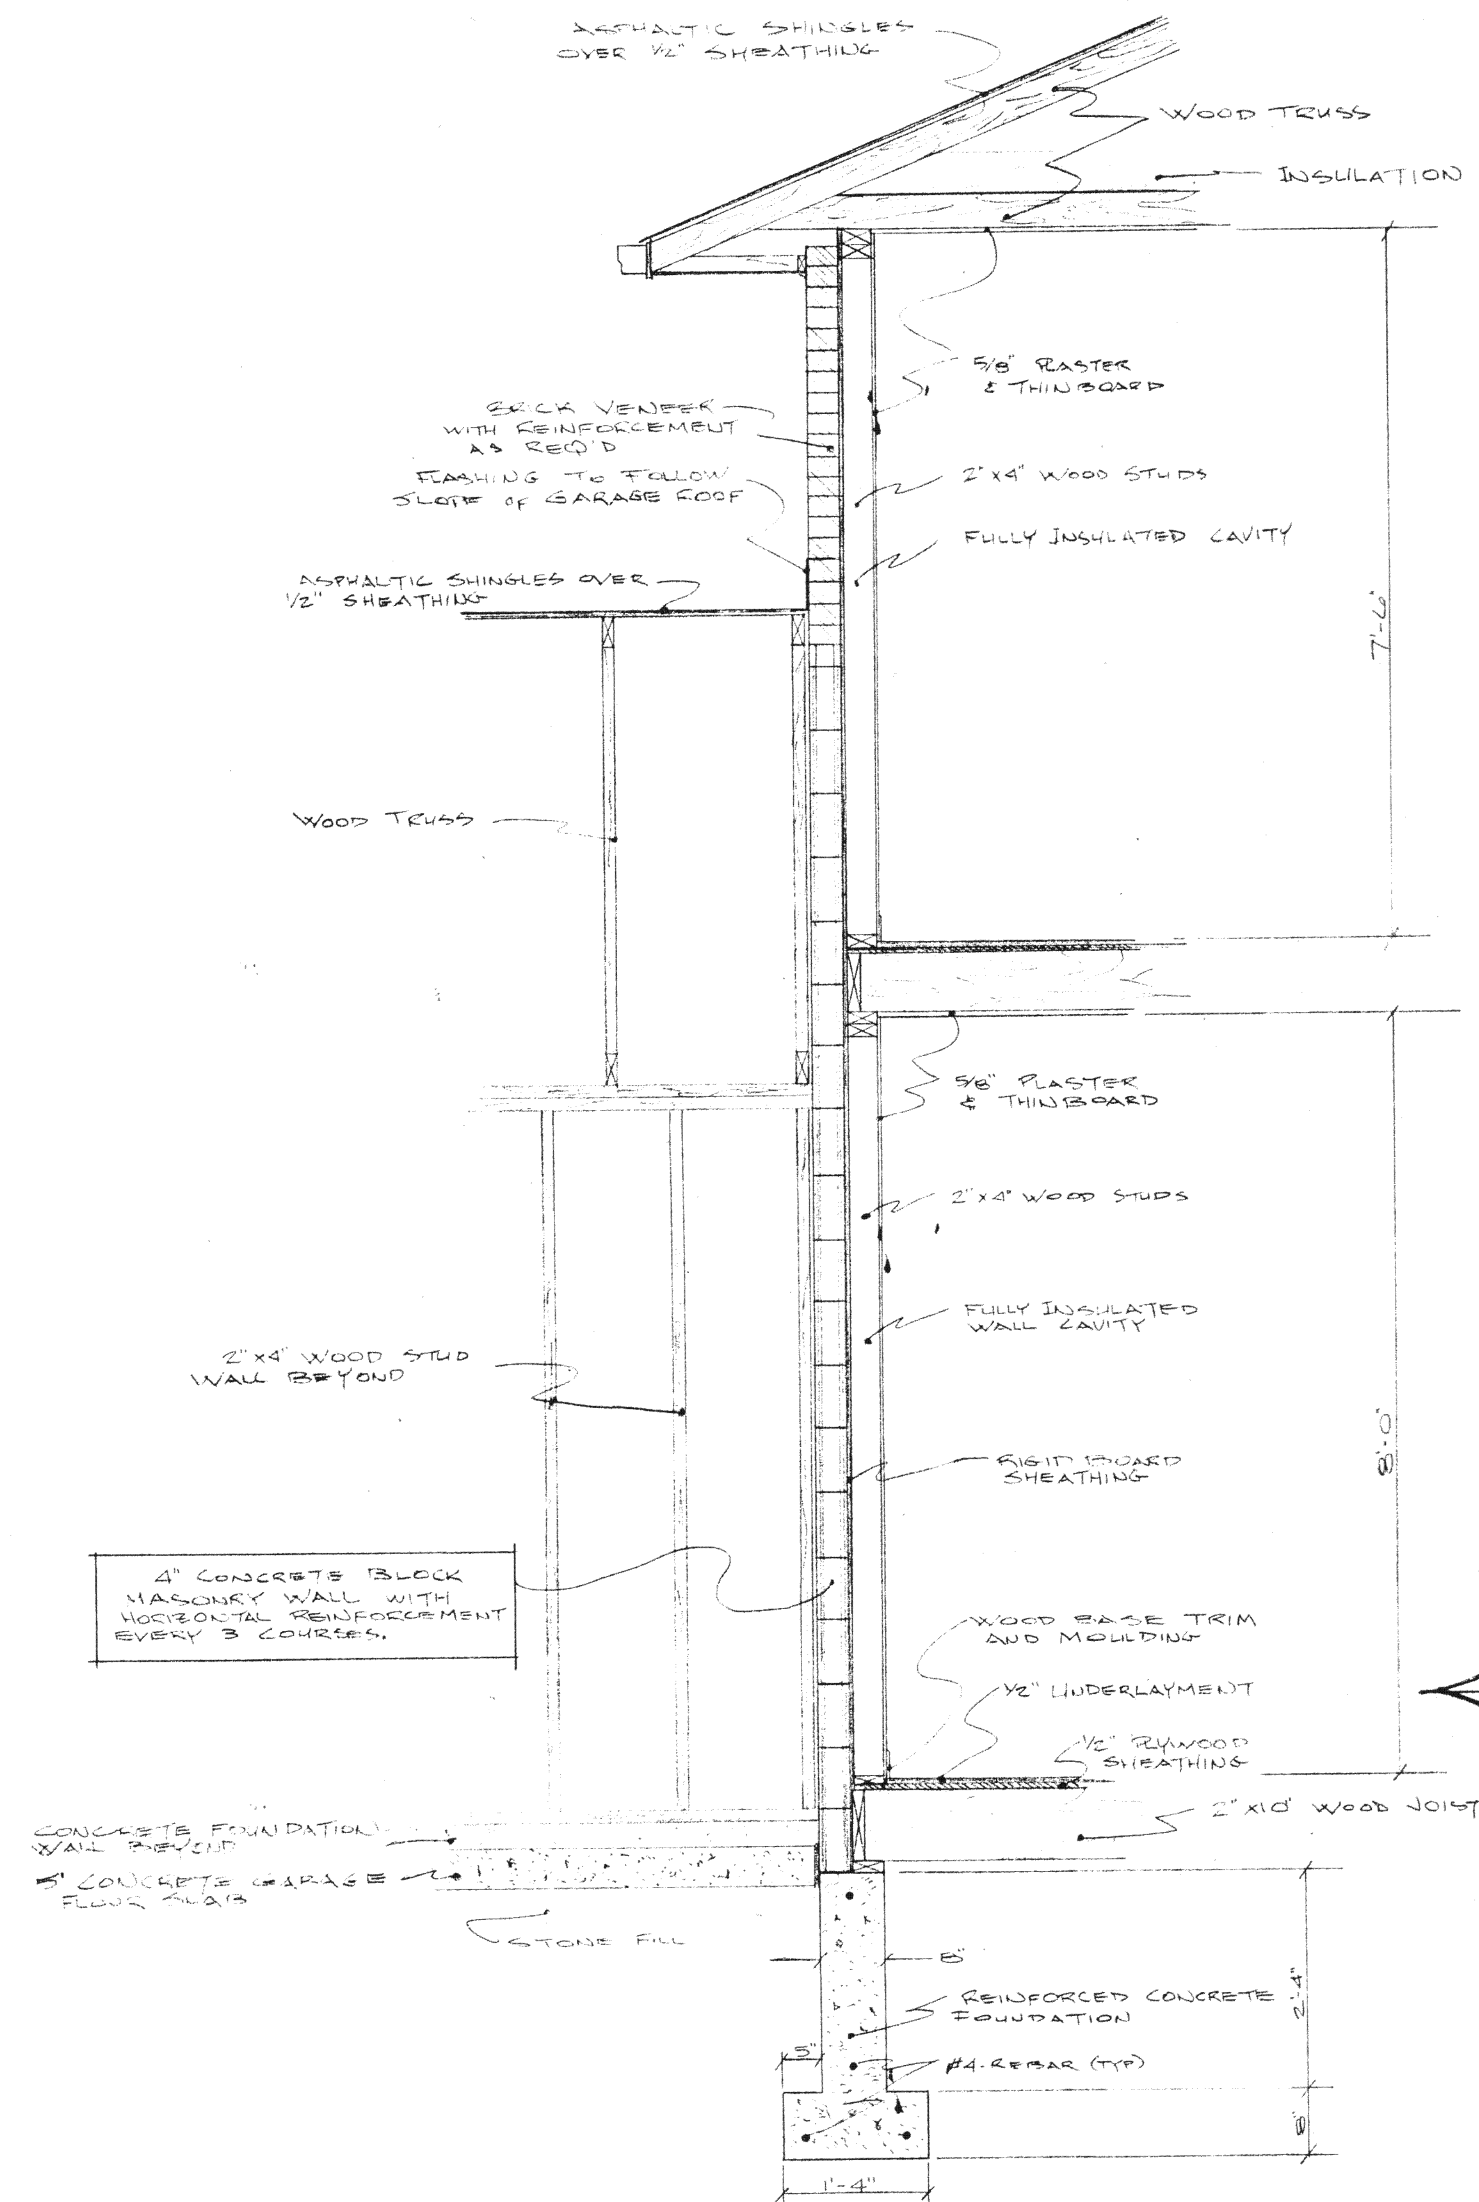


TYPICAL GARAGE-LIVING UNIT SEPARATION WALL

SCALE: 3/4" = 1'-0"

146478

11/14 State of Ohio Auglaize County, S.S.
 Received OCT 21 1976
 at 11:19 O'clock H.M.
 Recorded OCT 21 1976
 Not. No. H. Page H-42
 832
 L. A. Pohl
 Recorder, Auglaize Co., Ohio

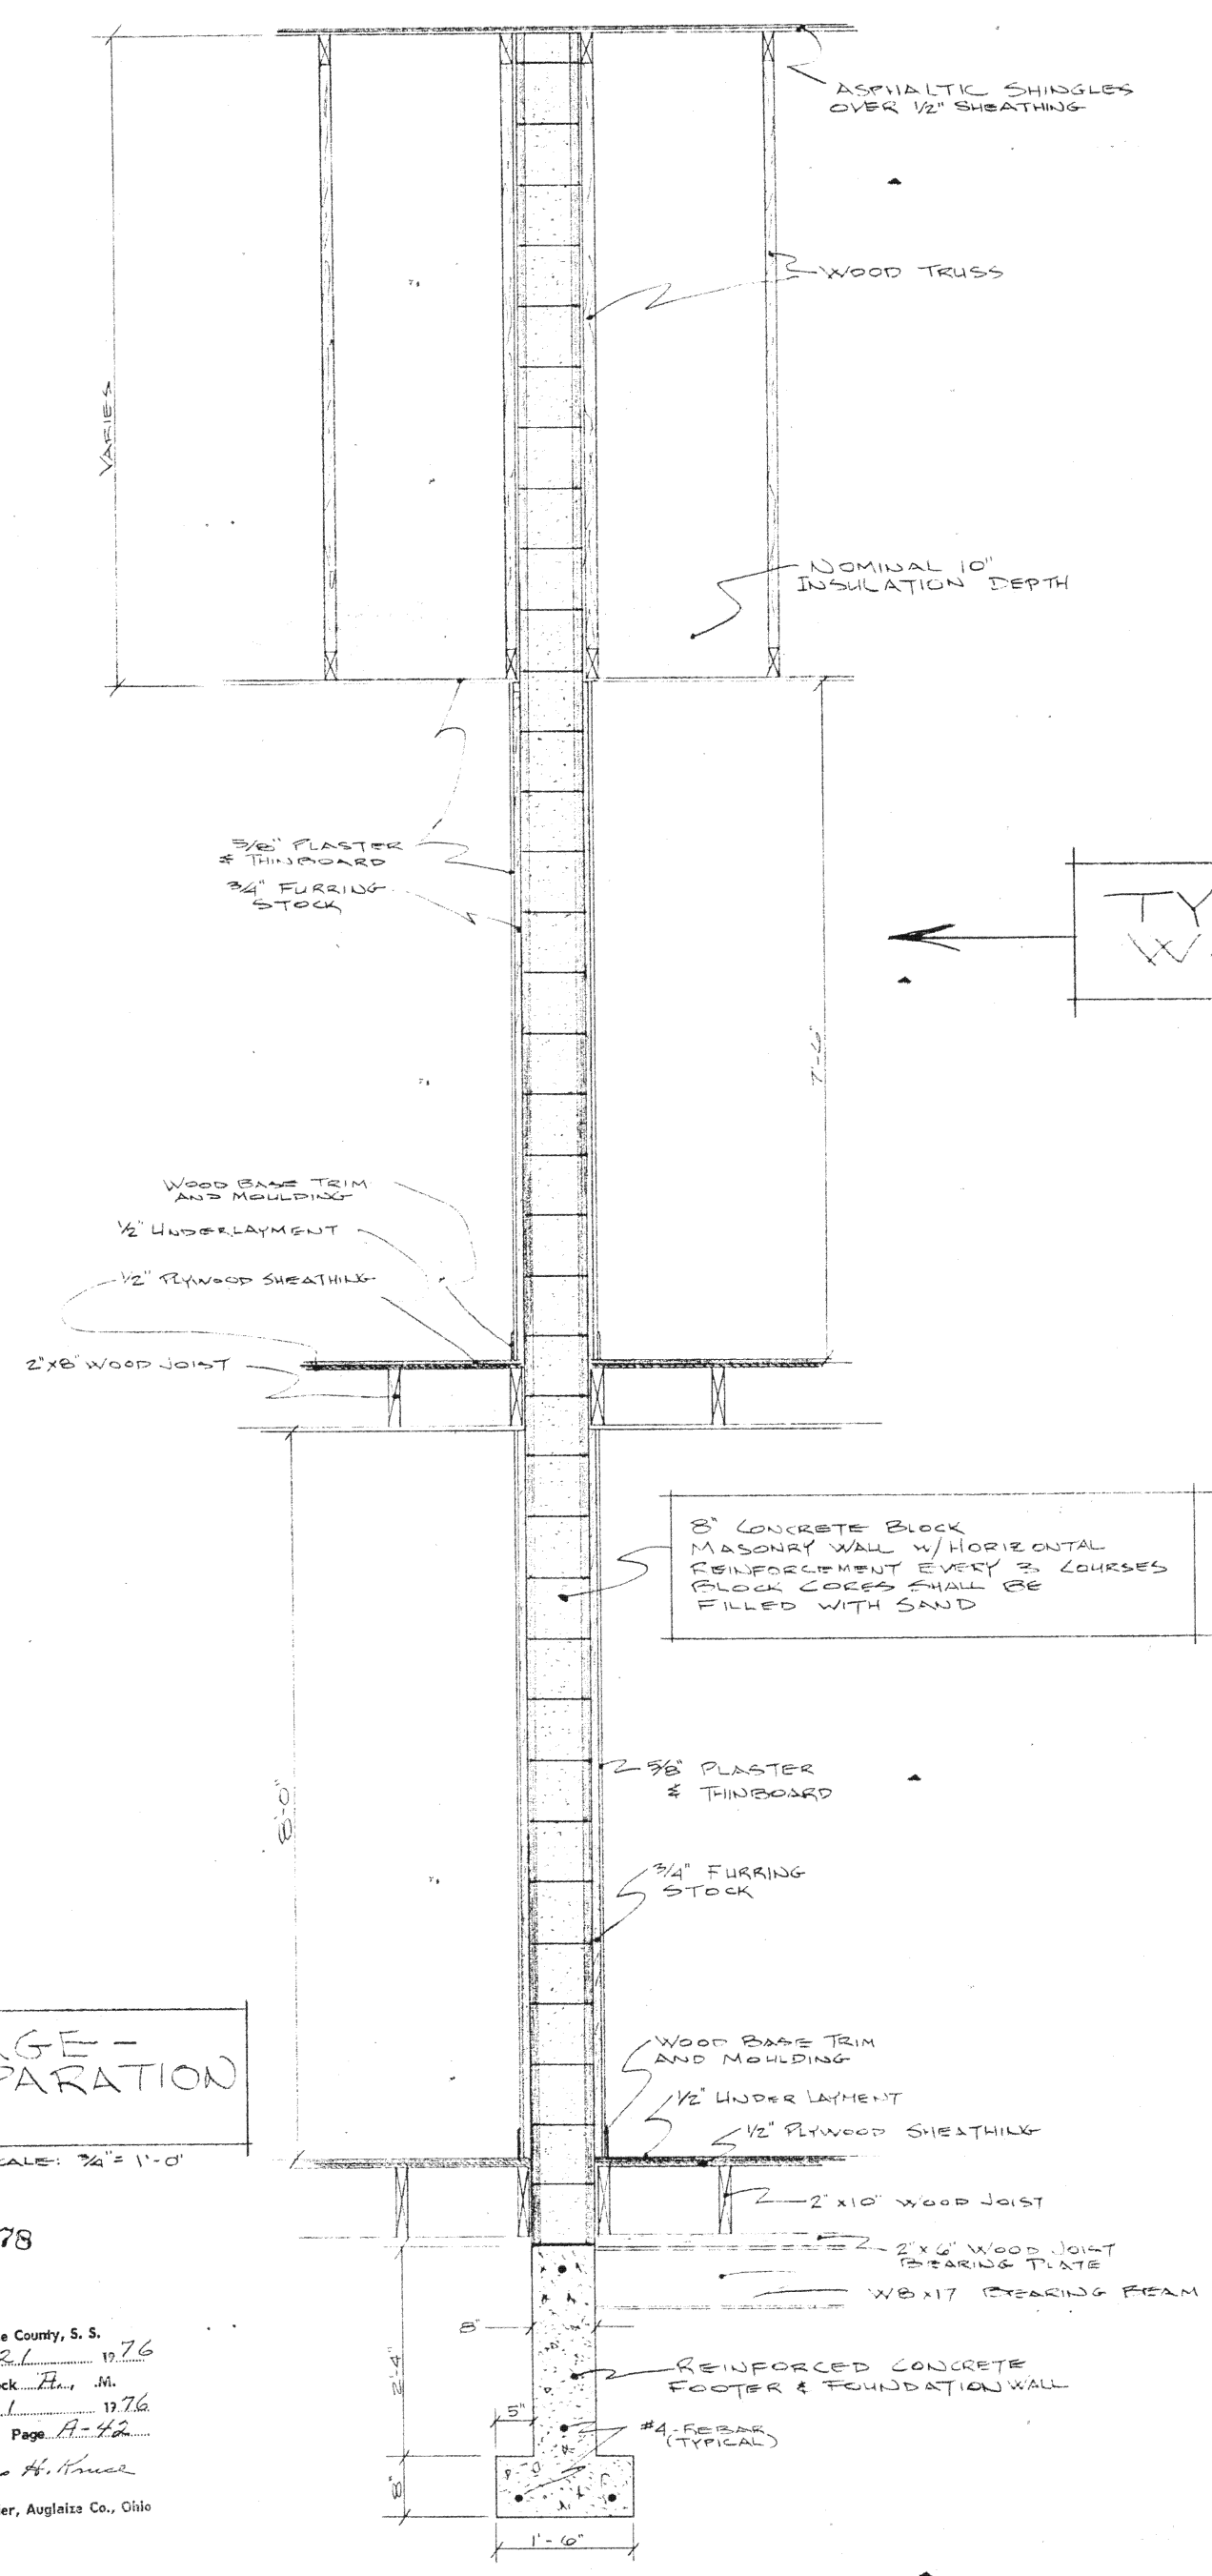

TYPICAL PARTY WALL

SCALE: 3/4" = 1'-0"

HOGENKAMP CONDOMINIUMS		MINSTER 3	OHIO
ROGER BORNHORST		MINSTER 2	OHIO
L. A. POHL ENGINEERING LTD.		LIMA, OHIO	
DATE: 3 APR 76	APPROVED:	DRAWING NO: E-76002-2	