


SURVEY ROUTE 501
VOL 9 PAGE 331
150.00

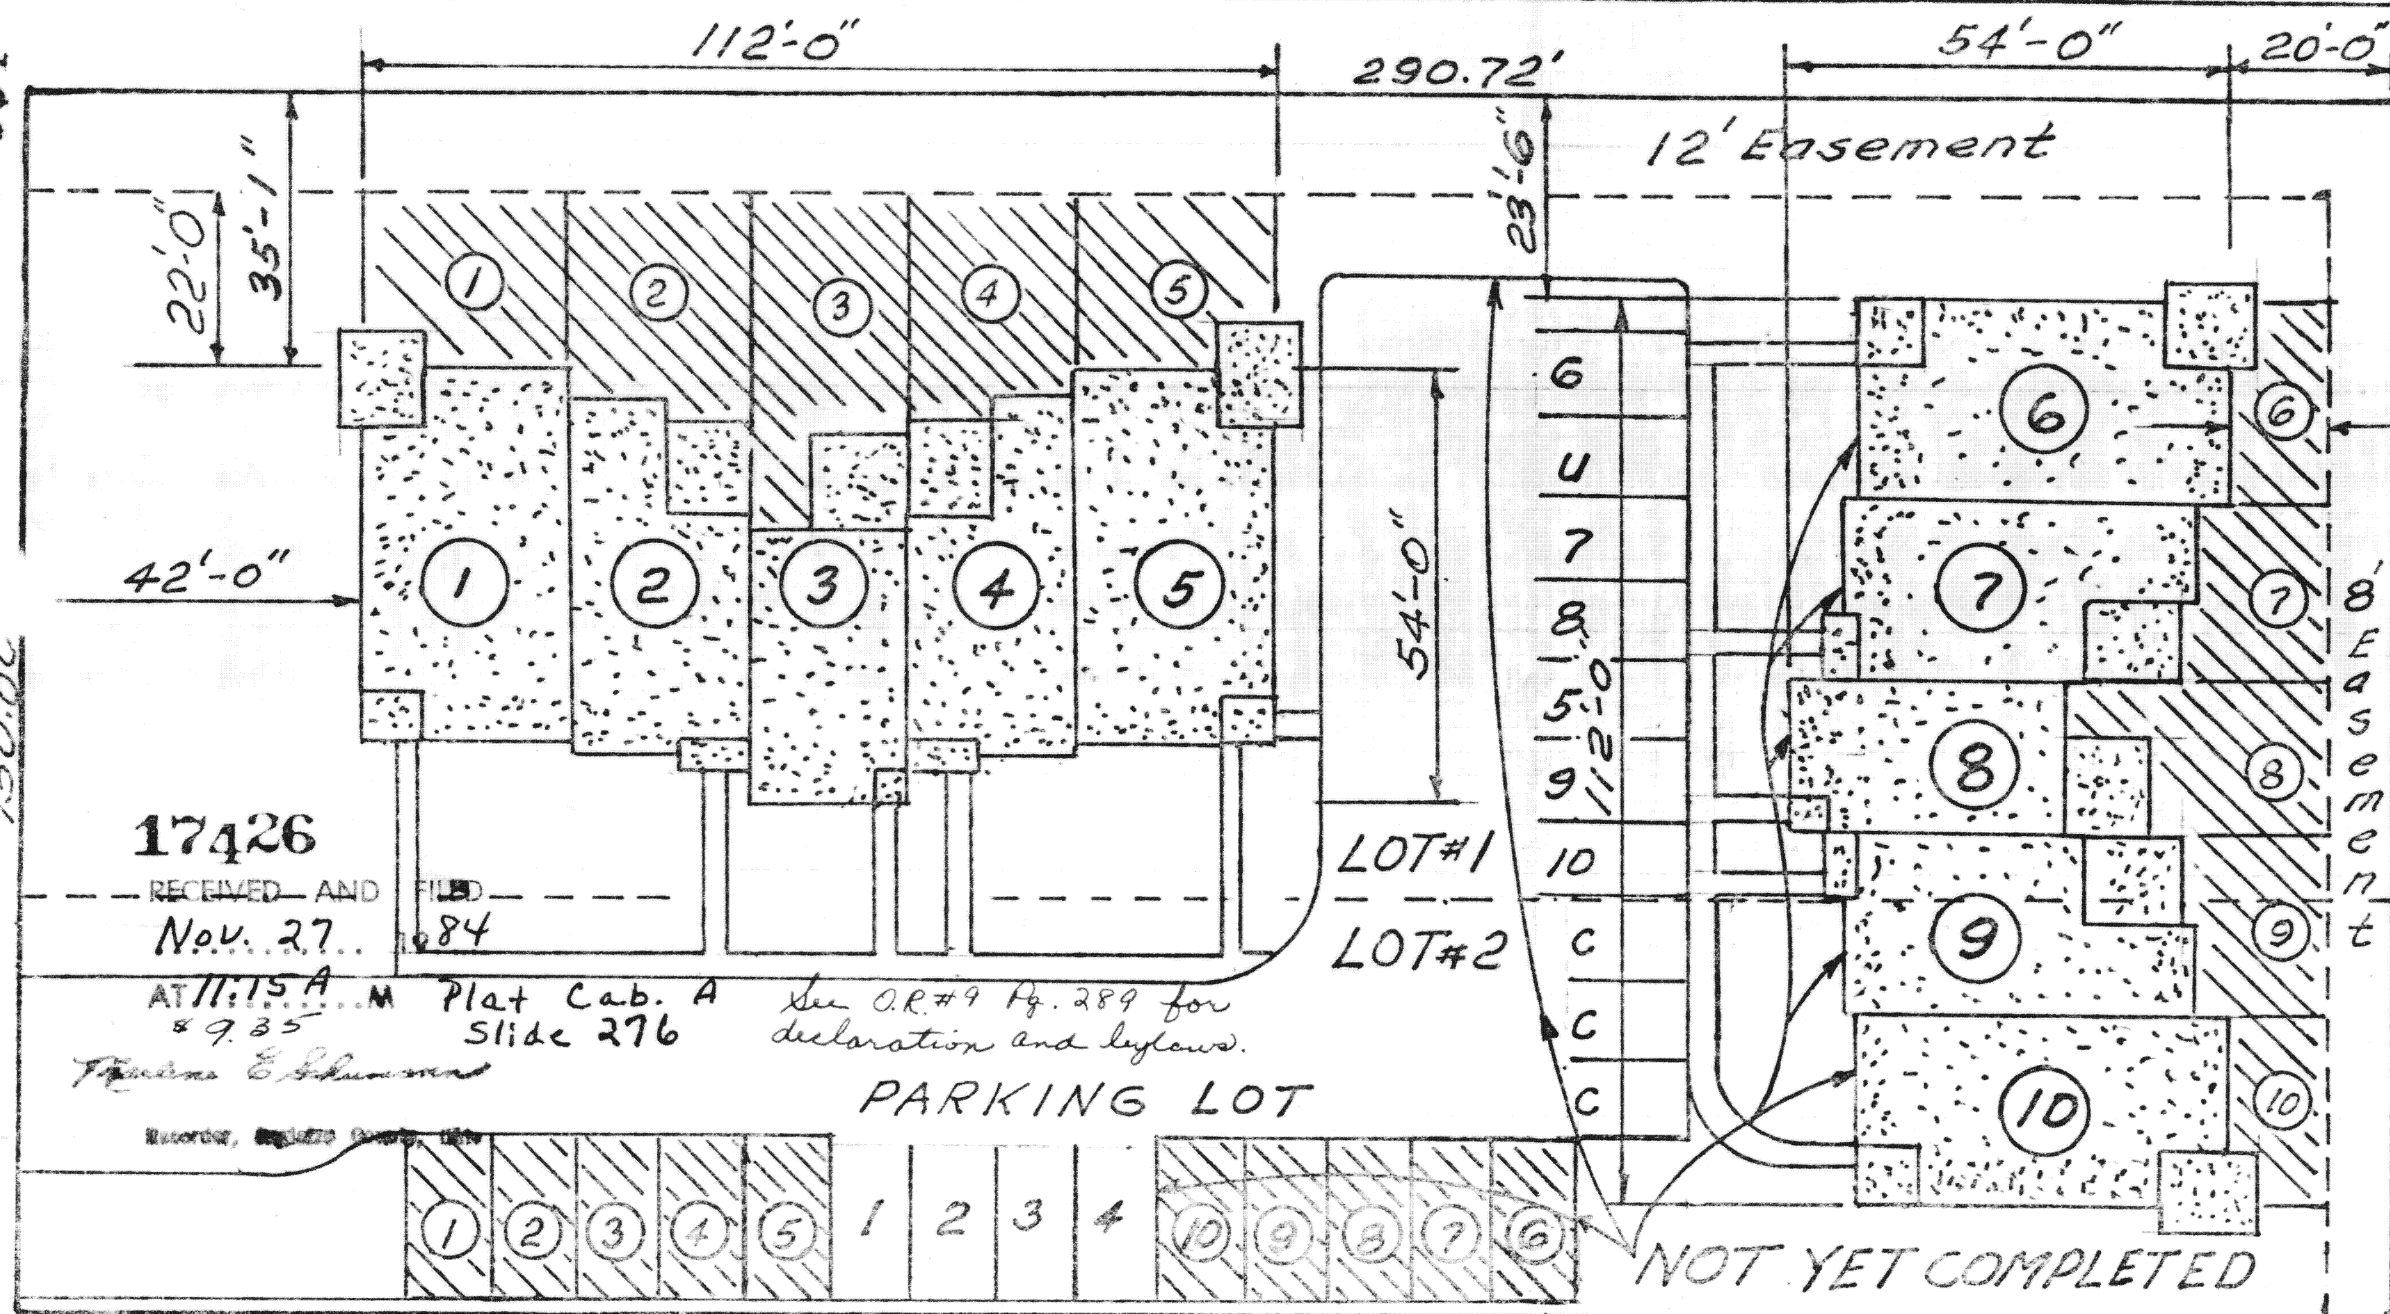

SCALE
1" = 30'

- UNITS
- LIMITED COMMON AREA
- COMMON AREA

① Number in Limited Common Area designates assignment of area or sheltered parking space to a single unit.

LEGAL DESCRIPTION

Situated in the City of Wapakoneta, County of Auglaize and State of Ohio, to-wit: Being Lot # one (1) and Fifty (50) feet off of the entire north side of Lot # two (2) in Bramblewood Subdivision as numbered and delineated on the plat of record at Plat Cabinet A pages 37-A and 38-A in the office of the Auglaize County Recorder.

CERTIFICATE

We hereby certify that the hereon description describes the Quail Run Condominium and that the within drawings show the dimensions of the buildings, as constructed, and that the locations thereof with respect to the boundaries are shown.

Michael P. Woodak
Registered Surveyor #6199
Kenneth Hegemann
Registered Engineer #30181

CONSENT 290.71'

We the undersigned being the Owners of the fee simple titles of the the lands herein described, hereby consent to and join the submission of said land and our interest therein to the Condominium Plan known as QUAIL RUN CONDOMINIUM as set forth in the Declaration of Condominium and the By-Laws and Articles of Incorporation of the Condominium Unit Association, as recorded with the Recorder of Auglaize County under the Condominium Statutes of the State of Ohio.

Owners
BLUE SKY DEVELOP. CORP. INC. WITNESSES

PRESIDENT: *Robert E. Katterhenry*
SECRETARY: *Anne E. Katterhenry*

NOTARY

STATE OF OHIO COUNTY OF AUGLAIZE
Be it remembered on this 23RD day of NOVEMBER 1984 before me a Notary Public in and for said Auglaize County appeared Robert E. Katterhenry, Pres. and Anne E. Katterhenry, Sec. of the BLUE SKY DEVELOP. CORP., INC., who acknowledge this signing of this Condominium Plat Plan to be their voluntary act and deed of BLUE SKY DEVELOP. CORP., INC.
In testimony whereof I hereunto set my hand and affix my Notarial Seal on the day and date aforesaid.
[Signature]
Notary Public My Commission expires

QUAIL RUN
CONDOMINIUM
EXHIBIT - "C"
By: *K.L. Hegemann* 7/2/84