
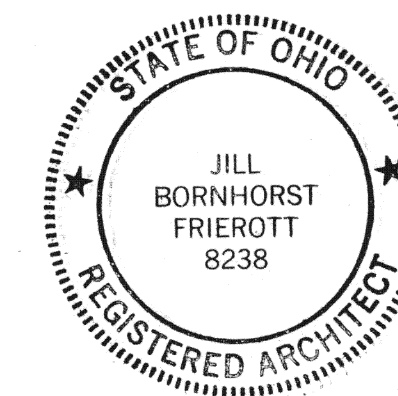


☐ A CONDOMINIUM UNIT
☒ LIMITED COMMON AREA

6206 RECEIVED
 87 NOV -14 AM 10:43
 MARLENE SCHUMANN
 AUGLAIZE CO. RECORDER

THIS IS TO CERTIFY THAT A COPY OF THIS PLAT HAS BEEN FILED WITH THE AUGLAIZE COUNTY, OHIO, AUDITOR.

Karyn Schumann
 COUNTY AUDITOR

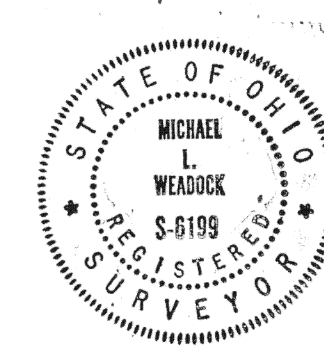

THE MEASUREMENTS ARE CERTIFIED TO BE CORRECT AND THESE DRAWINGS ACCURATELY SHOW THE BUILDINGS AS CONSTRUCTED.

Michael L. Weadock
 MICHAEL L. WEADOCK
 REGISTERED SURVEYOR #6199

Jill B. Frierott
 JILL B. FRIEROTT
 REGISTERED ARCHITECT #8238

I, THE UNDERSIGNED, BEING THE OWNER, DO HEREBY CONSENT TO AND JOIN IN THE SUBMISSION OF THE LANDS HEREIN DESCRIBED AND HER INTERESTS THEREIN TO THE CONDOMINIUM PLAN KNOWN AS ST. AUGUSTINE CONDOMINIUM AS SET FORTH IN THE DECLARATION OF SUCH CONDOMINIUM TO BE FILED WITH THE RECORDER OF AUGLAIZE COUNTY, OHIO, UNDER THE CONDOMINIUM STATUTES OF THE STATE OF OHIO.

Kay Dierksen
 WITNESS

Connie L. Prenger
 CONNIE L. PRENGER

Melinda Cordover
 WITNESS

STATE OF OHIO: SS
 AUGLAIZE COUNTY

BE IT REMEMBERED THAT ON THIS 29th DAY OF October 1987, BEFORE ME THE UNDERSIGNED A NOTARY PUBLIC IN AND FOR SAID STATE, PERSONALLY CAME CONNIE L. PRENGER WHO ACKNOWLEDGED THE SIGNING AND EXECUTION OF THE FOREGOING PLAN TO BE HER VOLUNTARY ACT AND DEED. IN TESTIMONY WHEREOF, I HAVE SET MY HAND AND NOTARIAL SEAL ON THE DATE ABOVE WRITTEN.

Melinda Cordover
 NOTARY PUBLIC

CONNIE L. PRENGER
 Notary Public, State of Ohio
 My Commission Expires Feb. 8, 1990

THE PERCENT INTEREST IN THE COMMON AREA WHICH IS OWNED BY EACH UNIT IS SET FORTH IN THE CONDOMINIUM DECLARATION TO WHICH A SMALL SCALE OF THIS DRAWING IS ATTACHED.

THE DECLARATION OF CONDOMINIUM AND THE BYLAWS OF THE UNIT OWNERS ASSOCIATION ARE RECORDED IN THE DEED RECORDS OF AUGLAIZE COUNTY, OHIO.

REVISIONS	BY

ST. AUGUSTINE CONDOMINIUM
 VILLAGE OF MINSTER
 AUGLAIZE COUNTY OHIO

Date Oct. / 87


Scale 20' = 1"

Drawn JBF

Job

Sheet


Of Sheets

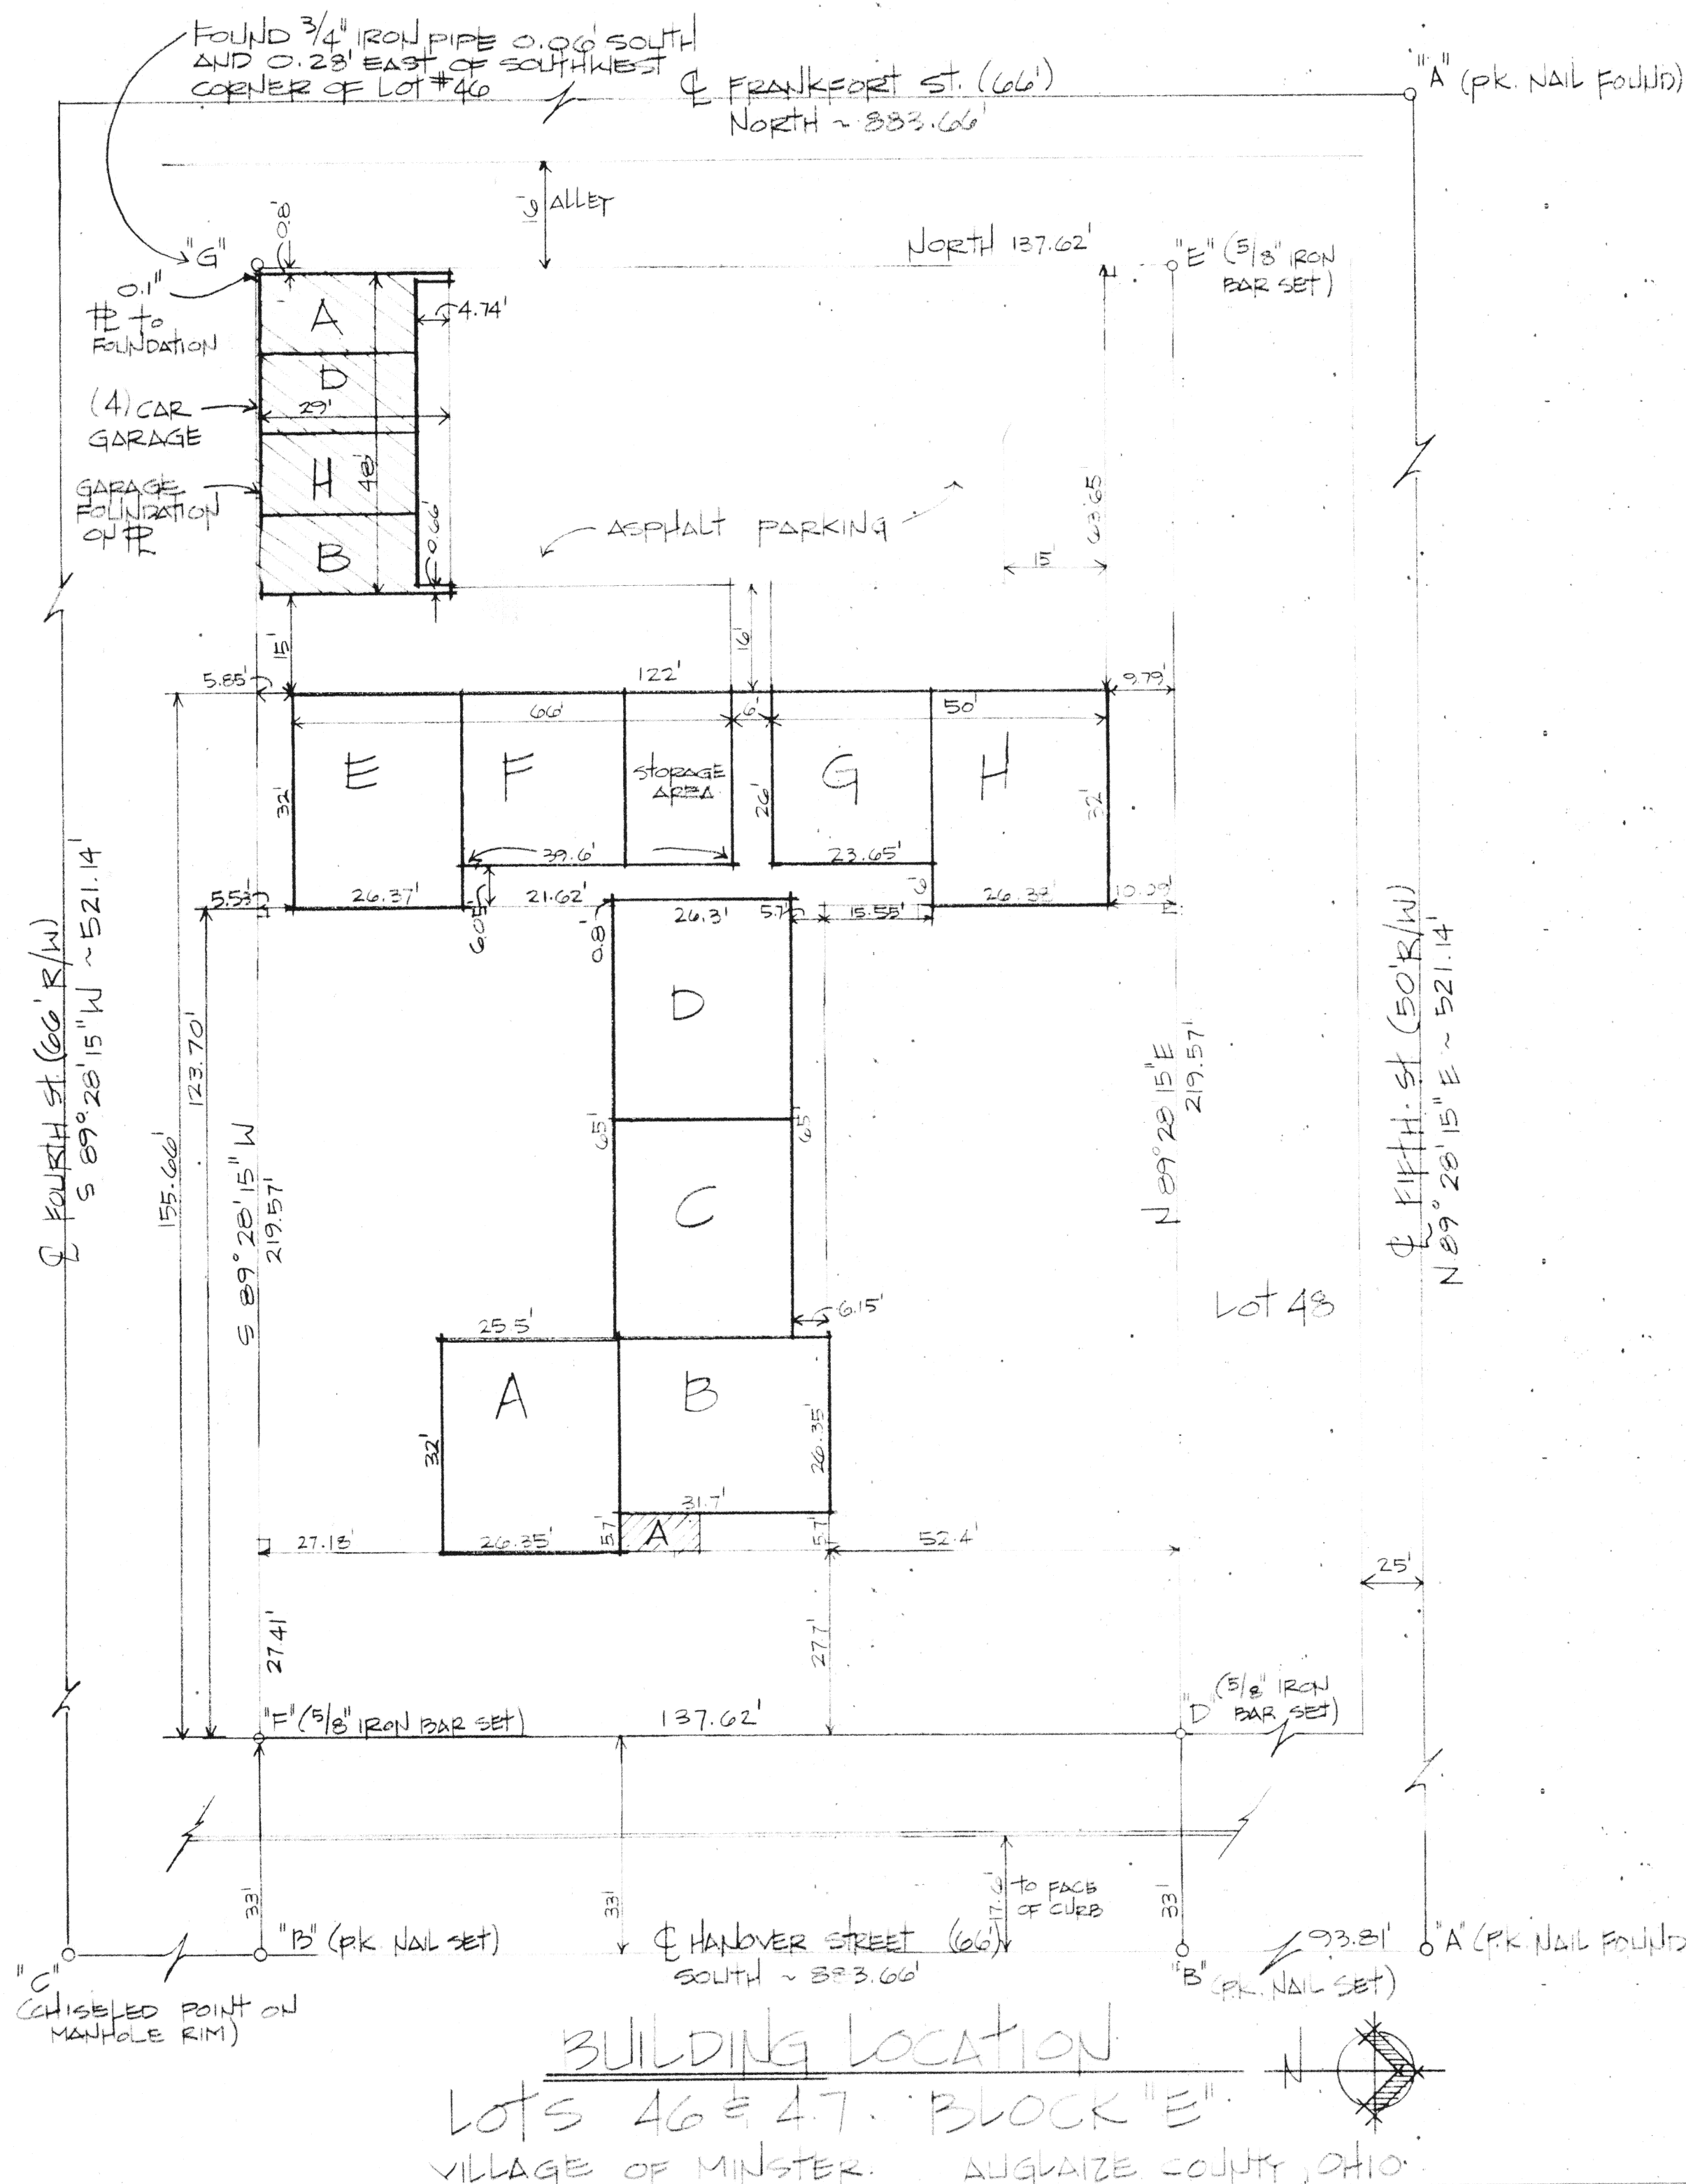

REVISIONS	BY

ST. AUGUSTINE CONDOMINIUM
VILLAGE OF MINSTER
AUGLAIZE COUNTY, OHIO

Date	Oct. / 87
Scale	$1/8" = 1'-0"$
Drawn	JBF
Job	
Sheet	1
Of	4 Sheets

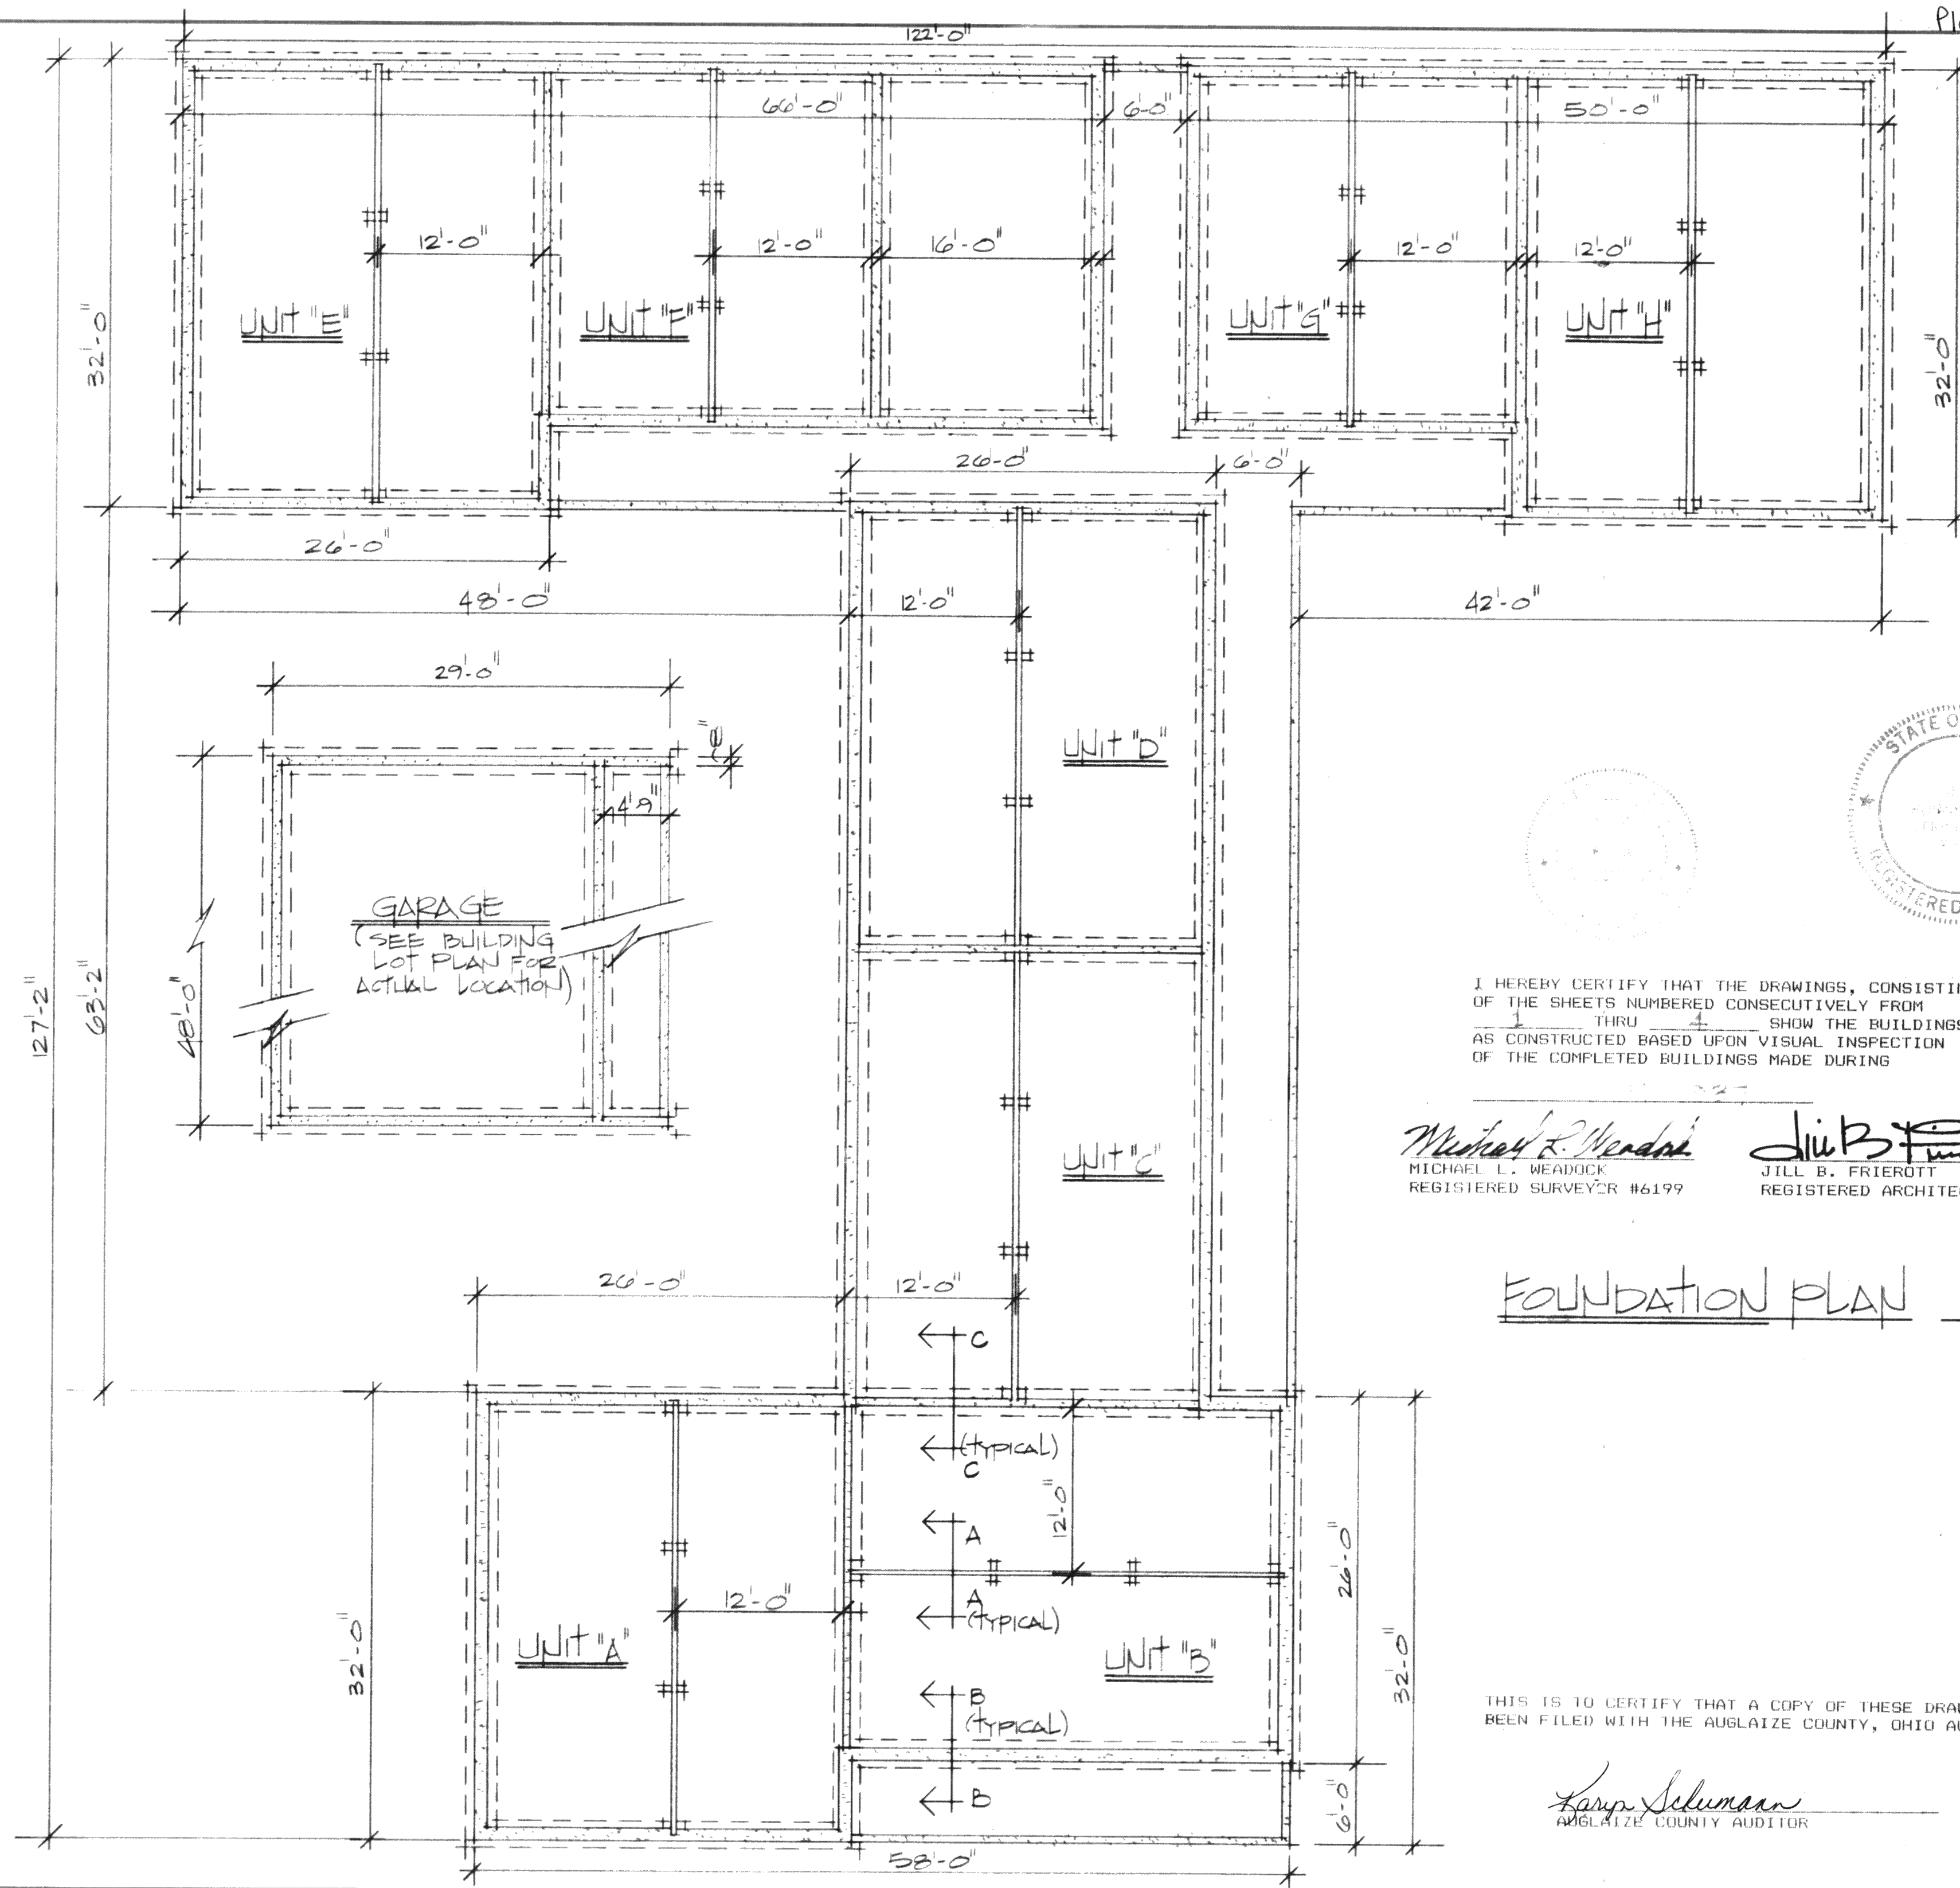

I HEREBY CERTIFY THAT THE DRAWINGS, CONSISTING OF THE SHEETS NUMBERED CONSECUTIVELY FROM 1 THRU 4 SHOW THE BUILDINGS AS CONSTRUCTED BASED UPON VISUAL INSPECTION OF THE COMPLETED BUILDINGS MADE DURING

Michael L. Weadock
MICHAEL L. WEADOCK
REGISTERED SURVEYOR #6199


JILL B. FRIEROTT
REGISTERED ARCHITECT #8238


FOUNDATION PLAN

THIS IS TO CERTIFY THAT A COPY OF THESE DRAWINGS HAS
BEEN FILED WITH THE AUGLAIZE COUNTY, OHIO AUDITOR.

Karyn Schumann
AGLAIZE COUNTY AUDITOR


ST. AUGUSTINE CONDOMINIUM
VILLAGE OF MINSTER
AUGLAIZE COUNTY, OHIO

Of 4 Sheets

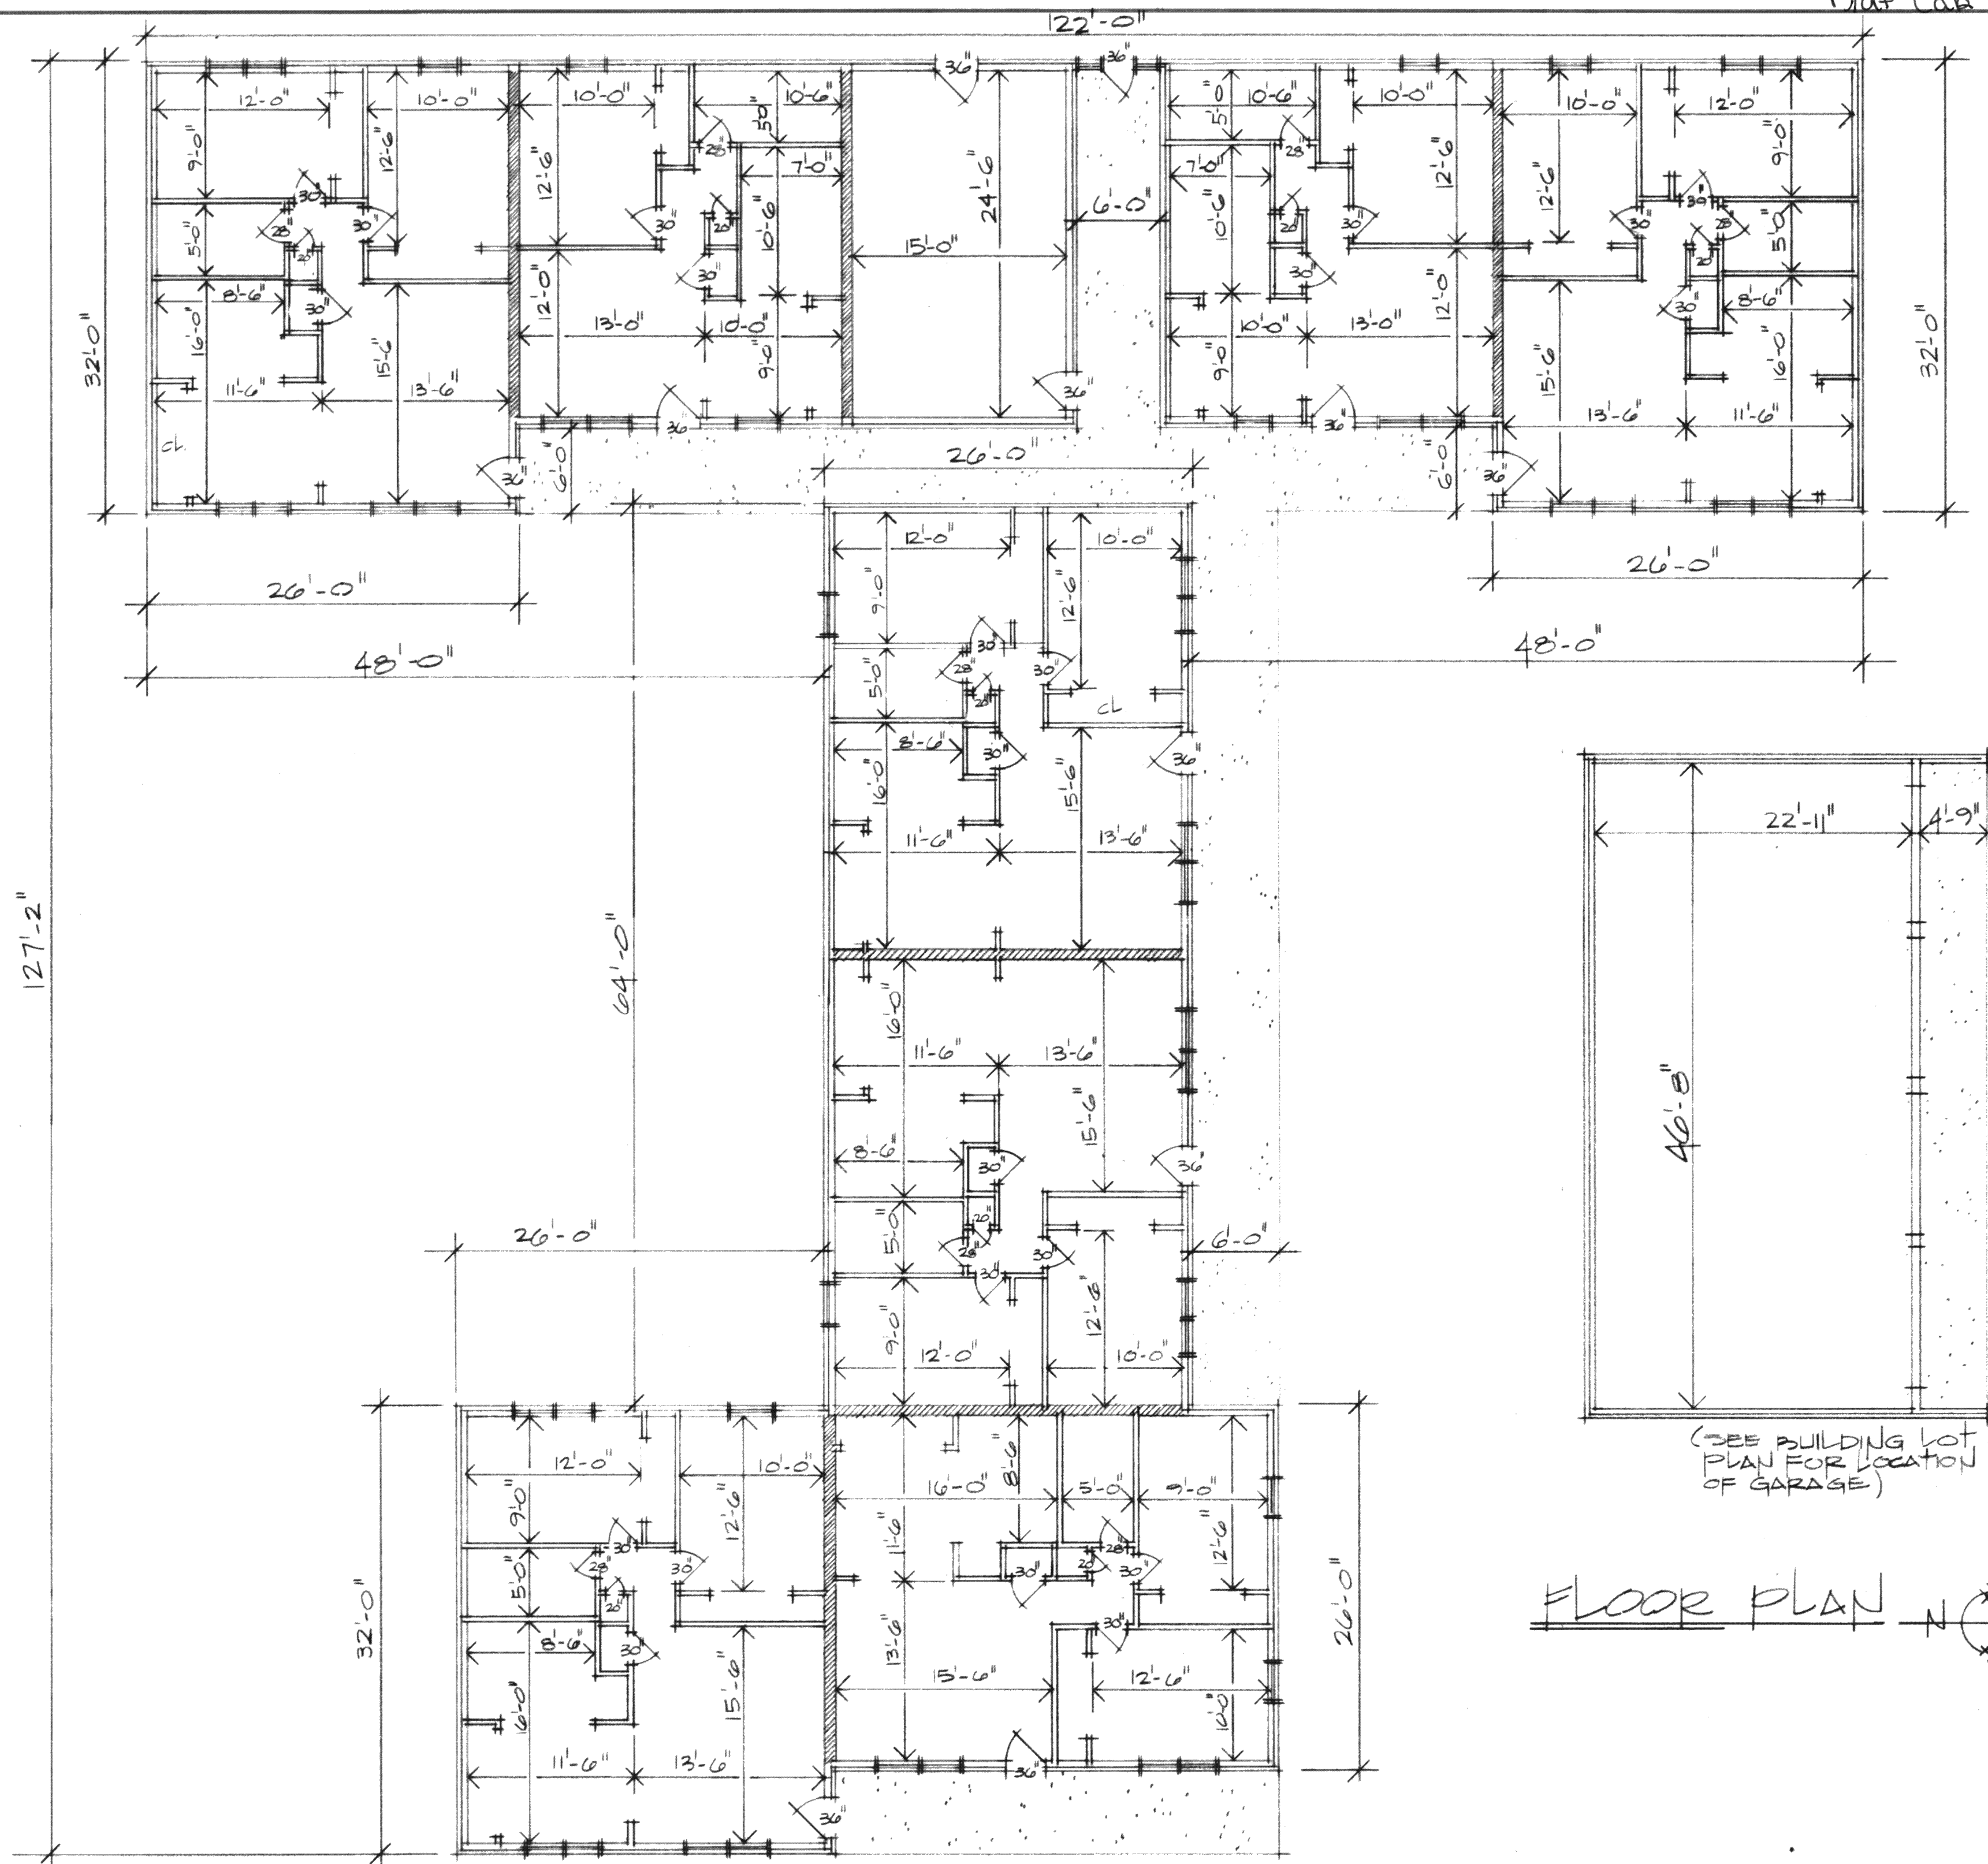

FLOOR PLAN 


NORTH SIDE ELEVATION

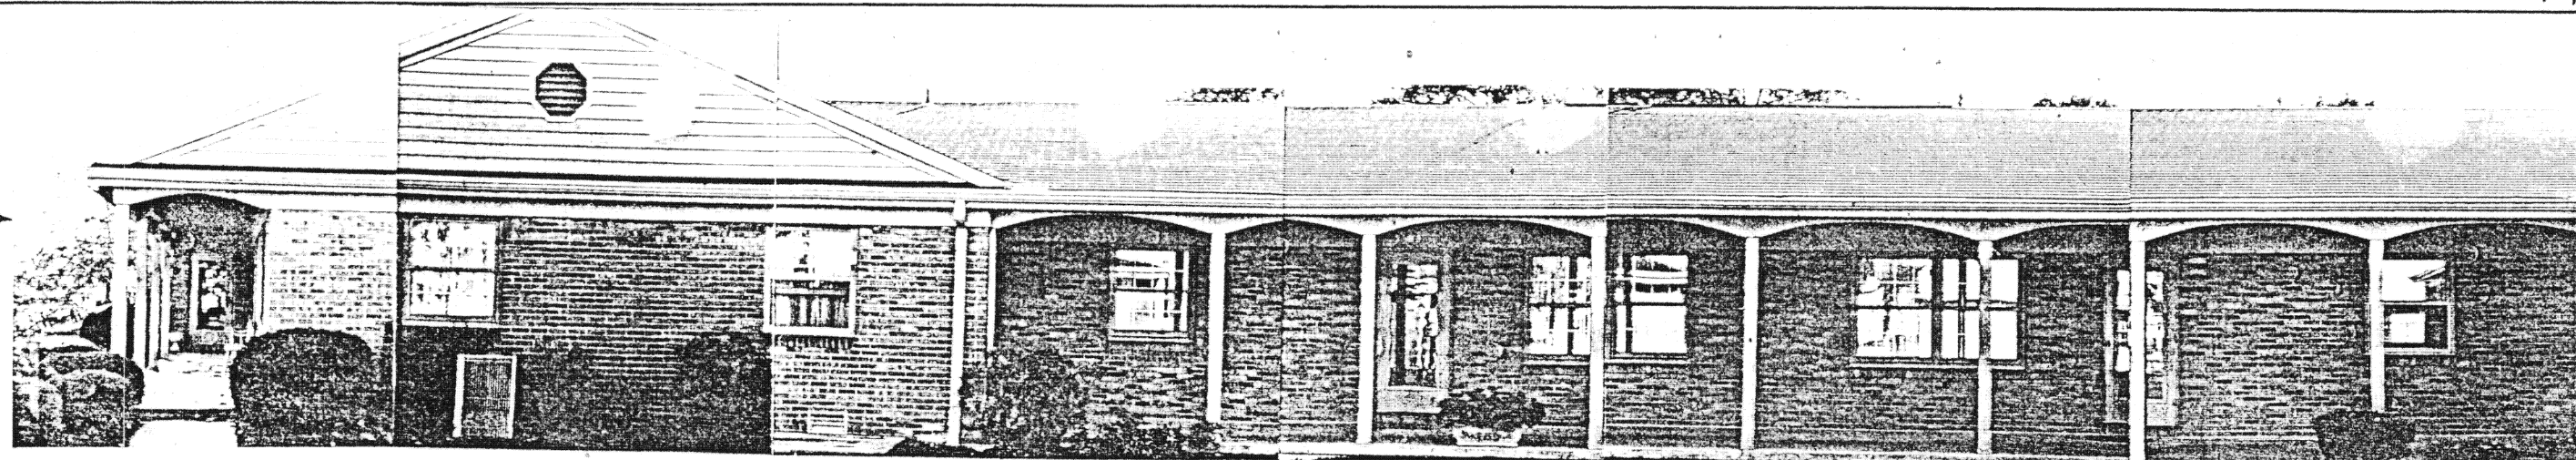



SOUTH-EAST ELEVATION



GARAGE FRONT

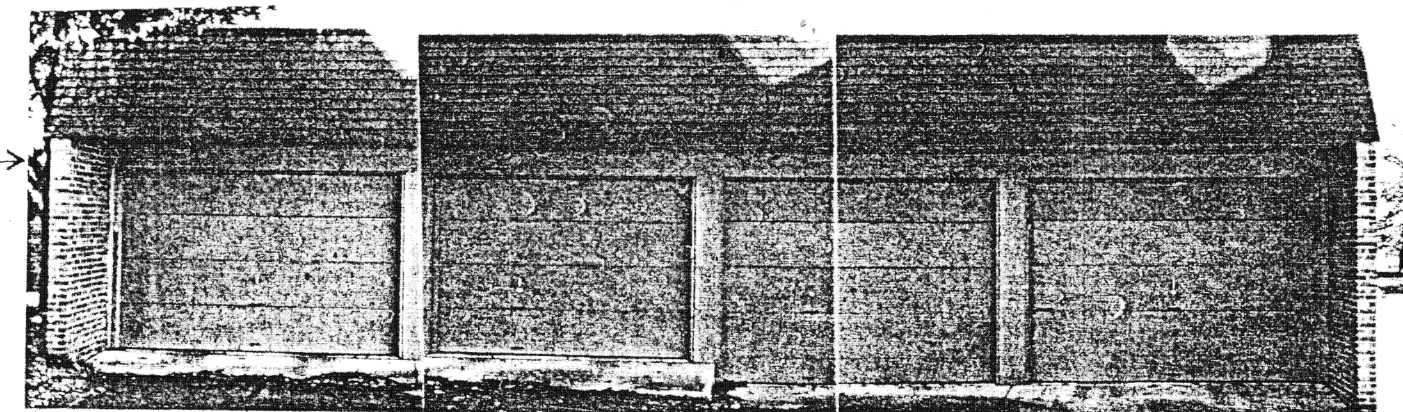

GARAGE SIDE VIEW
TYPICAL BOTH SIDES

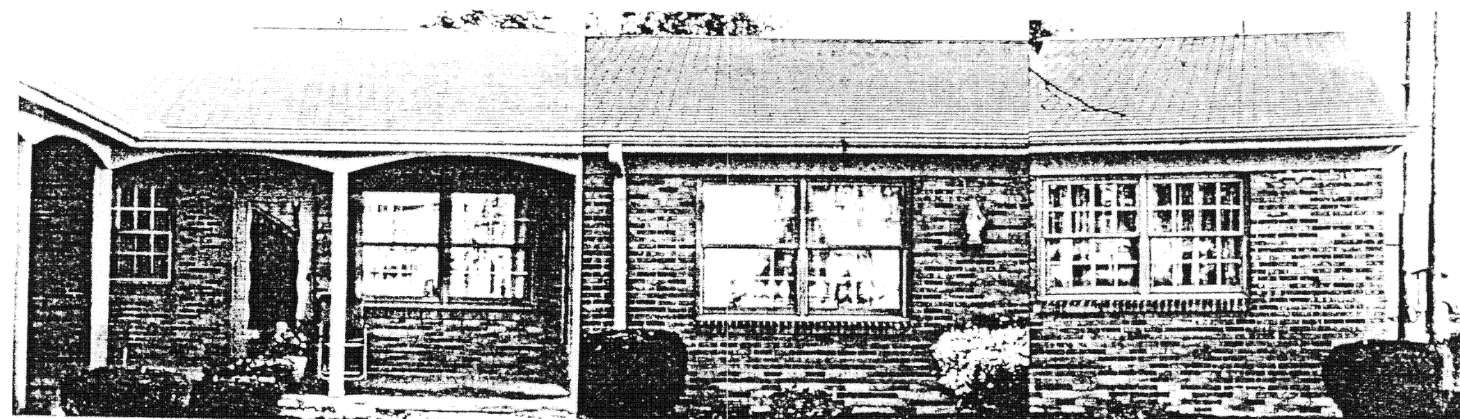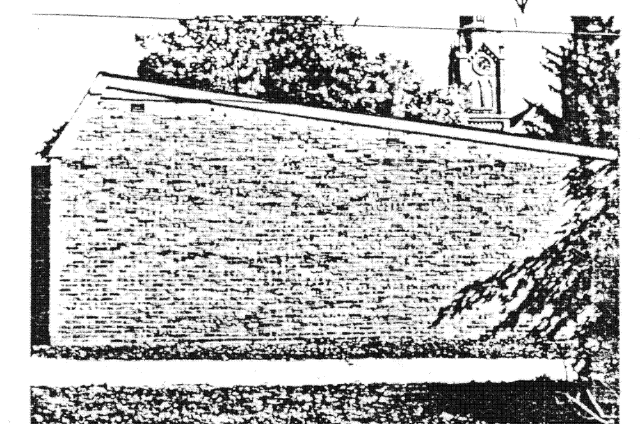

NORTH-EAST ELEVATION




SOUTH-SIDE ELEVATION

EAST-SIDE ELEVATION



WEST-SIDE ELEVATION

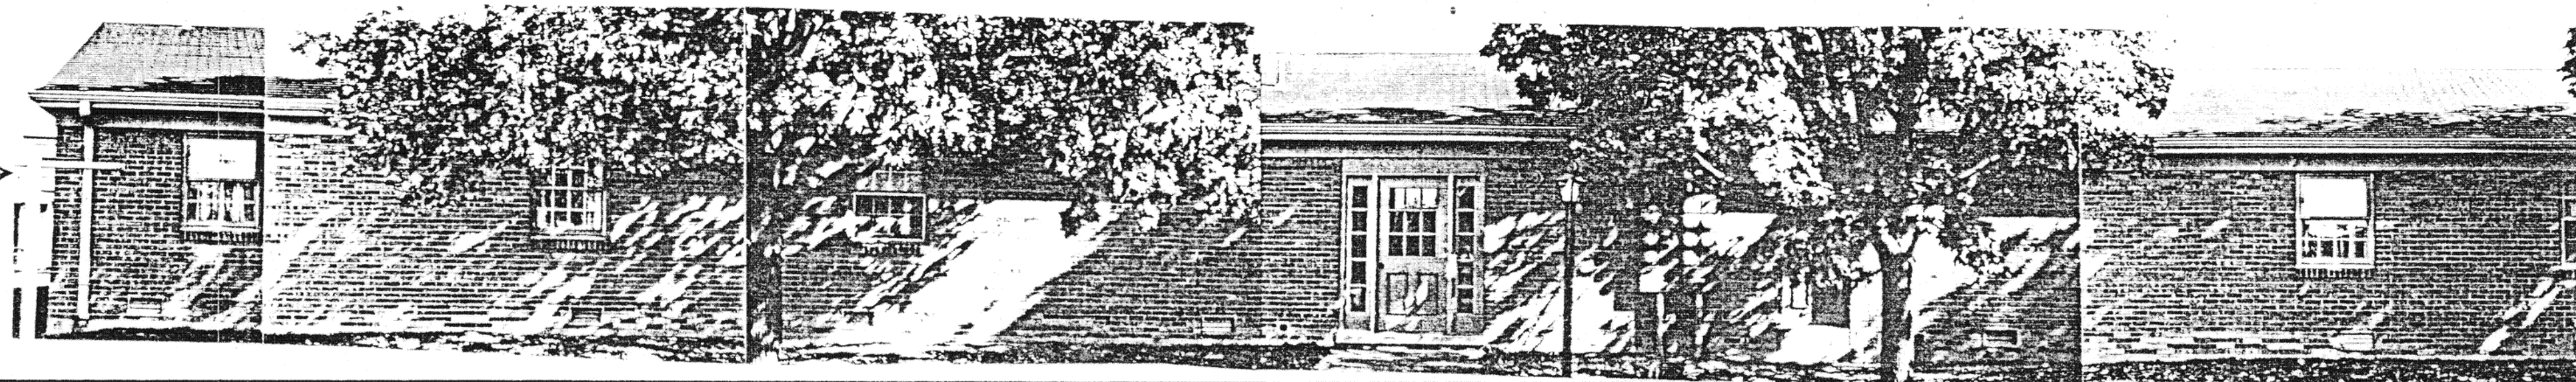

BUILDING ELEVATIONS			
SCALE: N.E.	APPROVED BY:	DRAWN BY: T.M.C.	
DATE: OCT. 1987		REVISED:	
ST. AUGUSTINE CONDOMINIUM			
MINSTER, INC.			DRAWING NUMBER: 3 of 4


REVISIONS	BY

ST. AUGUSTINE CONDOMINIUM
VILLAGE OF MINSTER
AUGLAIZE COUNTY, OHIO


Date	OCT. 1987
Scale	3/8" = 1'-0"
Drawn	JBF/MB
Job	
Sheet	4
Of	4 Sheets

NOTE:

8"x8"x16 CMU'S FILLED WITH SAND,
LAID FROM FOOTER TO UNDER ROOF
SHEATHING. 3/4" PLASTER ON BOTH
SIDES FROM FLOOR TO CEILING

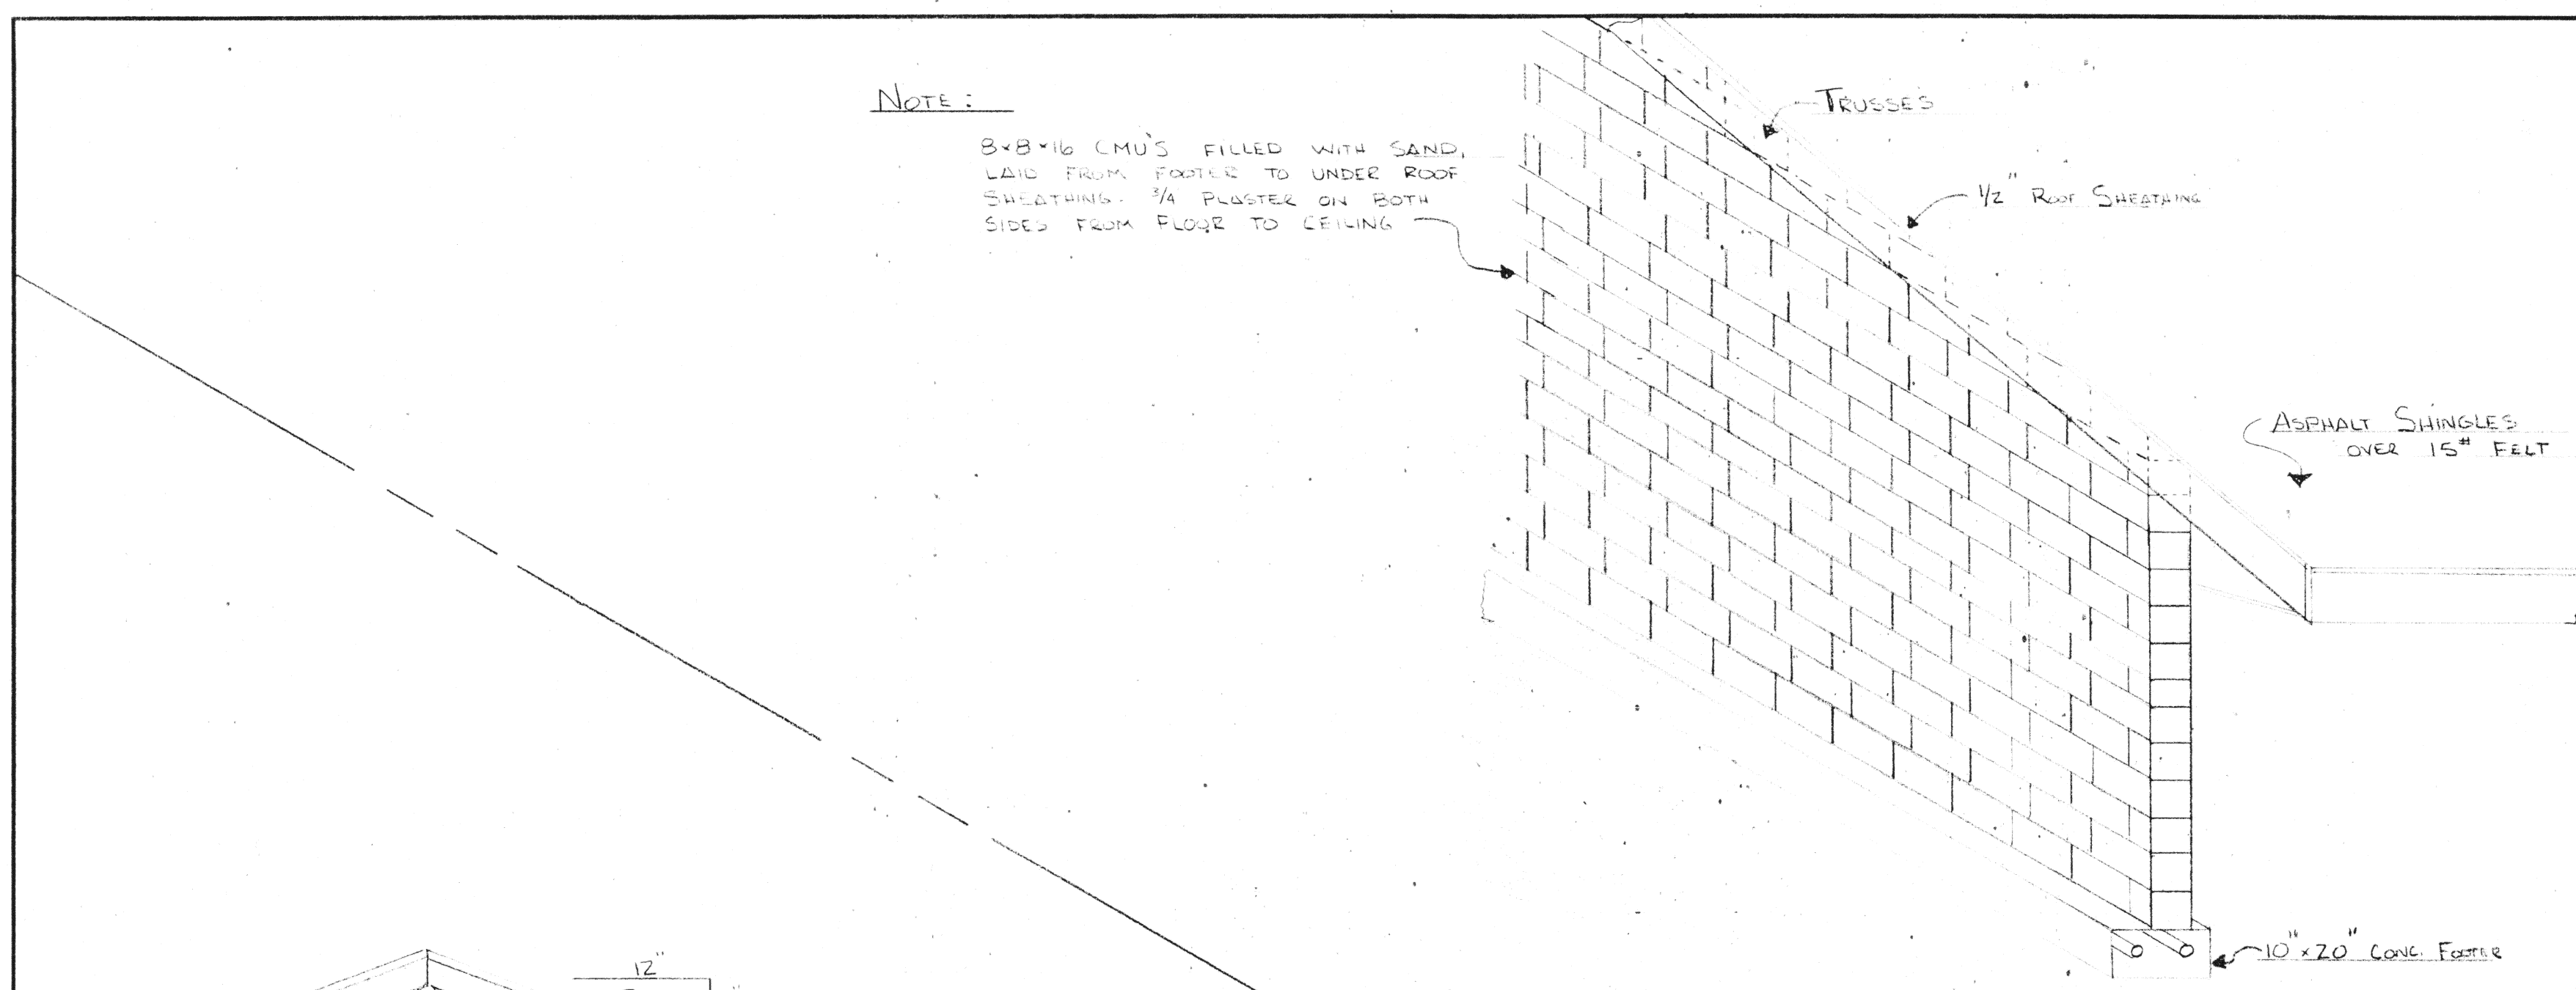

SECTION C-C

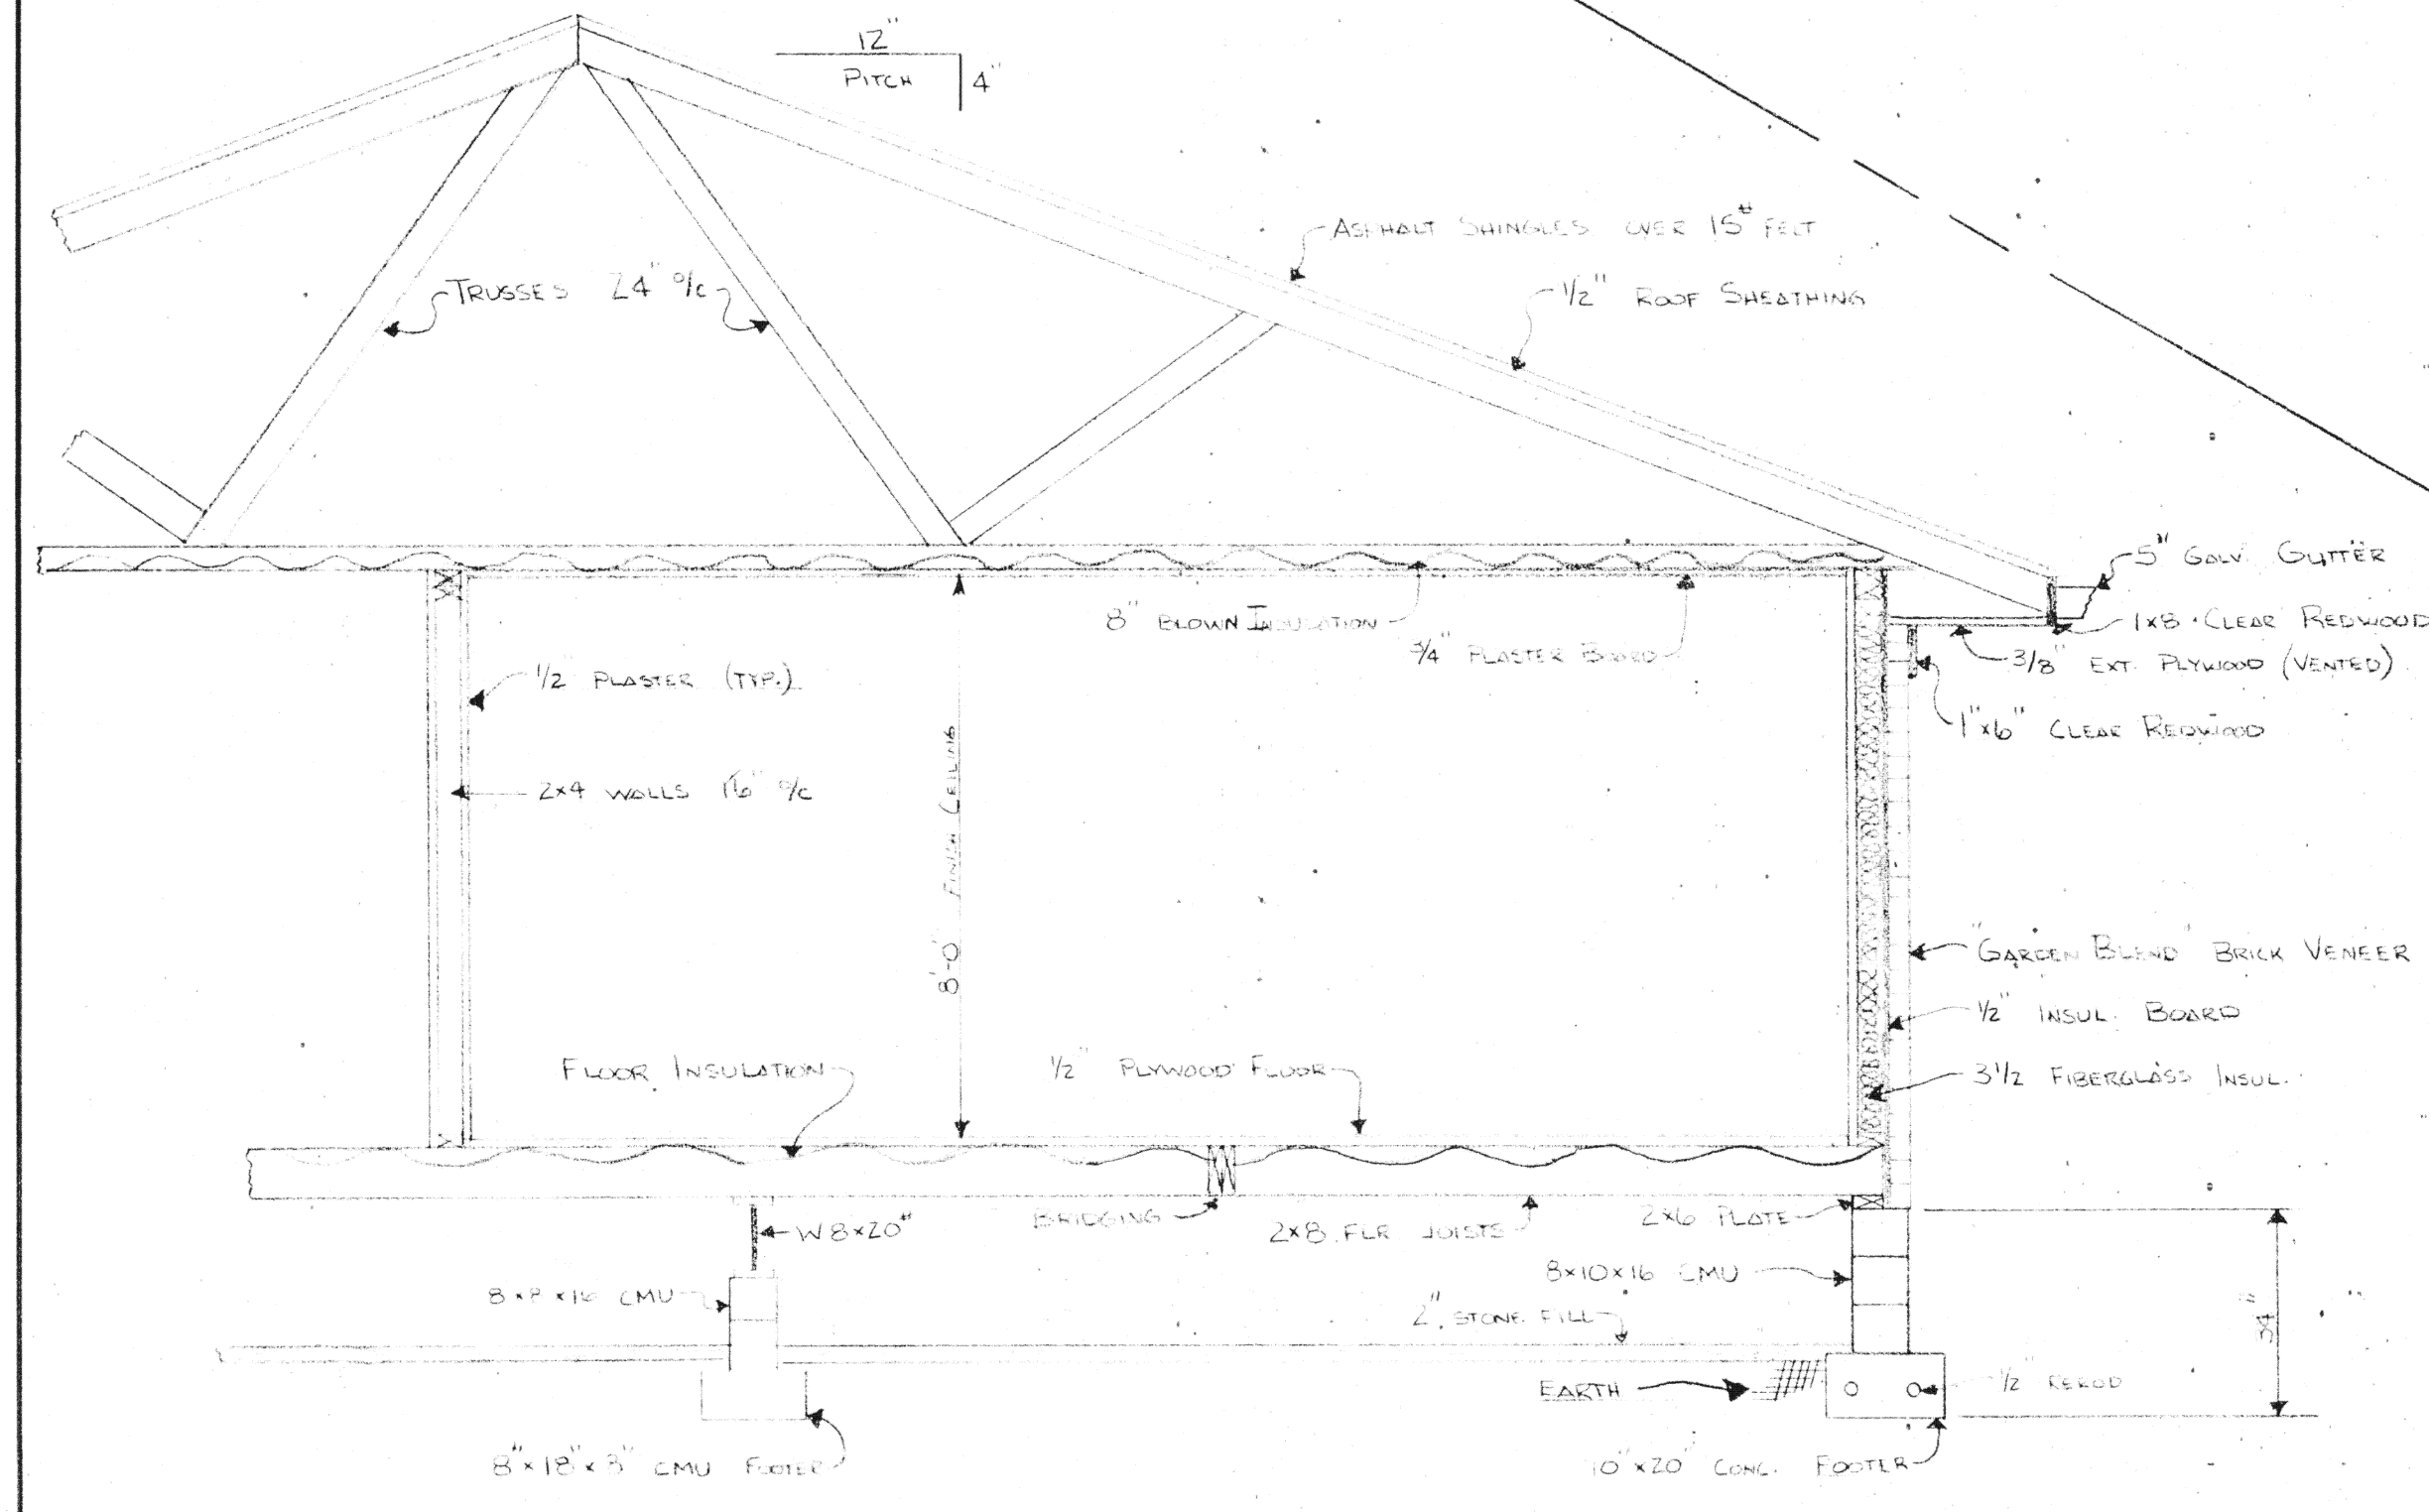

SECTION A-A

SECTION B-B