


WINSTON PLACE CONDOMINIUMS

N.W.1/4, Sec. 4, St. Marys Twp., Auglaize County, Ohio
 West Oaks Meadows N° 5, Lot 471 & E. 1/2 Lot 472
 Building "D" (Consisting of 2 Units)

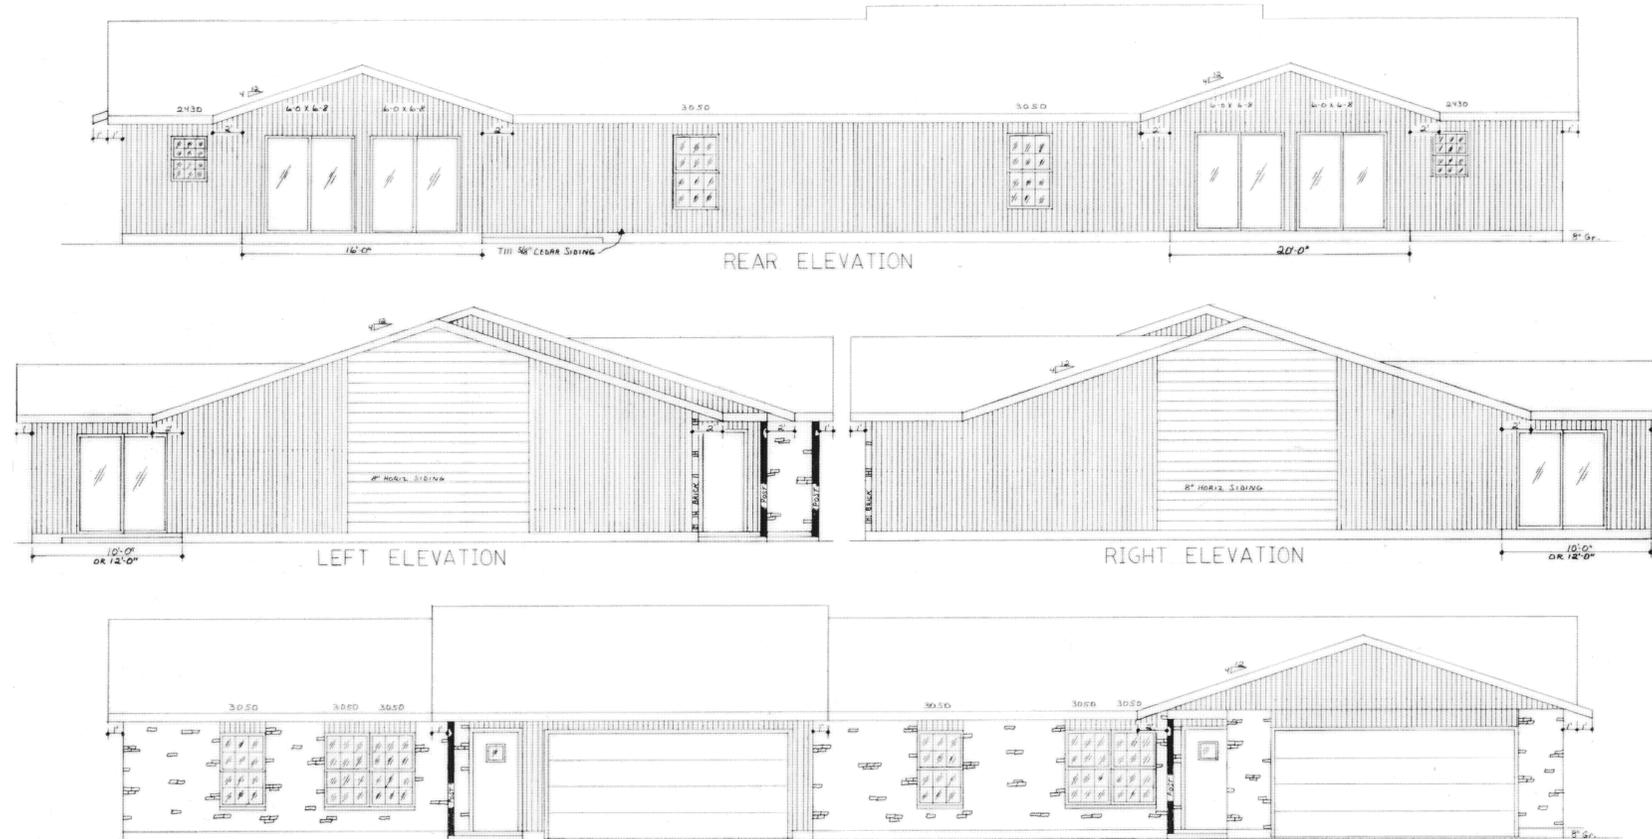

ELEVATIONS

ROOF: Typical 2"x4" ; 24" O.C. Truss
 3/8" C.D.X. Plywood
 235* Fiberglass Shingles

3/8" Rough Sawn Cedar Soffit

5" Aluminum Gutter

 Texture 1-11 Plywood

 Brick

1705 + 1707 KISLER STREET
 ST. MARYS, OHIO
 DATE 1-29-88 SCALE 1" = 8'
 REVISED 5-2-88

We, Daniel G. Bucher, Registered Engineer, State of Ohio No. 43709 and
 Ted A. Metzger, Registered Surveyor, State of Ohio No. 5514, do hereby
 certify that these drawings accurately show graphically the location,
 dimensions and configurations of Units 1 & 2 of the Winston Place Condominiums
 as constructed.

Dated at Lima, Ohio, Oct. 21, 1988


KOHLI & KALIHAR ASSOCIATES, LIMITED

By Daniel G. Bucher
 Registered Engineer No. 43709

By Theodore A. Metzger
 Registered Surveyor No. 5514

WINSTON PLACE CONDOMINIUMS

N.W.1/4, Sec. 4, St. Marys Twp., Auglaize County, Ohio
 West Oaks Meadows N° 5, Lot 471 & E. 1/2 Lot 472
 Building "D" (Consisting of 2 Units)

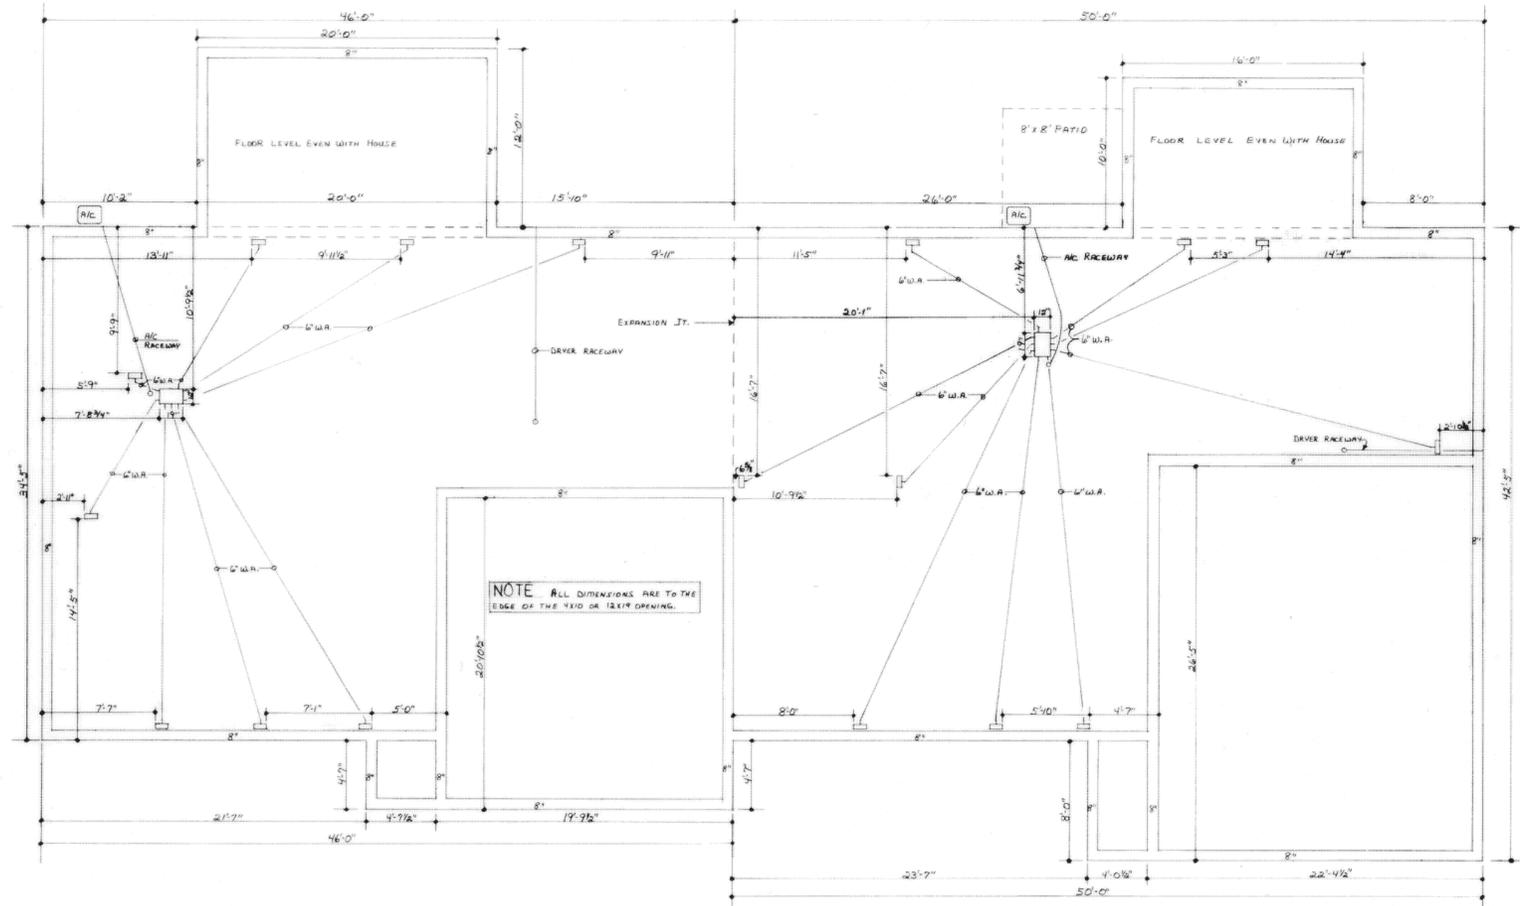

17054-1709 KISHLER STREET
 St. Marys, Ohio
 DATE 2-1-88 SCALE 1"=8'
 REVISED 5-2-88

FOUNDATION PLAN

FOOTERS: 10" Wide , 28" Thick Poured in Place Concrete

FLOOR: 4" Concrete Slab , Visqueen, 4" Stone

FOUNDATION WALLS: 8" Concrete Block (2 Rows)

We, Daniel G. Bucher, Registered Engineer, State of Ohio No. 43709 and Ted A. Metzger, Registered Surveyor, State of Ohio No. 5514, do hereby certify that these drawings accurately show graphically the location, dimensions and configurations of Units 1 & 2 of the Winston Place Condominiums as constructed.

Dated at Lima, Ohio, Oct. 21, 1988


KOHLI & KALIHAR ASSOCIATES, LIMITED

By Daniel G. Bucher
 Registered Engineer No. 43709

By Theodore A. Metzger
 Registered Surveyor No. 5514

WINSTON PLACE CONDOMINIUMS

N.W.1/4, Sec. 4, St. Marys Twp., Auglaize County, Ohio
 West Oaks Meadows N° 5, Lot 471 & E. 1/2 Lot 472
 Building "D" (Consisting of 2 Units)

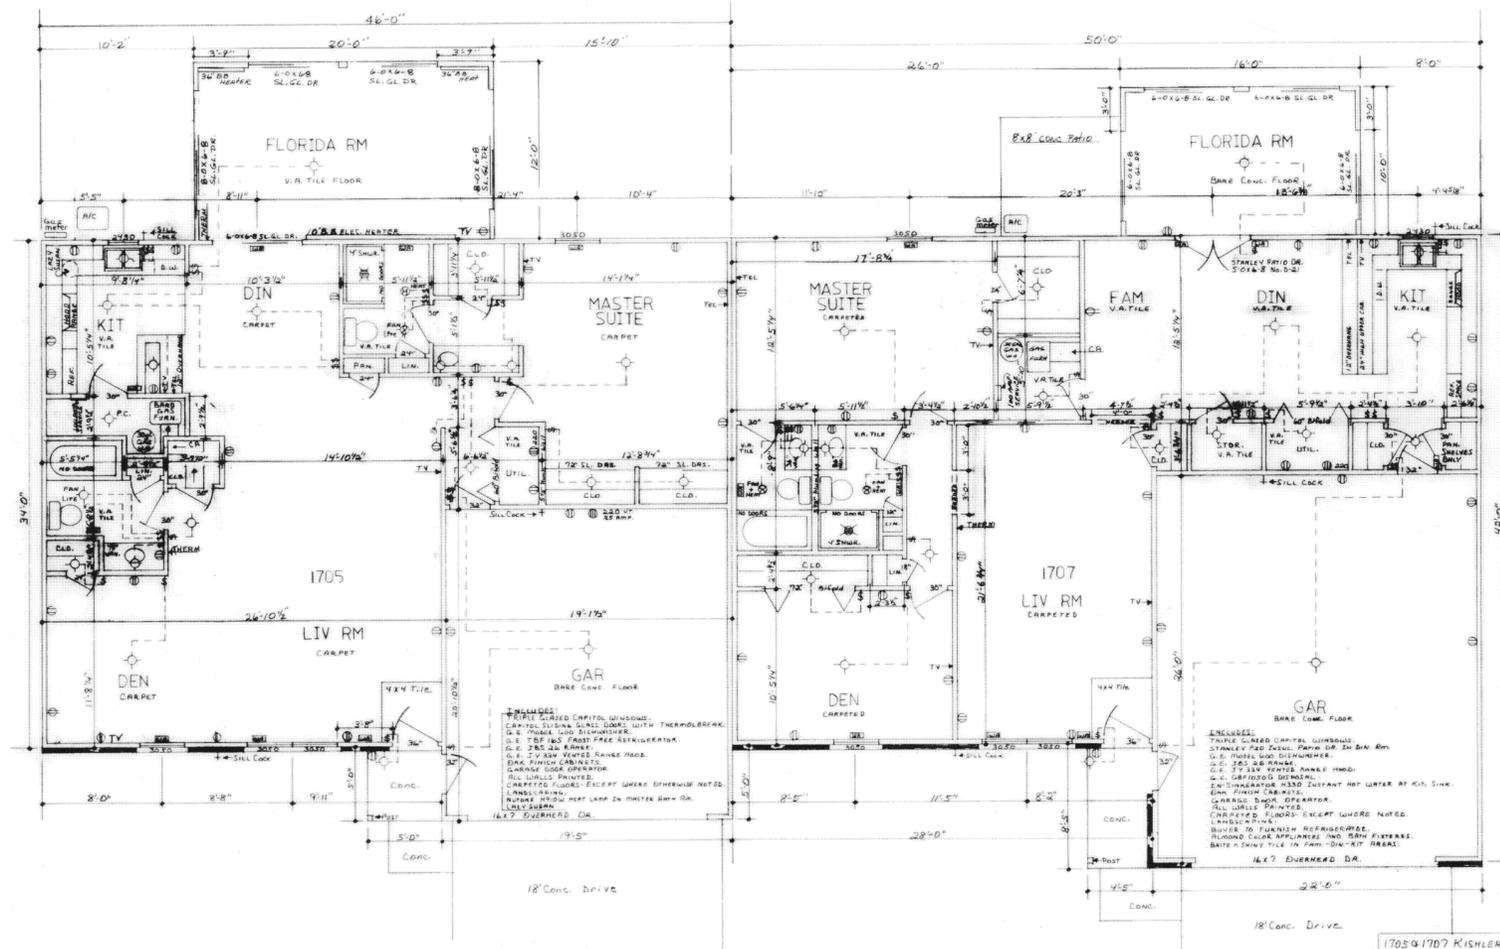

FIRST FLOOR PLAN

EXTERIOR WALLS: Typical 2"x4" , 24" O.C. Studs , R-11 Insulation
 Outside Finish: 5/8" Texture 1-11 Plywood
 Inside Finish: Painted 1/2" Drywall

INTERIOR WALLS: Typical 2"x4" , 24" O.C. Studs
 Painted 1/2" Drywall, each Side

UNIT PARTITION WALLS: 2 Rows 2"x4" , 24" O.C. Studs ,
 1/2" Sound Board , Painted 1/2" Drywall
 Each Side

NOTE: All Ceiling Heights are 8' Except Garages are 8'-6"

We, Daniel G. Bucher, Registered Engineer, State of Ohio No. 43709 and Ted A. Metzger, Registered Surveyor, State of Ohio No. 5514, do hereby certify that these drawings accurately show graphically the location, dimensions and configurations of Units 1 & 2 of the Winston Place Condominiums as constructed.

Dated at Lima, Ohio, Oct. 21, 1988.

KOHLI & KALIHER ASSOCIATES, LIMITED

By Daniel G. Bucher
 Registered Engineer No. 43709

By Theodore A. Metzger
 Registered Surveyor No. 5514

1705 & 1707 KISHLER STREET
 ST. MARYS, OHIO
 DATE 1-29-88 SCALE 1" = 8'
 3-8-88 REVISED PIANO DE 1987
 3-9-88 REVISED 1705 & 1707