

LINCOLN/MAIN CONDOMINIUM

NORTH
SCALE: 1"=20'



- CONDOMINIUM UNIT
- LIMITED COMMON AREA



I HEREBY CERTIFY THAT THE
DRAWINGS CONSISTING OF
SHEETS NUMBERED CONSECUTIVELY
1 THRU 8 SHOW THE
BUILDINGS AS CONSTRUCTED
AND BASED UPON VISUAL
INSPECTION OF COMPLETED
BUILDINGS DURING:
NOVEMBER 1990


Jill B. Frierott
JILL B. FRIEROTT
REG. ARCHITECT # 8238

Thomas W. Steinke
THOMAS W. STEINKE
REG. SURVEYOR # 6177

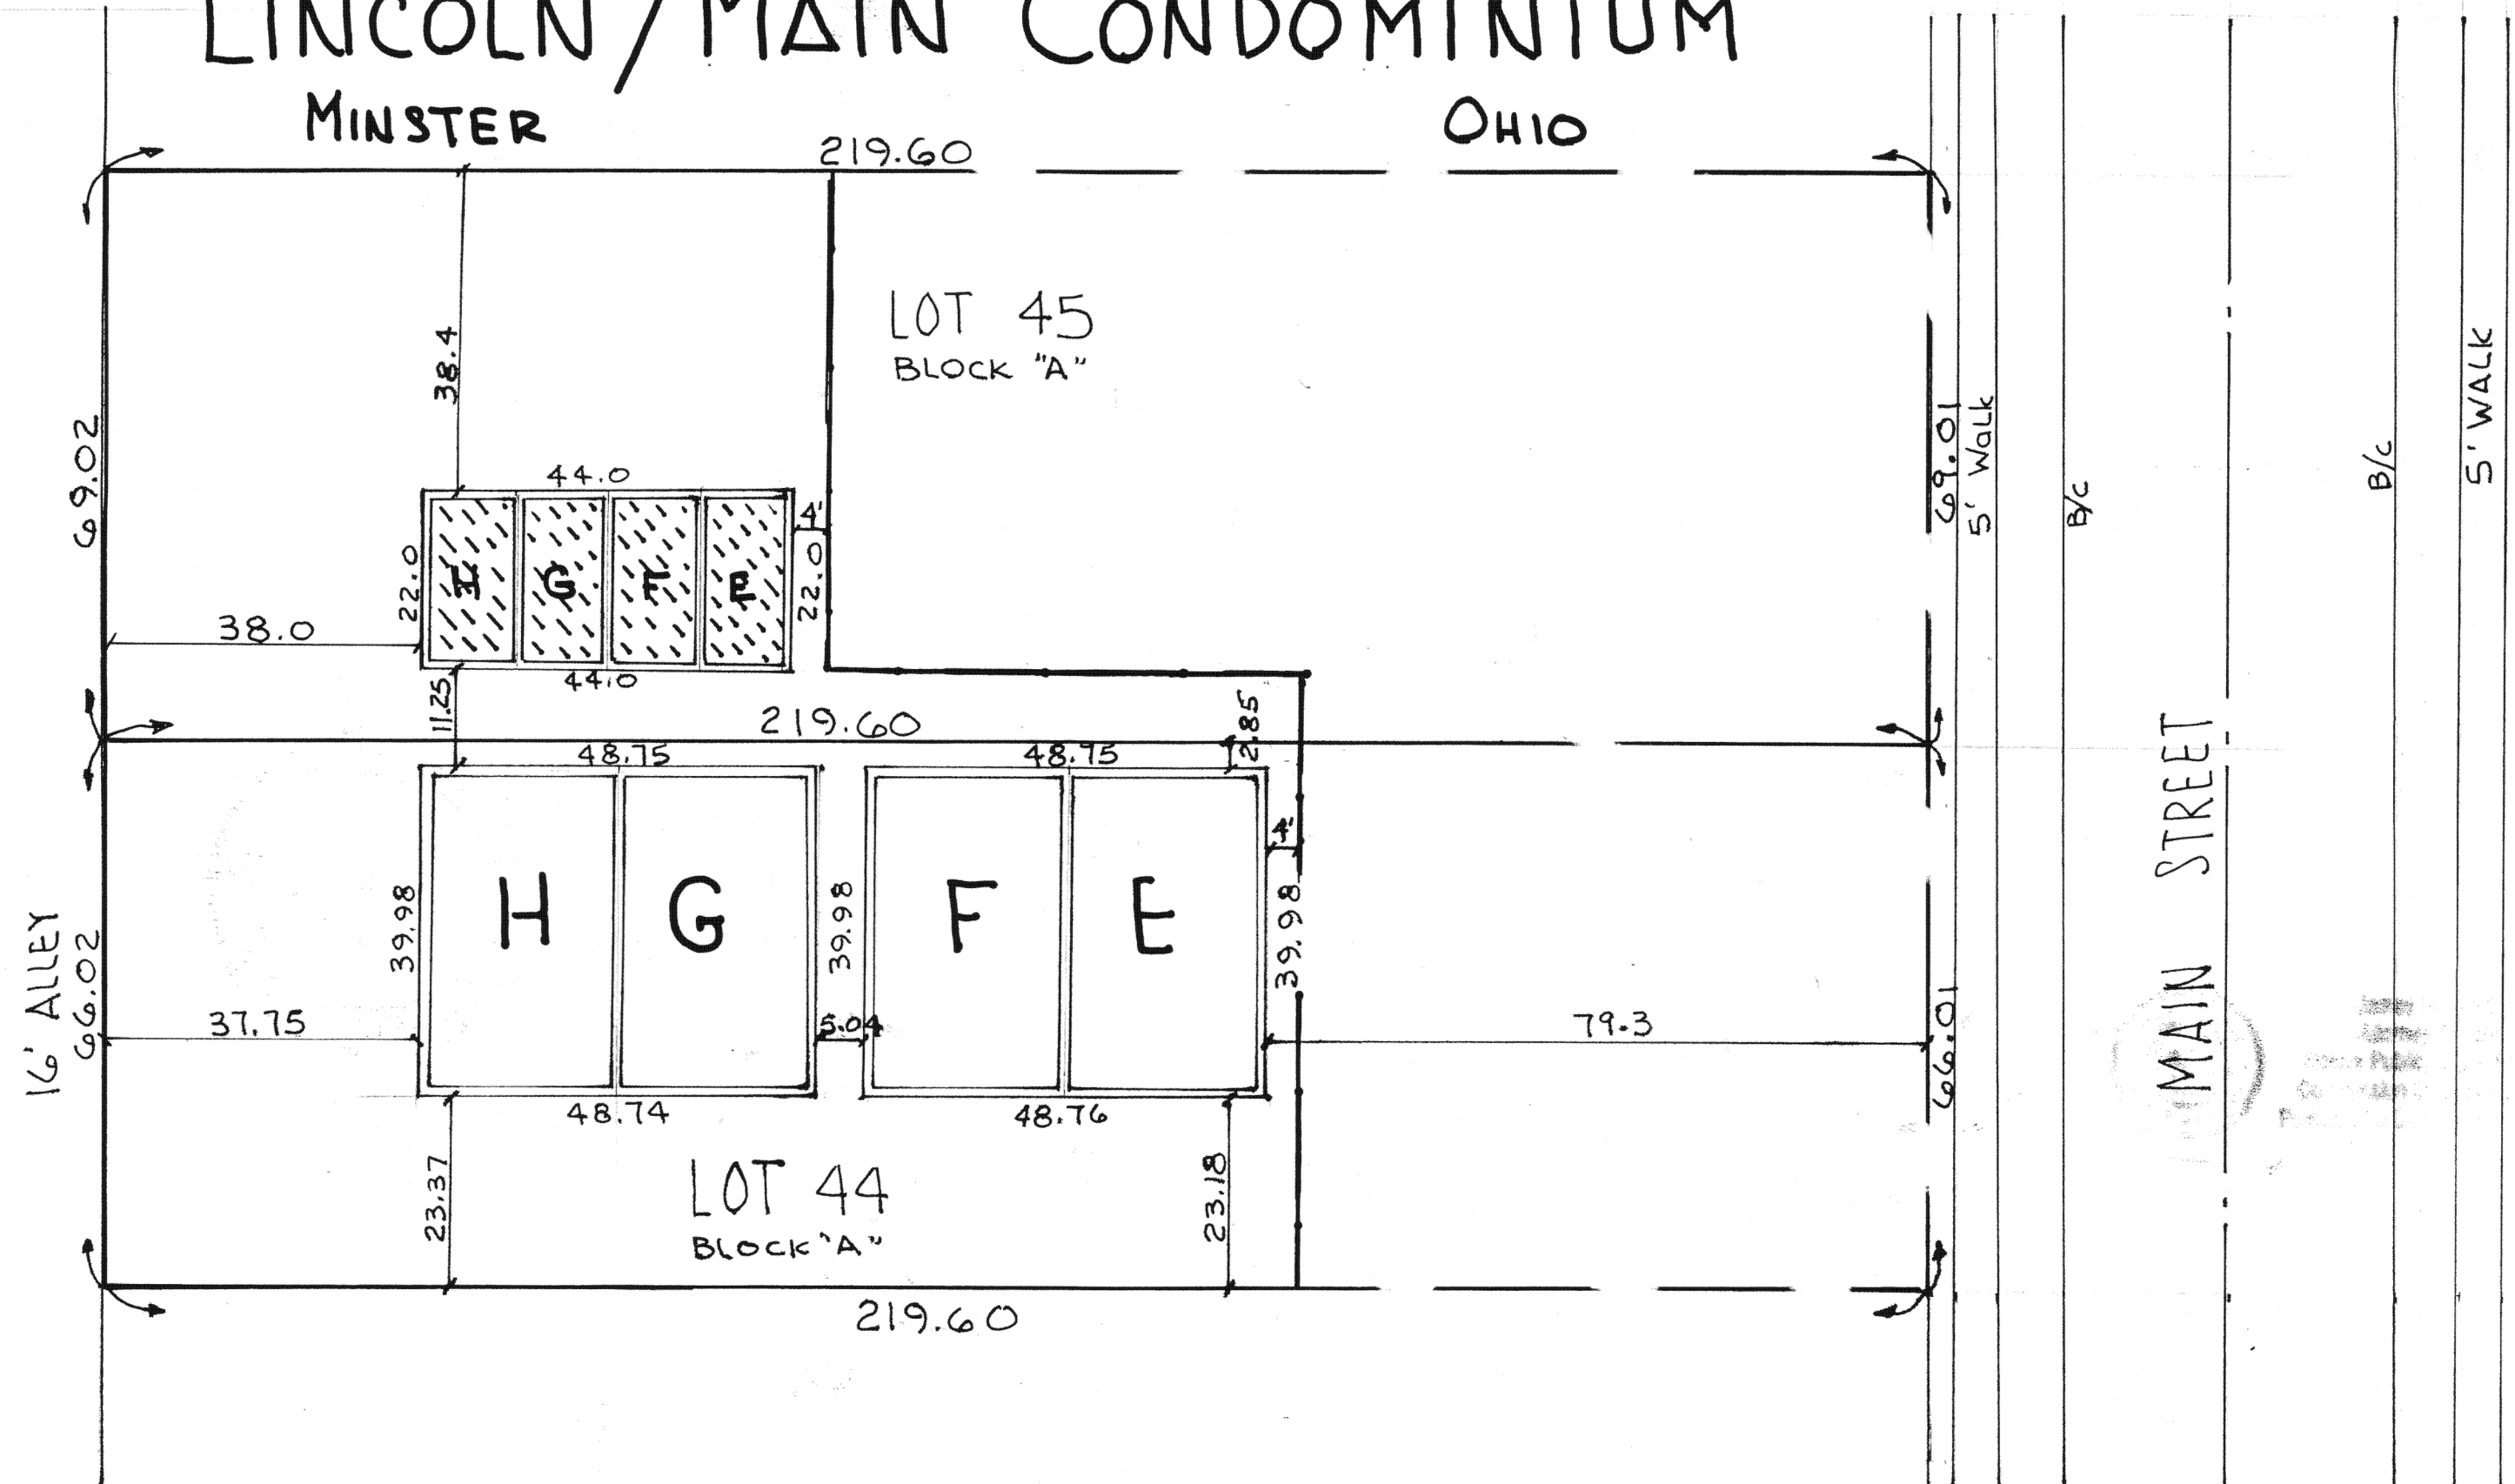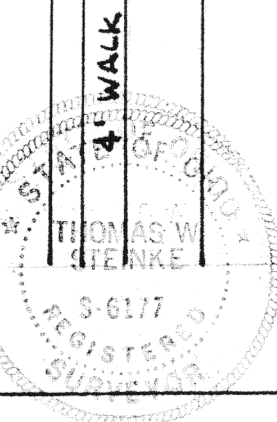

THIS IS TO CERTIFY THAT A COPY OF THESE
DRAWINGS HAS BEEN FILED WITH THE AUGLAIZE
COUNTY AUDITOR

Marlene Schumann - Dec 20, 1990
AUGLAIZE COUNTY AUDITOR

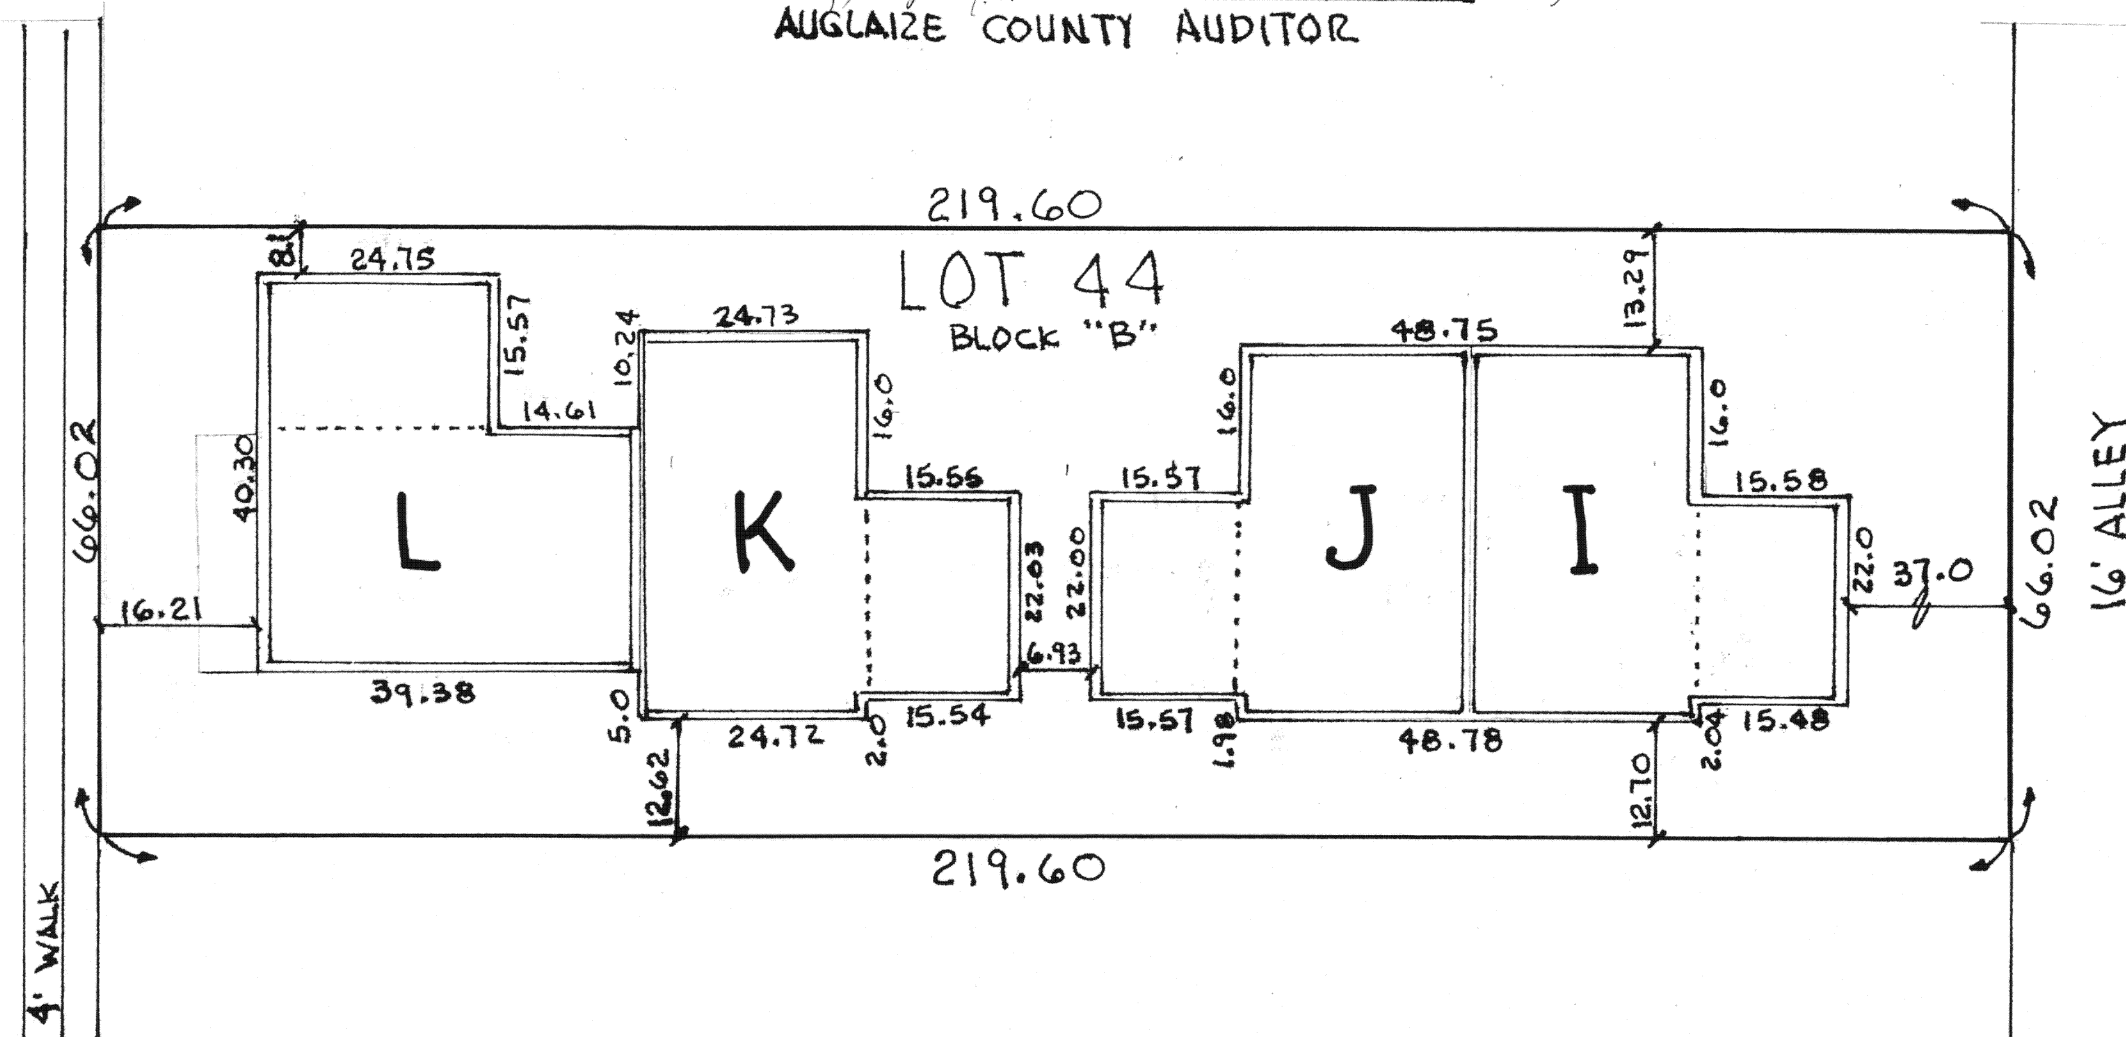

6360

Recorded Dec 20, 1990
@ 2:25 p.m. Vol. Flat
Book C, slide 3-10
Marlene Schumann
Auglaize County Recorder

THIS IS TO CERTIFY THAT A COPY OF THIS PLAT
HAS BEEN FILED WITH THE AUGLAIZE CO. OHIO AUDITOR
Karen Johnson Dec 30, 1990
COUNTY AUDITOR DATE

THE MEASUREMENTS ARE CERTIFIED TO BE CORRECT AND
THESE DRAWINGS ACCURATELY SHOW THE BUILDINGS AS CONSTRUCTED

Thomas W Steinke



THOMAS W. STEINKE

REGISTERED SURVEYOR #6177

Jill B. Frierott

JILL B. FRIEROTT



REGISTERED ARCHITECT #8238

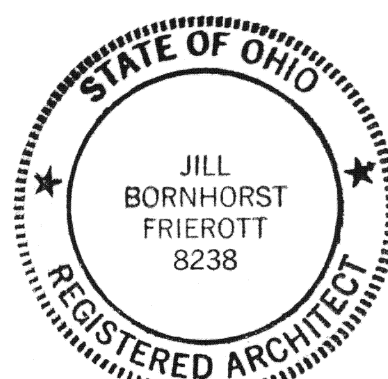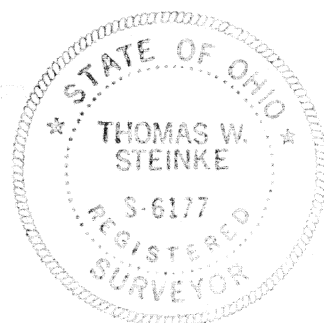

THE PERCENT INTEREST IN THE COMMON AREA WHICH IS
OWNED BY EACH UNIT IS SET FORTH IN THE CONDOMINIUM
DECLARATION TO WHICH A SMALL SCALE OF THIS DRAWING
IS ATTACHED.

THE DECLARATION OF CONDOMINIUM AND THE BYLAWS
OF THE UNIT OWNERS ASSOCIATION ARE RECORDED
IN THE DEED RECORDS OF AUGLAIZE COUNTY, OHIO

VILLAGE OF MINSTER - OHIO

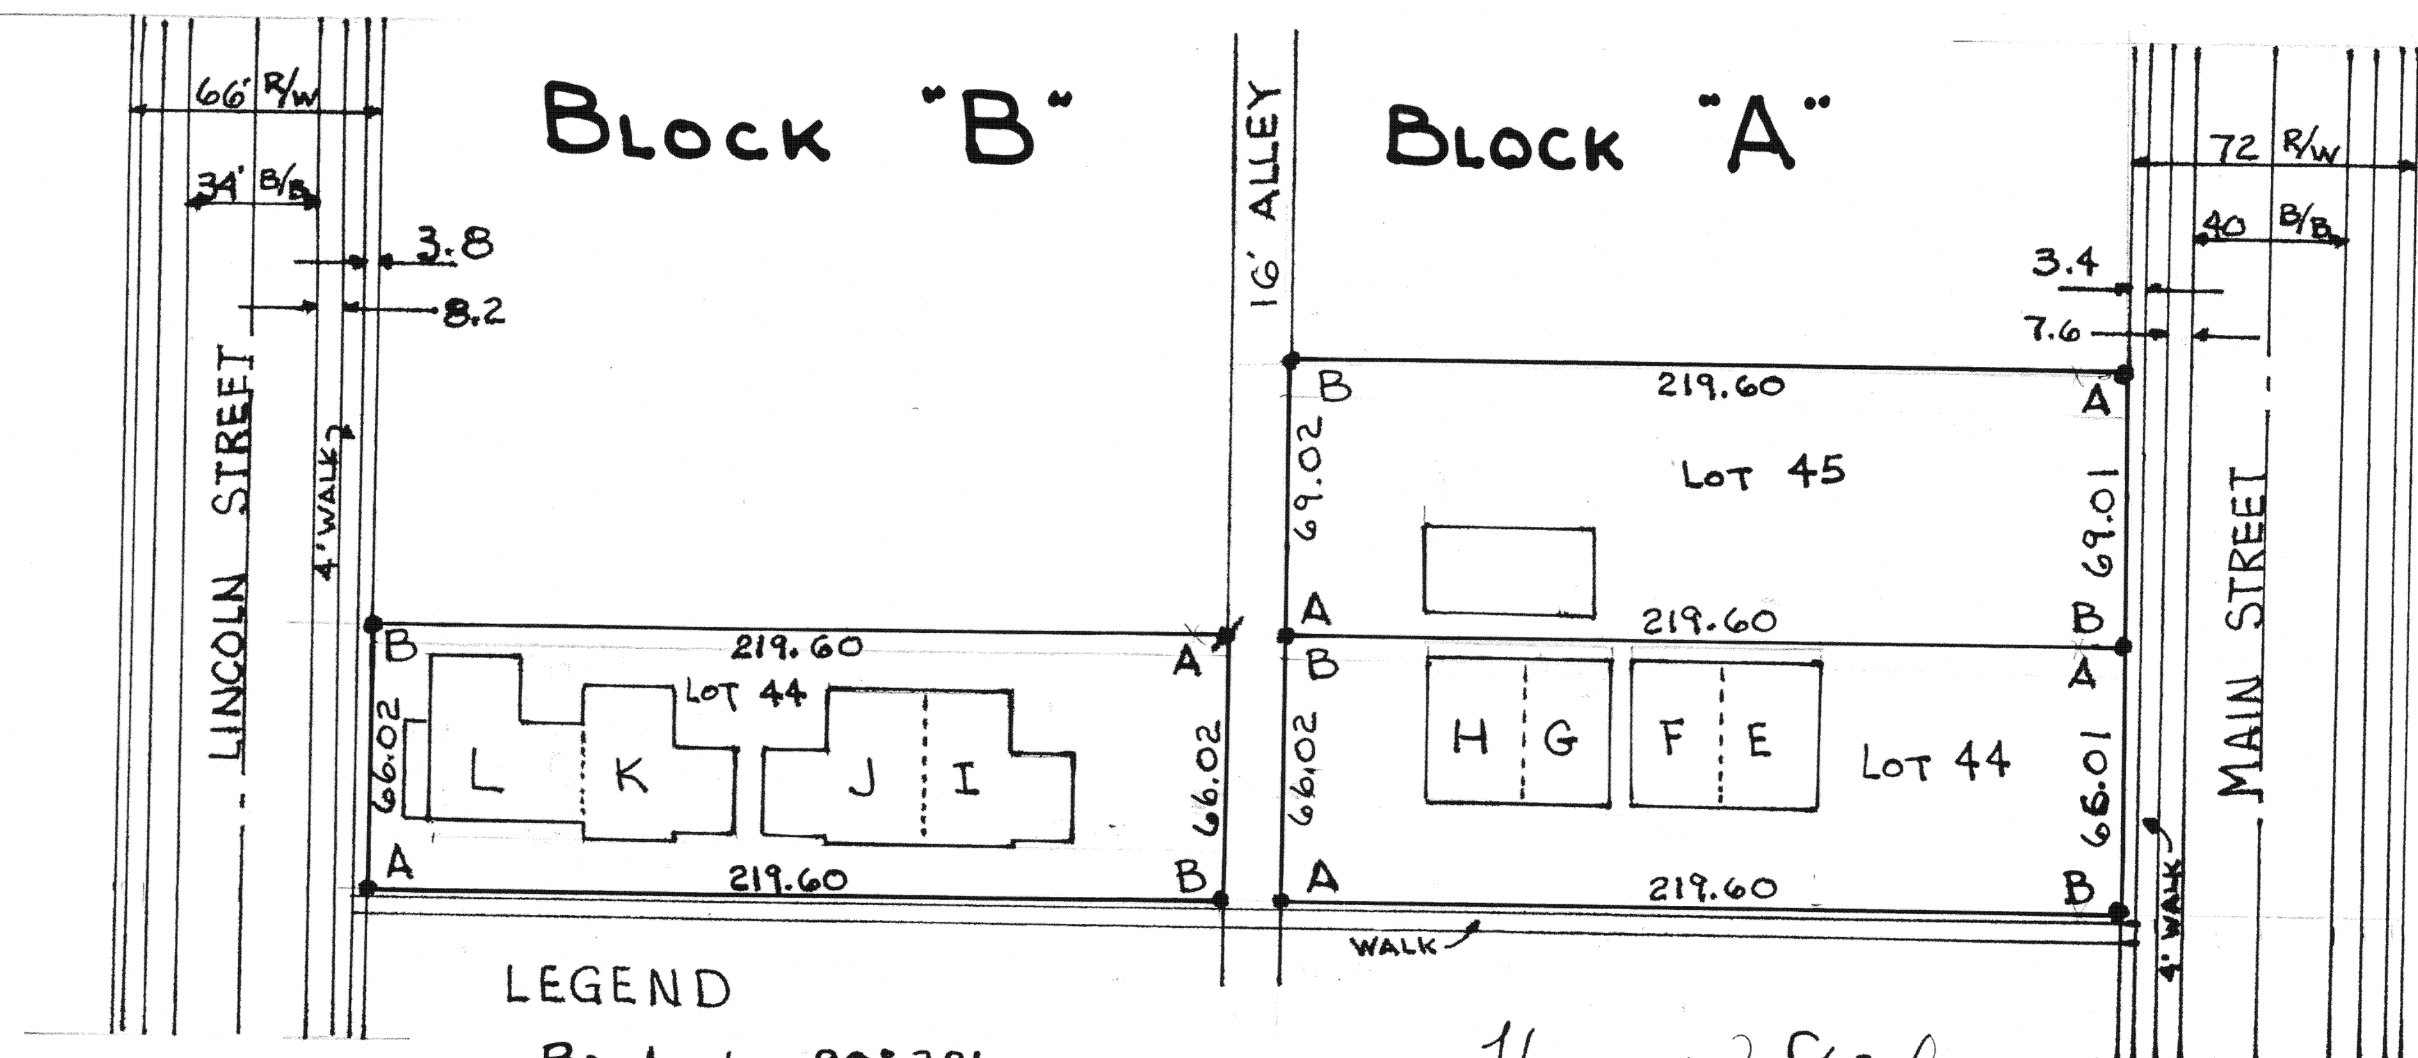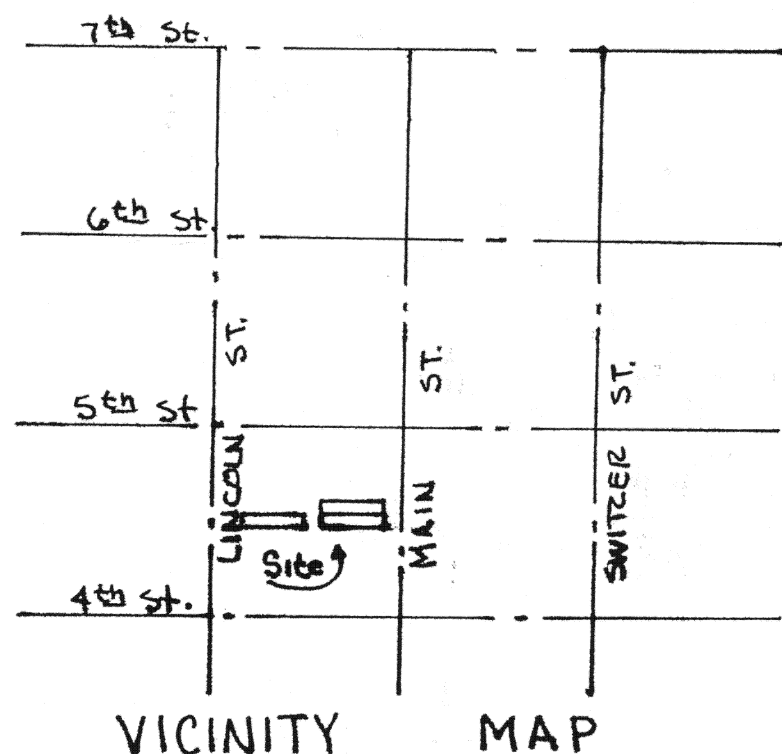

LEGEND

- B = Angle 90° 32'
- A = Angle 89° 28'
- = Iron Bar Set
- = P.K. Nail Set

Thomas W Steinke
THOMAS W. STEINKE

I Hereby Certify That The Survey Shown Hereon
Was Conducted By Me, Thomas W. Steinke -
Registered Surveyor #6177, On This 9th Day Of
November, 1990

I, THE UNDERSIGNED, BEING THE OWNER, DO HEREBY CONCENT TO AND
JOIN IN THE SUBMISSION OF THE LANDS HEREIN DESCRIBED AND THEIR INTRESTS
THEREIN TO THE CONDOMINIUM PLAN KNOWN AS LINCOLN/MAIN CONDOMINIUM
AS SET FORTH IN THE DECLARATION OF SUCH CONDOMINIUM TO BE FILED WITH
THE RECORDER OF AUGLAIZE COUNTY, OHIO UNDER THE CONDOMINIUM
STATUTES OF THE STATE OF OHIO

James F. Prenger
WITNESS
James F. Prenger
WITNESS

James F. Prenger
JAMES F. PRENGER

STATE OF OHIO: COUNTY OF AUGLAIZE: SS.
BEFORE ME, A NOTARY PUBLIC IN AND FOR SAID STATE, PERSONALLY CAME
JAMES F. PRENGER WHO ACKNOWLEDGED THE FOREGOING
TO BE HIS VOLUNTARY ACT AND DEED ON THIS 17 DAY OF DECEMBER 1990
IN TESTIMONY WHEREOF, I SET MY HAND
AND FIX MY SEAL



James F. Prenger
NOTARY PUBLIC

12/17/90
DATE




James F. Prenger
Notary Public, State of Ohio
Commission Expires Pursuant To Sec. 147.03 O.R.C.

NOTE: The & Intersections Of Main, Fourth, Ohio & Seventh Streets Measured
& The Excess Prorated As Shown

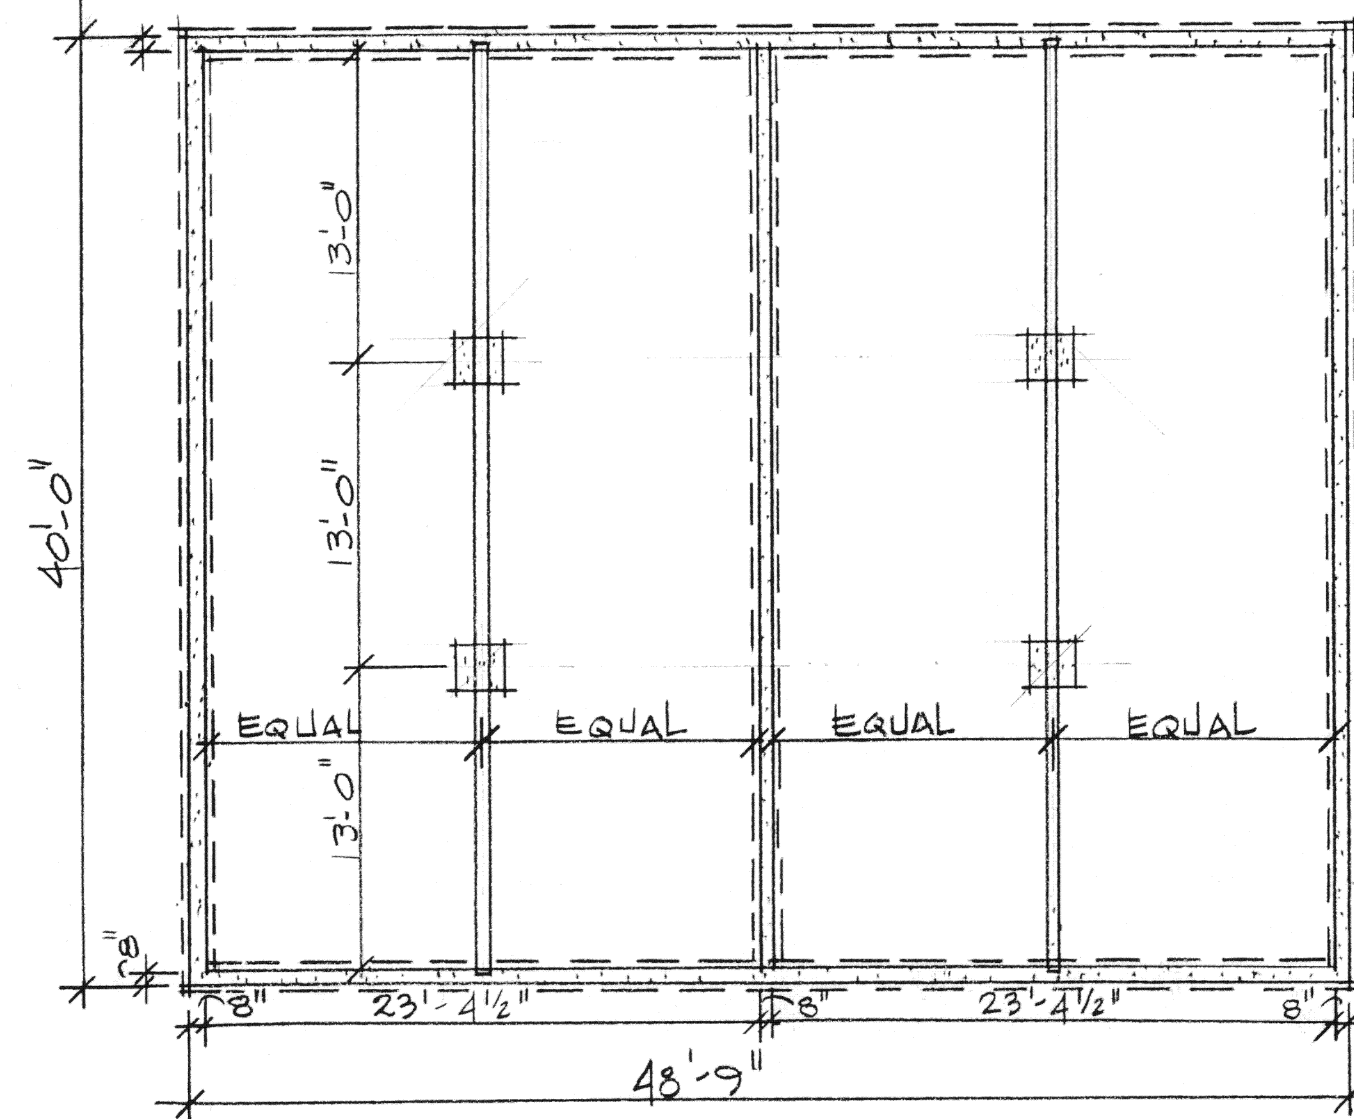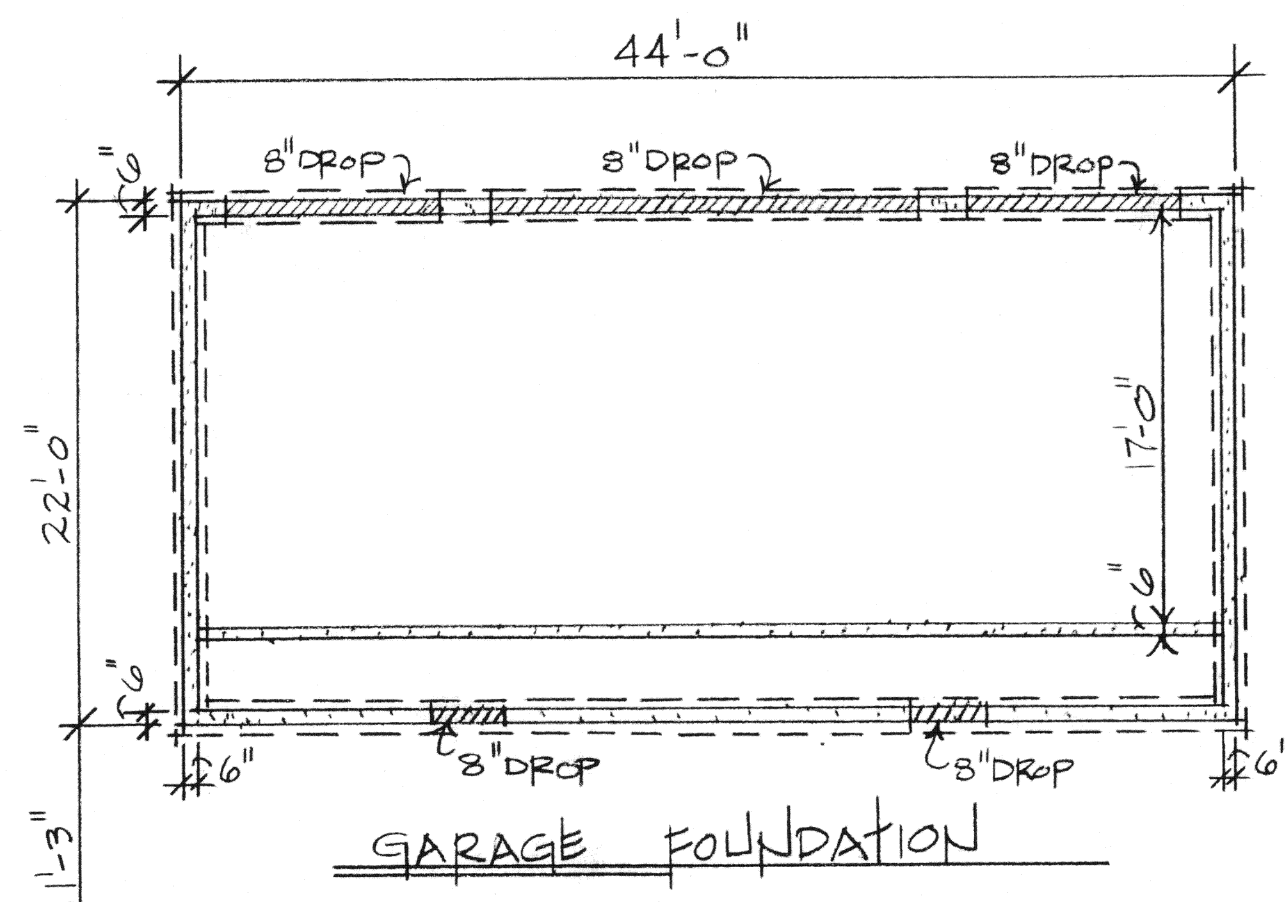


UNIT 'G'

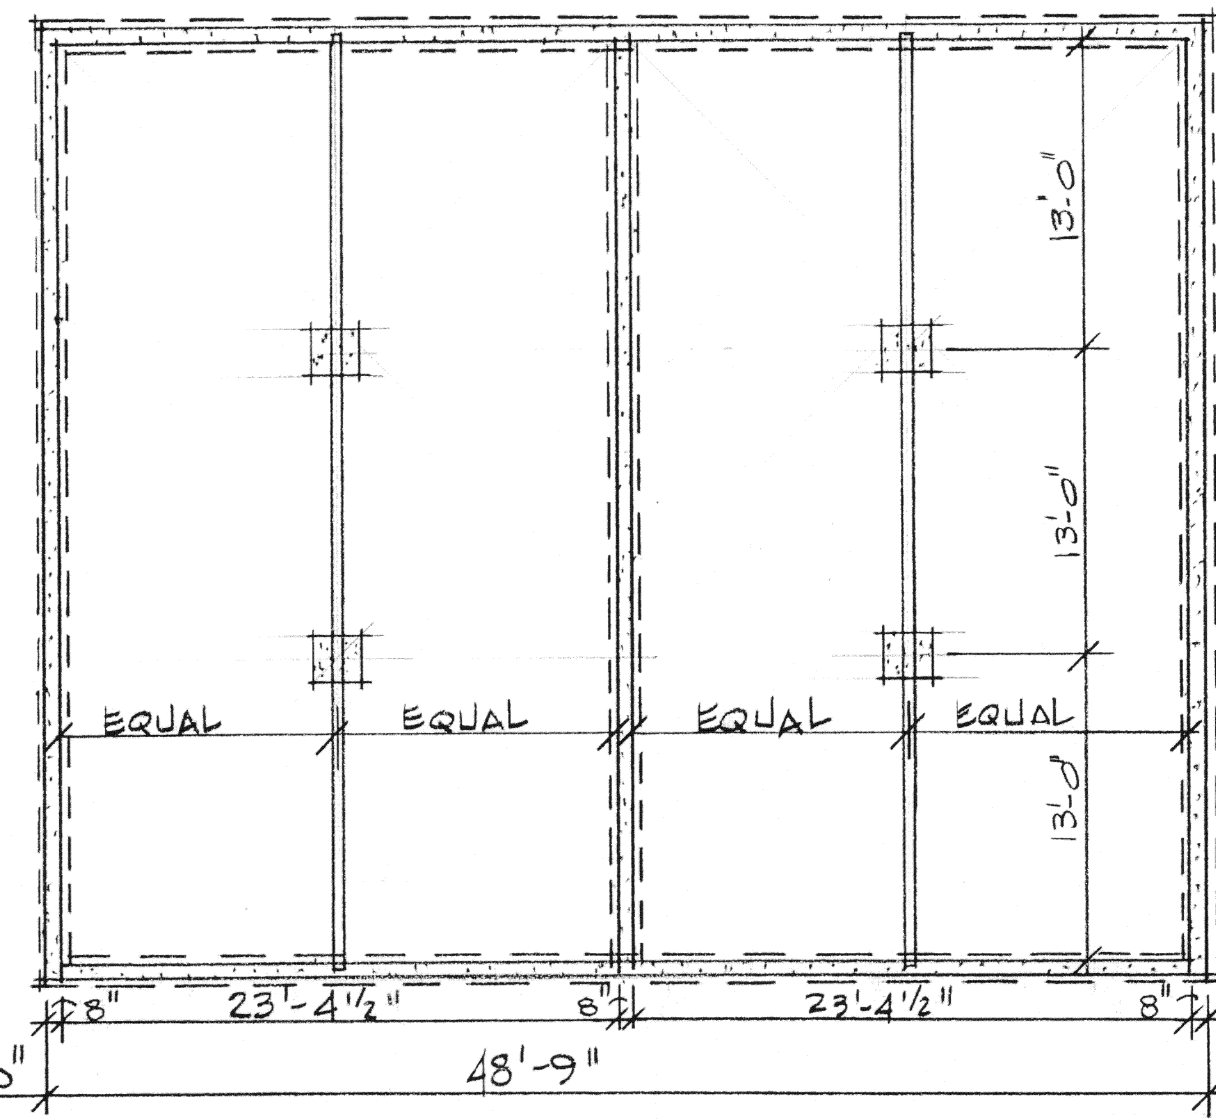

UNIT 'E'

UNIT 'H'

FOUNDATION PLANS

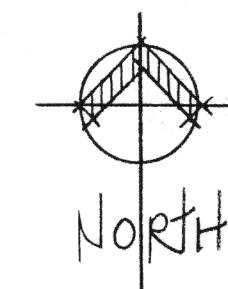

REVISIONS	BY

LINCOLN/MAN CONDOMINIUM
VILLAGE OF MINSTER
AUGLAIZE COUNTY, OHIO

Date 12/7/90

Scale 1/8" = 1'-0"




Drawn JBP

Job

Sheet

3

Of 8 Sheets

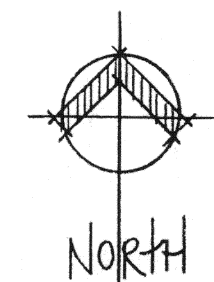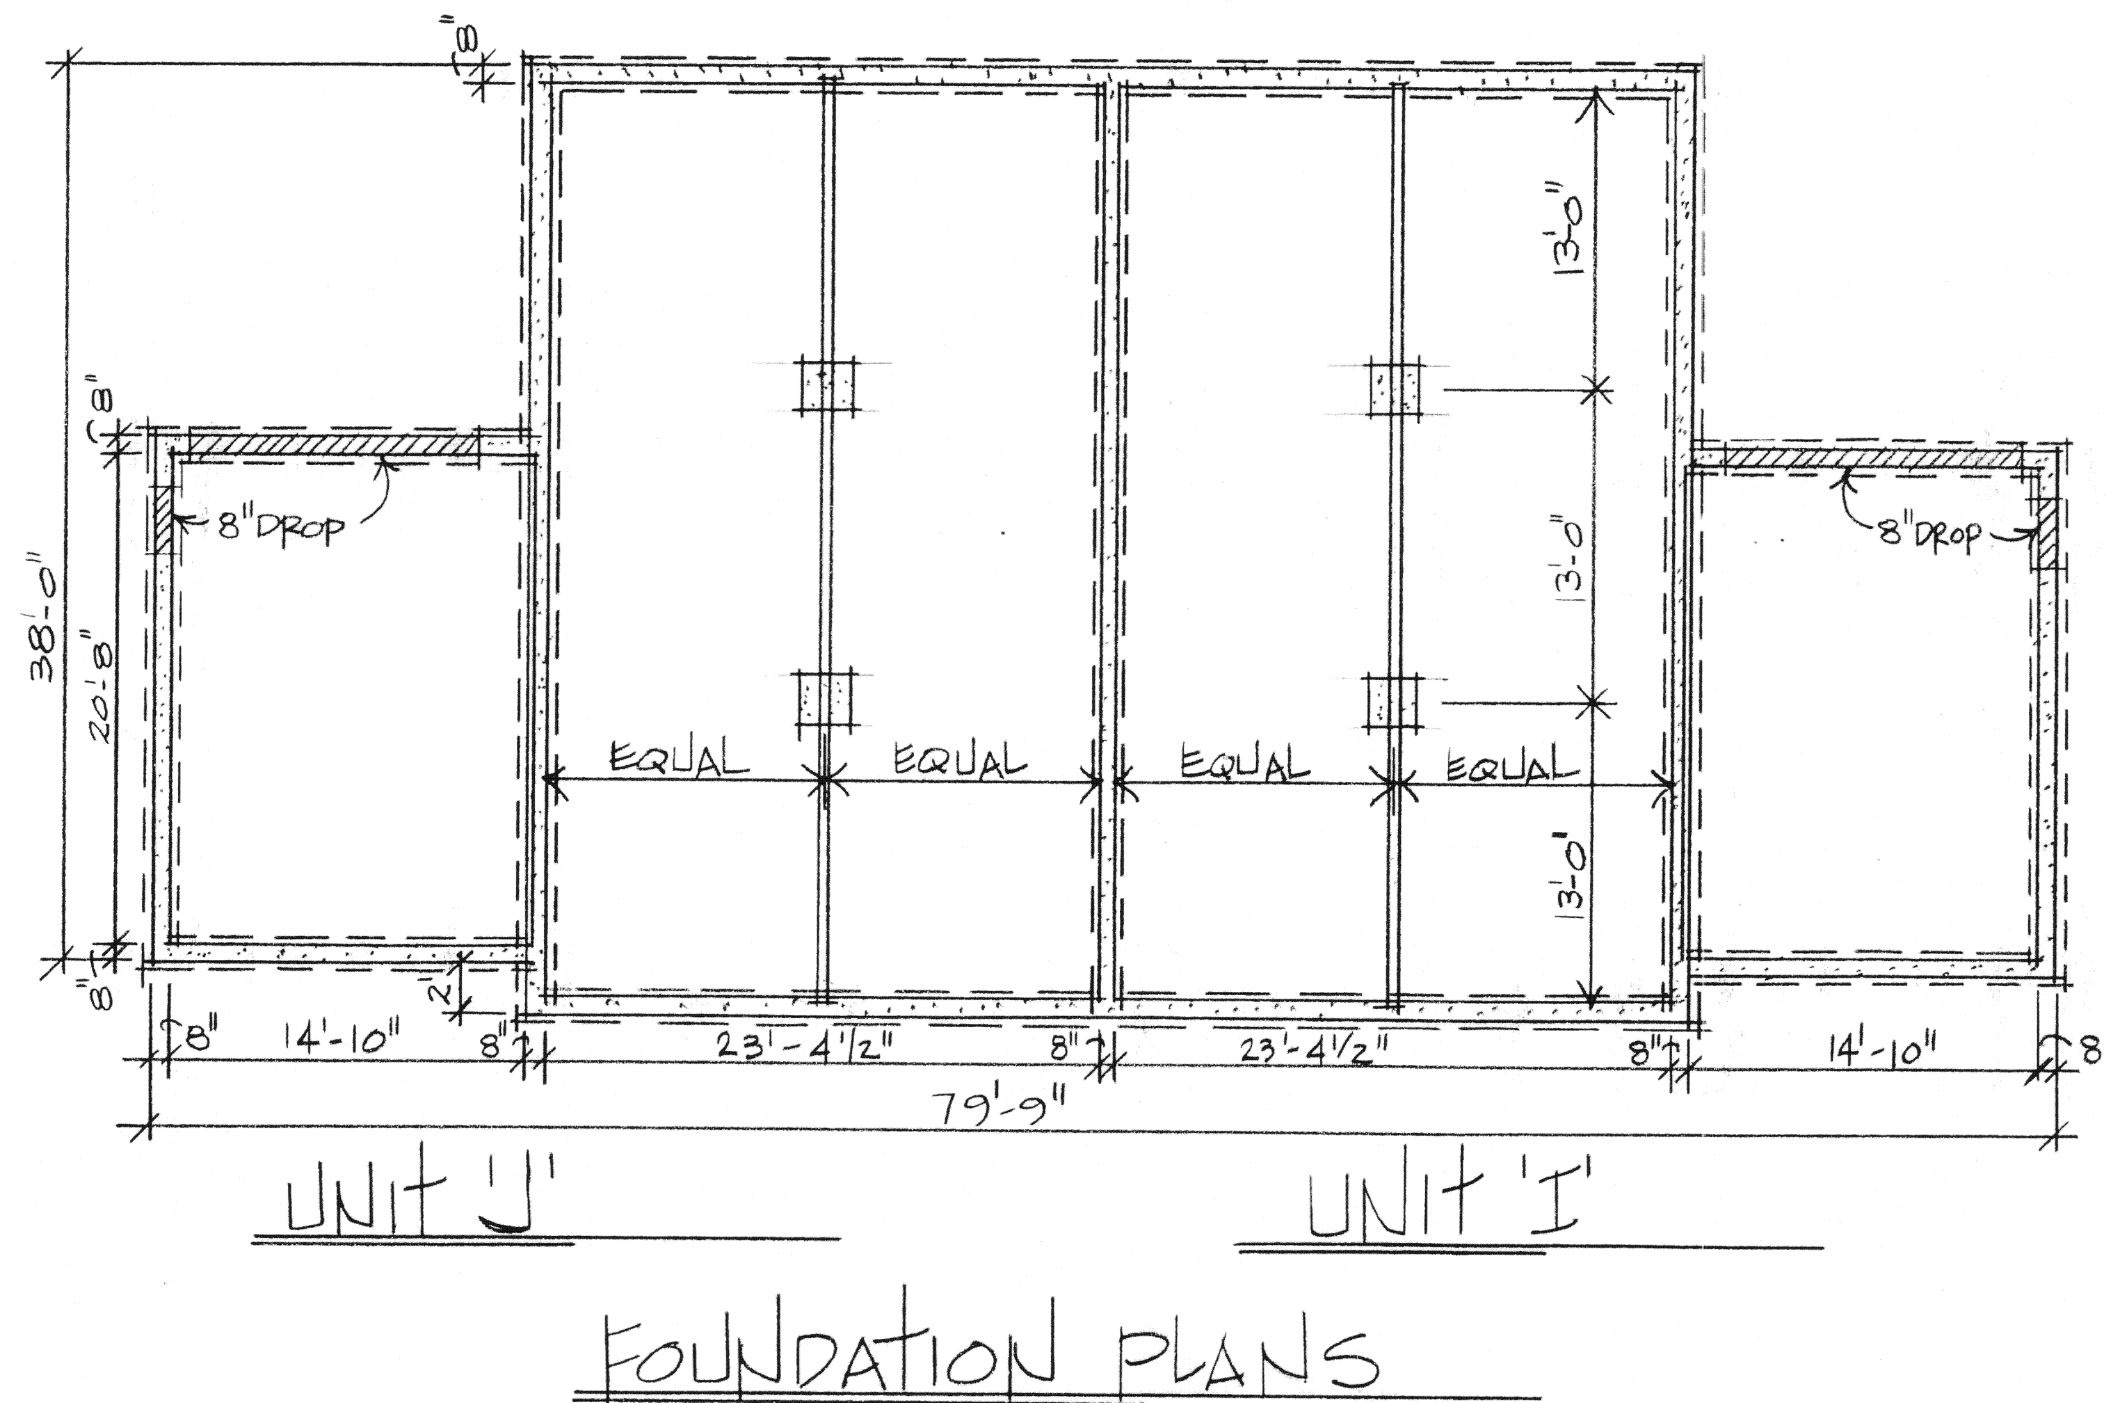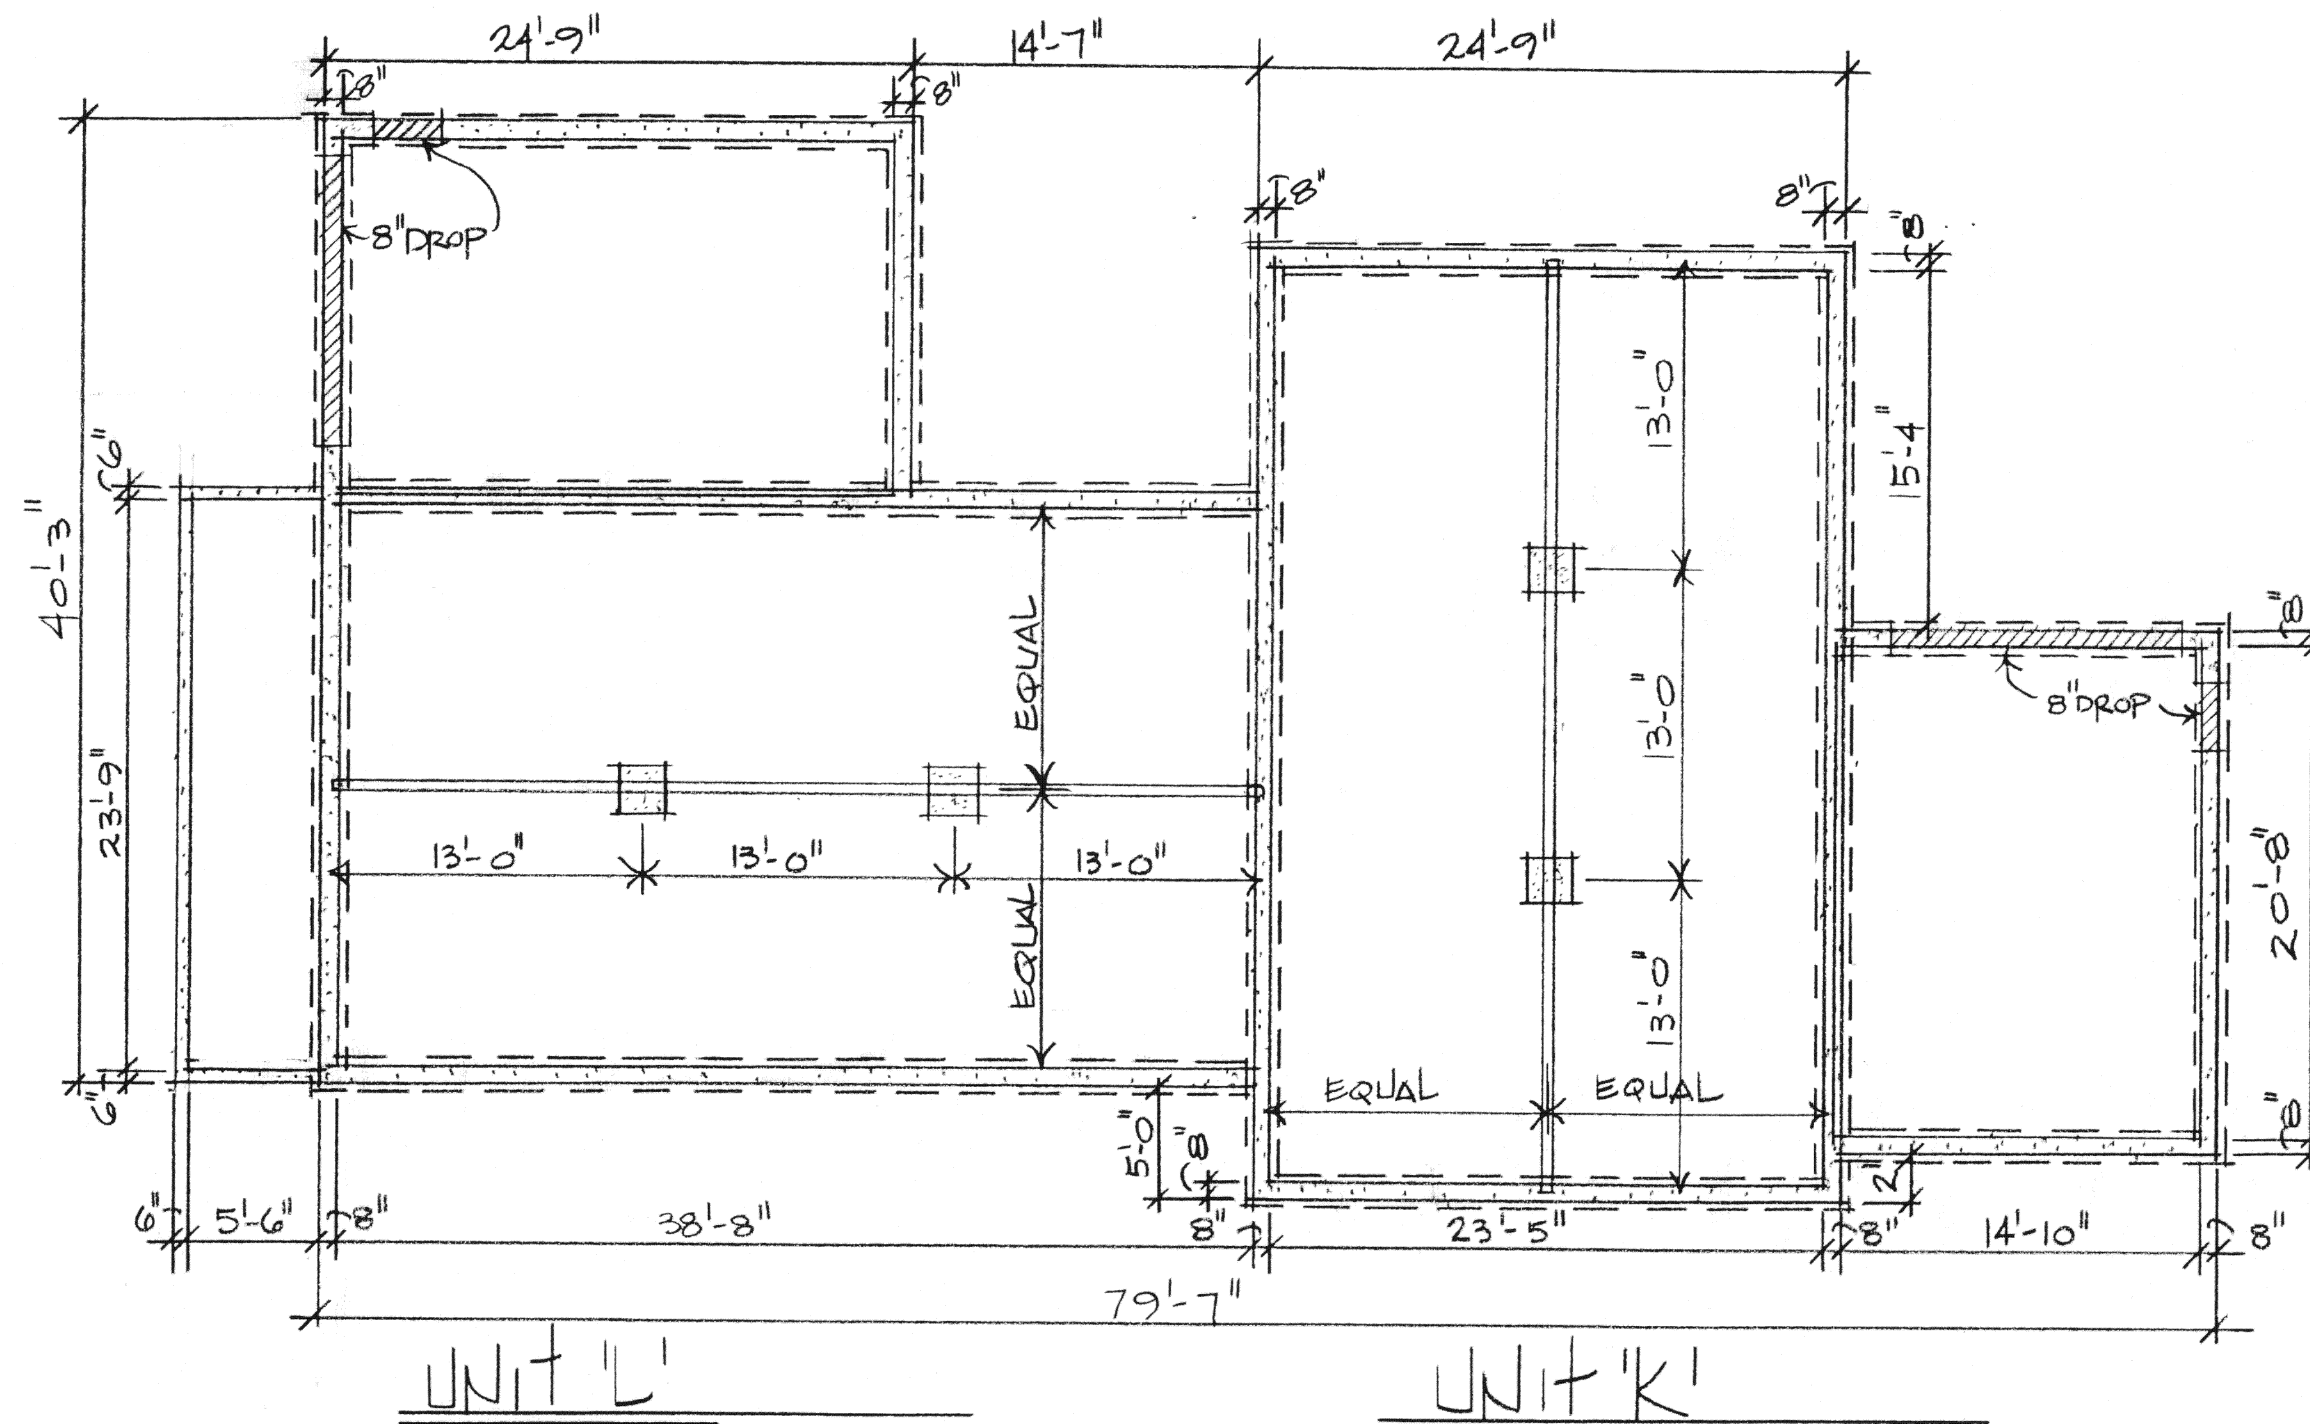

REVISIONS	BY


LINCOLN/MAIN CONDOMINIUM
VILLAGE OF MINSTER
AUGLAIZE COUNTY, OHIO

Date	12/7/90
Scale	1/8"=1'-0"
Drawn	JBF
Job	
Sheet	4
Of	8 Sheets




REVISIONS	BY


LINCOLN/MAYN CONDOMINIUM
VILLAGE OF MINSTER
AUGLAIZE COUNTY, OHIO

Date	12/7/90
Scale	1/8" = 1'-0"
Drawn	JBF
Job	
Sheet	5
Of	8
Sheets	

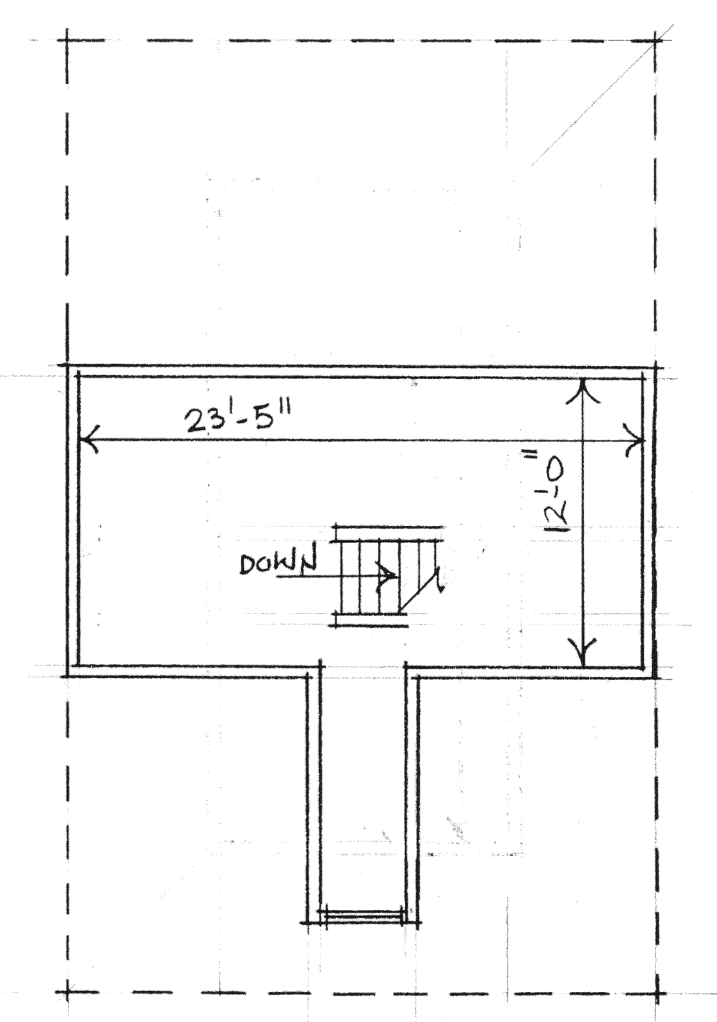


SECOND FLOOR
(TYPICAL UNITS E, F, G, H)

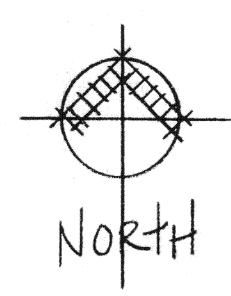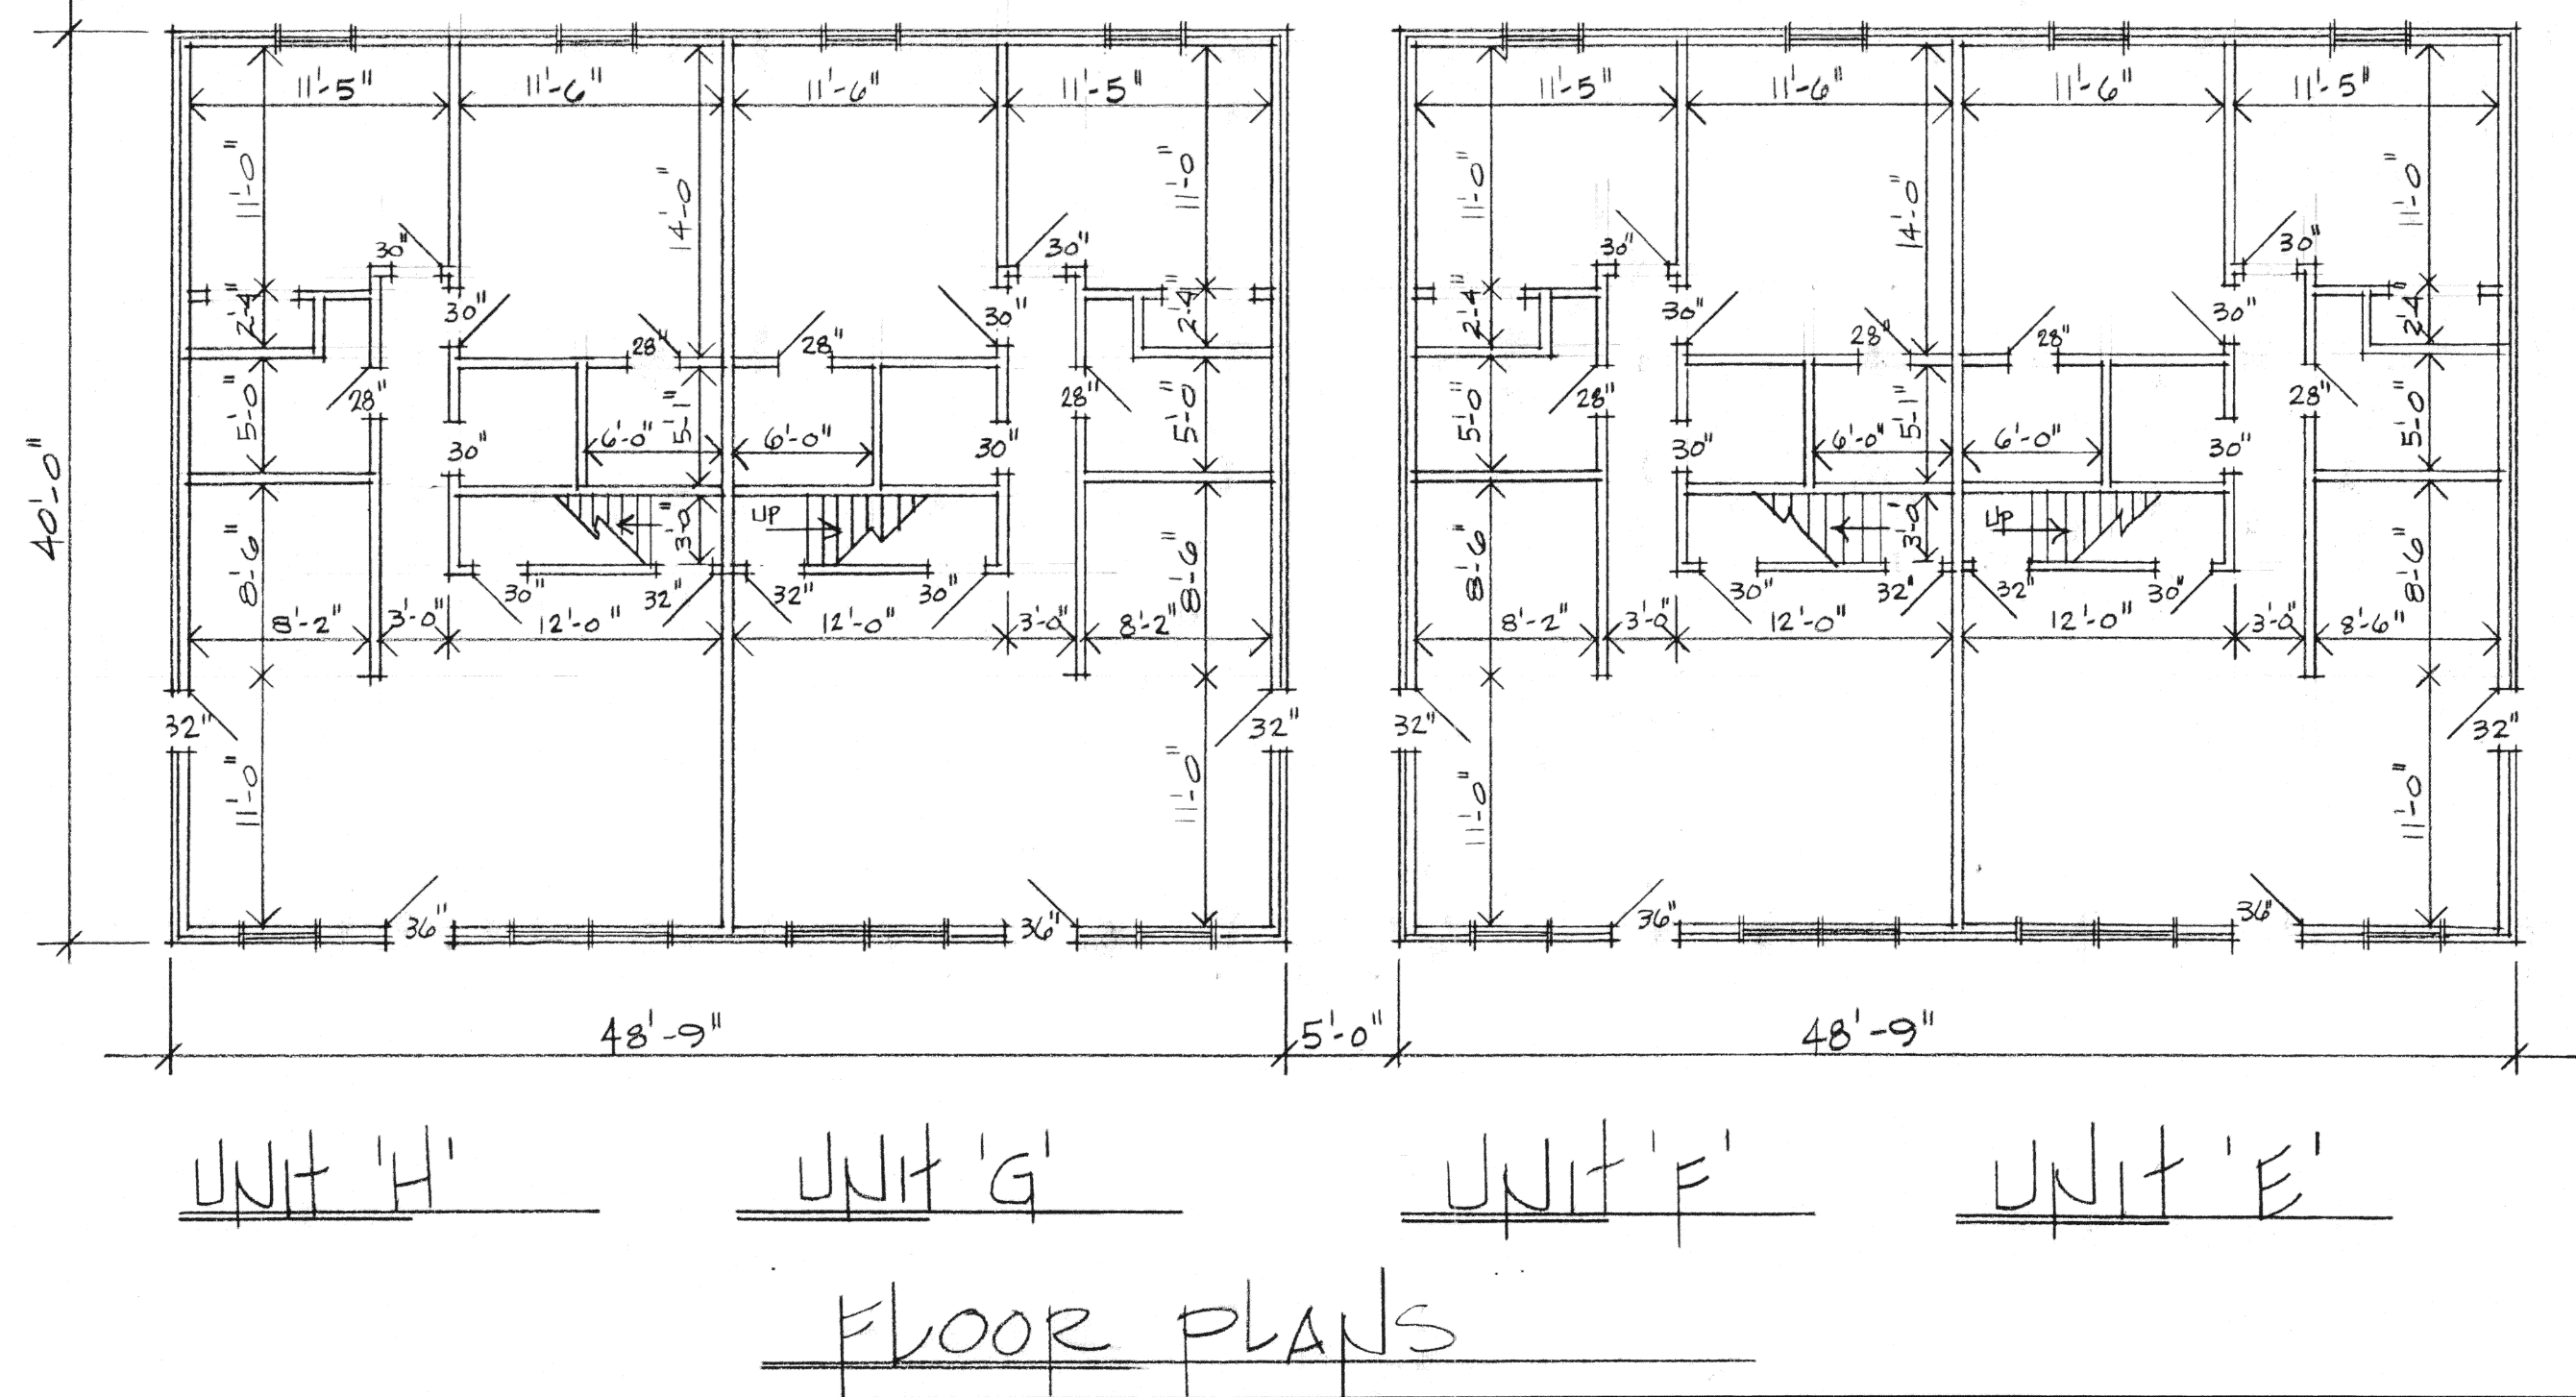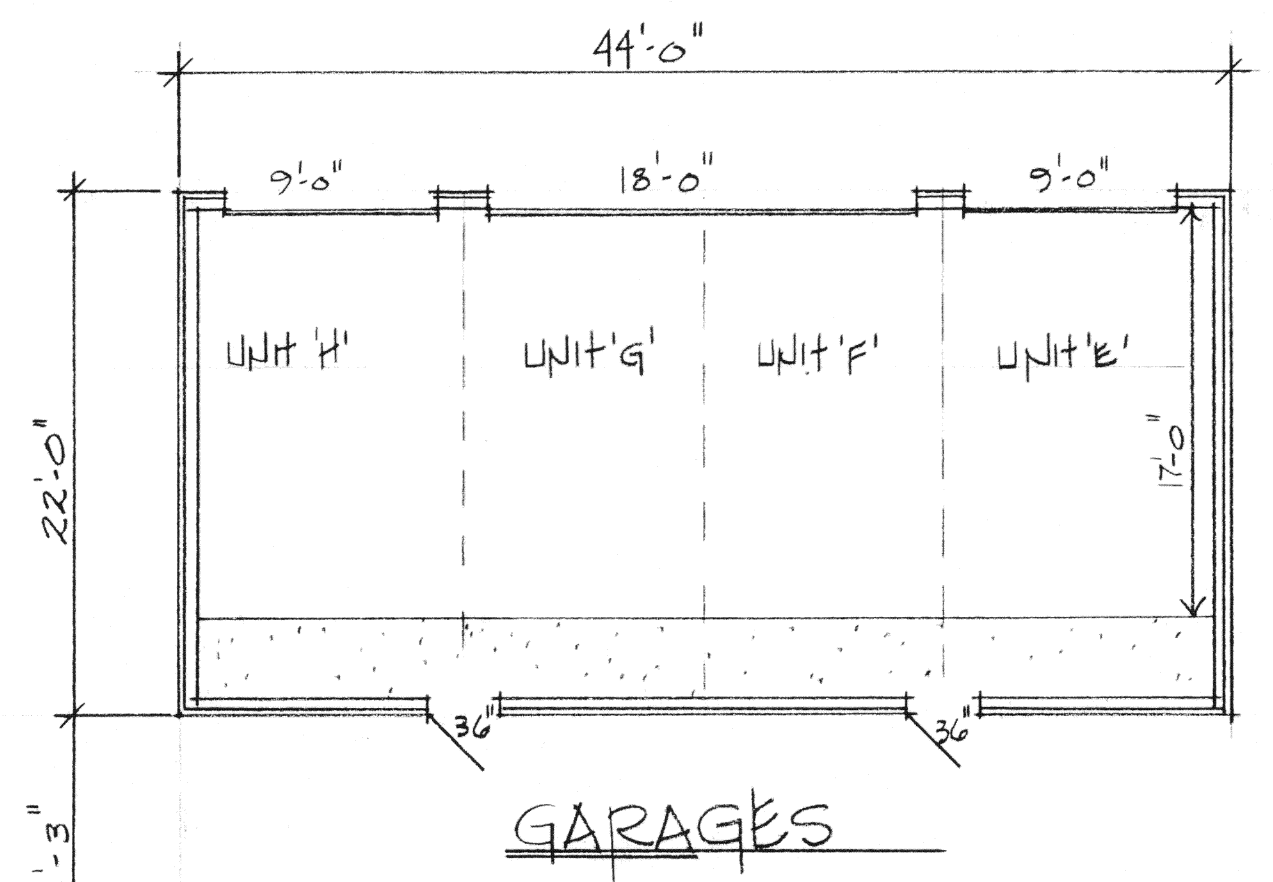

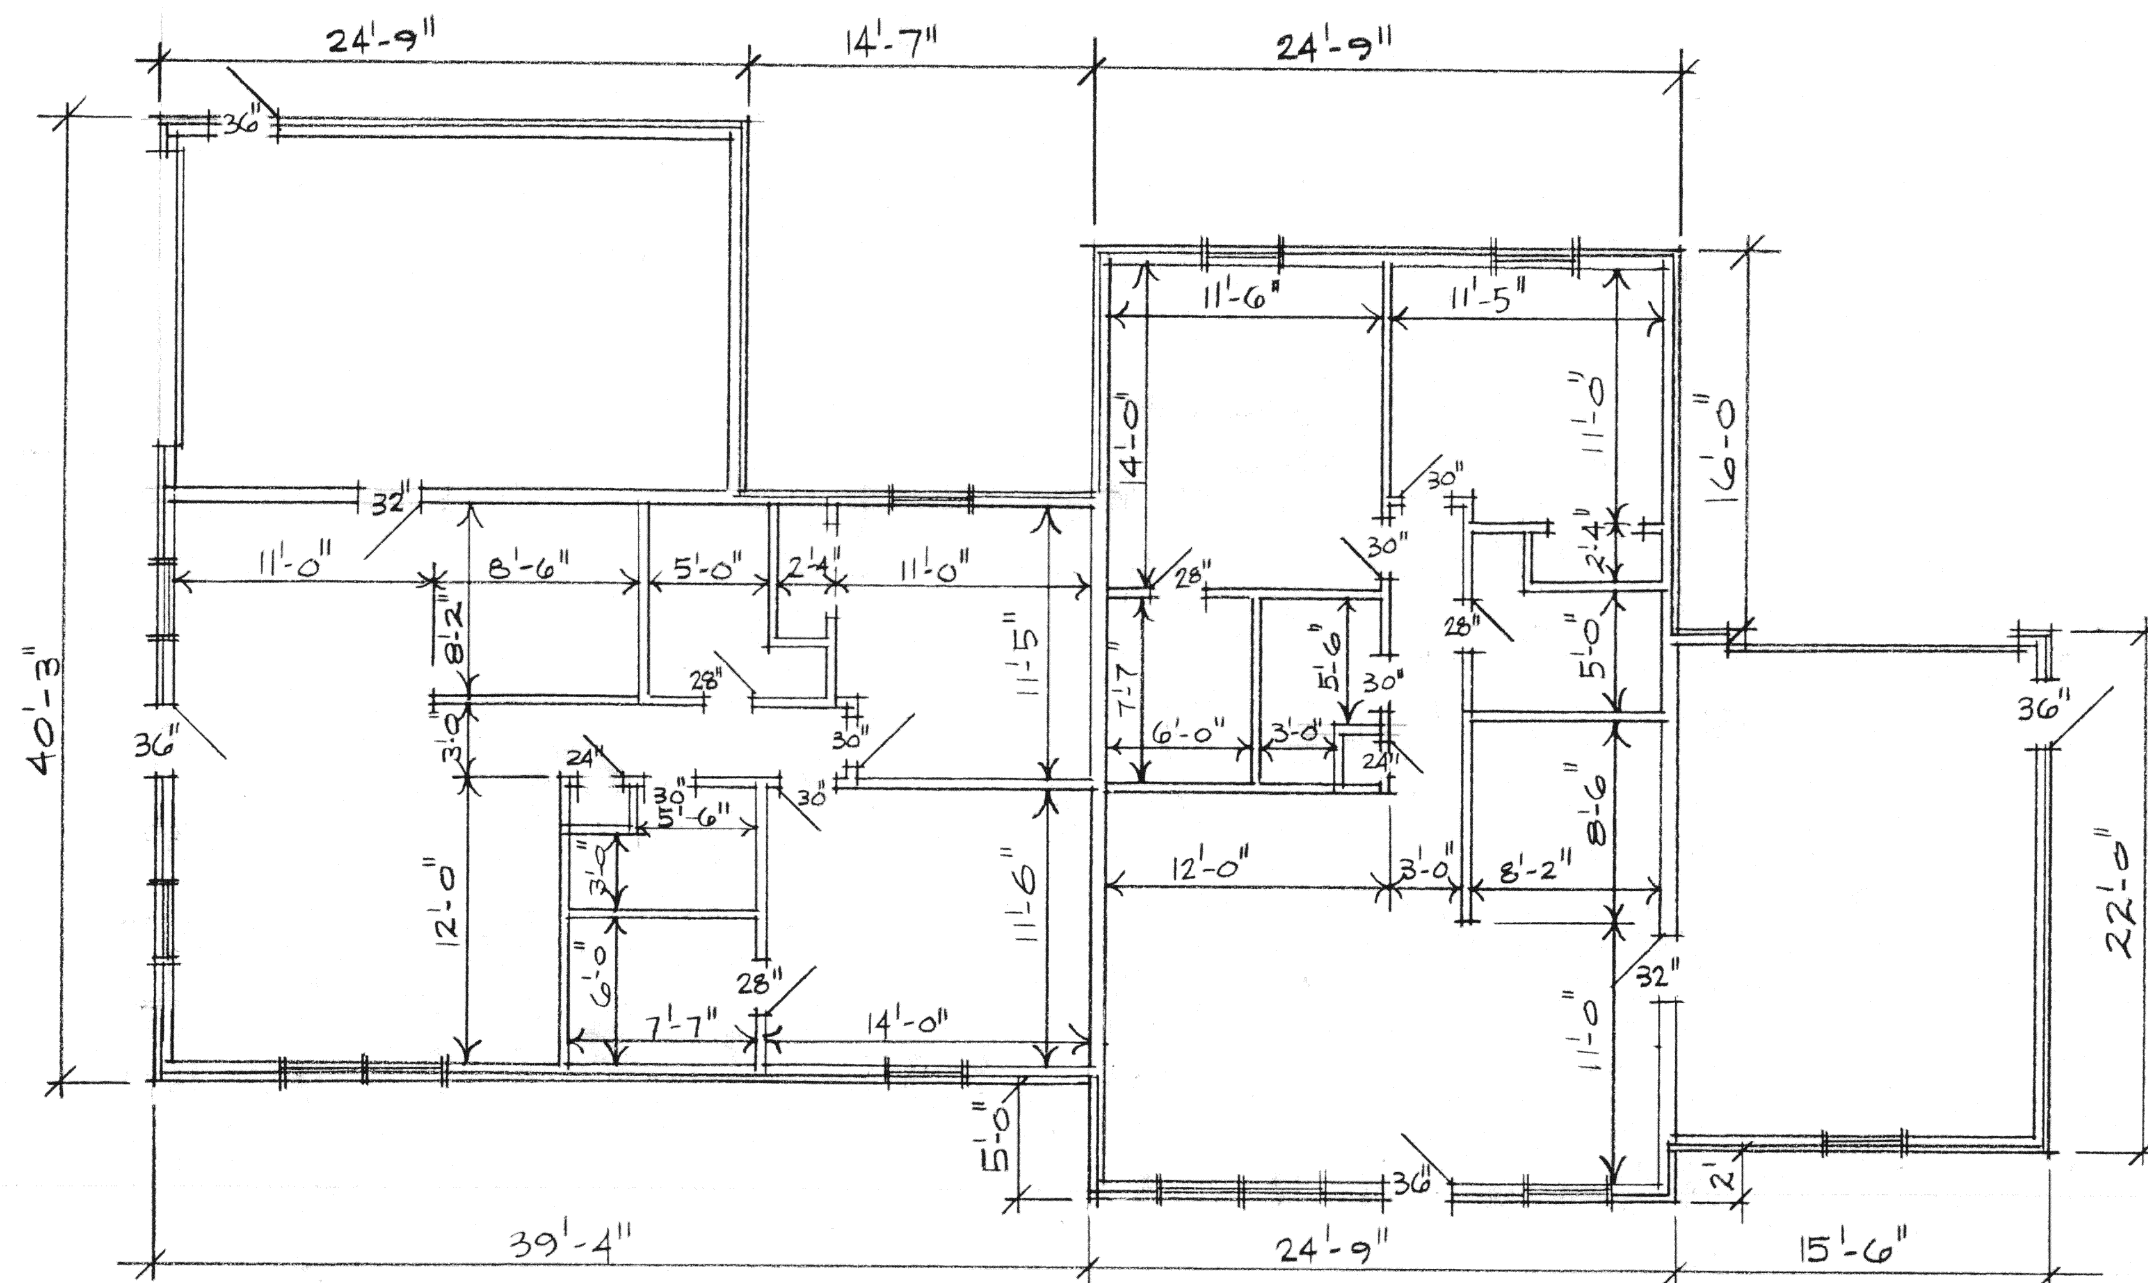

UNIT 'L'


UNIT 'K'

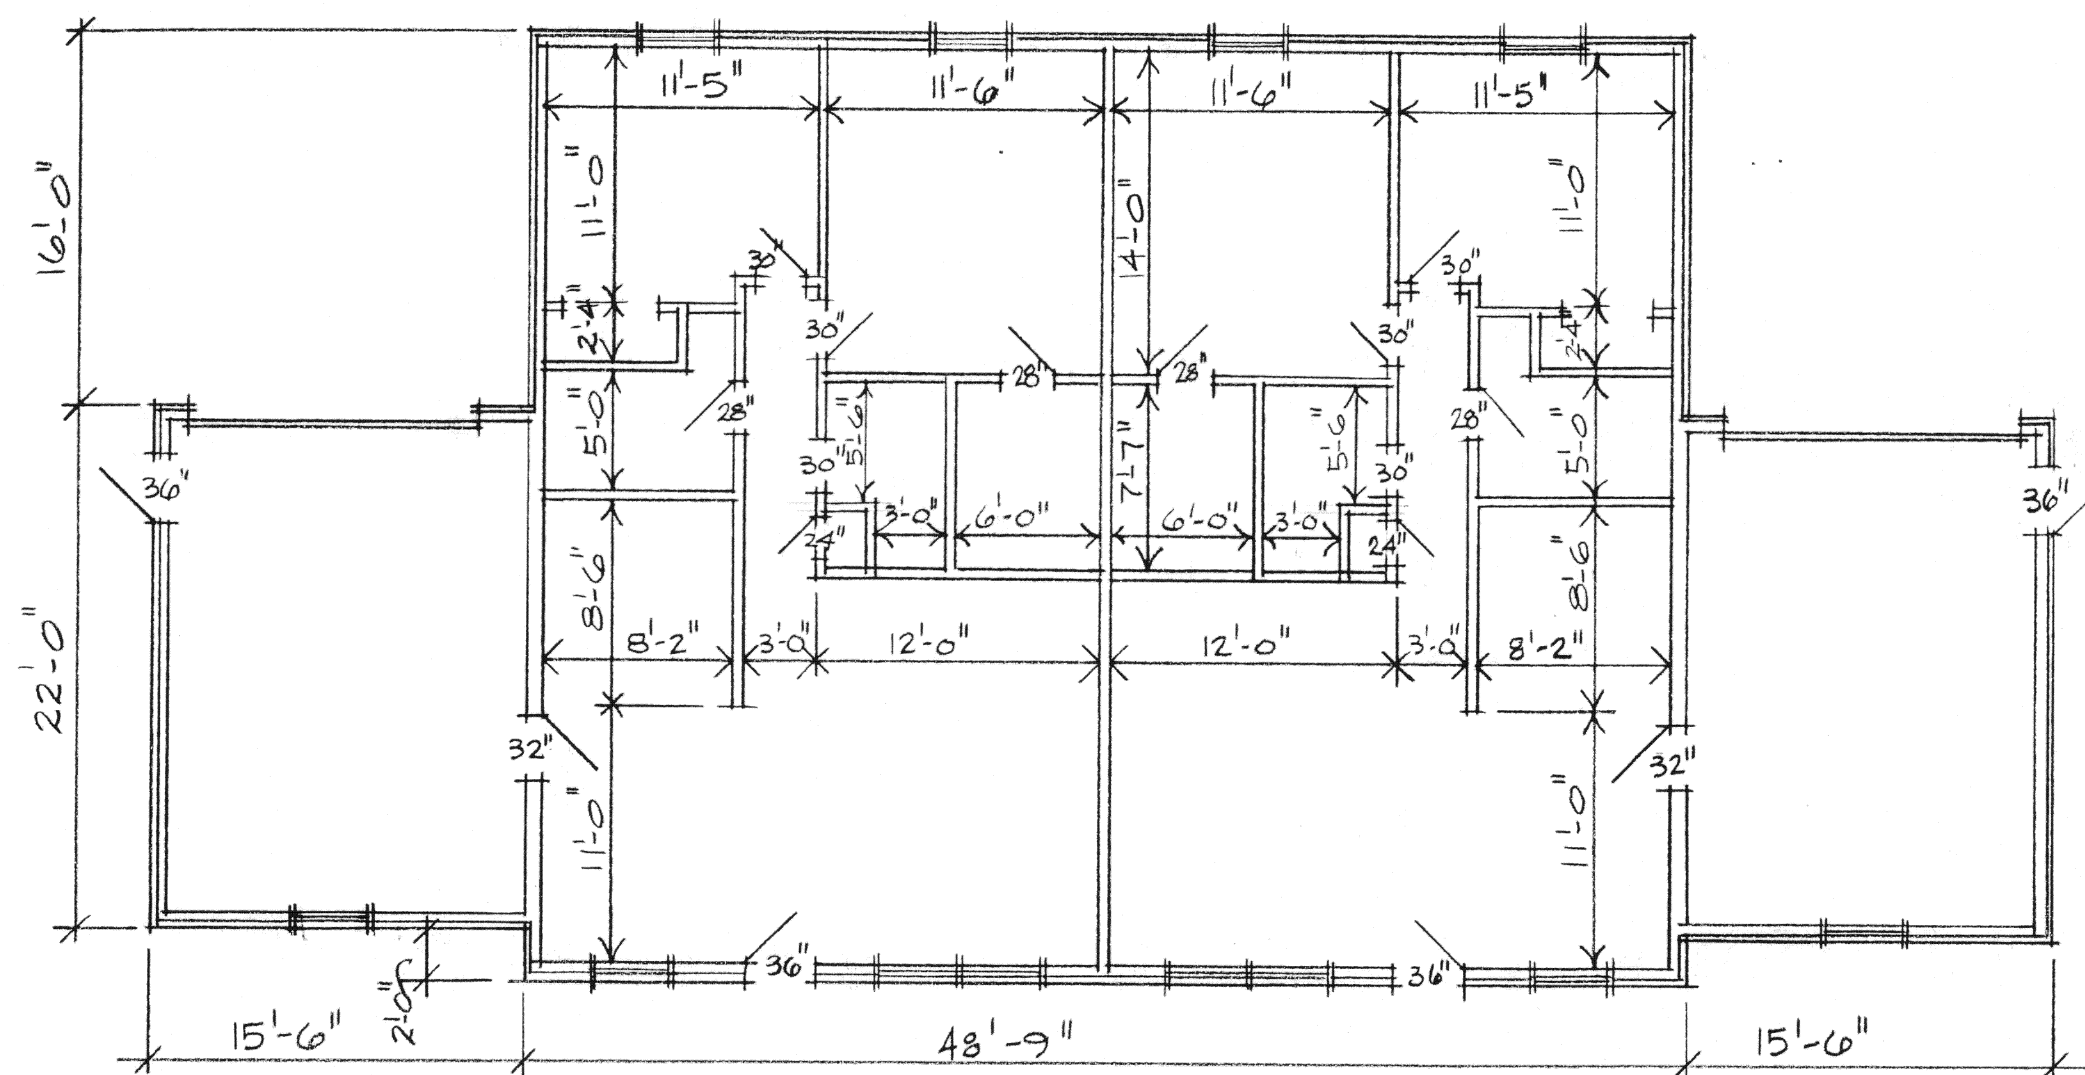

UNIT 'J'

UNIT 'I'

FLOOR PLANS

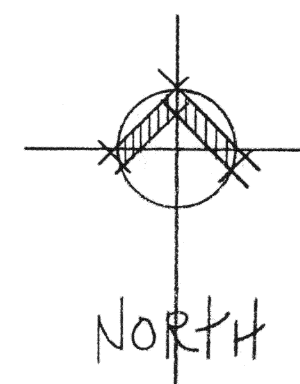

REVISIONS	BY

LINCOLN/MAIN CONDOMINIUM
VILLAGE OF MINSTER
AUGLAIZE COUNTY, OHIO

Date 12/7/90

Scale 1/8" = 1'-0"

Drawn JBF

Job


Sheet 6

Of 8 Sheets


REVISIONS	BY

LINCOLN / MAIN CONDOMINIUM
 VILLAGE OF MINSTER
 AUGLAIZE COUNTY, OHIO


Date	12/7/90
Scale	1/8" = 1'-0"
Drawn	JHP
Job	
Sheet	7
Of	8 Sheets

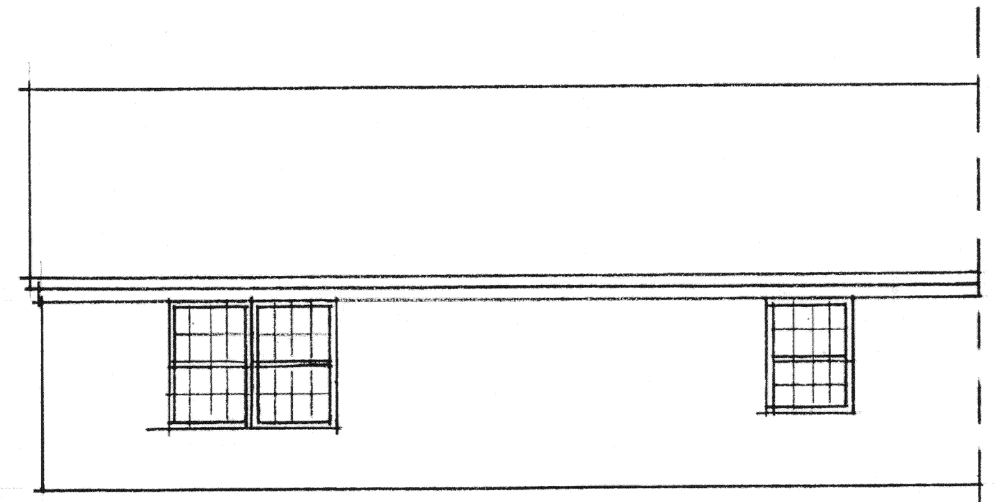


SOUTH ELEVATION-UNIT 'L'

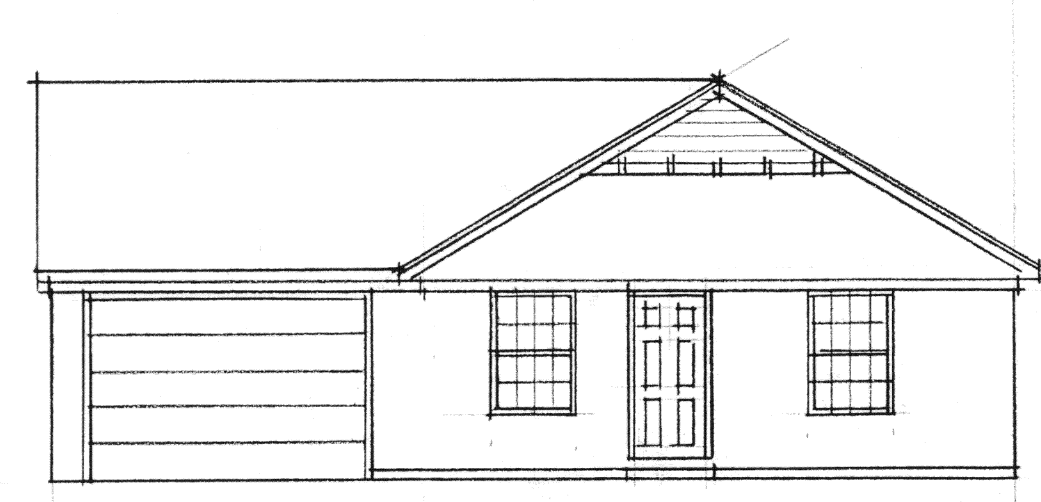


WEST ELEVATION-UNIT 'L'

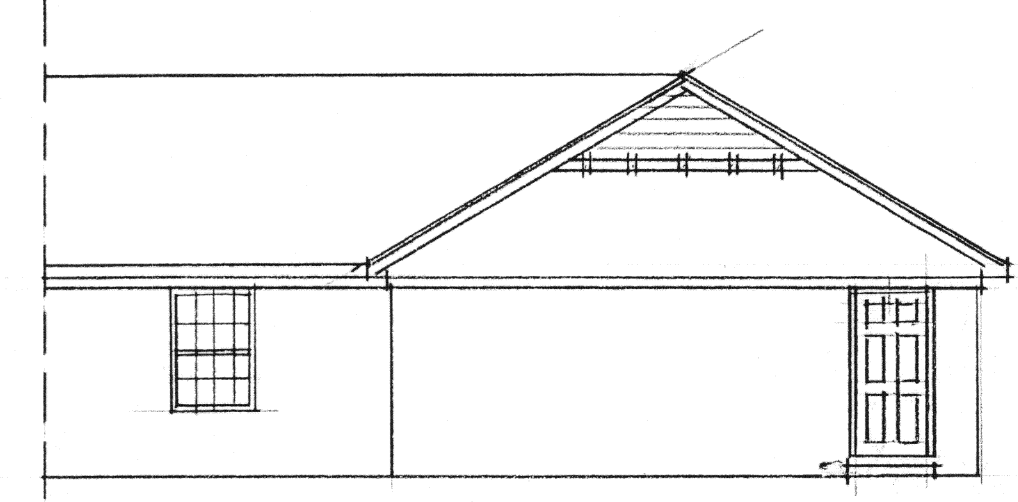


NORTH ELEVATION-UNIT 'L'

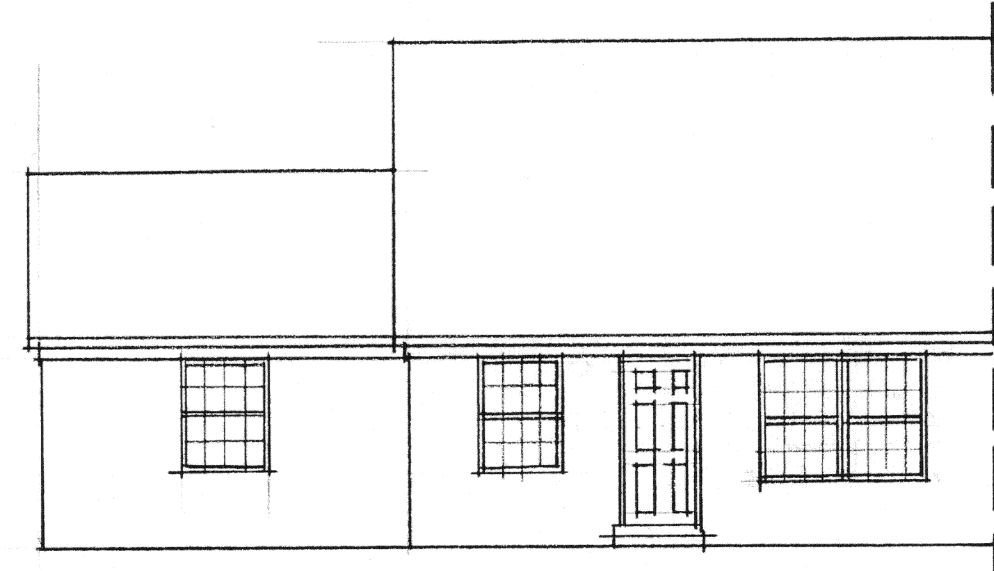


SOUTH ELEVATION-UNIT 'J'
 (SOUTH ELEVATION-UNITS 'I' & 'K'
 OPPOSITE HAND)

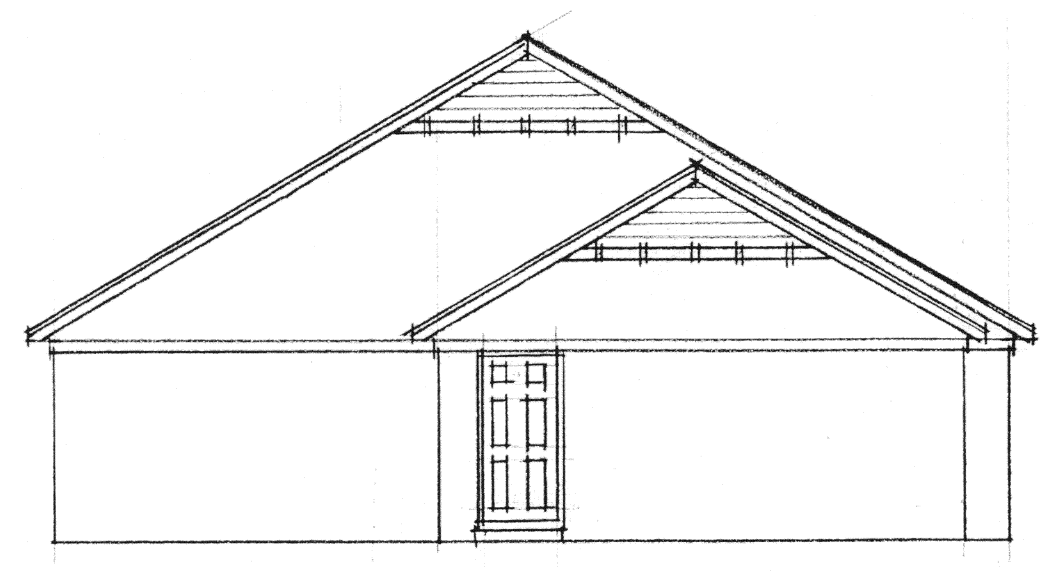


WEST ELEVATION-UNIT 'J'
 (EAST ELEVATION-UNITS 'I' & 'K'
 OPPOSITE HAND)

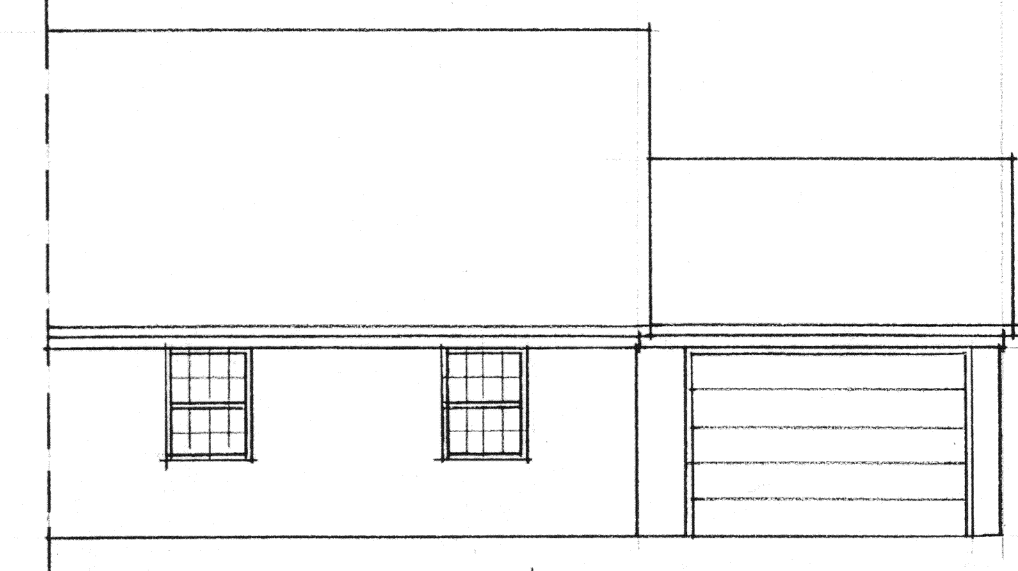


NORTH ELEVATION-UNIT 'J'
 (NORTH ELEVATION-UNITS 'I' & 'K'
 OPPOSITE HAND)

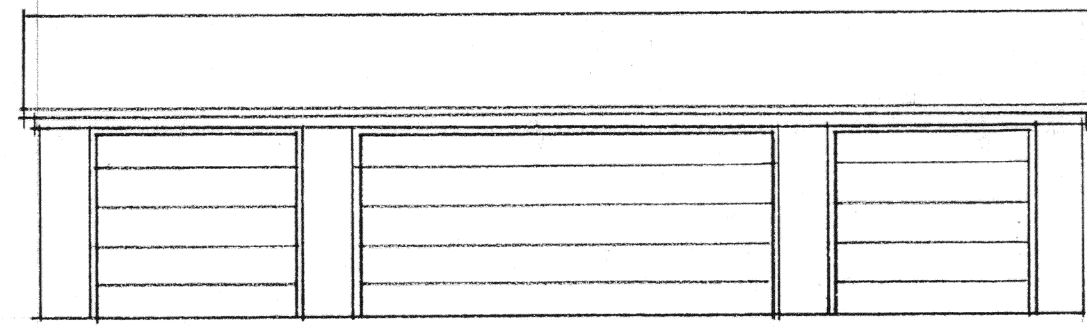


NORTH ELEVATION-GARAGE

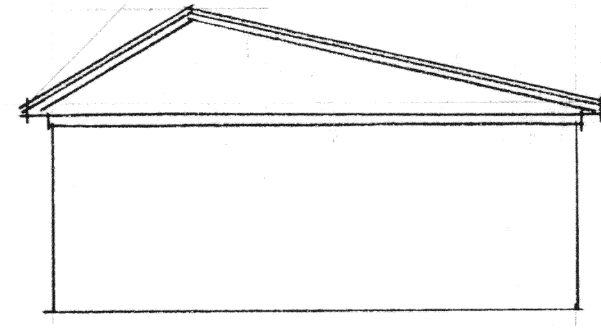


EAST ELEVATION-GARAGE
 (WEST OPPOSITE HAND)

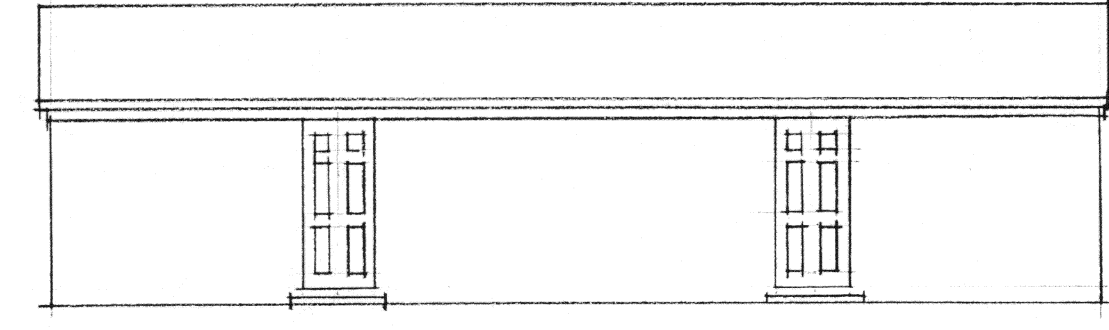


SOUTH ELEVATION-GARAGE

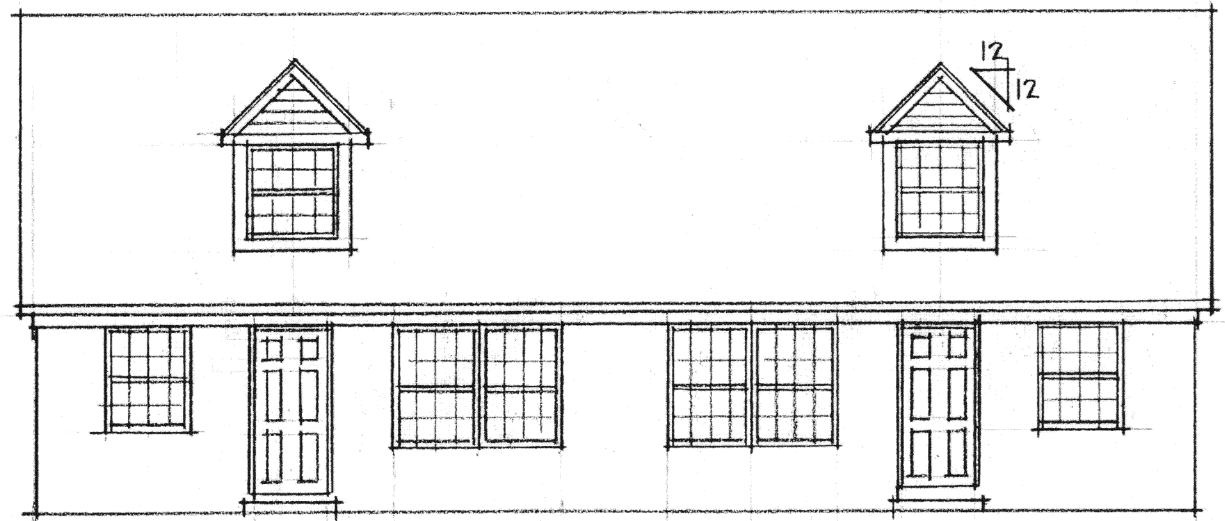

SOUTH ELEVATION-UNITS 'E', 'F' & 'G', 'H'

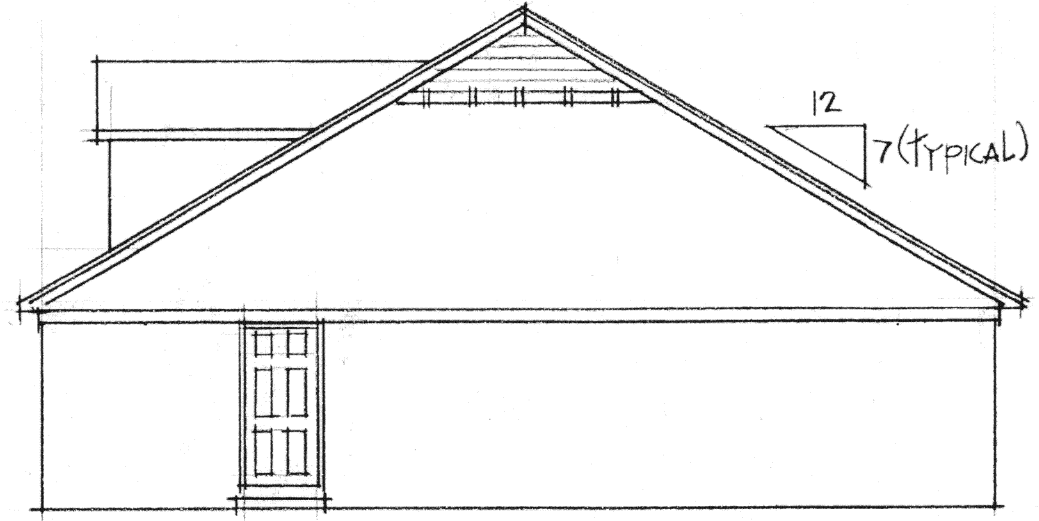


EAST ELEVATION-UNITS 'E' & 'G'
 WEST ELEVATION-UNITS 'F' & 'H'
 (OPPOSITE HAND)

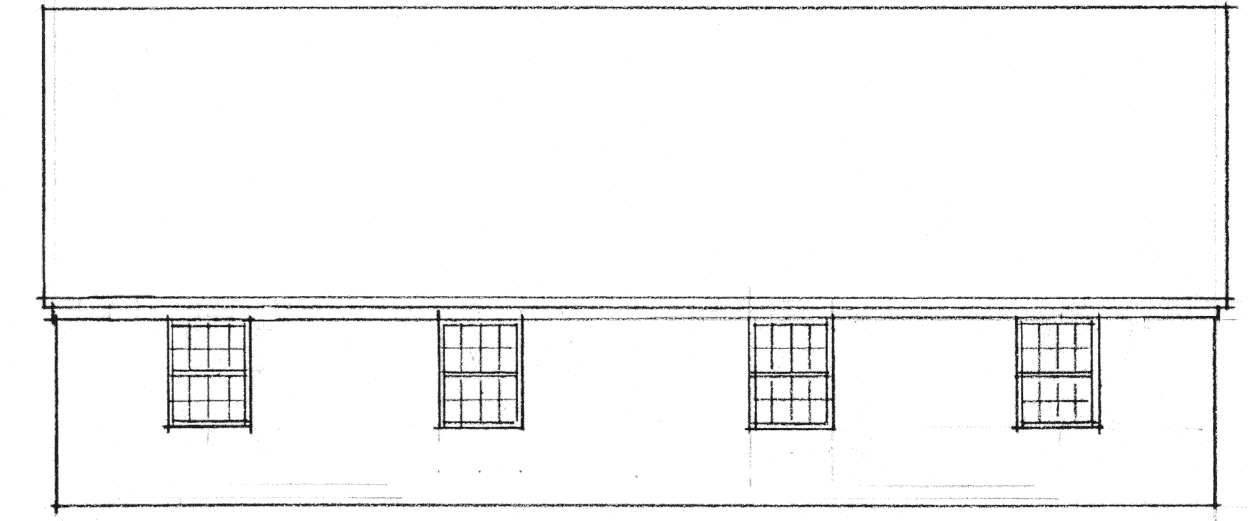

NORTH ELEVATION-UNITS 'E', 'F' & 'G', 'H'

REVISIONS	BY

LINCOLN/MAIN CONDOMINIUM
VILLAGE OF MINSTER
AUGLAIZE COUNTY, OHIO

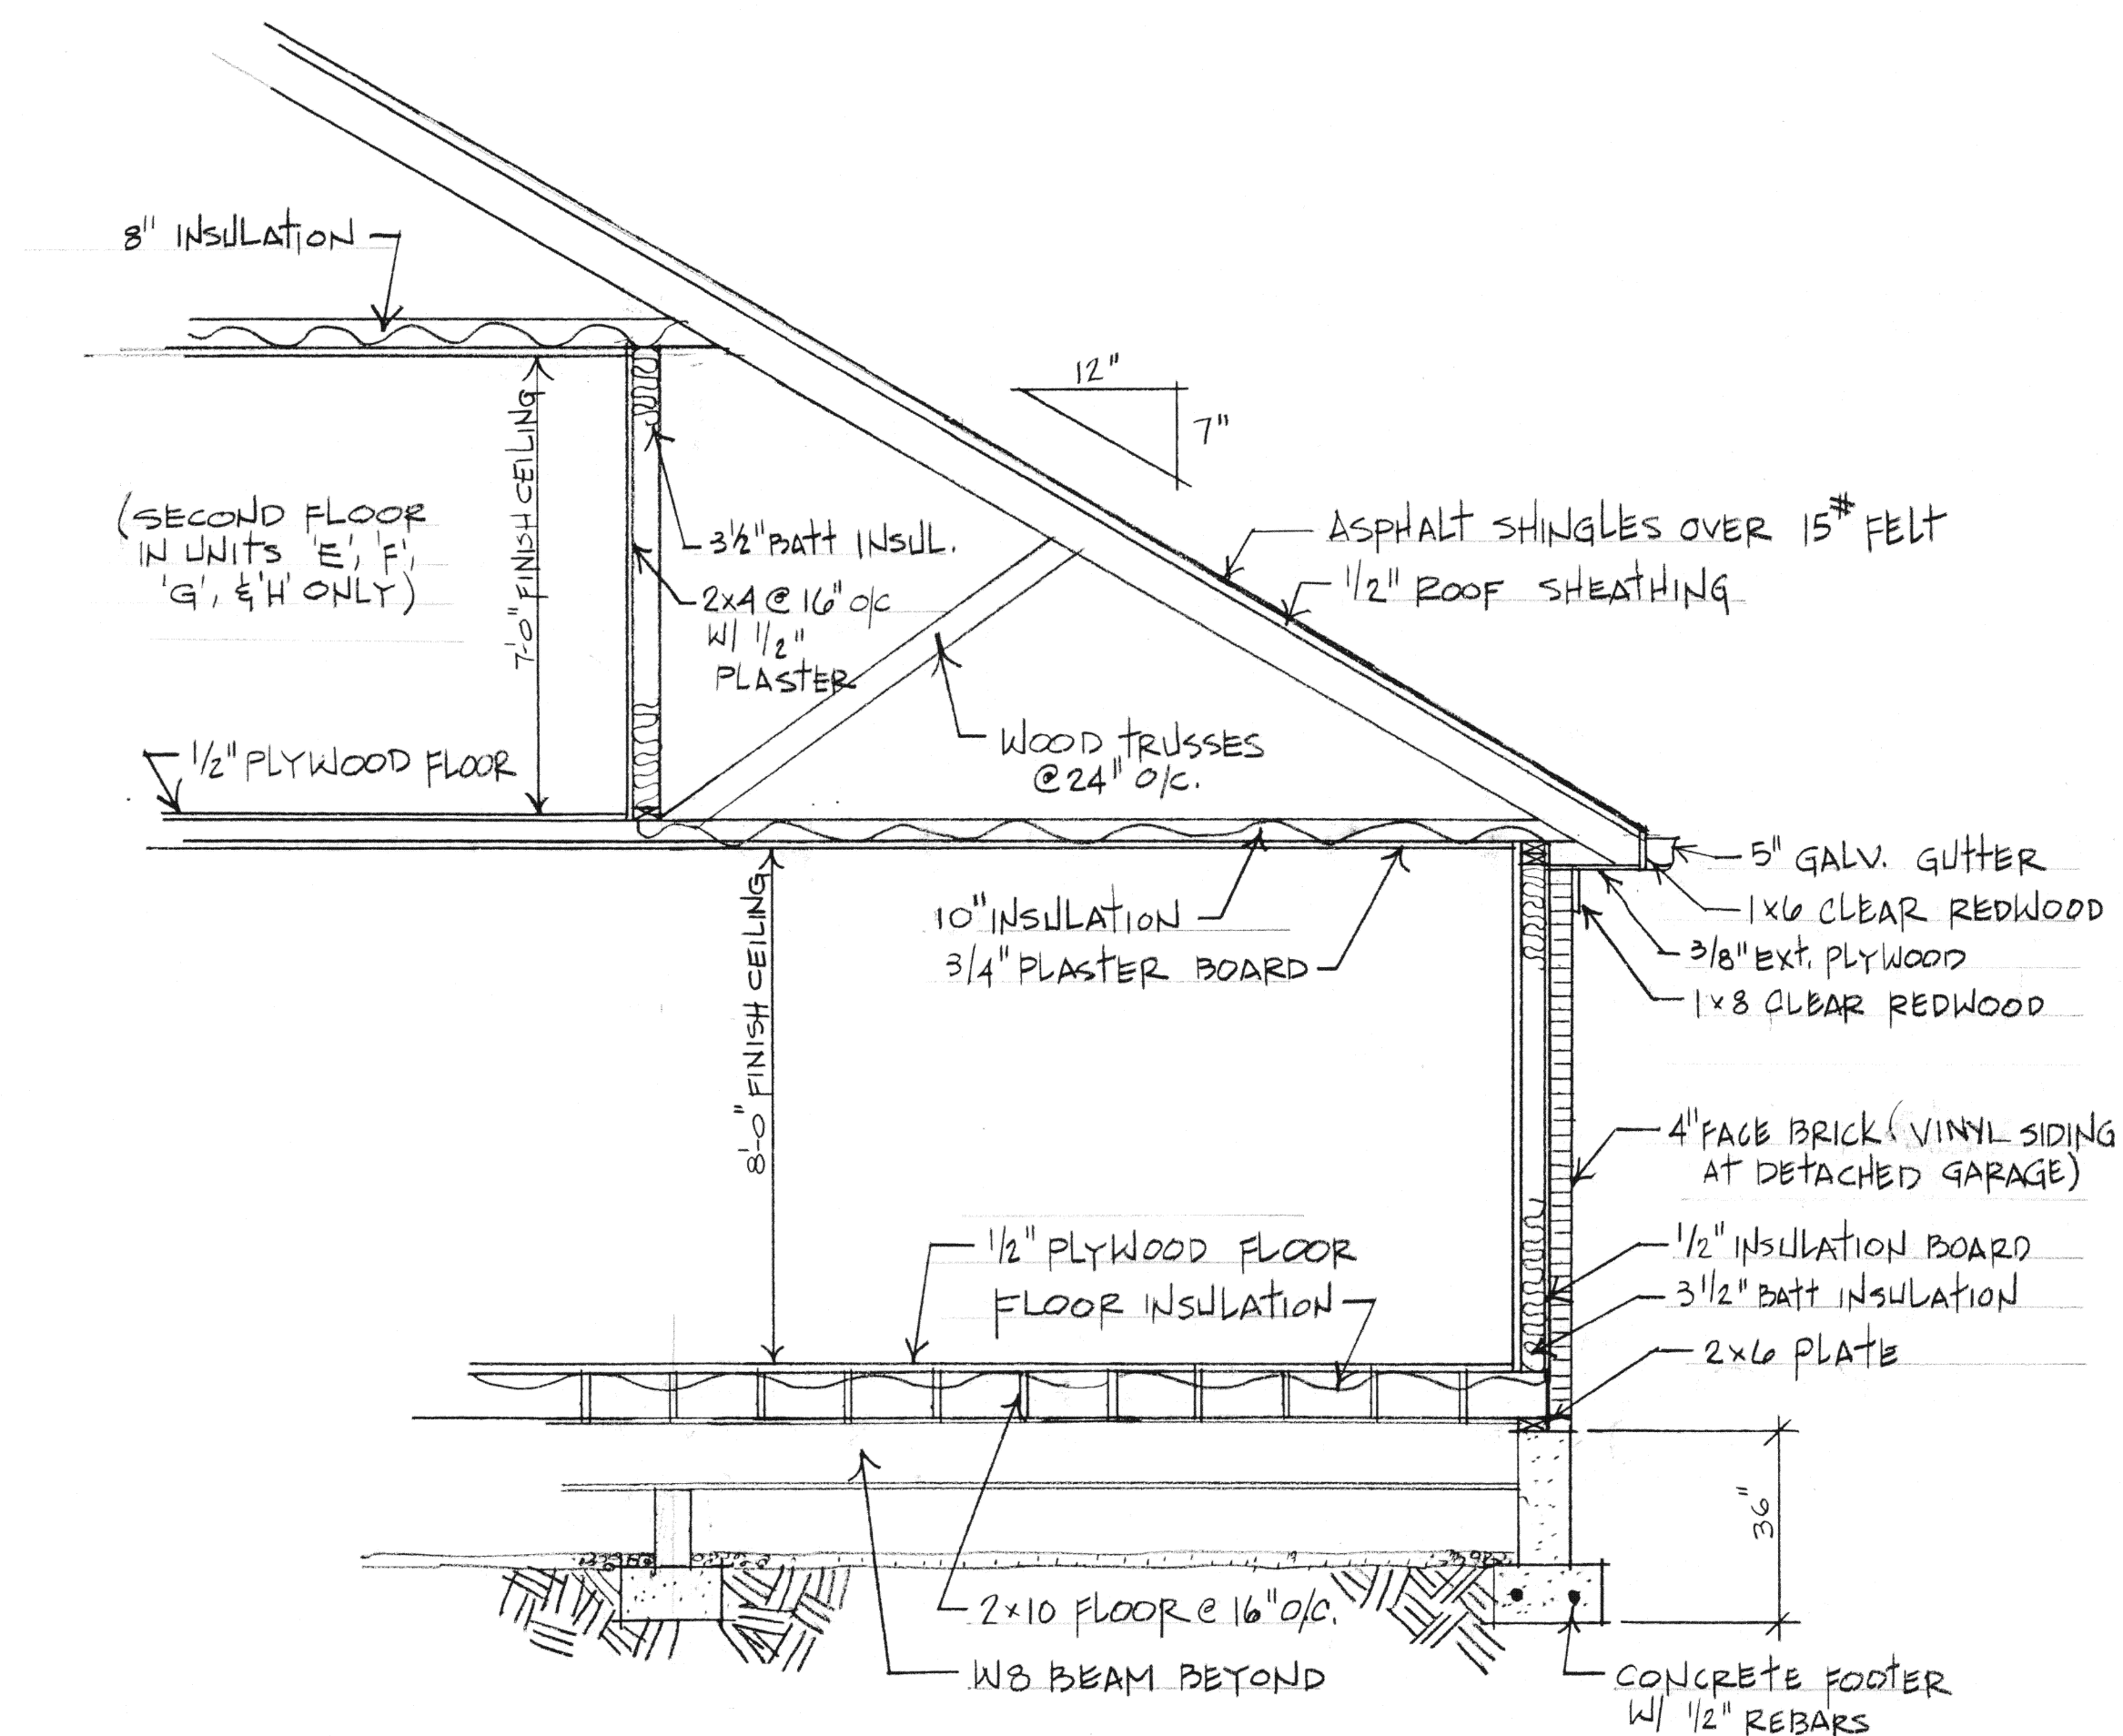

SECTION A-A (TYPICAL)

Date 12/7/90

Scale 3/8" = 1'-0"

Drawn JBF

Job

Sheet 8

Of 8 Sheets