




VOL 125 PAGE 0350

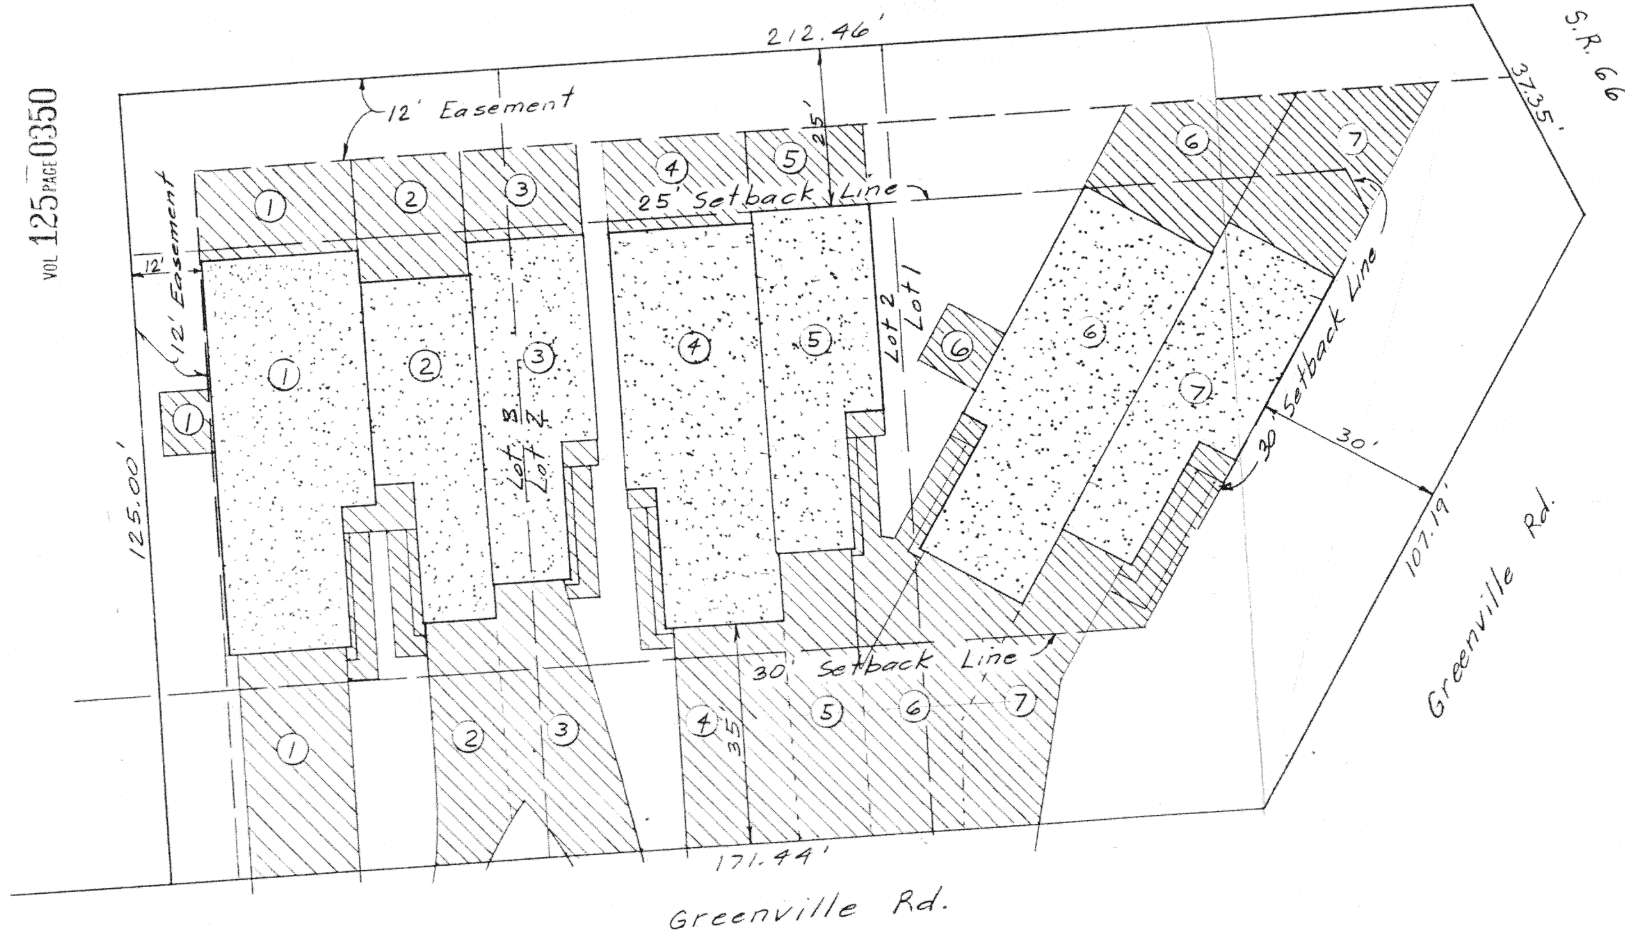

LEGEND

- Units
- Limited Common
- Common

RECEIVED
91 JUN 19 PM 3:43
MARLENE SCHUMAKER
ADMINISTRATIVE ASSISTANT

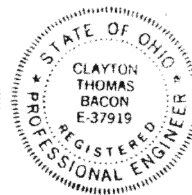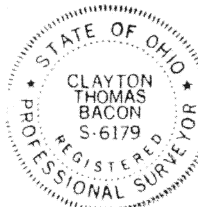

CERTIFICATE
I certify that this drawing and the within plans and descriptions of Terrace Park Condominiums accurately represents the buildings as constructed with respect to the boundaries as shown.
Clayton T. Bacon
Clayton T. Bacon PE #37919 & PS #6179

TERRACE PARK CONDOMINIUMS		
SCALE: 1" = 20'	APPROVED BY	DRAWN BY
DATE: 5-10-91		
Lots 1, 2, & 3 Townview Terrace Sub. St. Marys, Auglaize County, Ohio		
		DRAWING NUMBER