


WINSTON PLACE CONDOMINIUMS

N.W.1/4, Sec. 4, St. Marys Twp., Auglaize County, Ohio
 West Oaks Meadows No. 5, Lot 473 & W. 1/2 Lot 472
 Building "E" (Consisting of 2 Units)

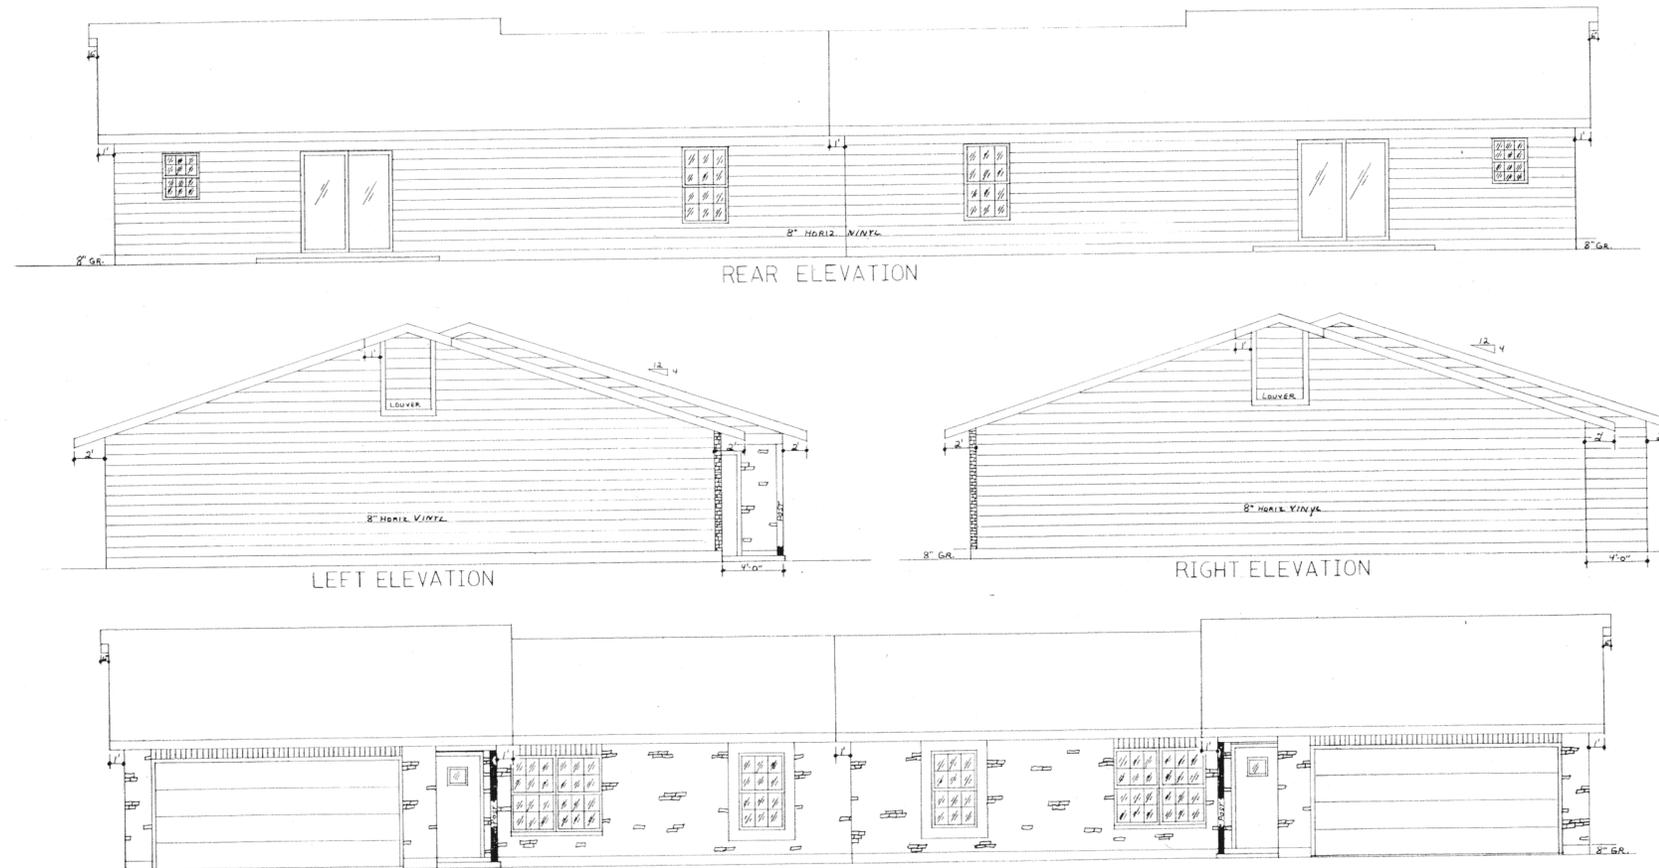

ELEVATIONS

ROOF: Typical 2"x4", 24" O.C. Truss
 3/8" C.D.X. Plywood
 235# Fiberglass Shingles
 5" Aluminum Gutter

K-2
 1704 1713 KISLER STREET
 ST. MARYS, OHIO



We, Daniel G. Bucher, Registered Engineer, State of Ohio No. 43709 and Ted A. Metzger, Registered Surveyor, State of Ohio No. 5514, do hereby certify that these drawings accurately show graphically the location, dimensions and configurations of Units 1 & 2 of the Winston Place Condominiums as constructed.

Dated at Lima, Ohio, August 7, 1989

KOHLI & KALIHAR ASSOCIATES, LIMITED


By Daniel G. Bucher
 Registered Engineer No. 43709

By Theodore A. Metzger
 Registered Surveyor No. 5514

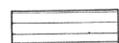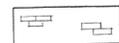-  Vinyl Siding
-  Texture I-II Plywood
-  Brick

WINSTON PLACE CONDOMINIUMS

N.W.1/4, Sec. 4, St. Marys Twp., Auglaize County, Ohio
 West Oaks Meadows No 5, Lot 473 & W. 1/2 Lot 472
 Building "E" (Consisting of 2 Units)

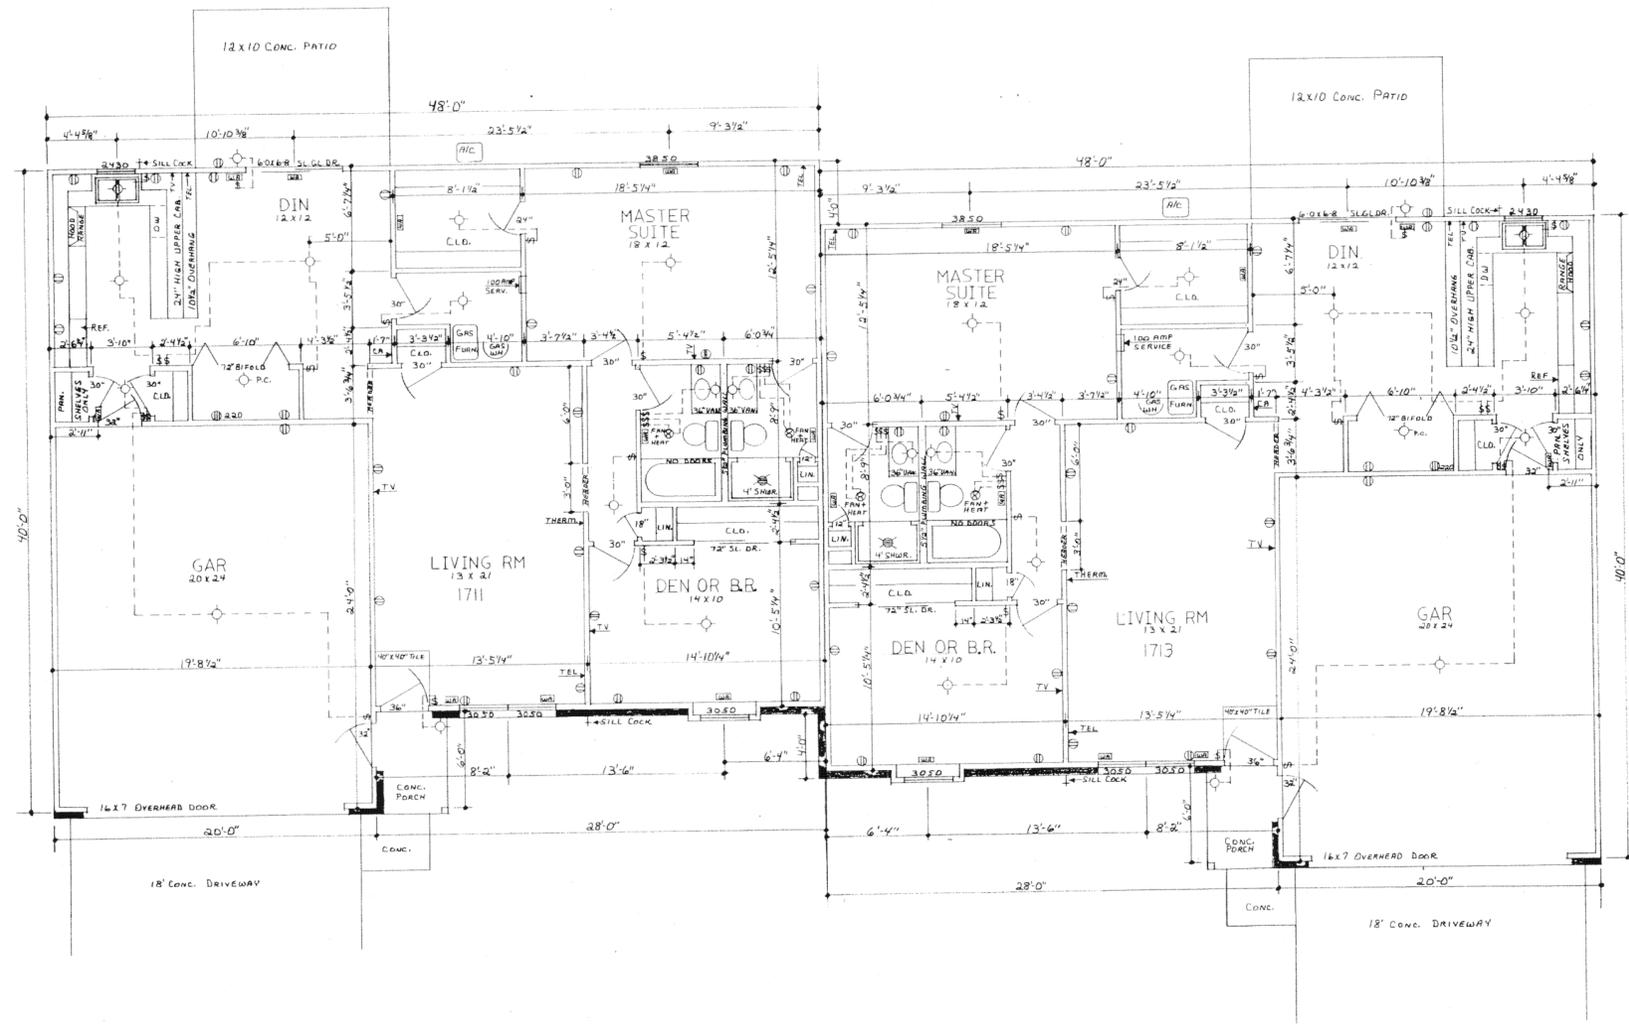

K-2
 1711 & 1713 Kishler Street
 St. Marys, Ohio

EXTERIOR WALLS: Typical 2"x4", 24" O.C. Studs, R-11 Insulation
 Outside Finish: 5/8" Texture 111 Plywood, Vinyl Siding, & Brick
 Inside Finish: Painted 1/2" Drywall

INTERIOR WALLS: Typical 2"x4", 24" O.C. Studs
 Painted 1/2" Drywall each Side

UNIT PARTITION WALLS:
 2 Rows 2"x4", 24" O.C. Studs,
 1/2" Sound Board, Painted 1/2"
 Drywall Each Side

We, Daniel G. Bucher, Registered Engineer, State of Ohio No. 43709 and
 Ted A. Metzger, Registered Surveyor, State of Ohio No. 5514, do hereby
 certify that these drawings accurately show graphically the location, dimen-
 sions and configurations of Units 1 & 2 of the Winston Place Condominiums
 as constructed.

Dated at Lima, Ohio, August 7, 1989

KOHLI & KALIHAR ASSOCIATES, LIMITED

By Daniel G. Bucher
 Registered Engineer No. 43709

By Theodore A. Metzger
 Registered Surveyor No. 5514