


PARK PLACE CONDOMINIUMS No. 1

BEING LOT NO. 2 OF PARK PLACE SUBDIVISION, VILLAGE OF MINSTER, AUGLAIZE COUNTY, OHIO

200200000633
RECORDED IN
AUGLAIZE COUNTY, OHIO
01-16-2002 At 03:48 PM.
PLAT 21.60



BEARINGS BASED ON PLAT OF PARK PLACE SUBDIVISION

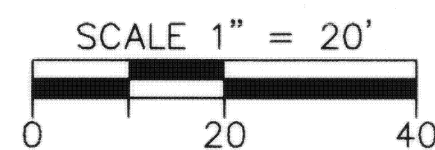

LEGEND


○ IRON PIN FOUND

ENABLING DECLARATION ESTABLISHING A PLAN
FOR CONDOMINIUM OWNERSHIP RECORDED IN
___ VOL. 457, PAGE 81 .

BYLAWS OF PARK PLACE CONDOMINIUMS ARE RECORDED
IN ___ VOL. 457, PAGE 93 .

OWNER LOT NO. 2: WEIGANDT LAND CO., LTD., VOL. ___, PG. ___

PARK PLACE SUBDIVISION RECORDED IN PLAT CAB. C, SLIDE 262

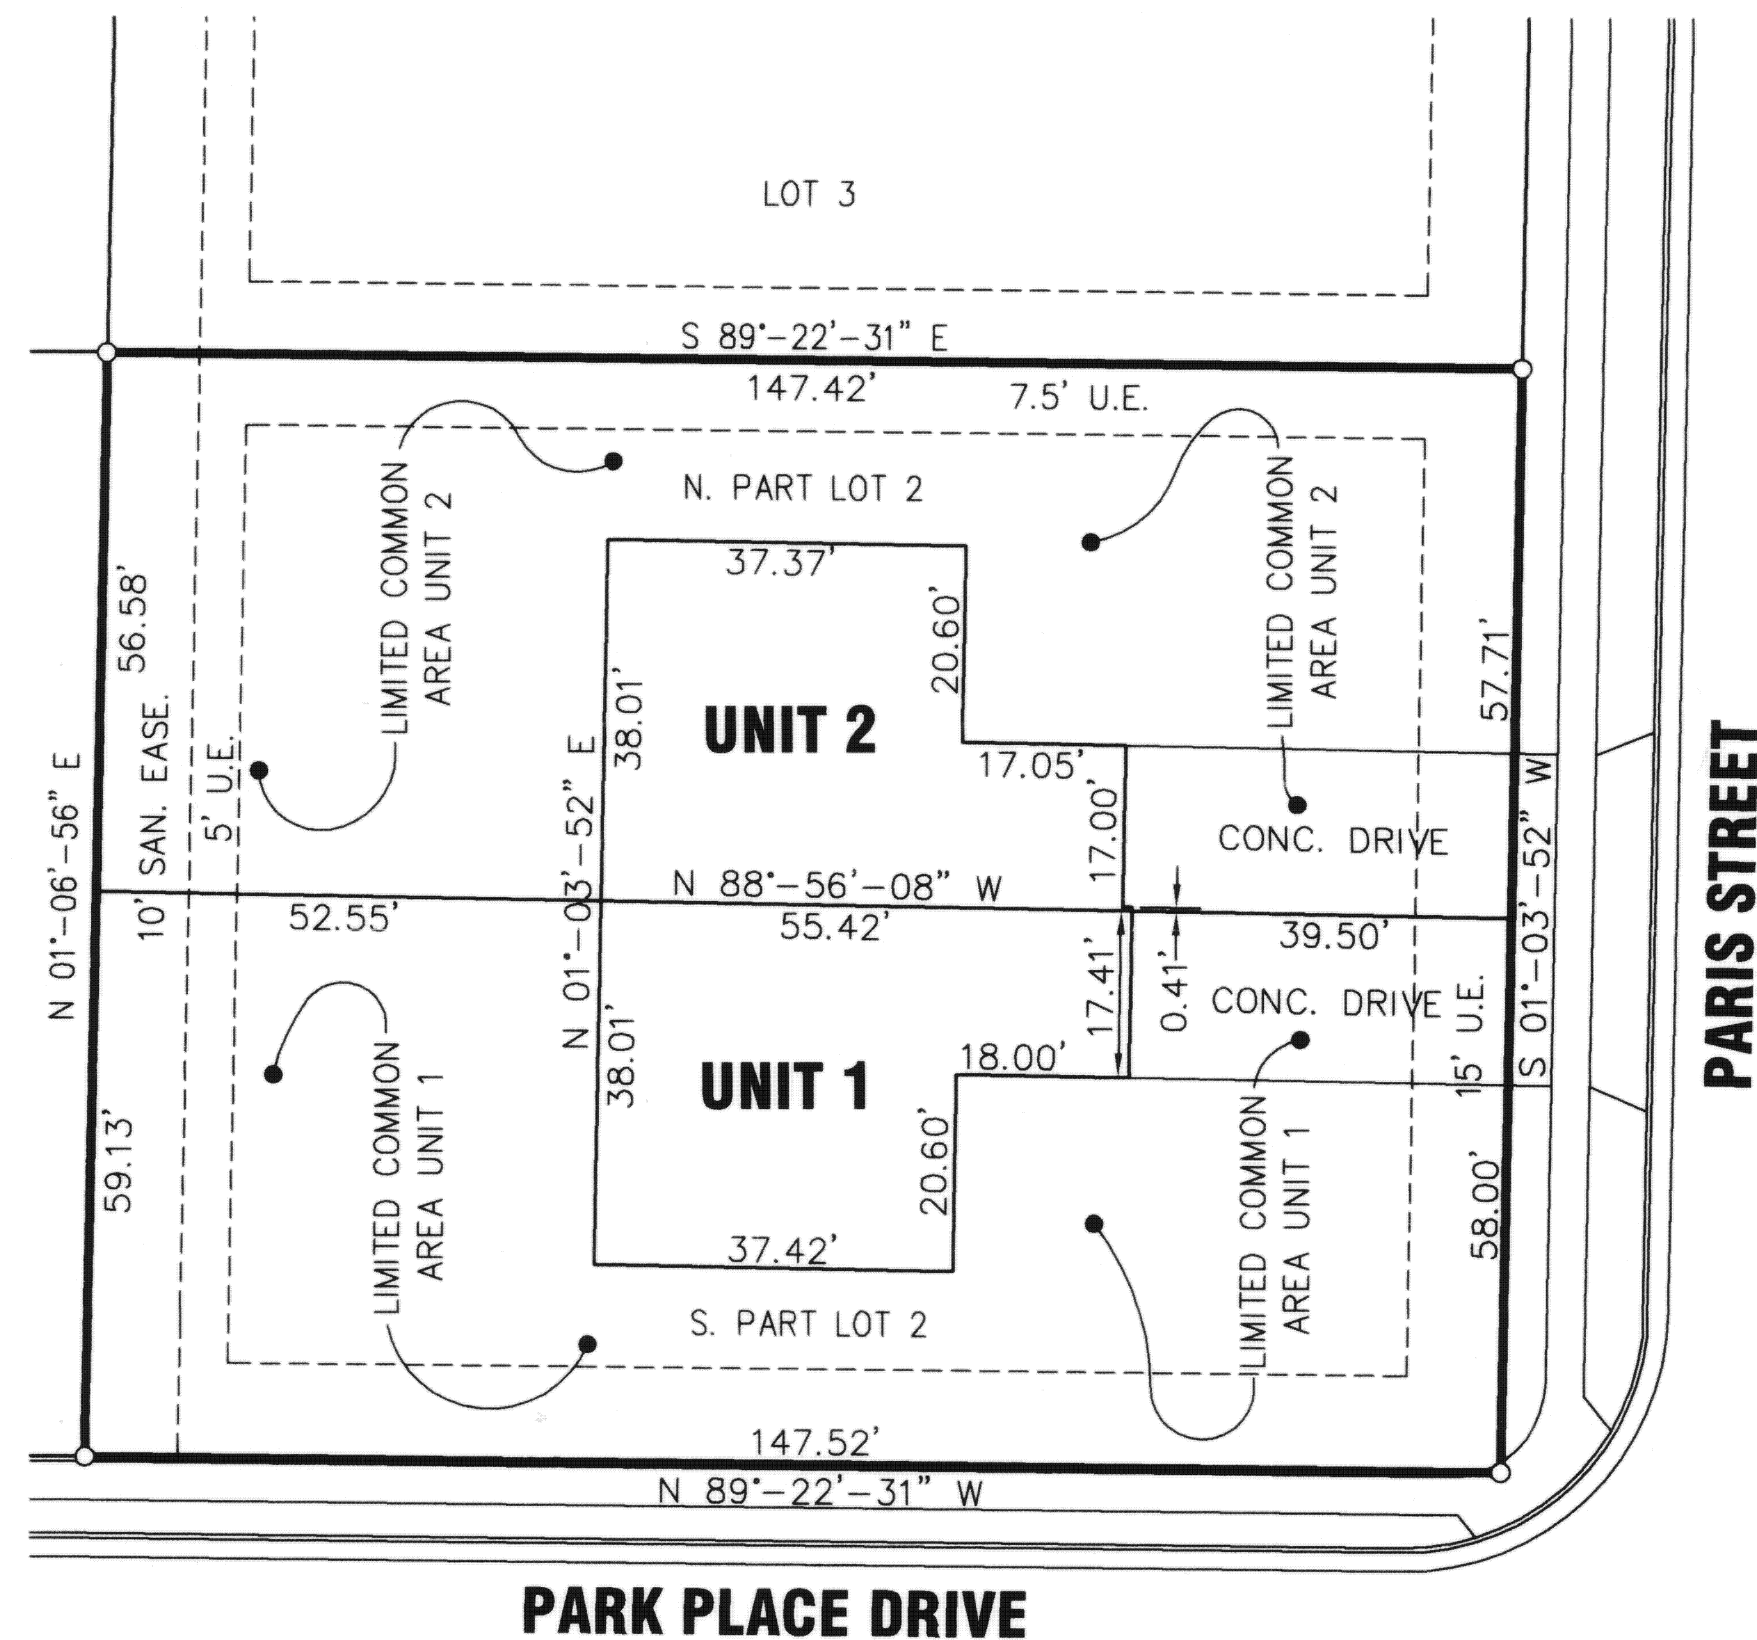


CERTIFICATION

THE DIMENSIONS SHOWN ON THE UNITS ARE FOR
THE FINISHED EXTERIOR AS CONSTRUCTED UPON
LOT 2 AND ARE ACCURATELY SHOWN HEREON.

Jeffrey S. Puthoff
JEFFREY S. PUTHOFF, P.E. #61619

10-8-01
DATE

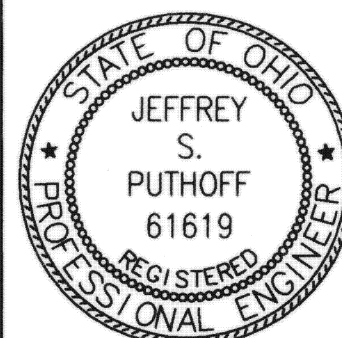


CERTIFICATION

THE DIMENSIONS SHOWN ON THE UNITS ARE FOR
THE FINISHED EXTERIOR AS CONSTRUCTED UPON
LOT 2 AND ARE ACCURATELY SHOWN HEREON.

Steven E. Bowersox
STEVEN E. BOWERSOX, P.S. #7059

10-08-2001
DATE

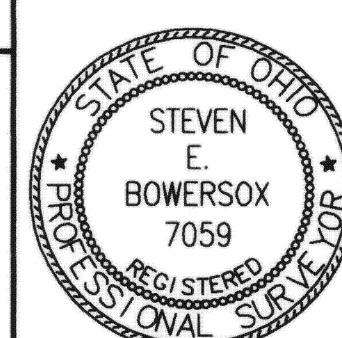

440 E. HOEWISHER ROAD
SIDNEY, OHIO 45365
(937) 497-0200 • FAX (937) 497-0300
www.choiceoneengineering.com

date: 10-08-2001	drawn by: seb	job number: AugMin0112
---------------------	------------------	---------------------------



Property of
Dave & L. Kuhn


Sheet
1 of 3

DATE: L. KUHN
DATE: 10/1/80
SHEET: 10/1/80

DUPLEX

WEIGANDT CONST.

Scale: 1/4" = 1'-0"
Drawn: D.L.K.
Date: Dec. 80

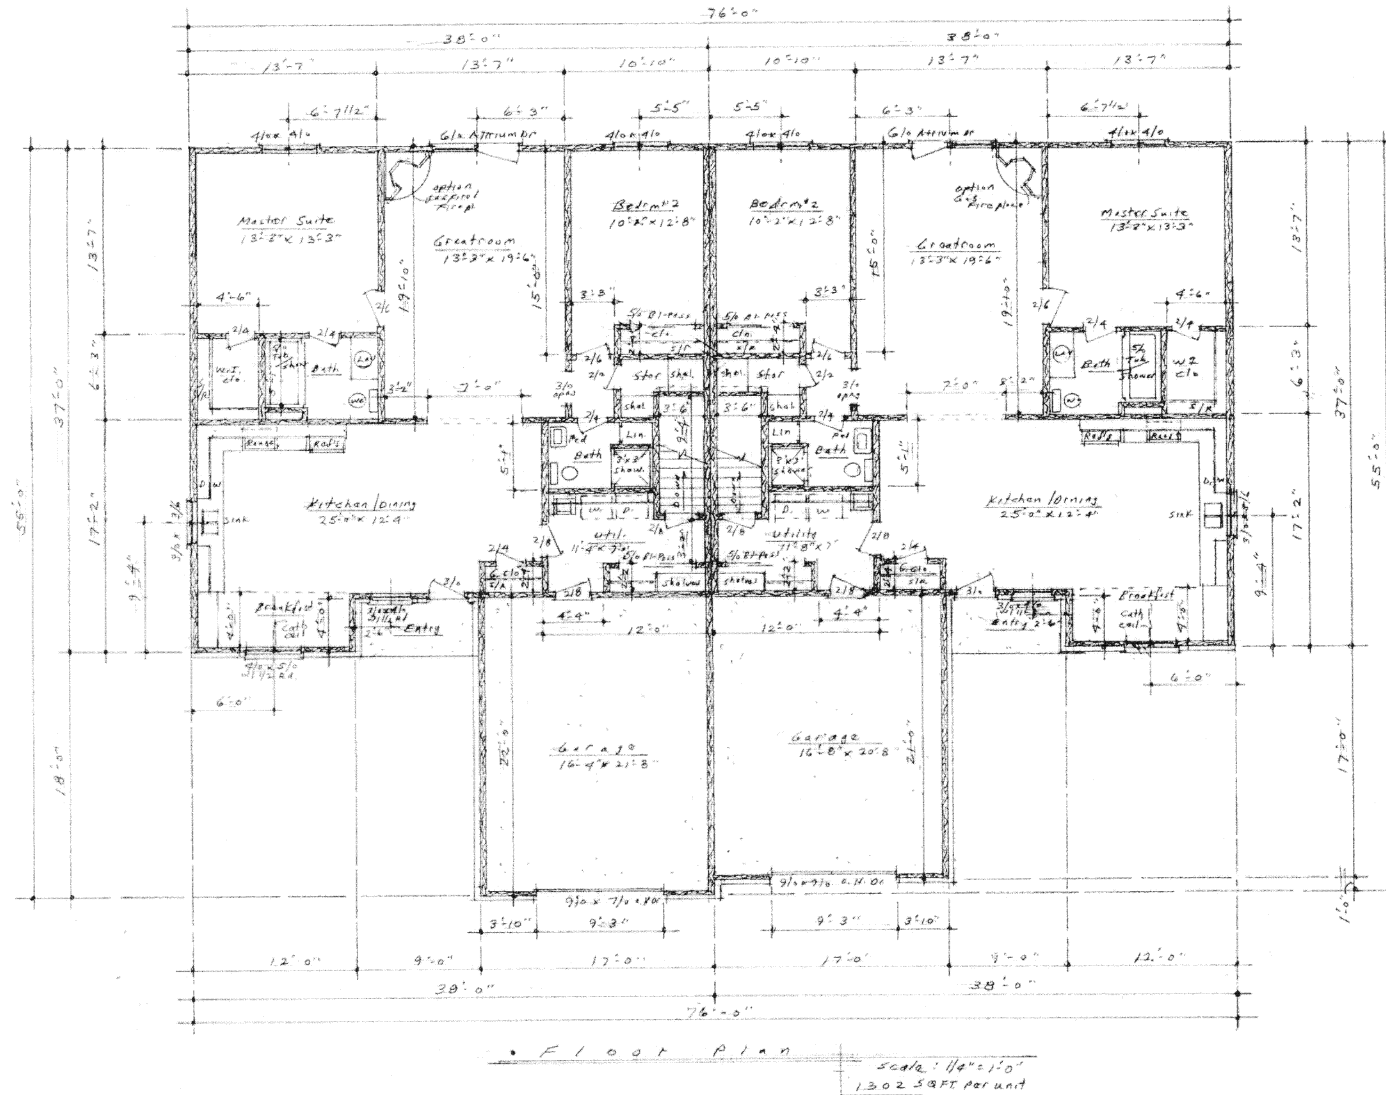

Property of
Dave & L. Kuhn

Sheet
2 of 3

DATE: L. KUHN
DATE: 10/1/80
SHEET: 10/1/80

DUPLEX

WEIGANDT CONST.

Scale: 1/4" = 1'-0"
Drawn: D.L.K.
Date: Dec. 80