
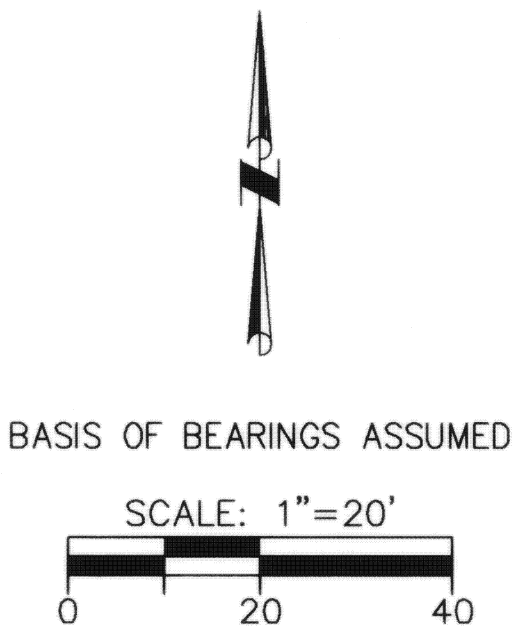


CARDINAL STREET CONDOMINIUM No. 1  
BEING SITUATE ON THE SOUTH PART OF LOT 9 AND THE WHOLE  
OF LOT 10 IN DICKE ACRES SUBDIVISION, 1st ADDITION, IN THE  
VILLAGE OF NEW BREMEN, GERMAN TOWNSHIP,  
AUGLAIZE COUNTY, OHIO

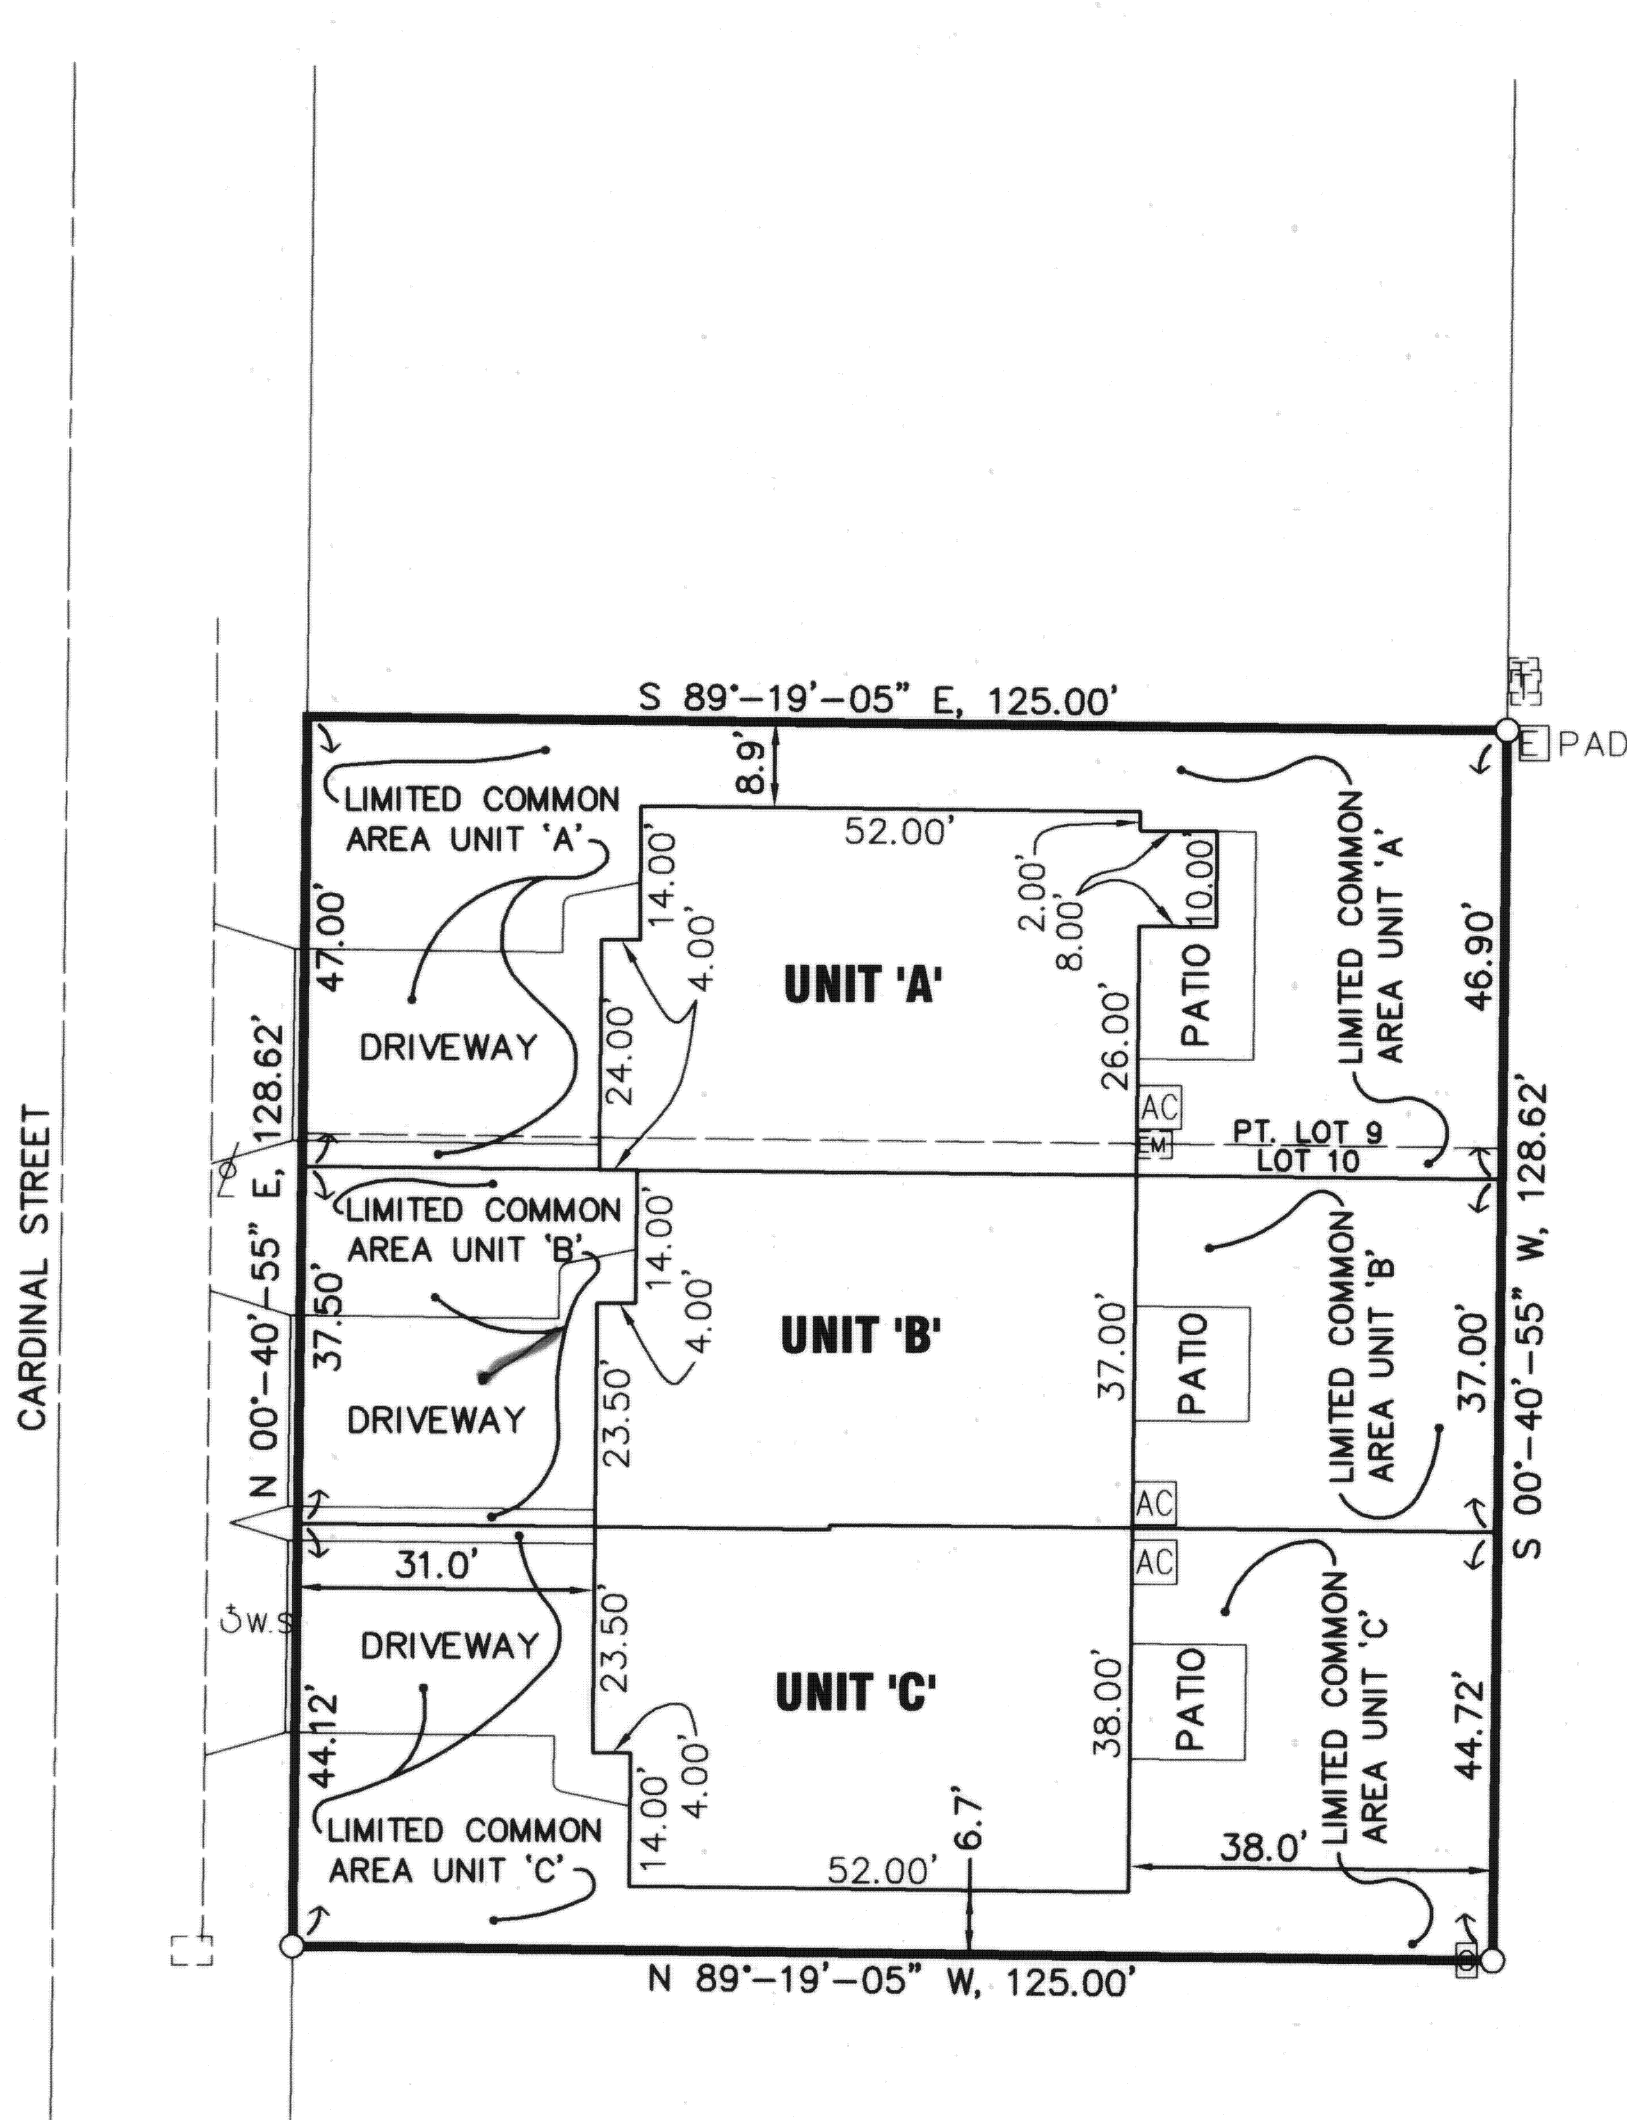

**LEGEND**  
○ IRON PIN FOUND  
W/JAMES GEESLIN CAP

**ENABLING DECLARATION ESTABLISHING  
A PLAN FOR CONDOMINIUM OWNERSHIP**

RECORDED IN OFFICIAL RECORD VOL. 477, PG. 121

**BYLAWS FOR CARDINAL STREET  
CONDOMINIUM No. 1**

RECORDED IN OFFICIAL RECORD VOL. 477, PG. 130

RECEIVED  
MAR 27 2003  
KARYN SCHUMANN  
Auglaize Co. Auditor

TRANSFERRED AND NUMBERED THIS 27 DAY OF March, 2003.

Karyn Schumann  
AUGLAIZE COUNTY AUDITOR


FILED THIS 27 DAY OF March, 2003, AT 12:35 O'CLOCK M.  
RECORDED THIS 27 DAY OF March, 2003.  
PLAT CABINET C, SLIDE 283

Ann Bellinger CS #3264  
AUGLAIZE COUNTY RECORDER

**ENGINEER'S CERTIFICATION**

THE DIMENSIONS SHOWN ON THE STRUCTURE ARE FOR  
THE FINISHED EXTERIOR AS CONSTRUCTED UPON LOT  
9 & 10 AND ARE ACCURATELY SHOWN HEREON.


Anthony V. Schroeder 3-6-03  
ANTHONY V. SCHROEDER, P.E. #52939 DATE

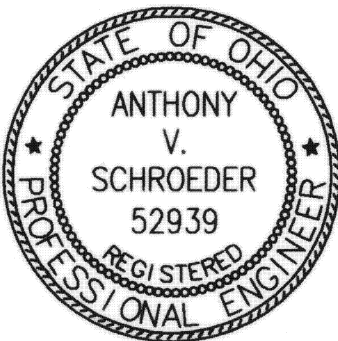

**SURVEYOR'S CERTIFICATION**


THE DIMENSIONS SHOWN ON THE STRUCTURE ARE FOR  
THE FINISHED EXTERIOR AS CONSTRUCTED UPON LOT  
9 & 10 AND ARE ACCURATELY SHOWN HEREON.

Steven E. Bowersox 3-6-2003  
STEVEN E. BOWERSOX, P.S. #7059 DATE

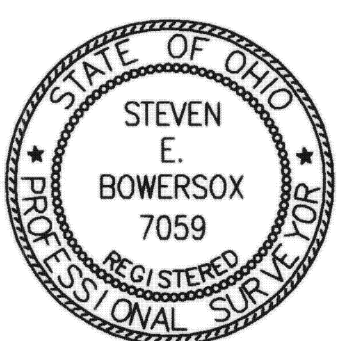

440 E. HOEWISHER ROAD  
SIDNEY, OHIO 45365  
(937) 497-0200 • FAX (937) 497-0300  
www.choiceoneengineering.com


date: 09-18-2002 drawn by: seb job number: AUGNBE0203

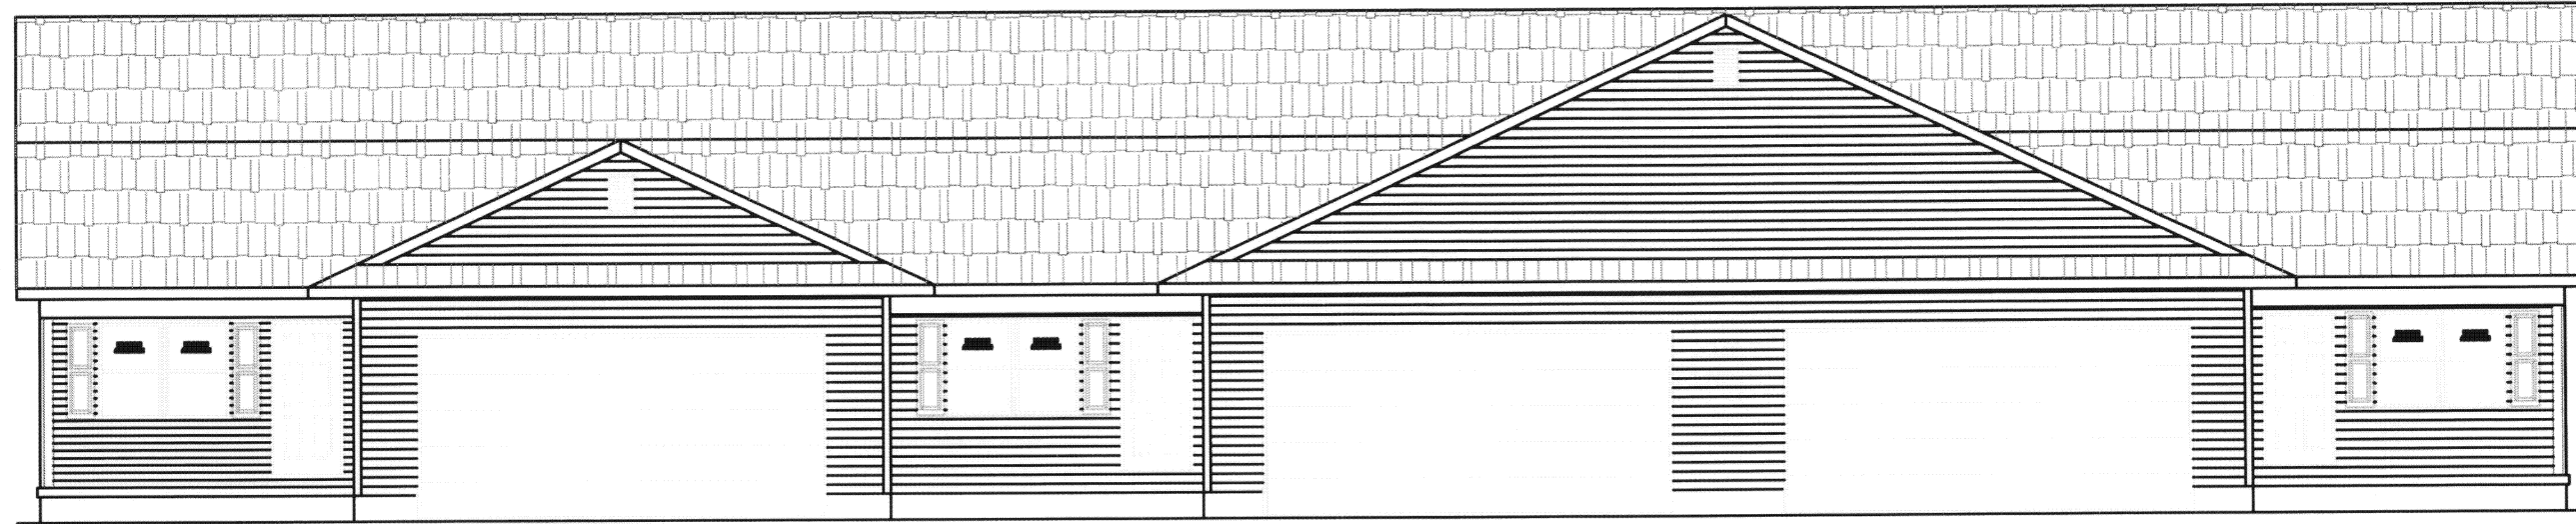


FRONT ELEVATION ROOF PITCH 5/12

NOTES:


- MASTIC VINYL SIDING & LOUVERS WGV50 COLOR CAMET
- CLAY ALUMN SOFFIT
- CLAY ALUMN PORCH COLUMNS
- LANDMARK 30 YR. ROOF
- LARSON SANDTONE STORM DOORS
- STEEL OVERHEAD DOORS
- STEEL EXTERIOR DOORS

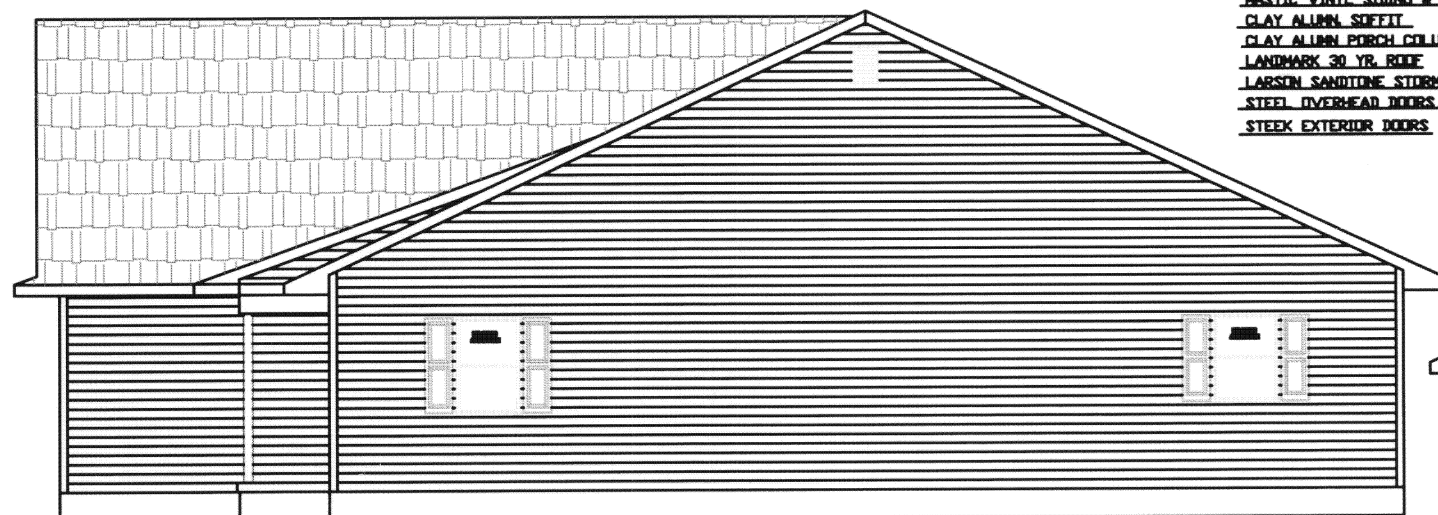

SIDE ELEVATION ROOF PITCH 5/12

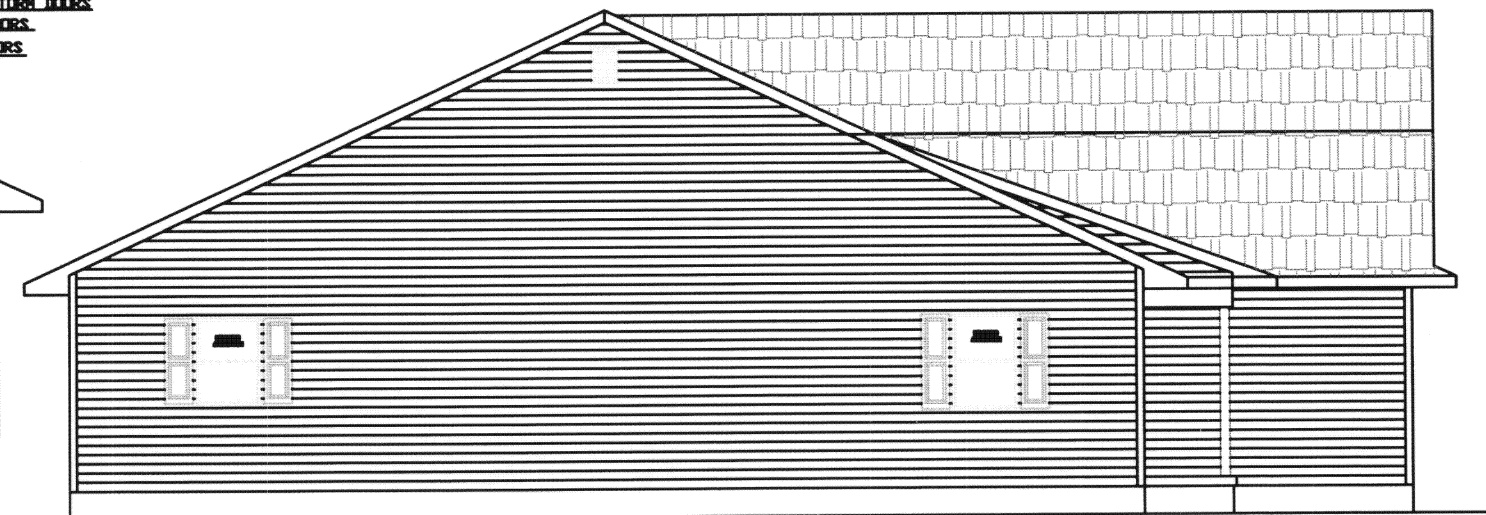

SIDE ELEVATION ROOF PITCH 5/12

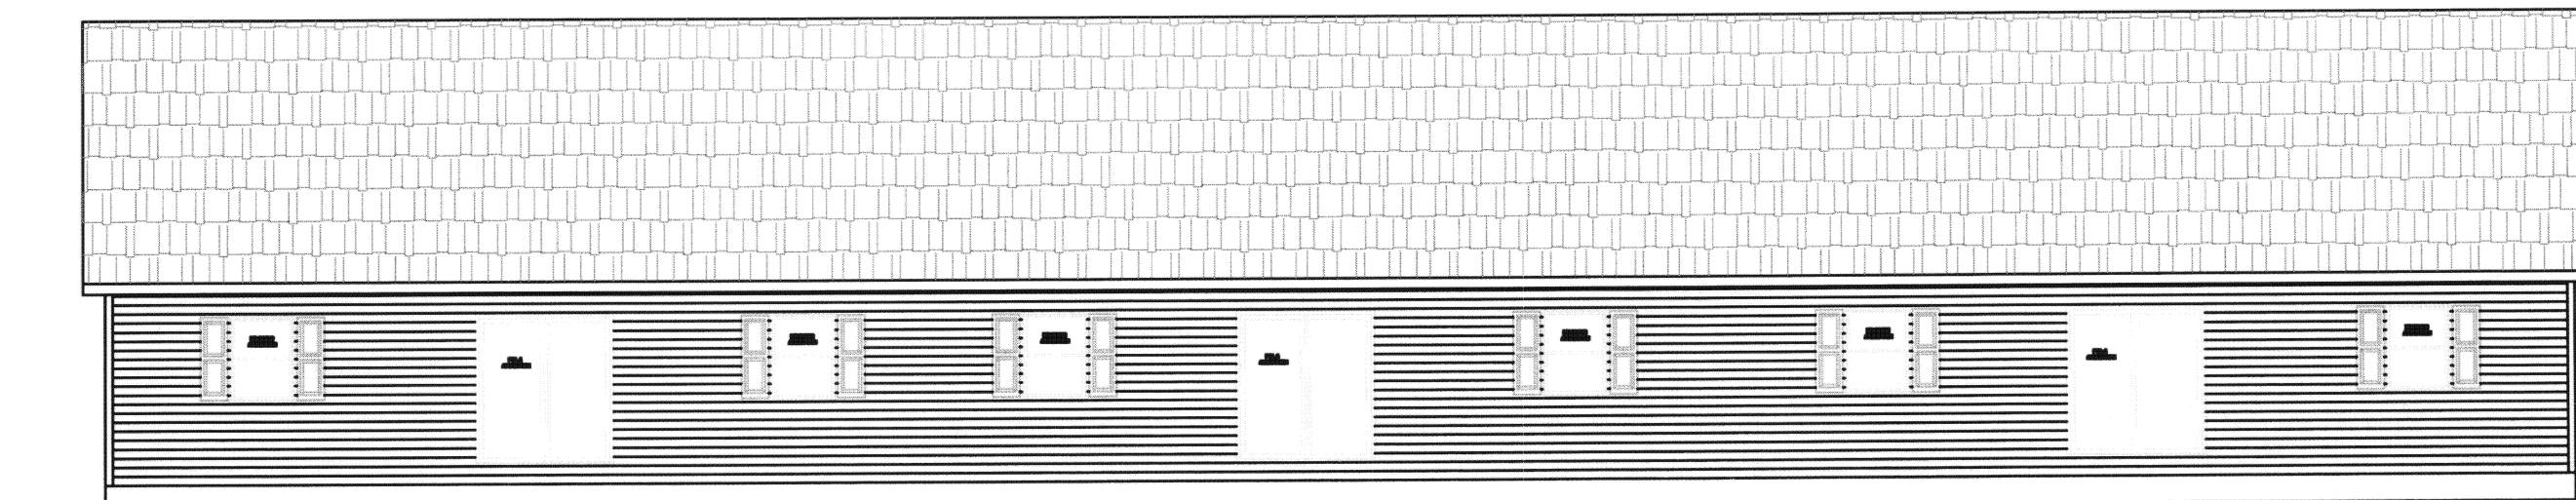

REAR ELEVATION ROOF PITCH 5/12

DWG. TITLE: MIKE & CINDY EBBING	
DWG. No.: 438ELEV	
DATE: 3-19-02	HOME PH. 419-878-2191
DR. BY: RON STOUT	WORK PH.
SCALE: 1/4" = 1'	SHT.: 3 OF: 3