

# PARK PLACE CONDOMINIUM No. 4

BEING REPLATTED LOT NO. 1 OF PARK PLACE SUBDIVISION, PHASE ONE,  
VILLAGE OF MINSTER, AUGLAIZE COUNTY, OHIO

TRANSFERRED AND NUMBERED THIS 24 DAY OF January, 2005

JAN 24 2005

KARYN SCHULMAN  
Auglaize Co. Auditor

Karyn Schumann  
AUGLAIZE COUNTY AUDITOR


FILED THIS 24 DAY OF January, 2005 AT 10:32 O'CLOCK A.M.  
RECORDED THIS 24 DAY OF January, 2005  
PLAT CABINET C, SLIDE 395

# 461

Anna Bellini  
AUGLAIZE COUNTY RECORDER



BEARINGS BASED ON PLAT OF PARK PLACE SUBDIVISION, PHASE ONE

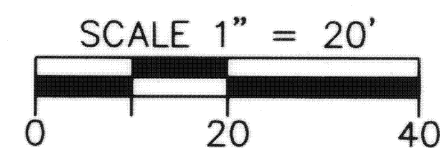

## LEGEND

○ IRON PIN FOUND


ENABLING DECLARATION ESTABLISHING A PLAN  
FOR CONDOMINIUM OWNERSHIP RECORDED IN  
OR VOL. 519, PAGE 1732.

BYLAWS OF PARK PLACE CONDOMINIUM ARE RECORDED  
IN OR VOL. 519, PAGE 1749.

OWNER LOT NO. 1: WEIGANDT LAND CO., LTD., O.R. VOL. 413, PG. 209

PARK PLACE SUBDIVISION, PHASE ONE, RECORDED IN PLAT CAB. C, SLIDE 244

REPLAT OF LOTS 1, 8 AND 14, PARK PLACE SUBDIVISION, PHASE ONE,  
RECORDED IN PLAT CAB. C, SLIDE 345

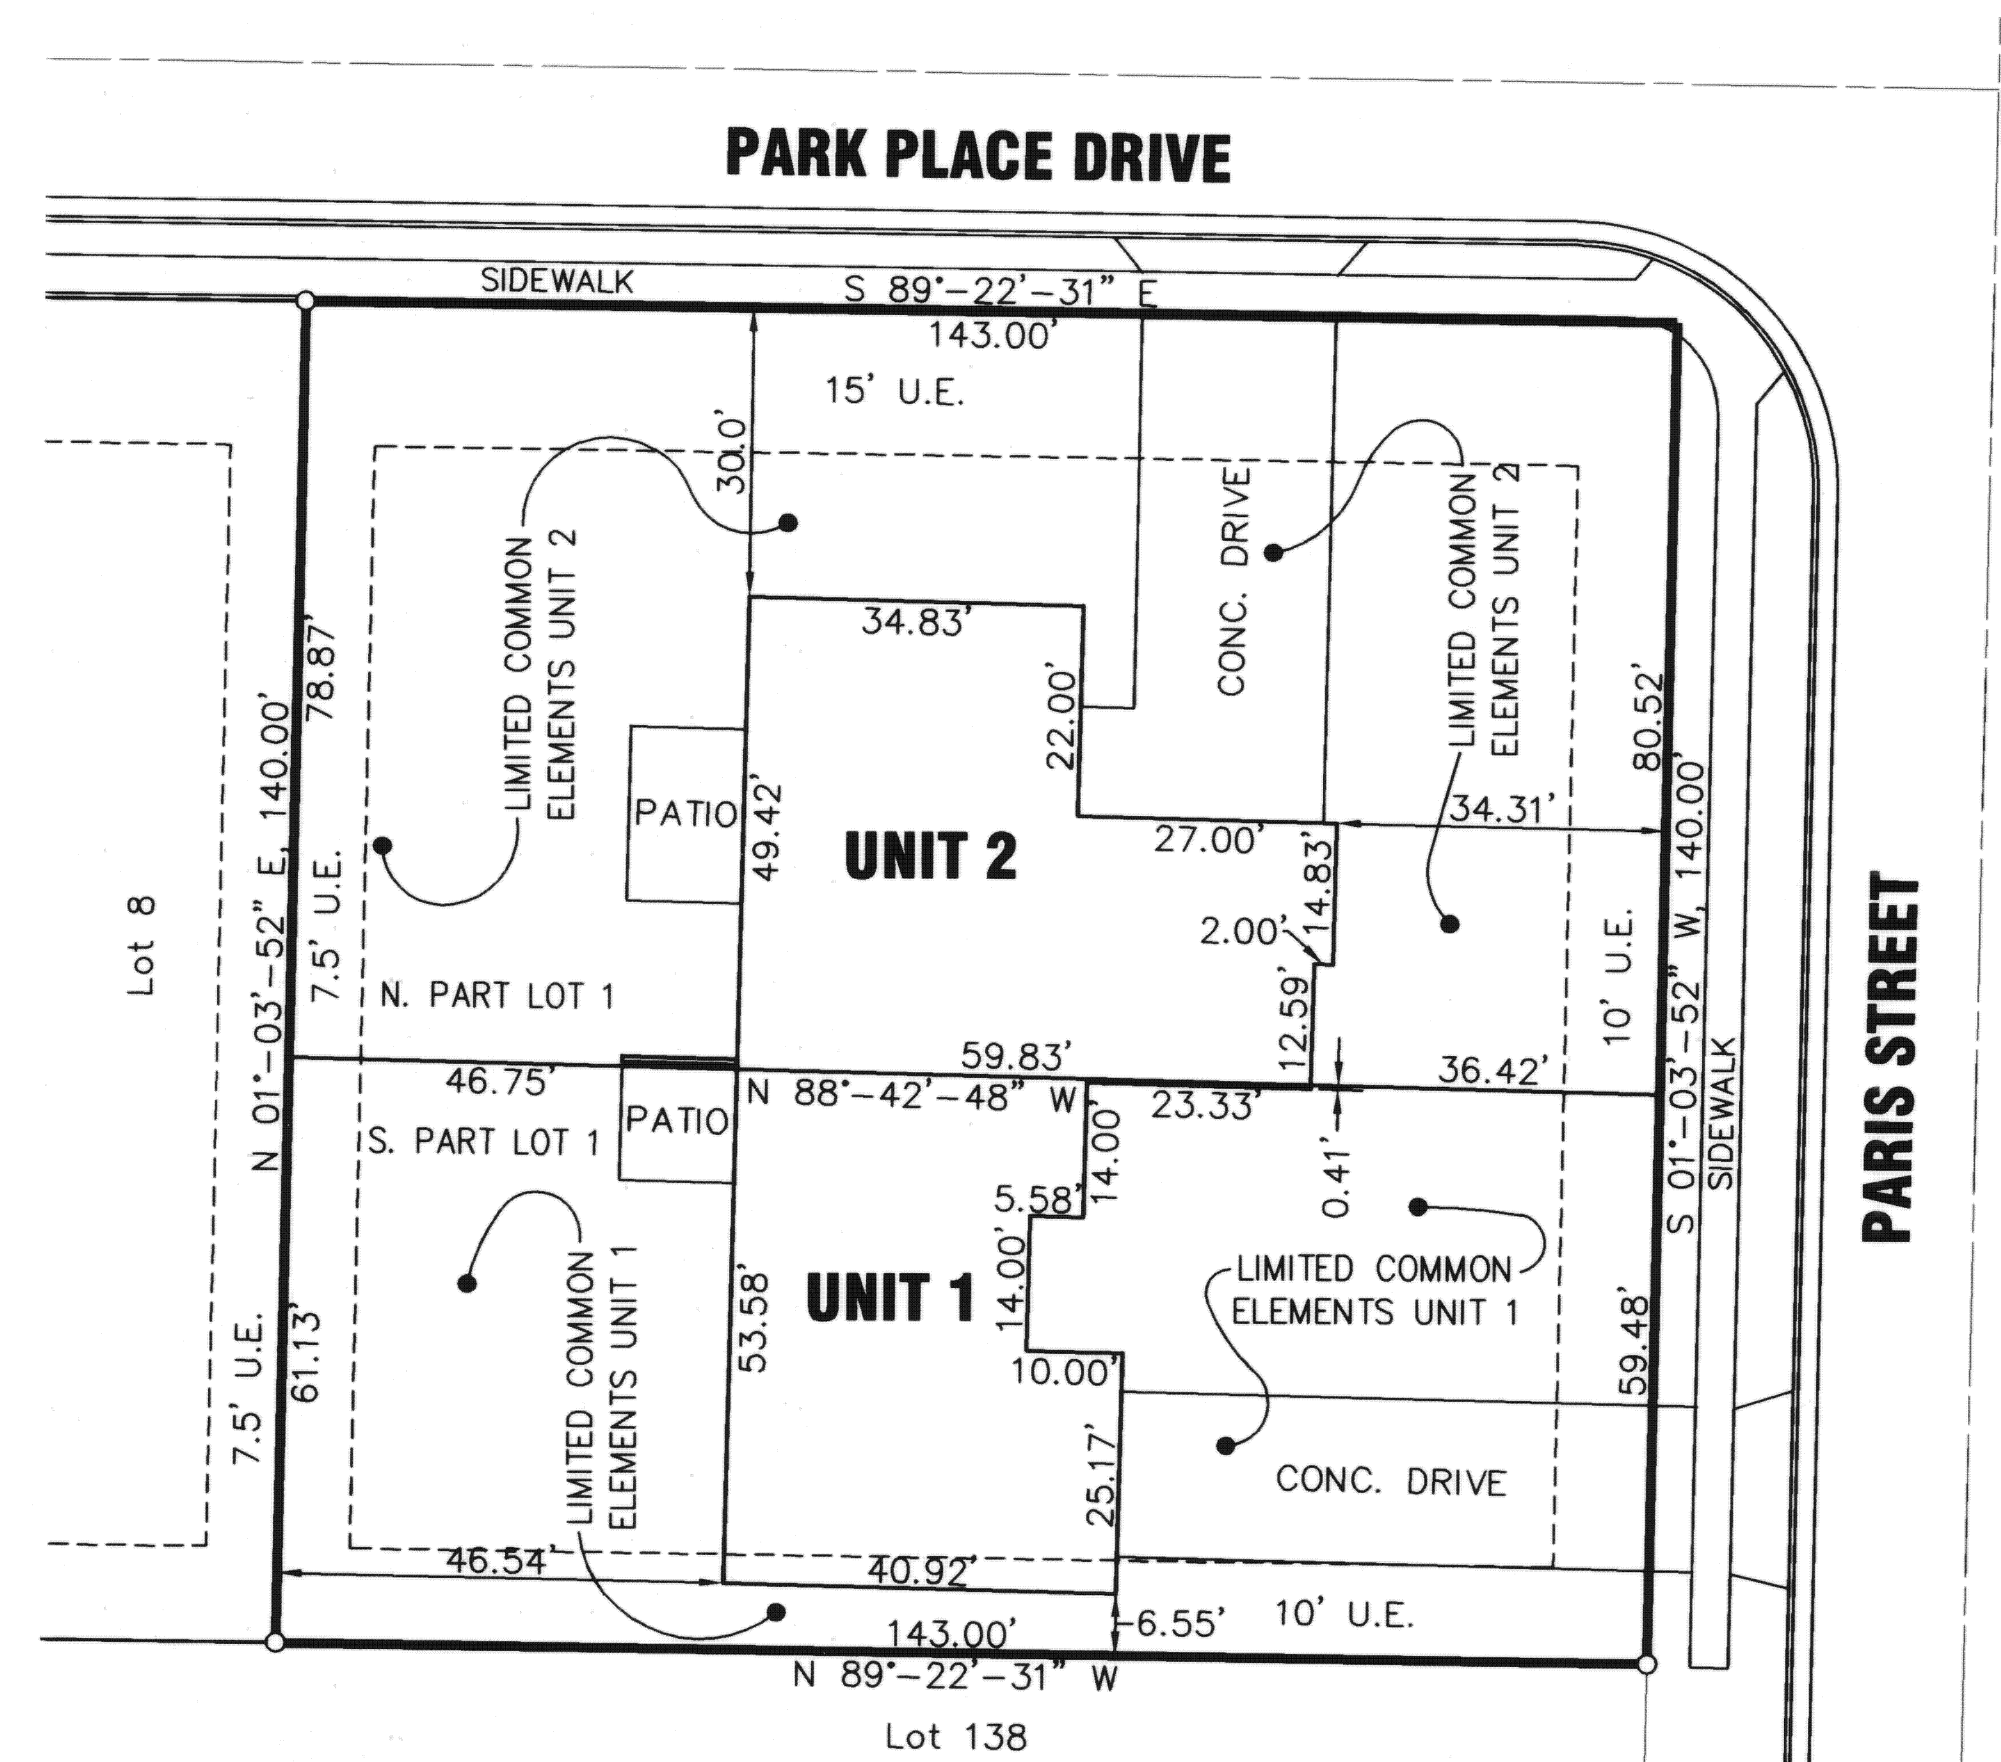


## CERTIFICATION

THE DIMENSIONS SHOWN ON THE UNITS ARE FOR  
THE FINISHED EXTERIOR AS CONSTRUCTED UPON  
LOT 1 AND ARE ACCURATELY SHOWN HEREON.

Jeffrey S. Puthoff  
JEFFREY S. PUTHOFF, P.E. #61619

1/19/05  
DATE

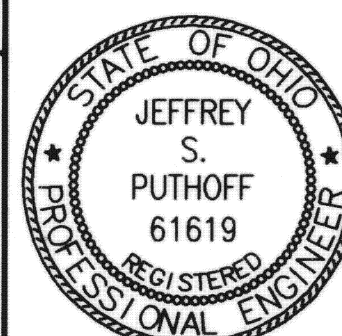


## CERTIFICATION

THE DIMENSIONS SHOWN ON THE UNITS ARE FOR  
THE FINISHED EXTERIOR AS CONSTRUCTED UPON  
LOT 1 AND ARE ACCURATELY SHOWN HEREON.

Steven E. Bowersox  
STEVEN E. BOWERSOX, P.S. #7059

1-19-2005  
DATE

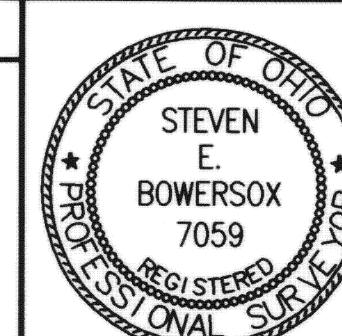

**CHOICE ONE ENGINEERING**  
the choice that exceeds ...  
440 E. HOEWISHER ROAD  
SIDNEY, OHIO 45365  
(937) 497-0200 • FAX (937) 497-0300  
www.choiceoneengineering.com

date: 01-19-2005  
drawn by: seb  
job number: AugMin0112