


"R" PLACE CONDOMINIUMS

BEING TRACT 1 OF WOEHMYER SUBDIVISION, VILLAGE OF MINSTER, AUGLAIZE COUNTY, OHIO

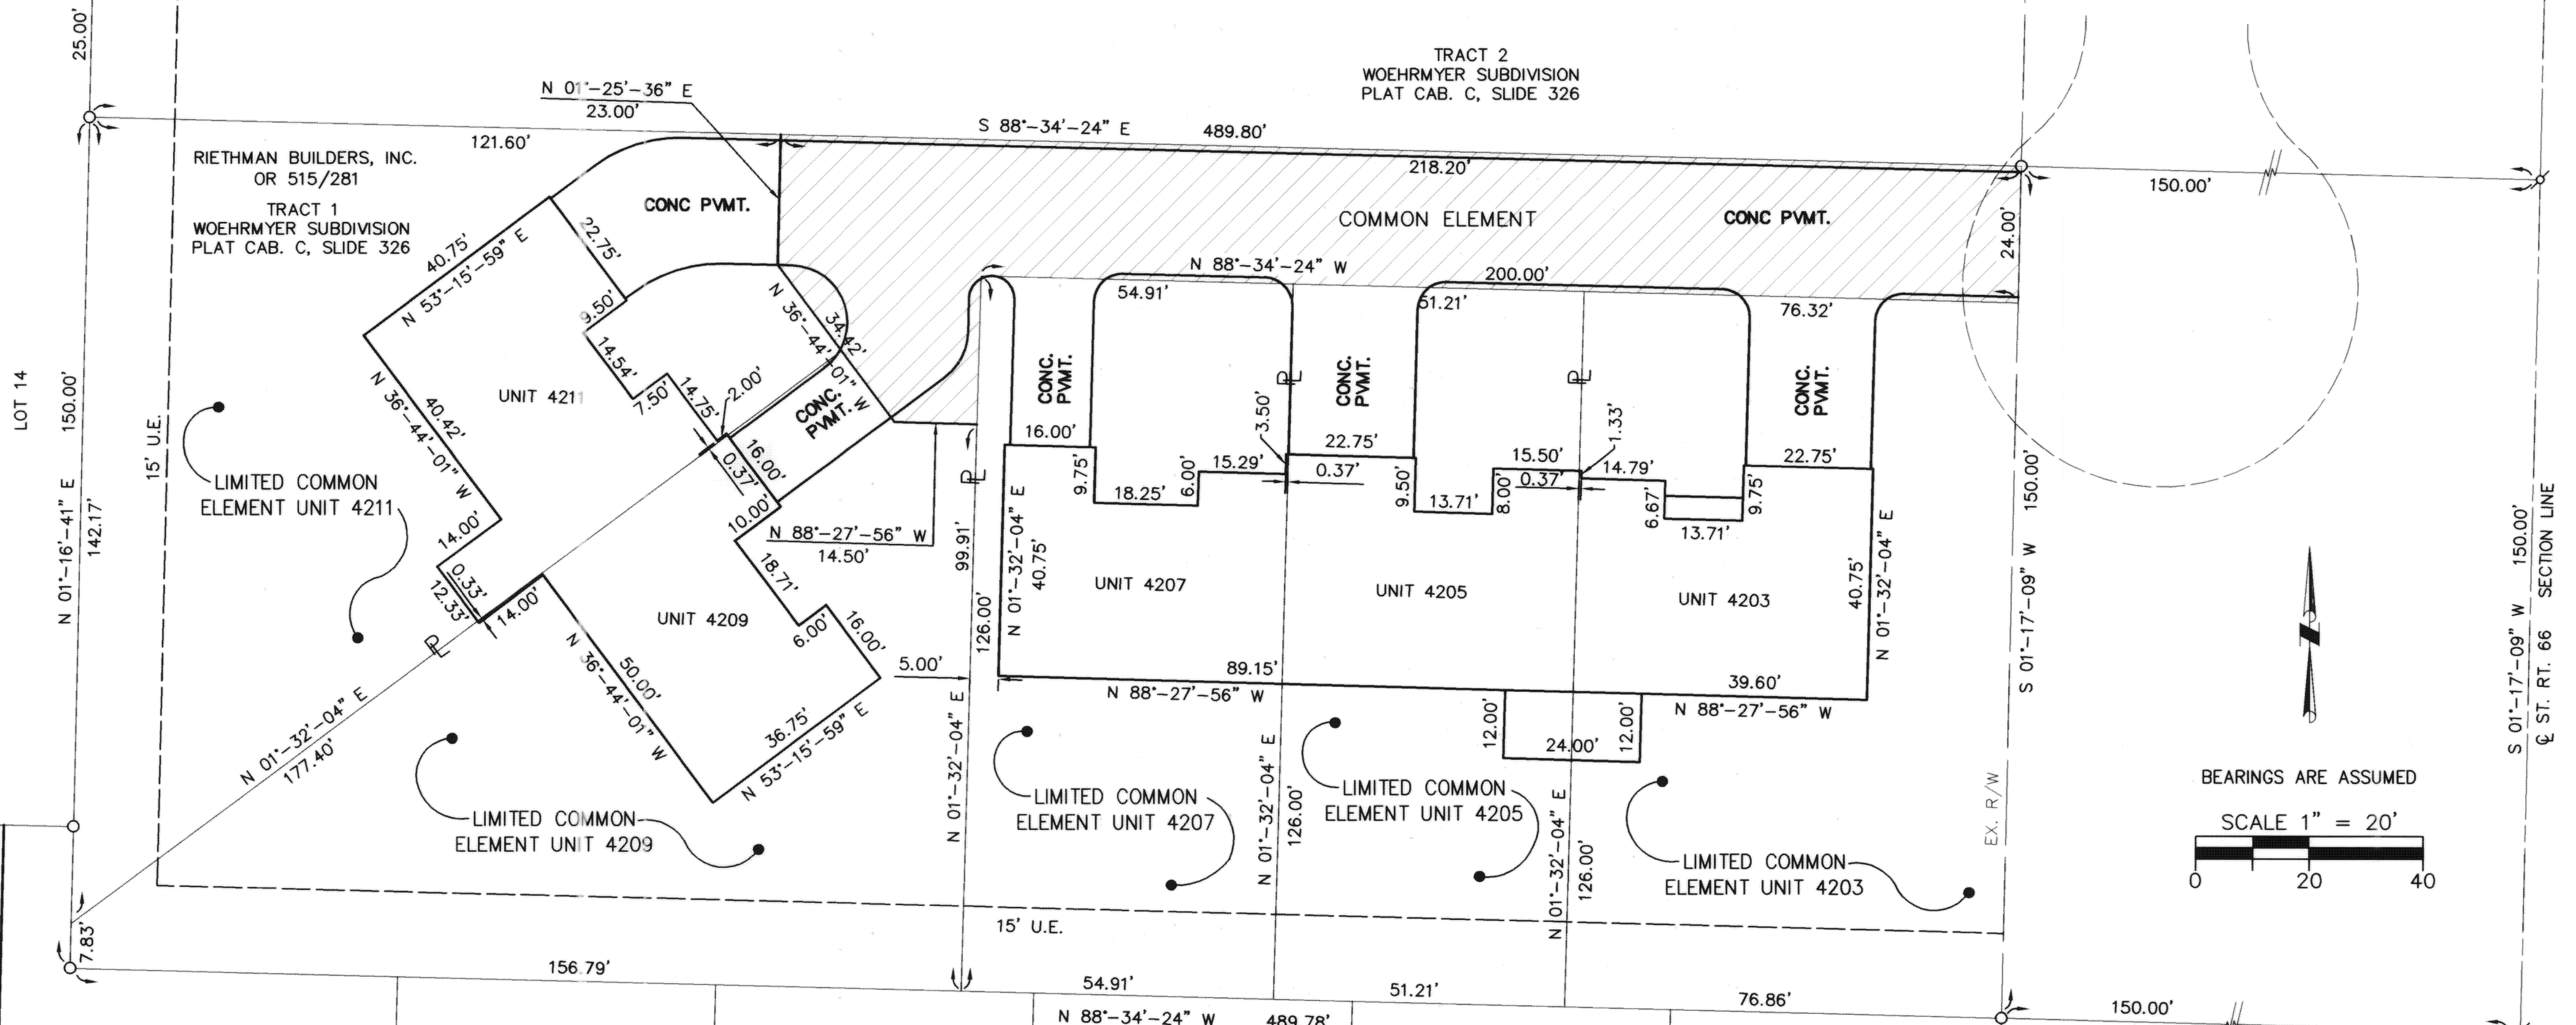


BEARINGS ARE ASSUMED
SCALE 1" = 20'

LEGEND
○ IRON PIN FOUND
⊗ MAG NAIL FOUND
COMMON ELEMENT


Filed for record
3-30-05 #2086
Caled Pg 2-18
Apn Billing
Recorder
ENABLING DECLARATION ESTABLISHING A PLAN
FOR CONDOMINIUM OWNERSHIP RECORDED IN
OR VOL. 522, PAGE 780.

BYLAWS OF "R" PLACE CONDOMINIUMS ARE RECORDED
IN OR VOL. 522, PAGE 794.

CERTIFICATION
THE DIMENSIONS SHOWN ON THE UNITS ARE FOR
THE FINISHED EXTERIOR AS CONSTRUCTED UPON
TRACT 1 AND ARE ACCURATELY SHOWN HEREON.
JEFFREY S. PUTHOFF, P.E. #61619
DATE 1/18/05

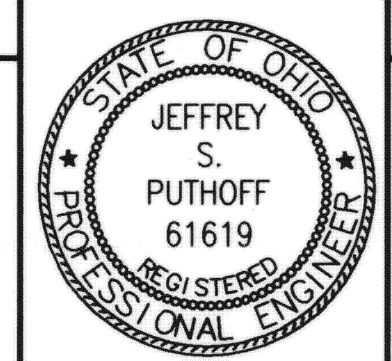

CERTIFICATION
THE DIMENSIONS SHOWN ON THE UNITS ARE FOR
THE FINISHED EXTERIOR AS CONSTRUCTED UPON
TRACT 1 AND ARE ACCURATELY SHOWN HEREON.
Wesley D. Goubeaux, P.S. #8254
DATE 1-18-05

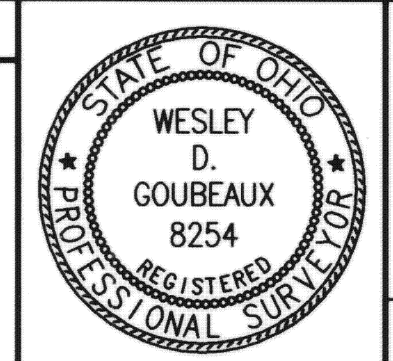

CHOICE ONE ENGINEERING
the choice that exceeds...
440 E. HOEWISHER ROAD
SIDNEY, OHIO 45365
(937) 497-0200 • FAX (937) 497-0300
www.choiceoneengineering.com
date: 01-18-2005
drawn by: wdg
job number: AUGMIN0501



Front Elevation



Rear Elevation



THESE DRAWINGS, AS PREPARED BY THE DEVELOPER, PROVIDE A
GENERALLY ACCURATE REPRESENTATION OF THE STRUCTURE AS BUILT

VERIFIED DURING A SITE VISIT ON 2/10/05

Bradley T. Garmann
BRADLEY T. GARMANN, R.A. # 8241

2/19/05
DATE

E1, E2, F1, F2

Riethman Condo

Rosebud Subdivision
Minster, Ohio 45865

RIETHMAN
BUILDERS, L.L.C.
MINSTER, OH
419 628-3096

Condo and Garage

Front & Rear Elevations

Revision

SCALE
1/4" = 1'


DRAWN BY
JBM

REVISED


DRAWING NUMBER
248-04

APPROVED BY

DATE
9/14/04

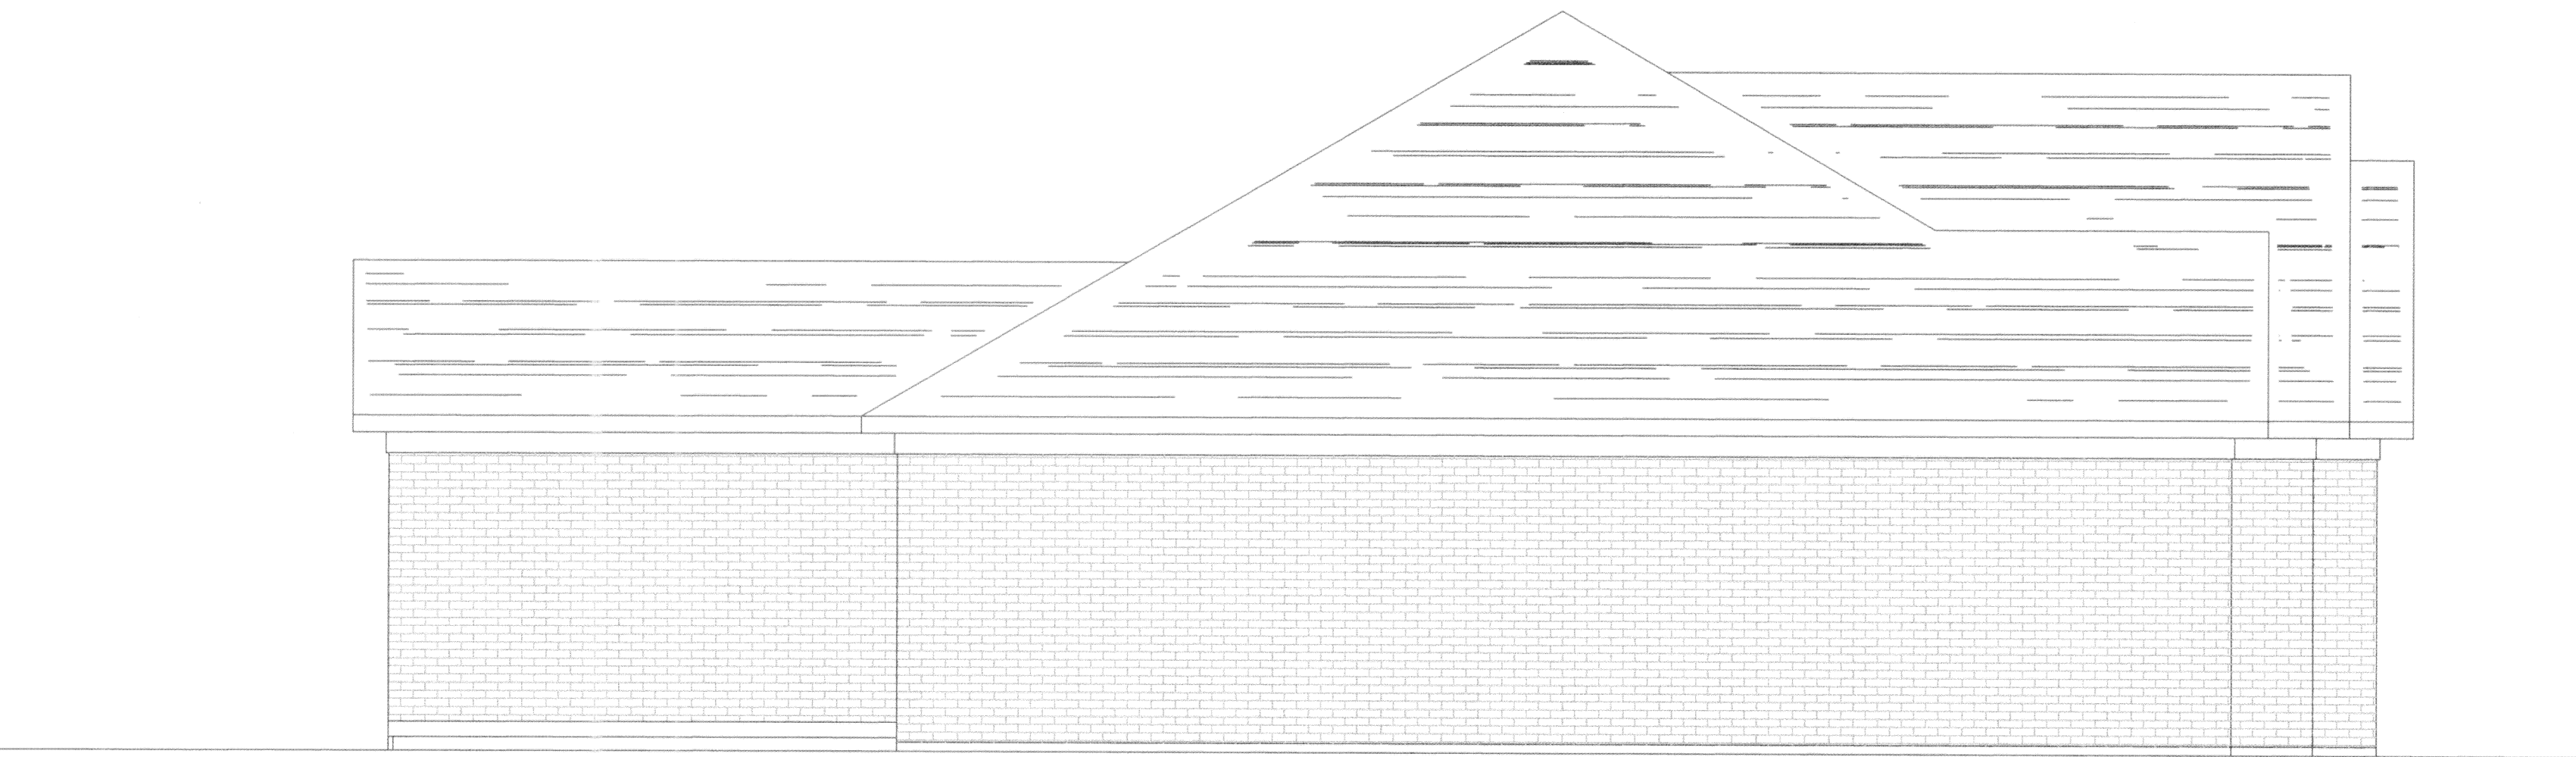



Left Side Elevation

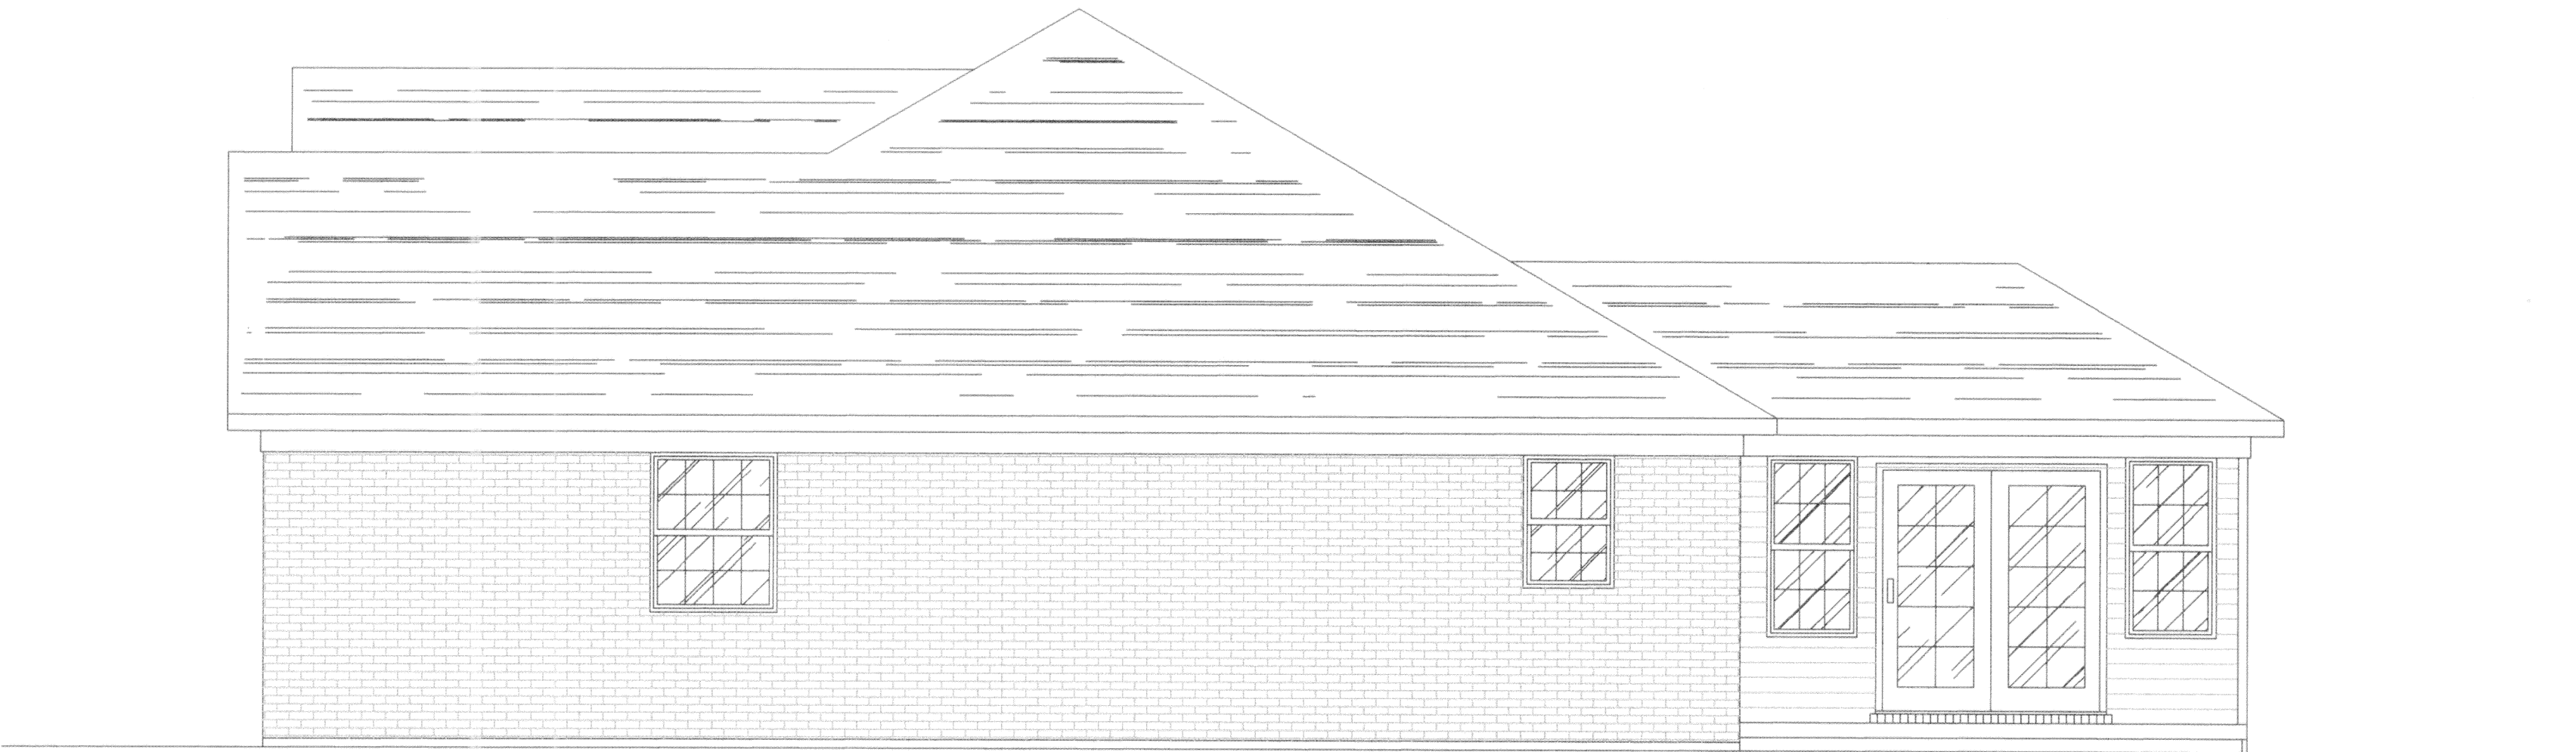

Right Side Elevation

2/14/05

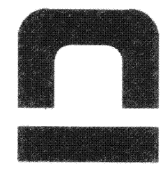
E2	 RIETHMAN BUILDERS, L.L.C. MINSTER, OH 419 628-3096	Riethman Condo Rosebud Subdivision Minster, Ohio 45865	Condo and Garage	
			Side Elevations	
			DATE	APPROVED BY
			9/14/04	DRAWING NUMBER 248-04

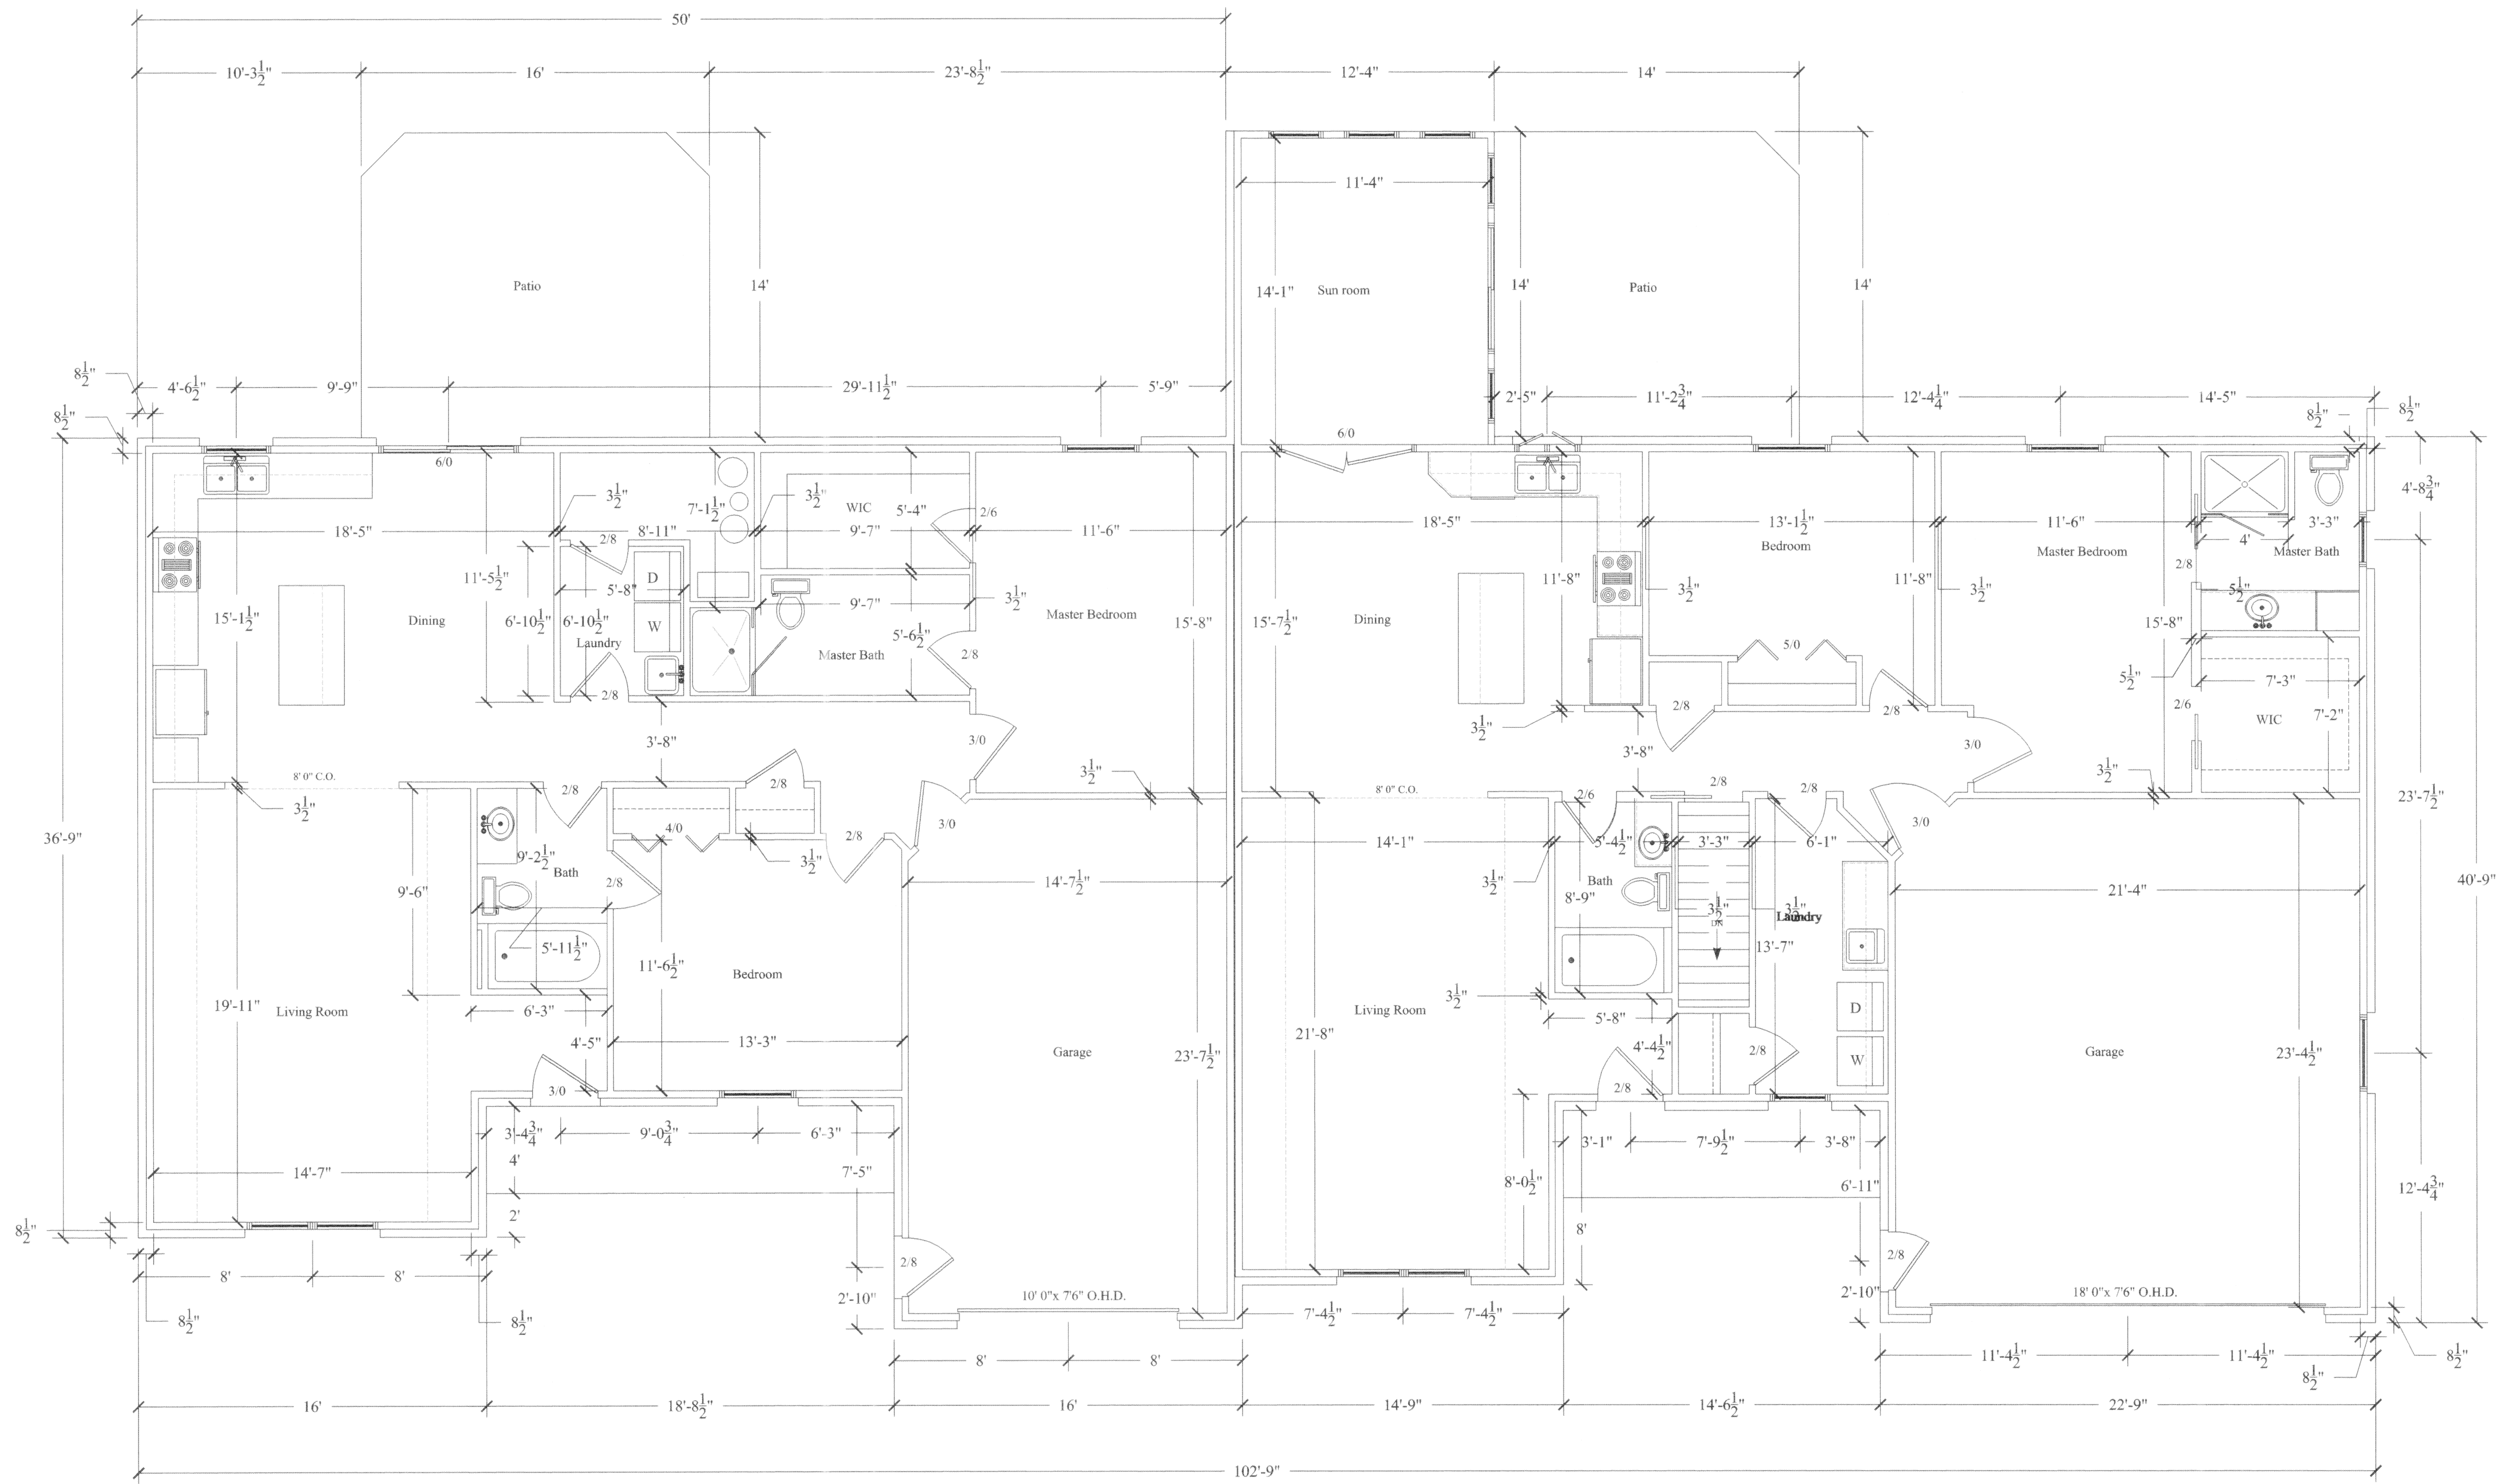

Revision	Condo and Garage	
	Dimensioned Floor Plan	
	SCALE	DRAWN BY
	1/4" = 1'	JBM
		REVISED
	DATE	APPROVED BY
	9/14/04	
	DRAWING NUMBER	248-04

Riethman Condo

Rosebud Subdivision
Minster, Ohio 45865

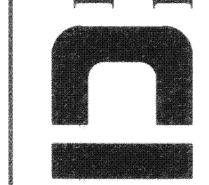

RIETHMAN

BUILDERS, L.L.C.

MINSTER, OH


419 628-3096

F1

2/14/05



Front Elevations

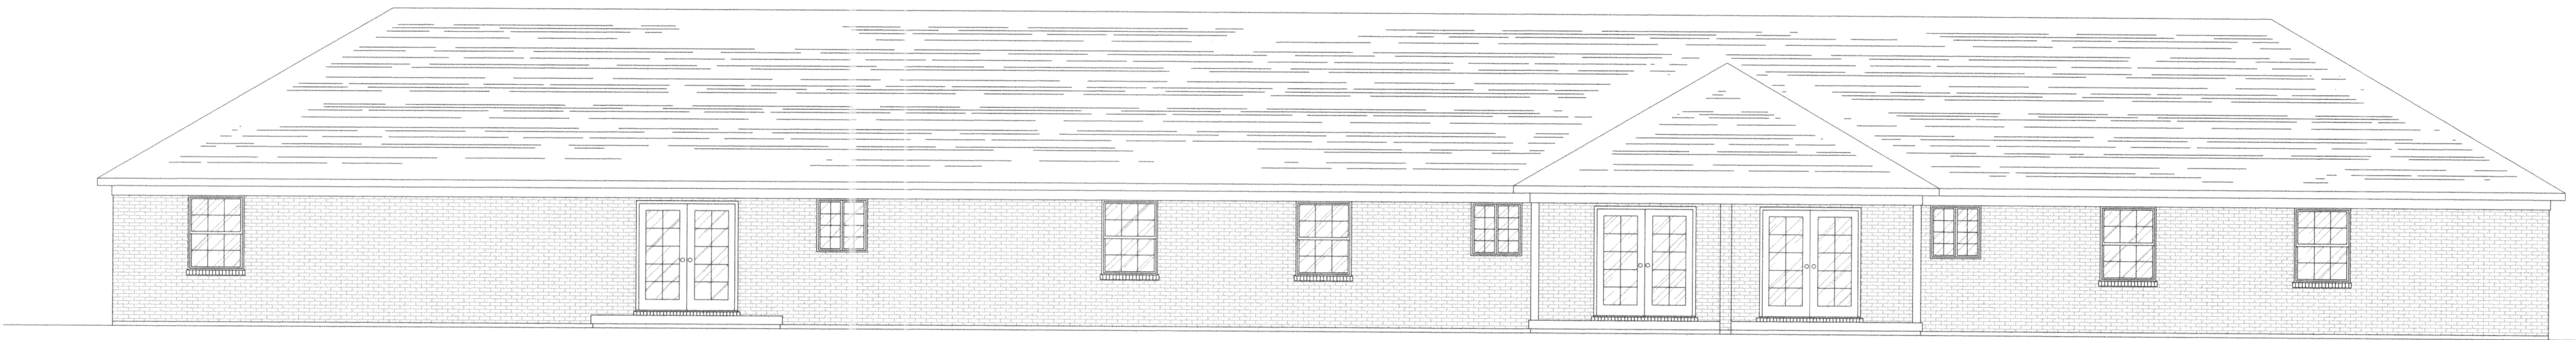

Rear Elevations



THESE DRAWINGS, AS PREPARED BY THE DEVELOPER, PROVIDE A GENERALLY
ACCURATE REPRESENTATION OF THE STRUCTURE AS BUILT.
VERIFIED DURING A SITE VISIT ON 2/14/05
Bradley T. Garmann
BRADLEY T. GARMANN P.A. #8241
DATE
2/14/05
E1, E2, F1 & F1


Revision	Northeast Condo Building	
	SCALE 3/16" = 1'	DRAWN BY JBM
	Front & Rear Elevations	
	DATE 10/23/04	APPROVED BY
		DRAWING NUMBER 249-04

Riethman Condo

Rosebud Subdivision
Minster, Ohio 45865

RIETHMAN BUILDERS, L.L.C.
MINSTER, OH
419 628-3096


E1

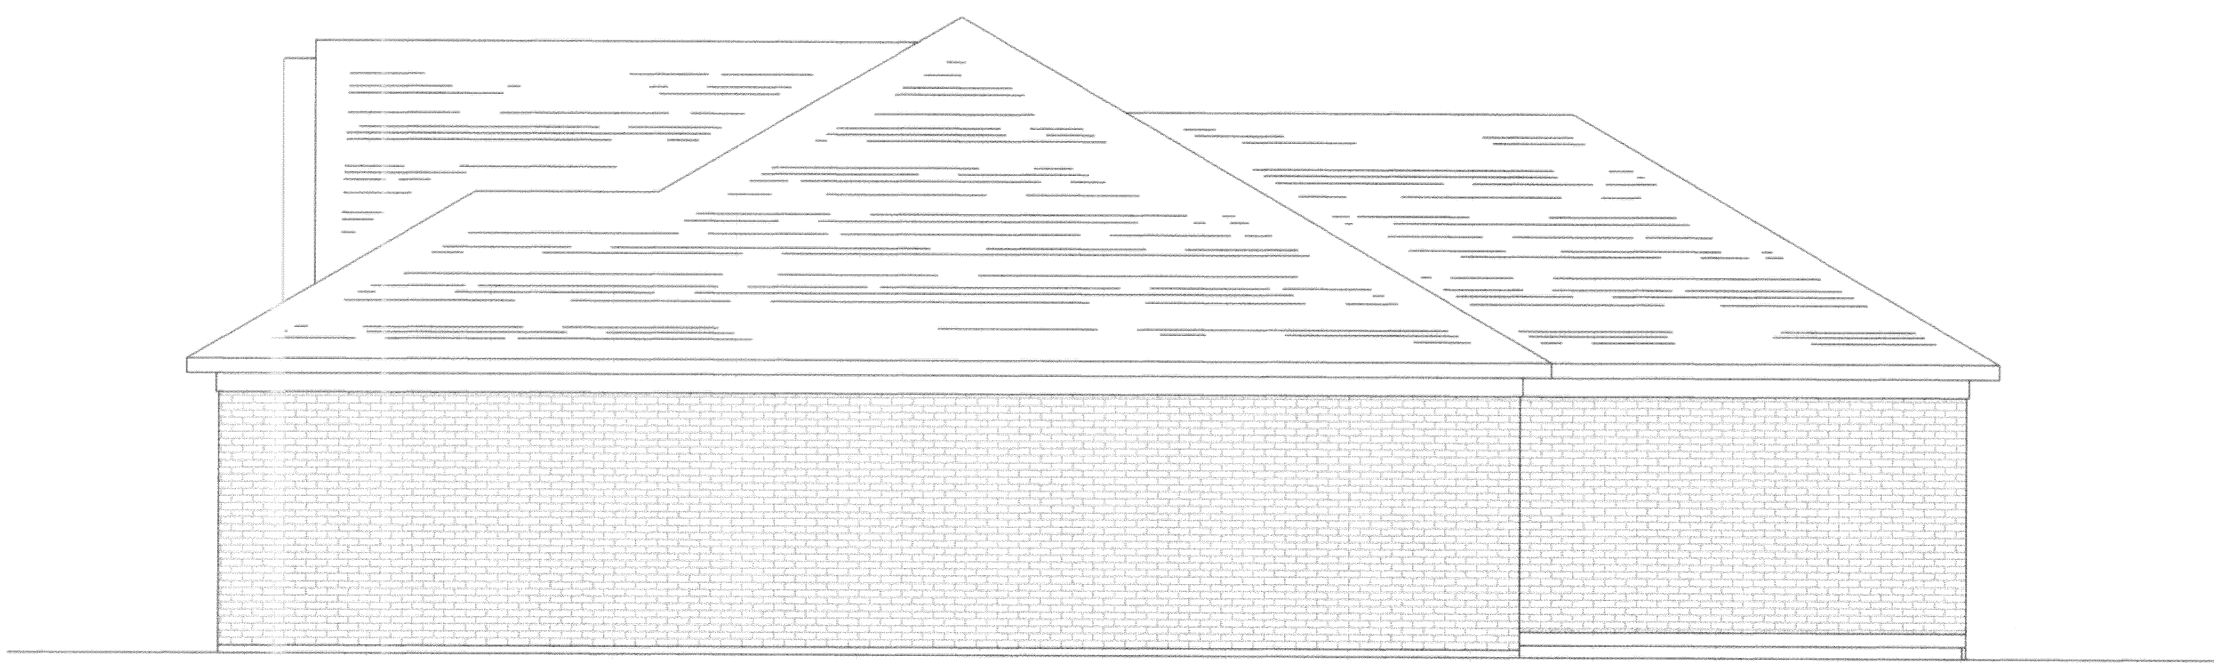

West Elevation



East Elevation

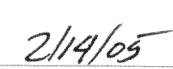


**RIETHMAN
BUILDERS, L.L.C.**
MINSTER, OH
419 628-3096

Rosebud Subdivision
Minster, Ohio 45865

Revision

D 15-16

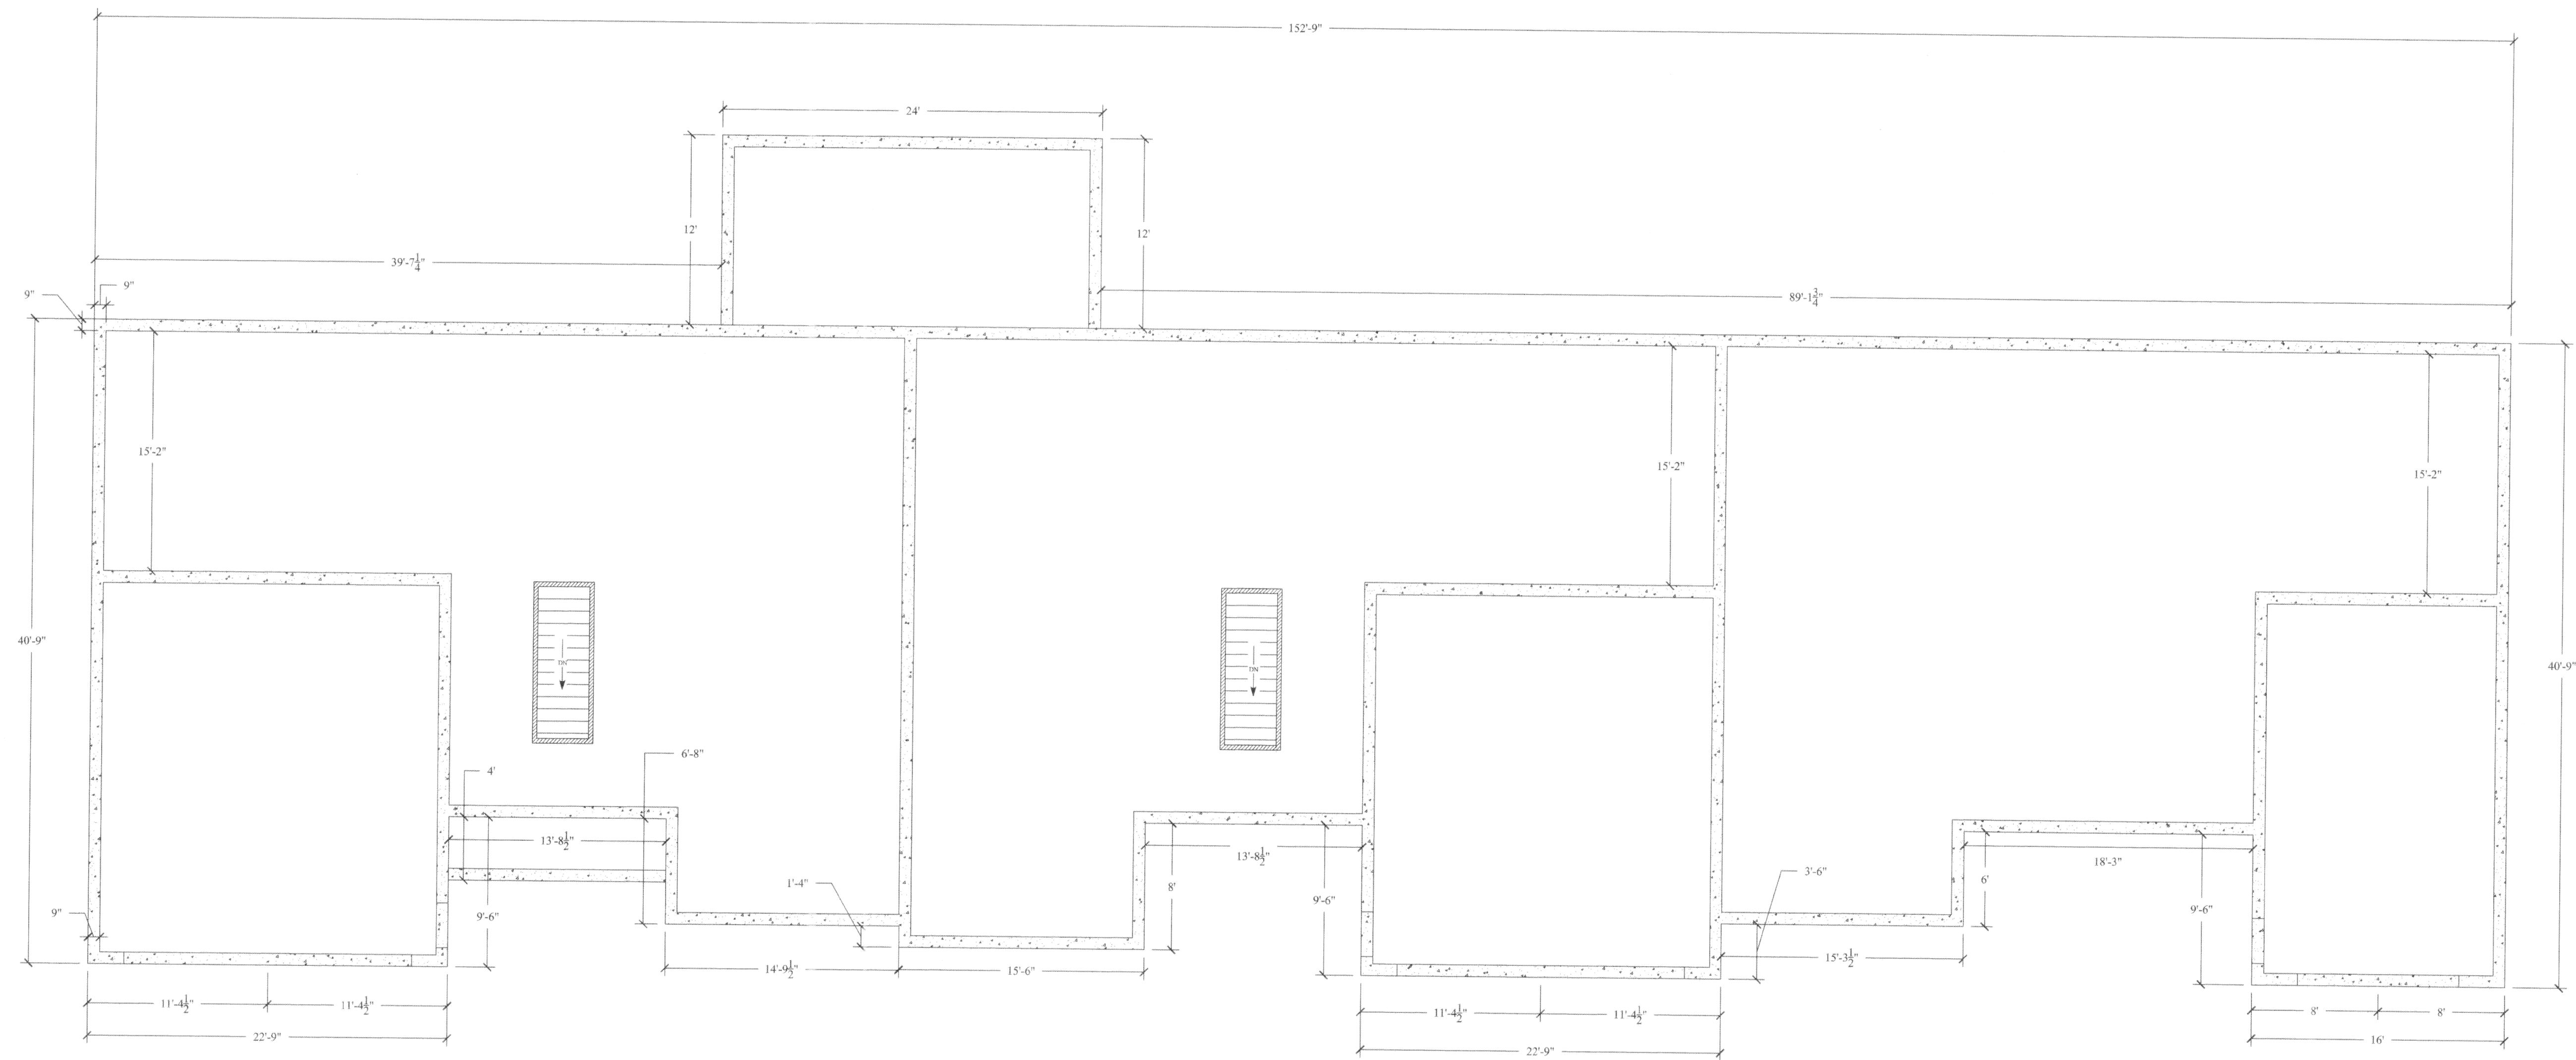

Foundation Plan

RIETHMAN BUILDERS, L.L.C. MINSTER, OH 419 628-3096 F1	Riethman Condo Rosebud Subdivision Minster, Ohio 45865		Northeast Condo Building Dimensioned Foundation Plan		SCALE DRAWN BY JBM REVISED
	Revision				
		DATE	APPROVED BY	DRAWING NUMBER	
		10/23/04		249-04	

D 172-18