

PARK PLACE CONDOMINIUM No. 5

BEING LOT NO. 25 OF PARK PLACE SUBDIVISION, PHASE TWO,
VILLAGE OF MINSTER, AUGLAIZE COUNTY, OHIO

TRANSFERRED AND NUMBERED THIS 18 DAY OF Aug, 2005

AUG 18 2005

Karyn Schumann C.S.
AUGLAIZE COUNTY AUDITOR


FILED THIS 18 DAY OF August, 2005 AT 3:17 O'CLOCK P.M.
RECORDED THIS 18 DAY OF August, 2005
PLAT CABINET 2, SLIDE 33

6345

Ana Bellino
AUGLAIZE COUNTY RECORDER



BEARINGS BASED ON PLAT OF PARK PLACE SUBDIVISION, PHASE ONE

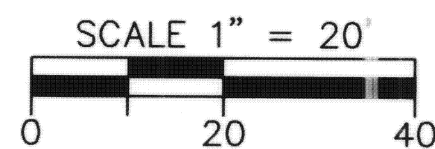

LEGEND

○ IRON PIN FOUND

ENABLING DECLARATION ESTABLISHING A PLAN
FOR CONDOMINIUM OWNERSHIP RECORDED IN
OR VOL. 529, PAGE 1139.


BYLAWS OF PARK PLACE CONDOMINIUM ARE RECORDED
IN OR VOL. 529, PAGE 1157.

OWNER LOT NO. 25: WEIGANDT LAND CO., LTD., O.R. VOL. 413, PG. 209

PARK PLACE SUBDIVISION, PHASE ONE, RECORDED IN PLAT CAB. C, SLIDE 244

PARK PLACE SUBDIVISION, PHASE TWO, RECORDED IN PLAT CAB. C, SLIDE 245-246

HAMILTON STREET 66' R/W

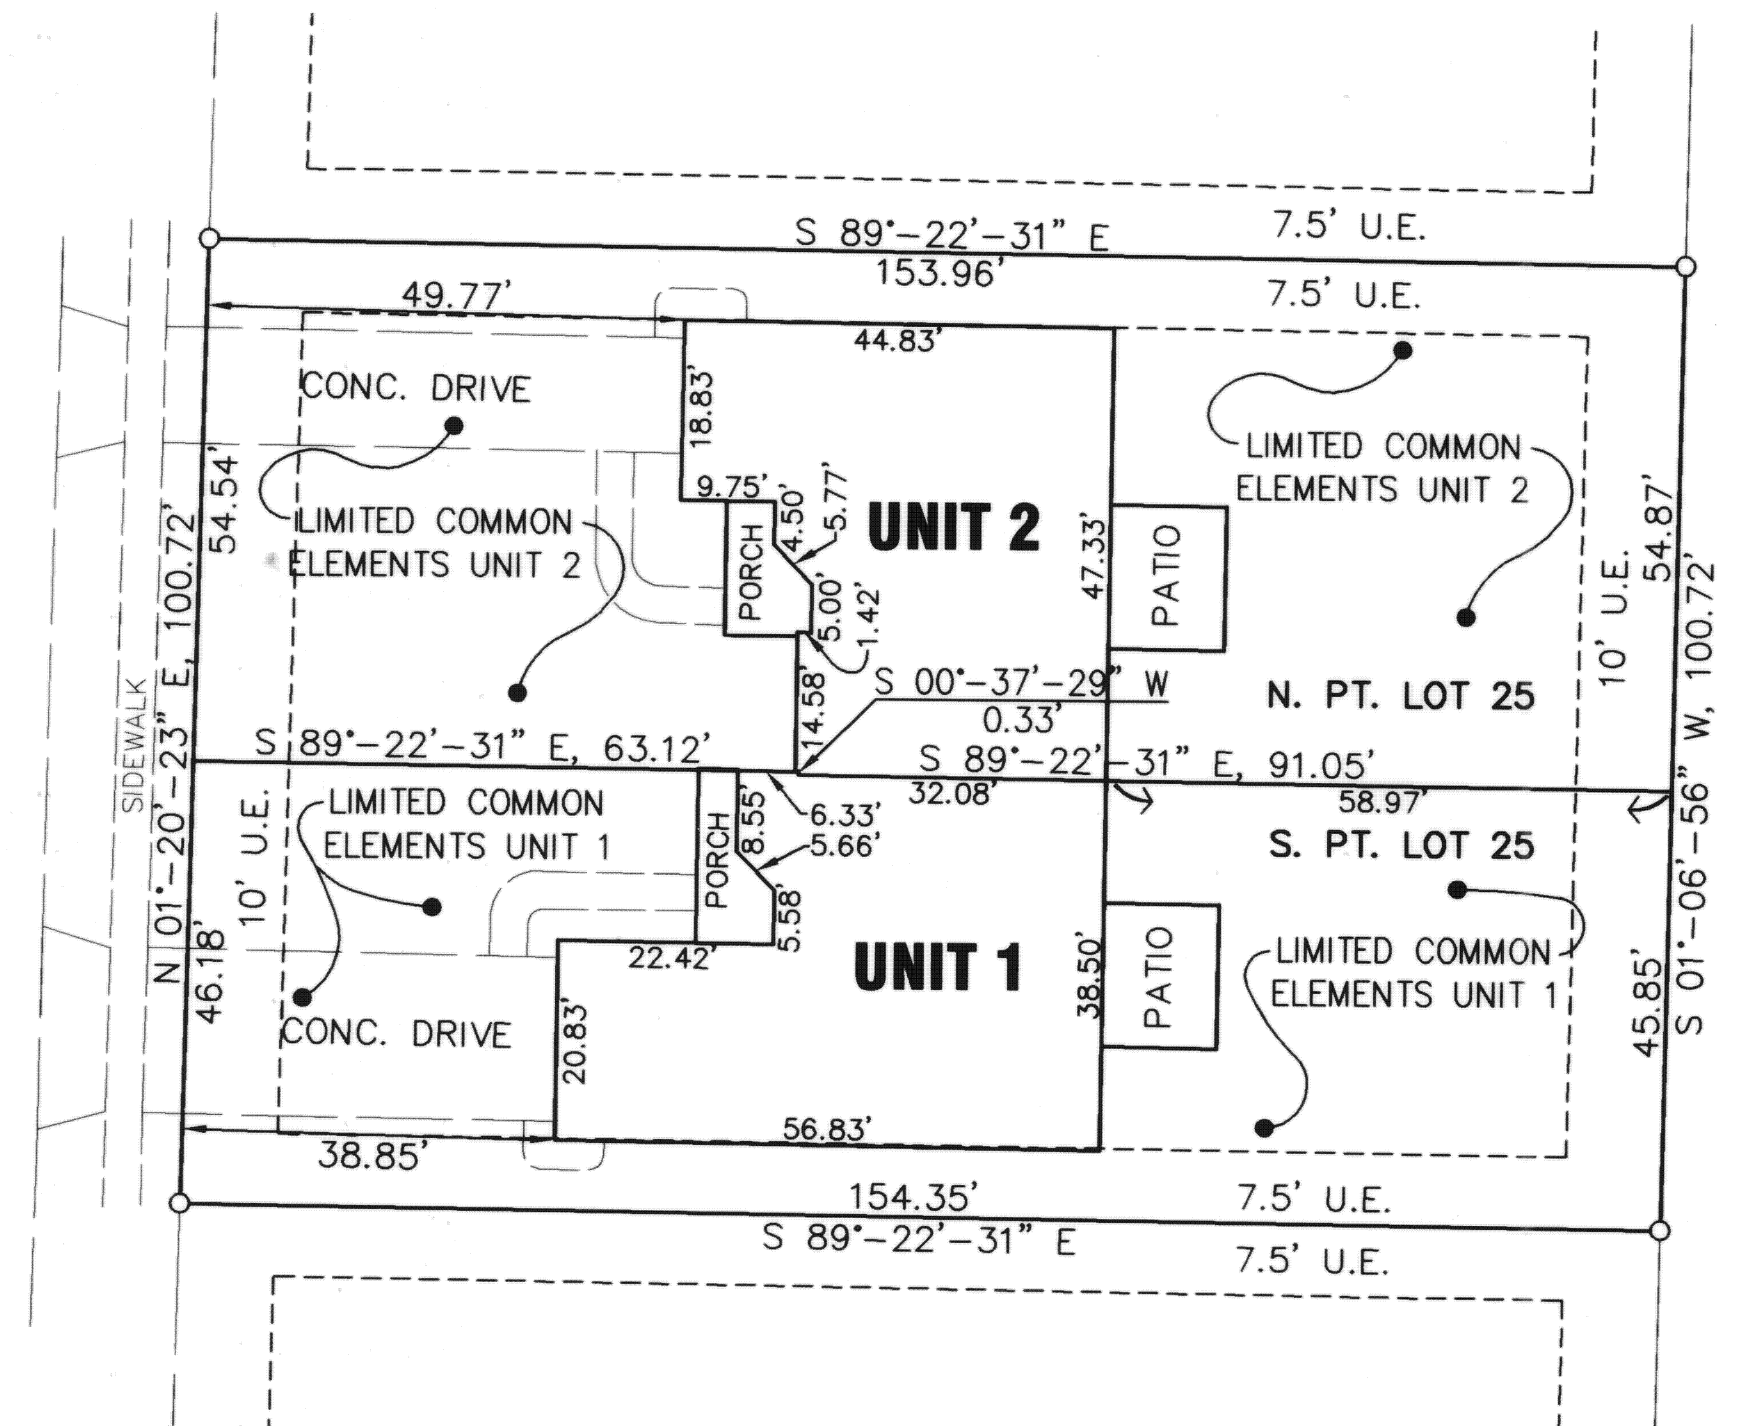


CERTIFICATION

THE DIMENSIONS SHOWN ON THE UNITS ARE FOR
THE FINISHED EXTERIOR AS CONSTRUCTED UPON
LOT 25 AND ARE ACCURATELY SHOWN HEREON.

Jeffrey S. Puthoff
JEFFREY S. PUTHOFF, P.E. #61619

8/4/05
DATE

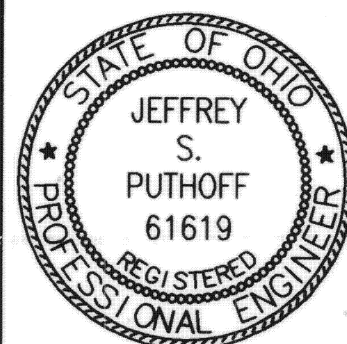


CERTIFICATION

THE DIMENSIONS SHOWN ON THE UNITS ARE FOR
THE FINISHED EXTERIOR AS CONSTRUCTED UPON
LOT 25 AND ARE ACCURATELY SHOWN HEREON.

Steven E. Bowersox
STEVEN E. BOWERSOX, P.S. #7059

08-04-2005
DATE

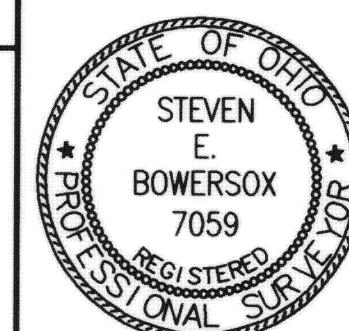

CHOICE ONE ENGINEERING
the choice that exceeds ...

440 E. HOEWISHER ROAD
SIDNEY, OHIO 45365
(937) 497-0200 • FAX (937) 497-0300
www.choiceoneengineering.com

date: 08-04-2005 drawn by: seb job number: AugMin0112