


Cal D Slides 51-55

SHEET 1 OF 5


MARSH POINTE CONDOMINIUMS

Part of the N.E. 1/4, Sec. 19 and the S.E. 1/4, Sec. 18,
St. Marys Twp., Auglaize County, Ohio
Klosterman Kove Lot 20 and 21.

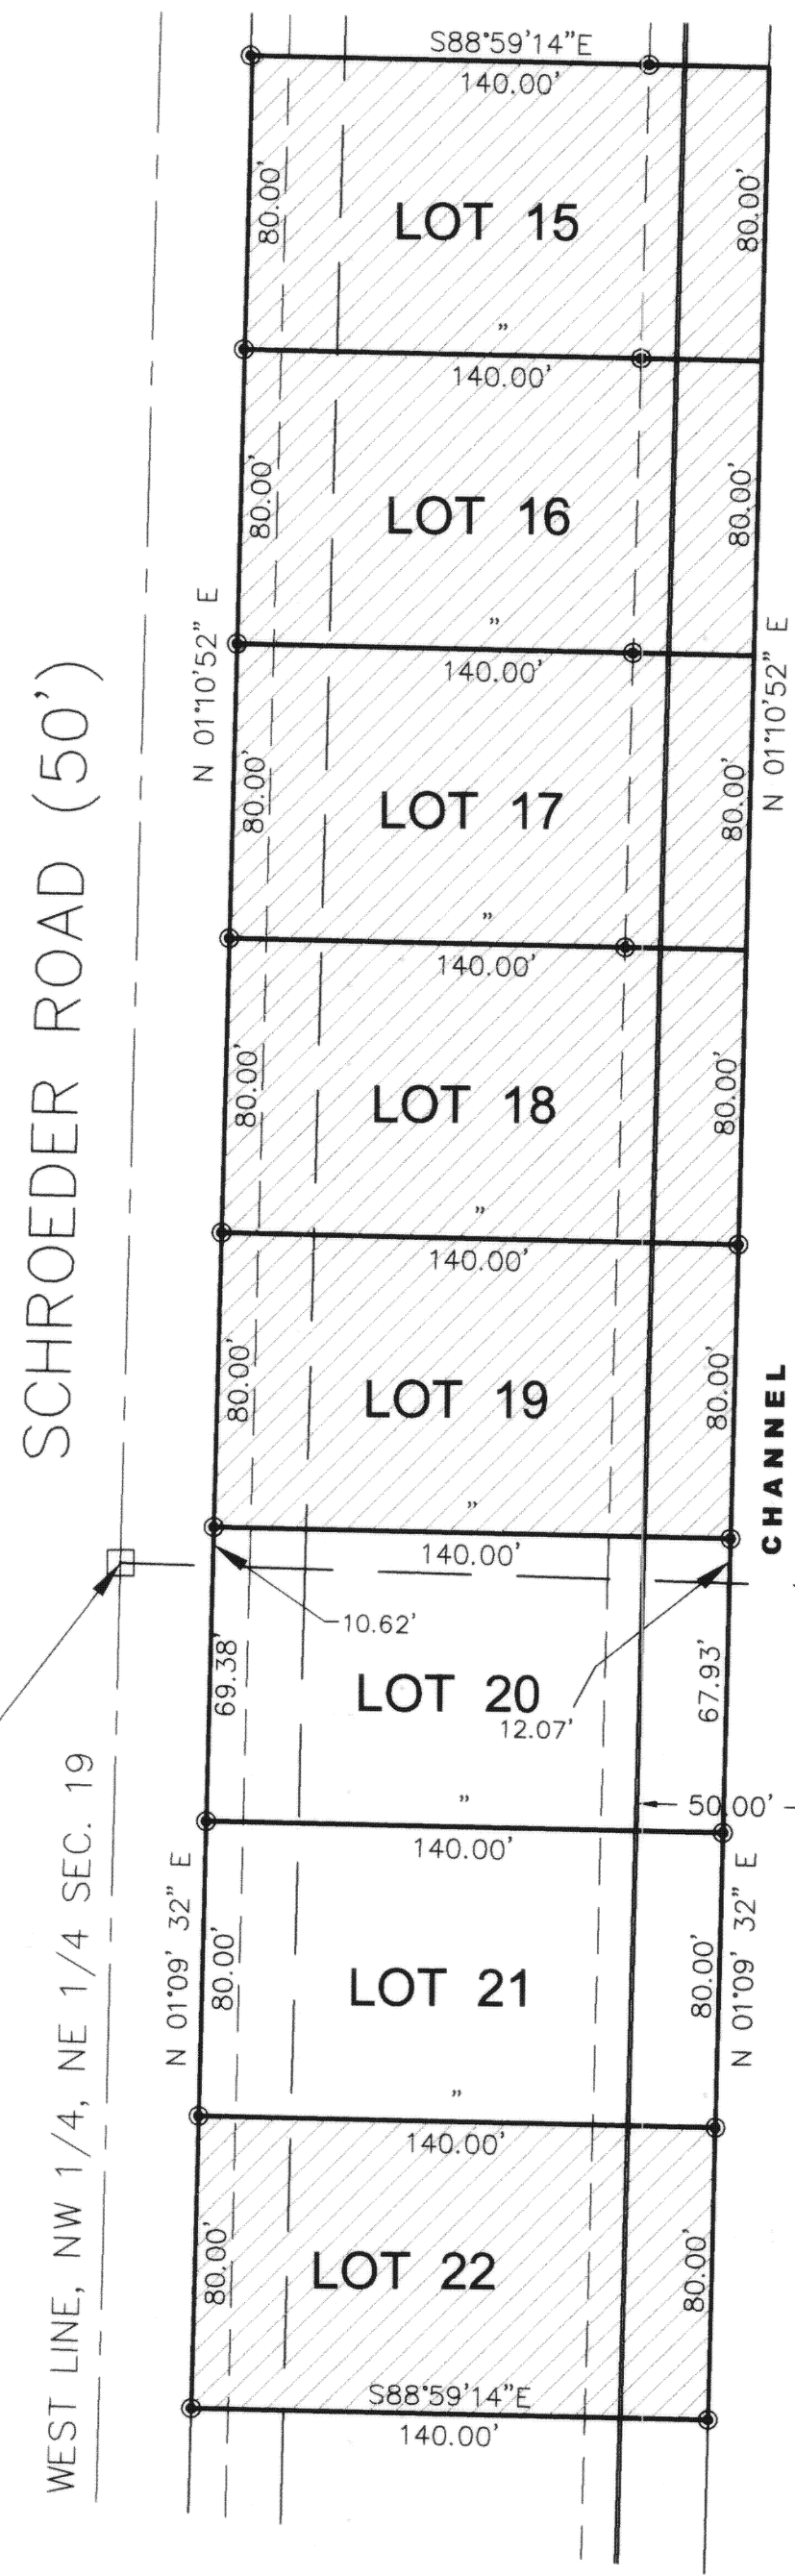


SW Corner, SE 1/4,
Section 18, St. Marys
Township

SECTION 18
SECTION 19

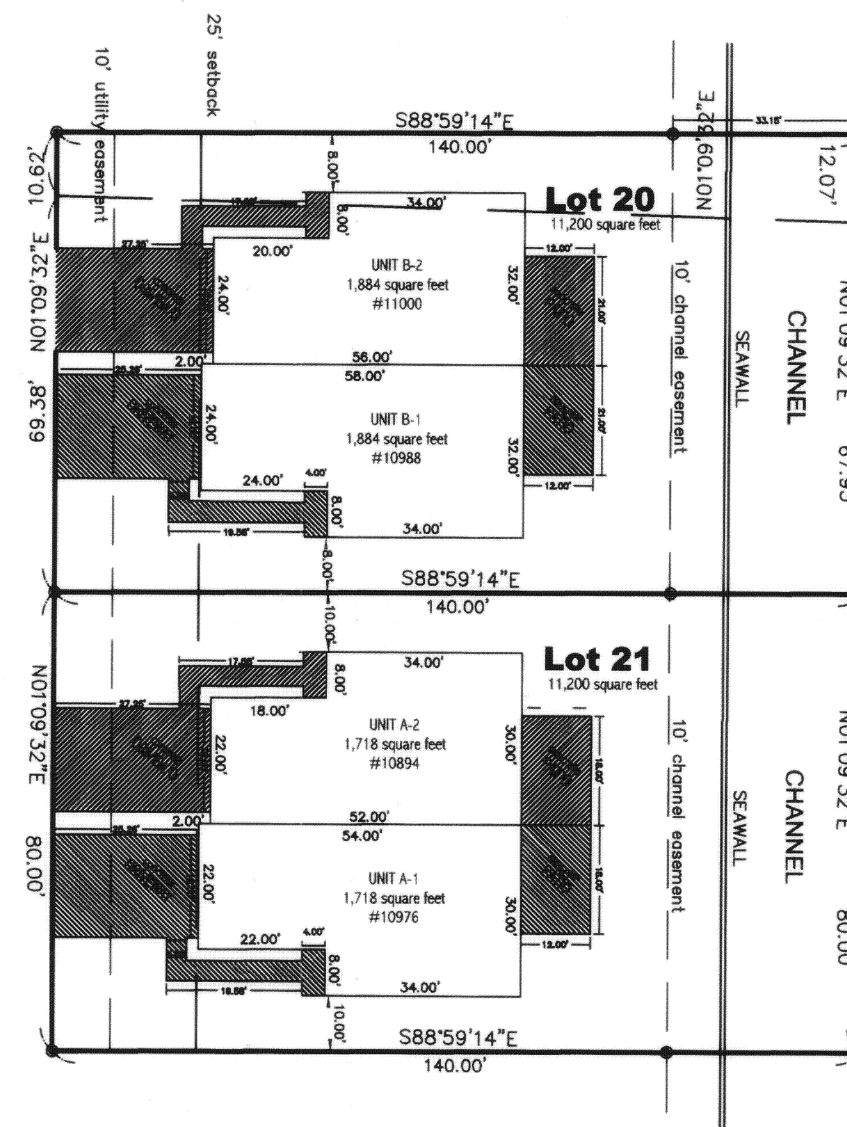

LEGEND

- DENOTES LIMITED COMMON AREA UNIT 1
- DENOTES LIMITED COMMON AREA UNIT 2
- DENOTES EXPANDABLE AREA

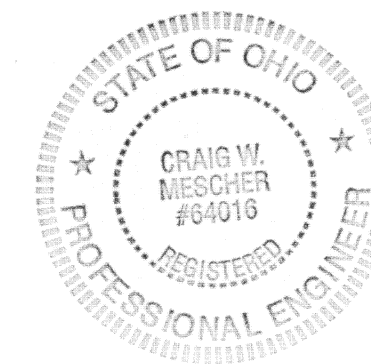

We, Craig W. Mescher, P.E., State of Ohio registration No. 64016,
and James M. Kent, P.S., State of Ohio registration No. 6792,
Do hereby certify that these drawings accurately show graphically
the location, dimensions and configurations of Units 1 and 2 of
Marsh Pointe Condominiums, as constructed.

Dated at Celina, Ohio on 12/6, 2005

By: Craig W. Mescher, Professional Engineer No. 64016

kent surveying, inc.



acad - Marsh Pointe Condos

drawing # 4572

September 12, 2005

revised December 6, 2005

By: James M. Kent, Professional Surveyor No. 6792

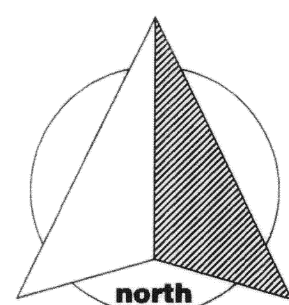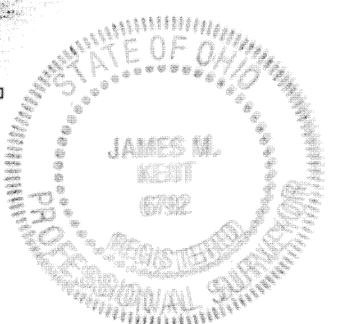

GRAPHIC SCALE




(IN FEET)
1 inch = 50 ft.


MARSH POINTE CONDOMINIUMS

Part of the N.E. 1/4 of Section 19 and Part of the SE 1/4
of Section 18, St. Marys Twp., Auglaize County, Ohio
Klosterman Kove Lot 20


UNIT B

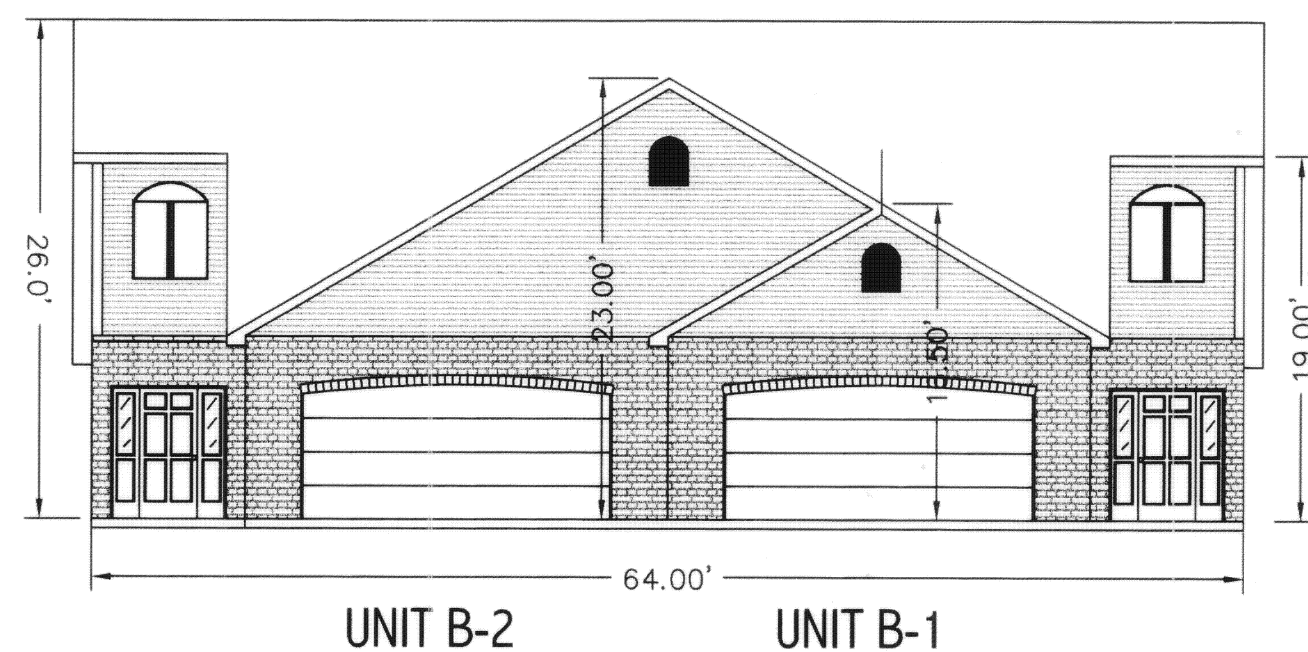


FRONT ELEVATION

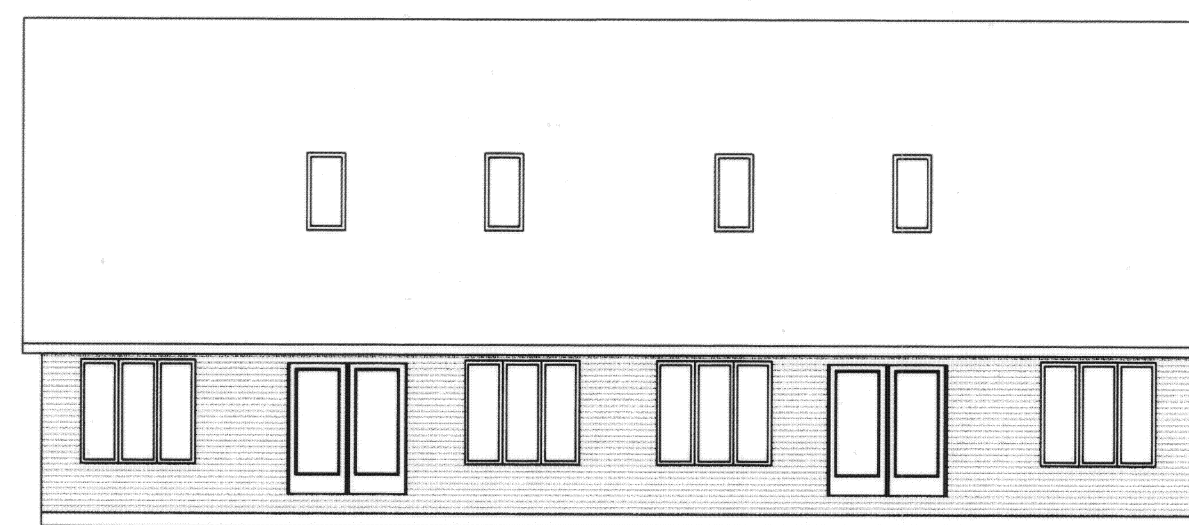


REAR ELEVATION

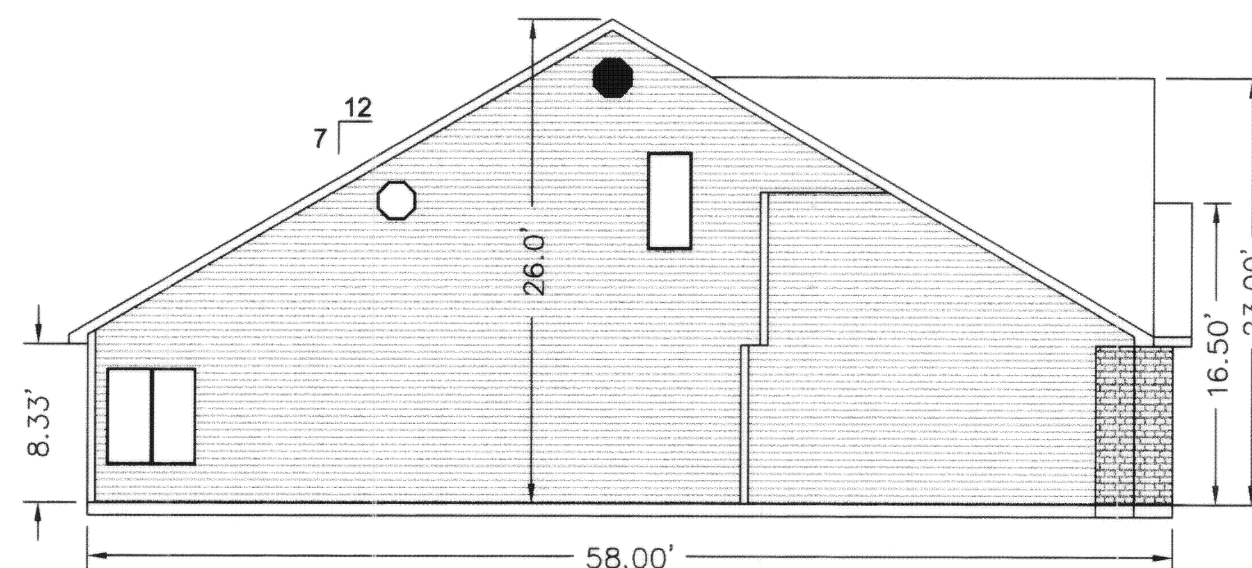

UNIT B-2
LEFT ELEVATION

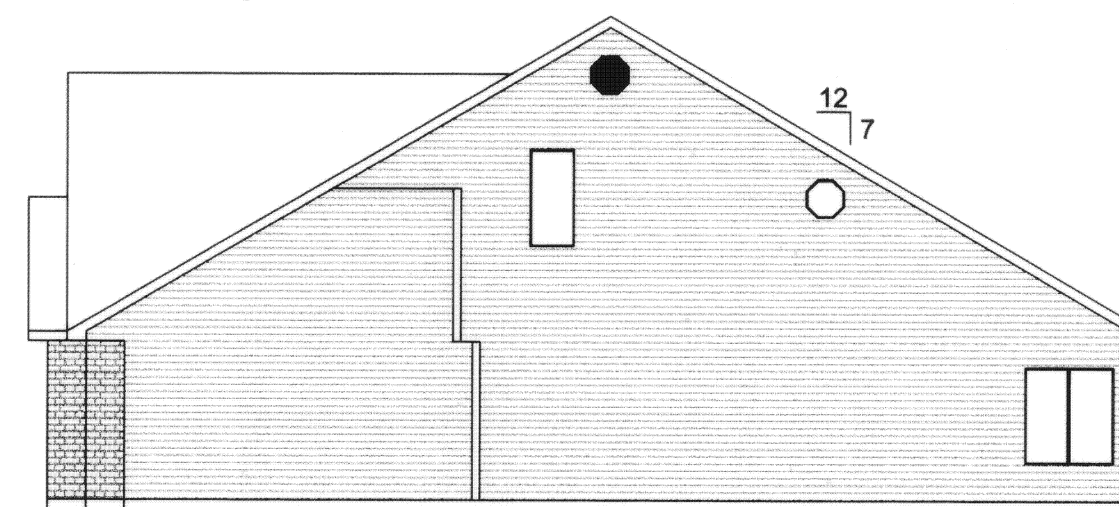

UNIT B-1
RIGHT ELEVATION

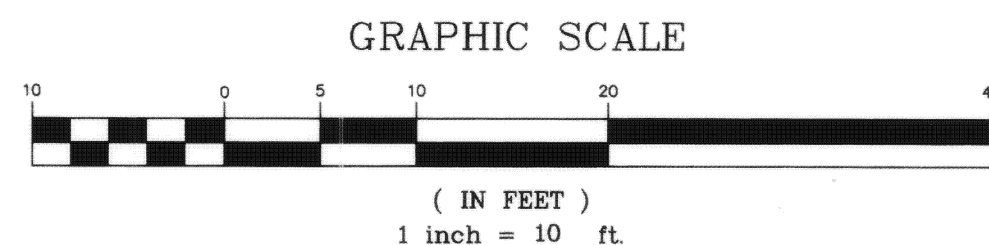

DENOTES
BRICK


DENOTES
VINYL SIDING

kent surveying, inc.
acad - Marsh Pointe Condos
drawing # 4572
September 12, 2005

MARSH POINTE CONDOMINIUMS


Part of the N.E. 1/4, Sec. 19, St. Marys Twp., Auglaize County, Ohio
Klosterman Kove Lot 20

UNIT B

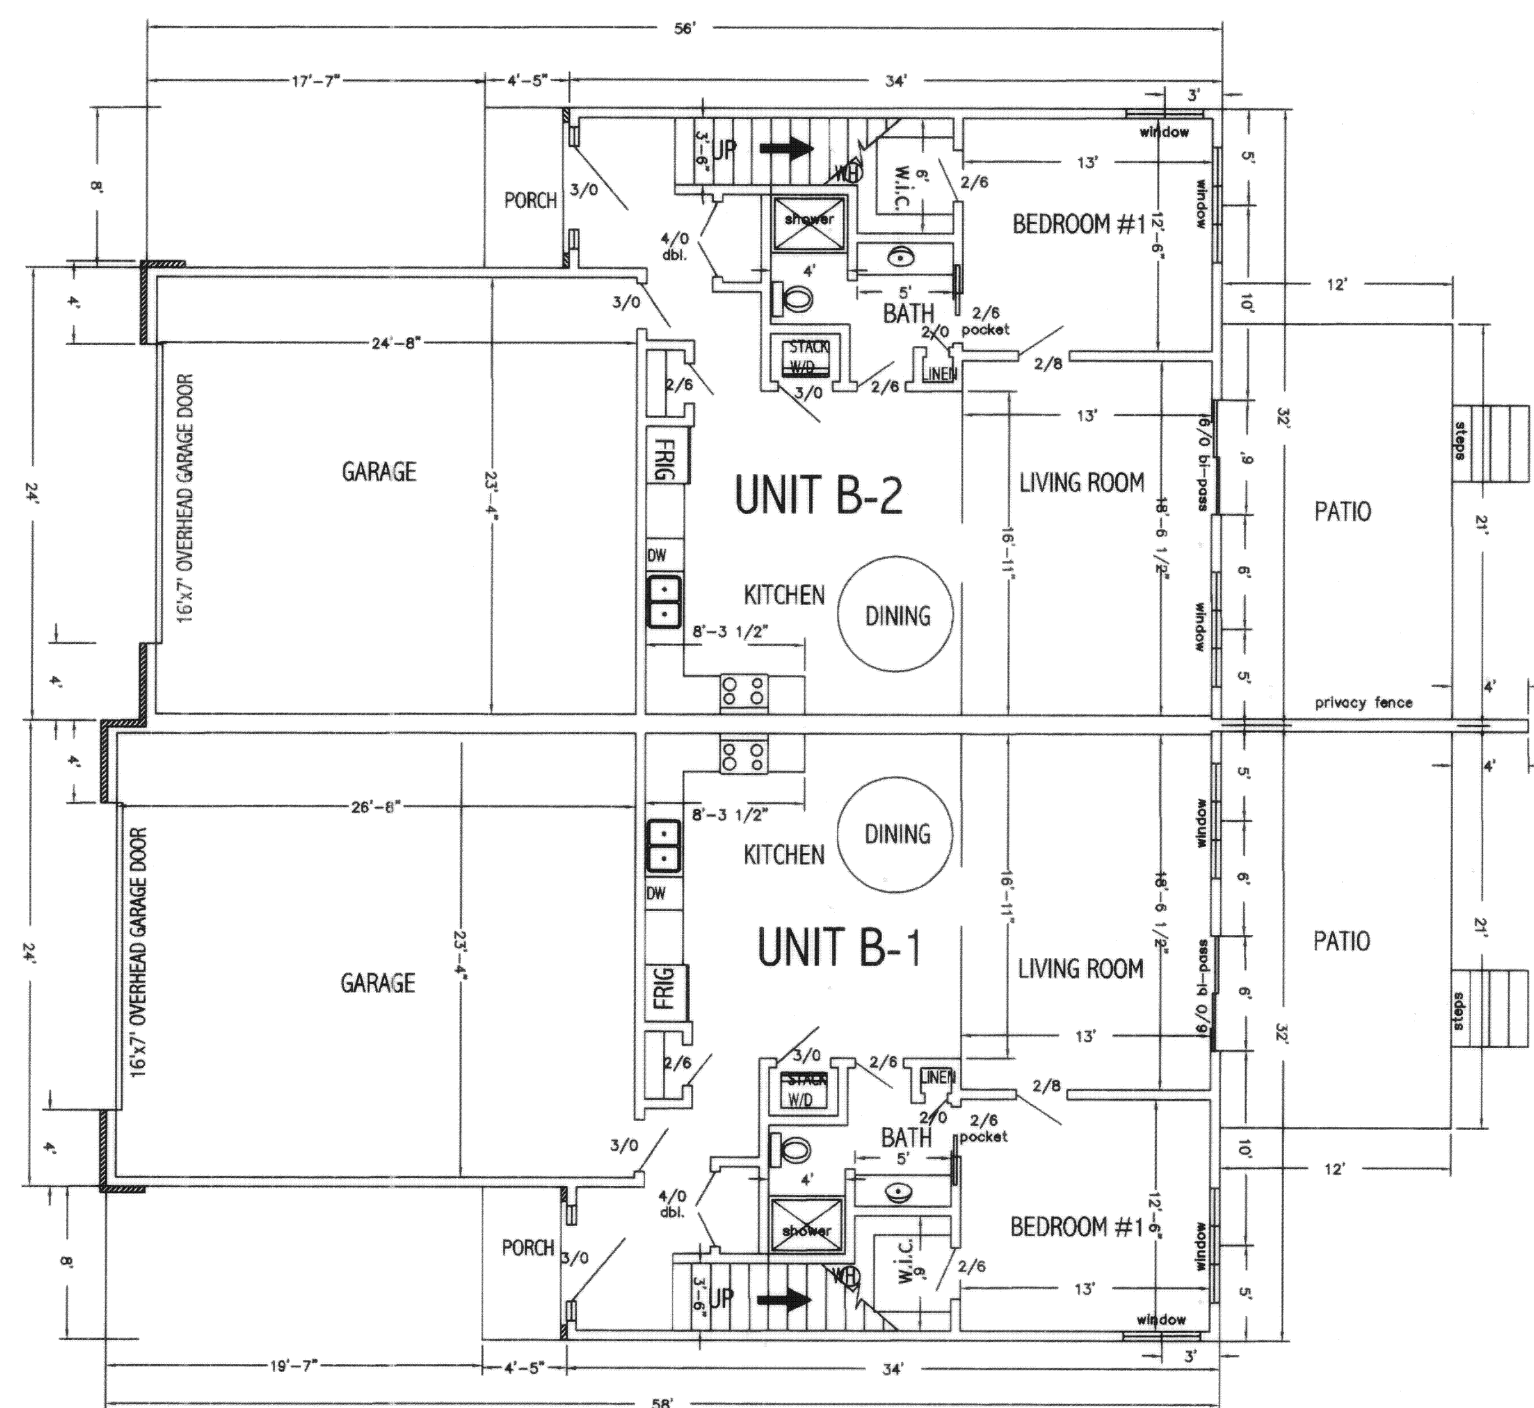



FIRST FLOOR

1017 square ft. living space

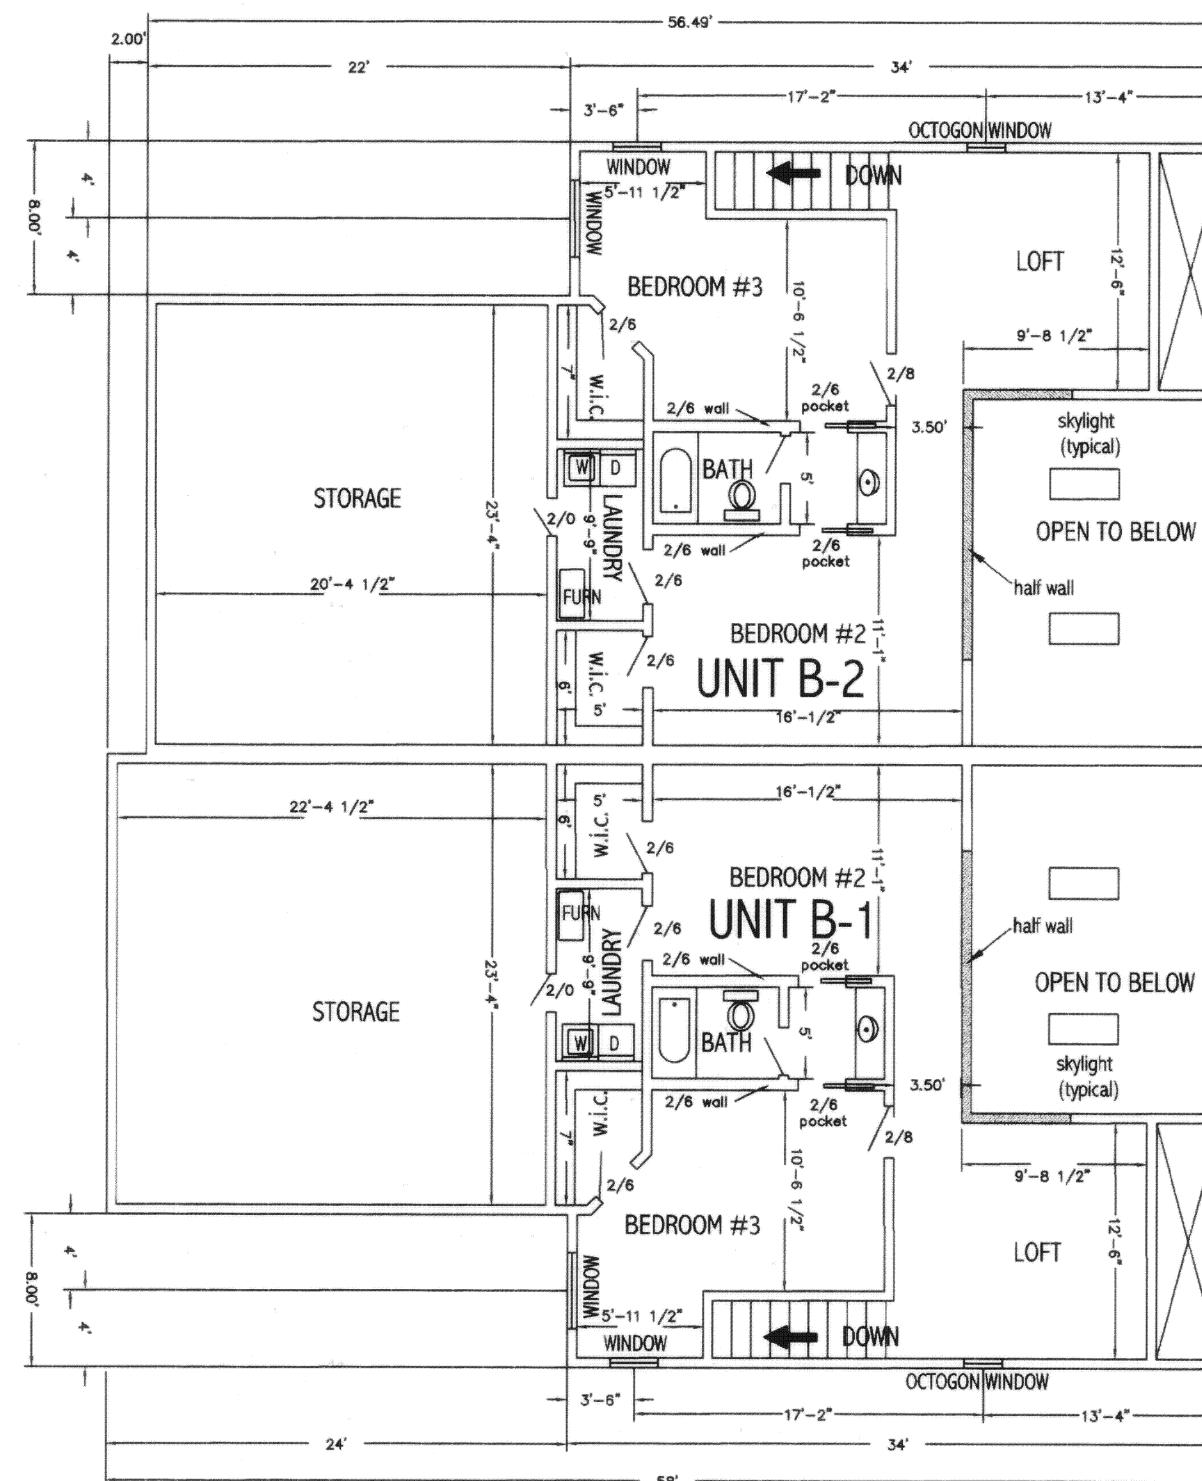

SECOND FLOOR

867 square ft. living space

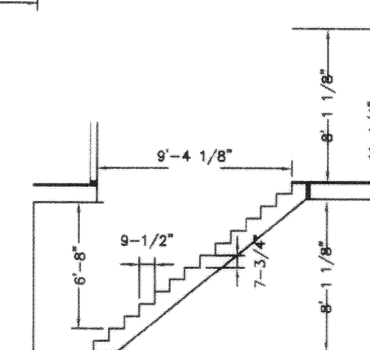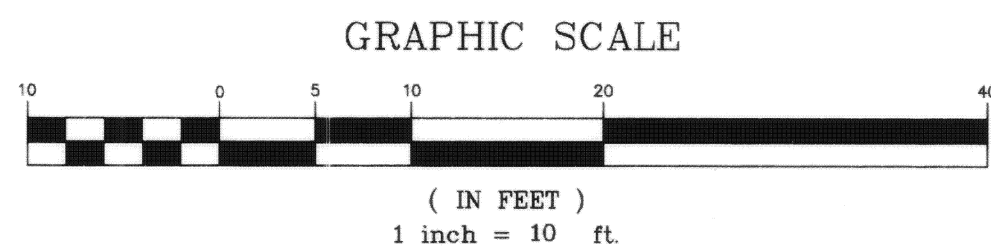


kent surveying, inc.
acad - Marsh Pointe Condos
drawing # 4572
June 15, 2005
revised December 6, 2005


MARSH POINTE CONDOMINIUMS

Part of the N.E. 1/4, Sec. 19, St. Marys Twp., Auglaize County, Ohio
Klosterman Kove Lot 21


UNIT A

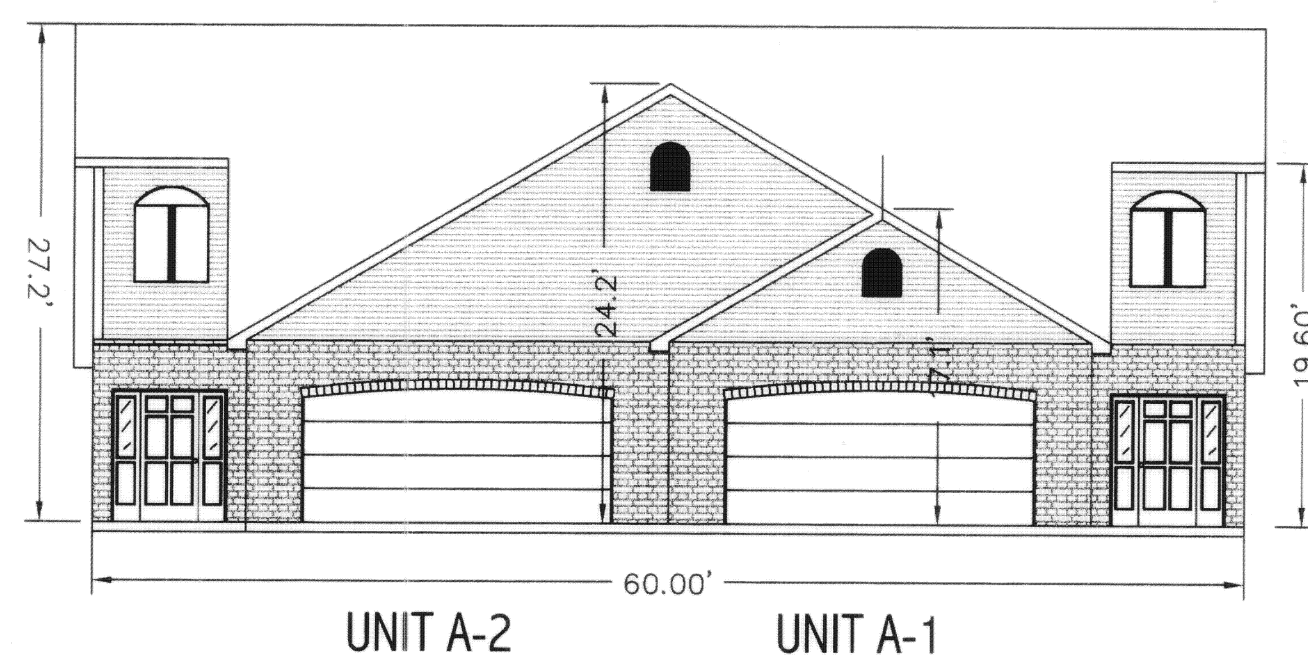


FRONT ELEVATION

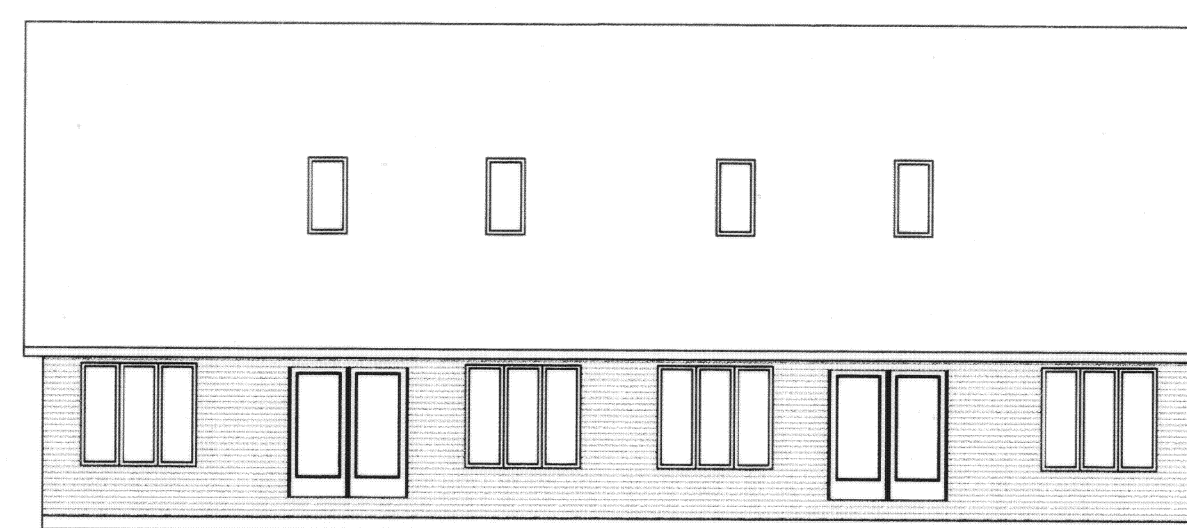



REAR ELEVATION

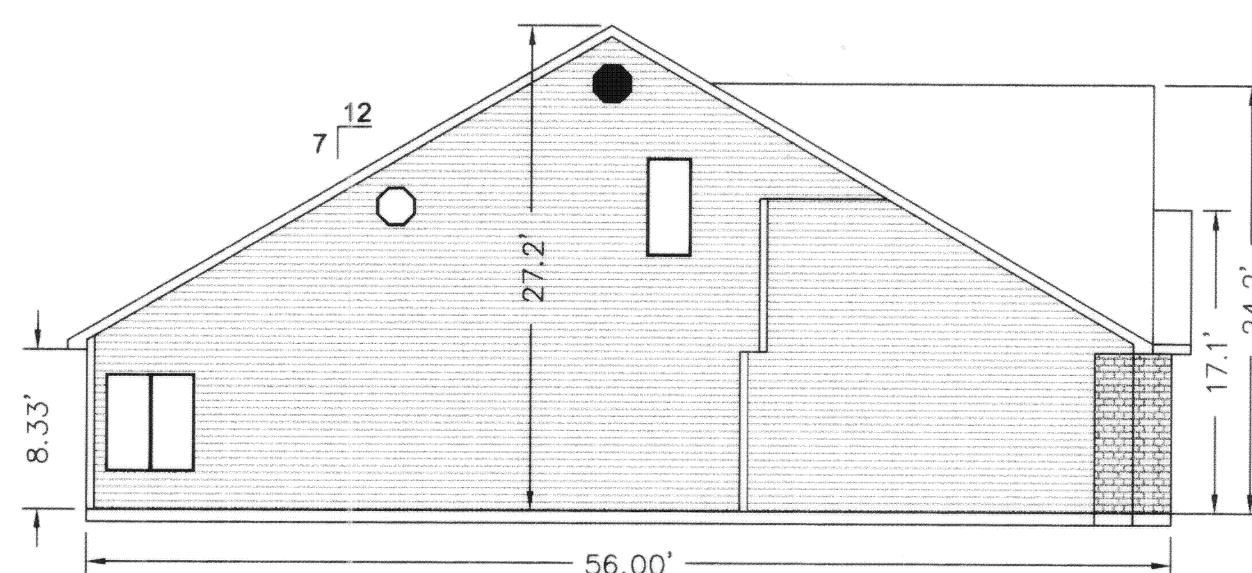

UNIT A-2
LEFT ELEVATION

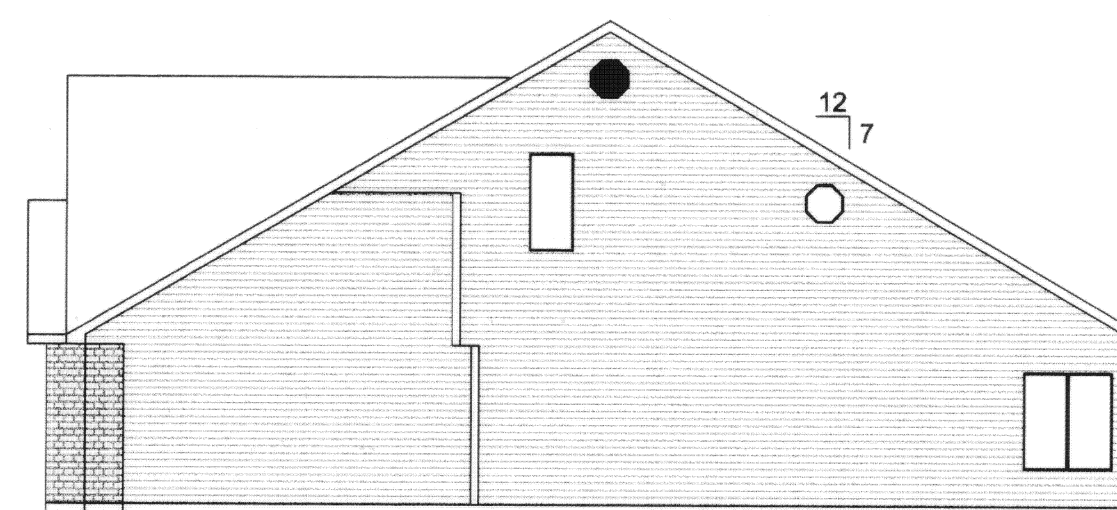

UNIT A-1
RIGHT ELEVATION

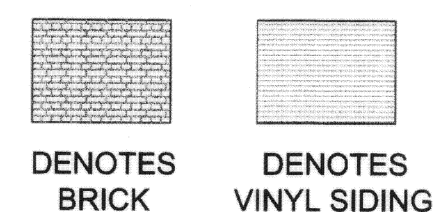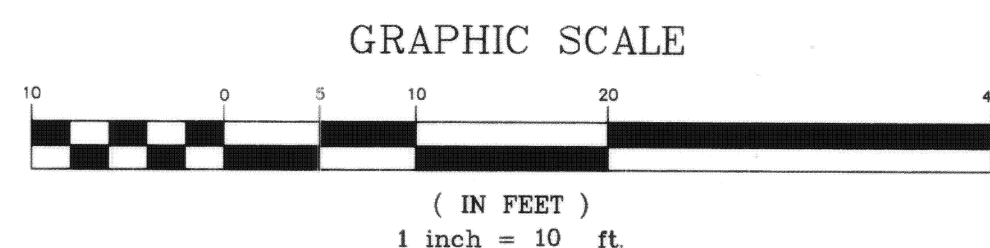


kent surveying, inc.
acad - Marsh Pointe Condos
drawing # 4572
September 12, 2005
revised December 6, 2005


MARSH POINTE CONDOMINIUMS

Part of the N.E. 1/4, Sec. 19, St. Marys Twp., Auglaize County, Ohio
Klosterman Kove Lot 21



UNIT A

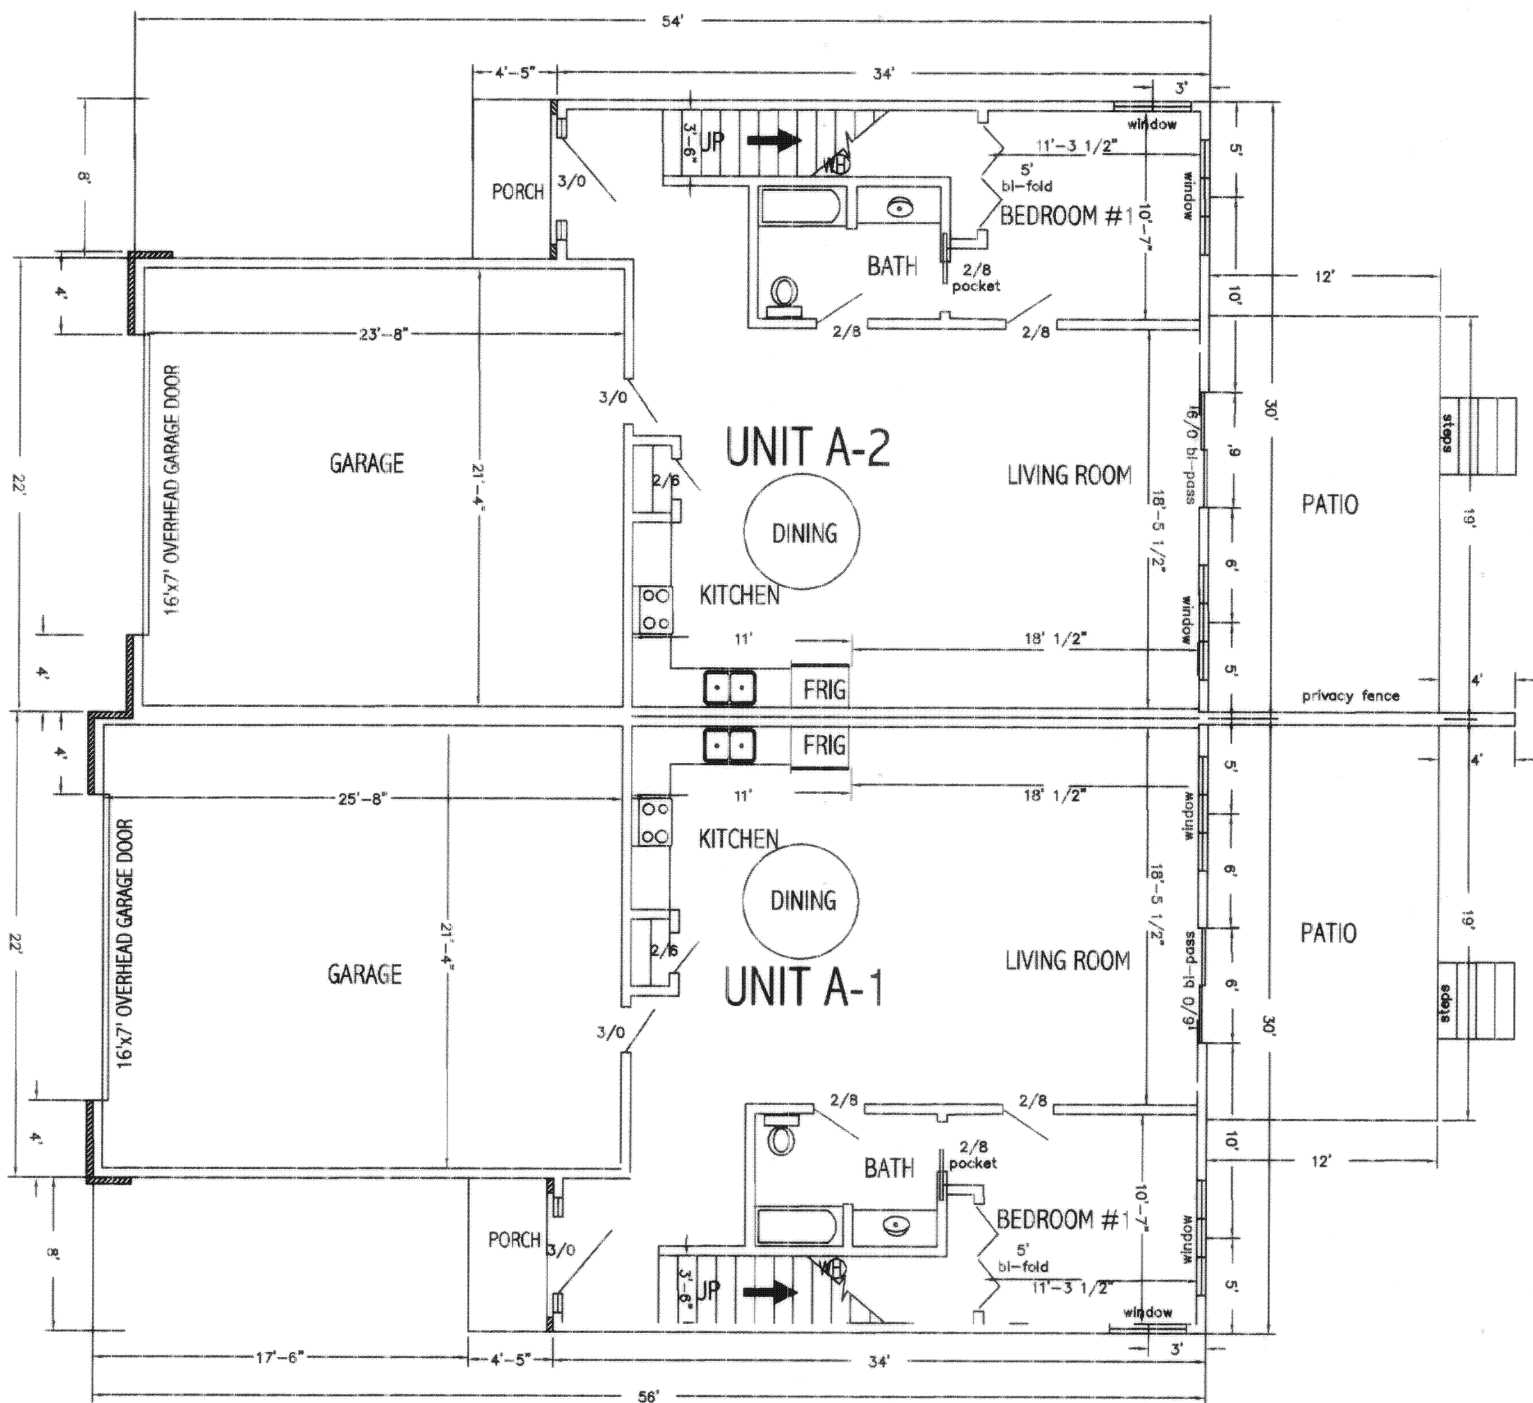

FIRST FLOOR
933 square ft. living space

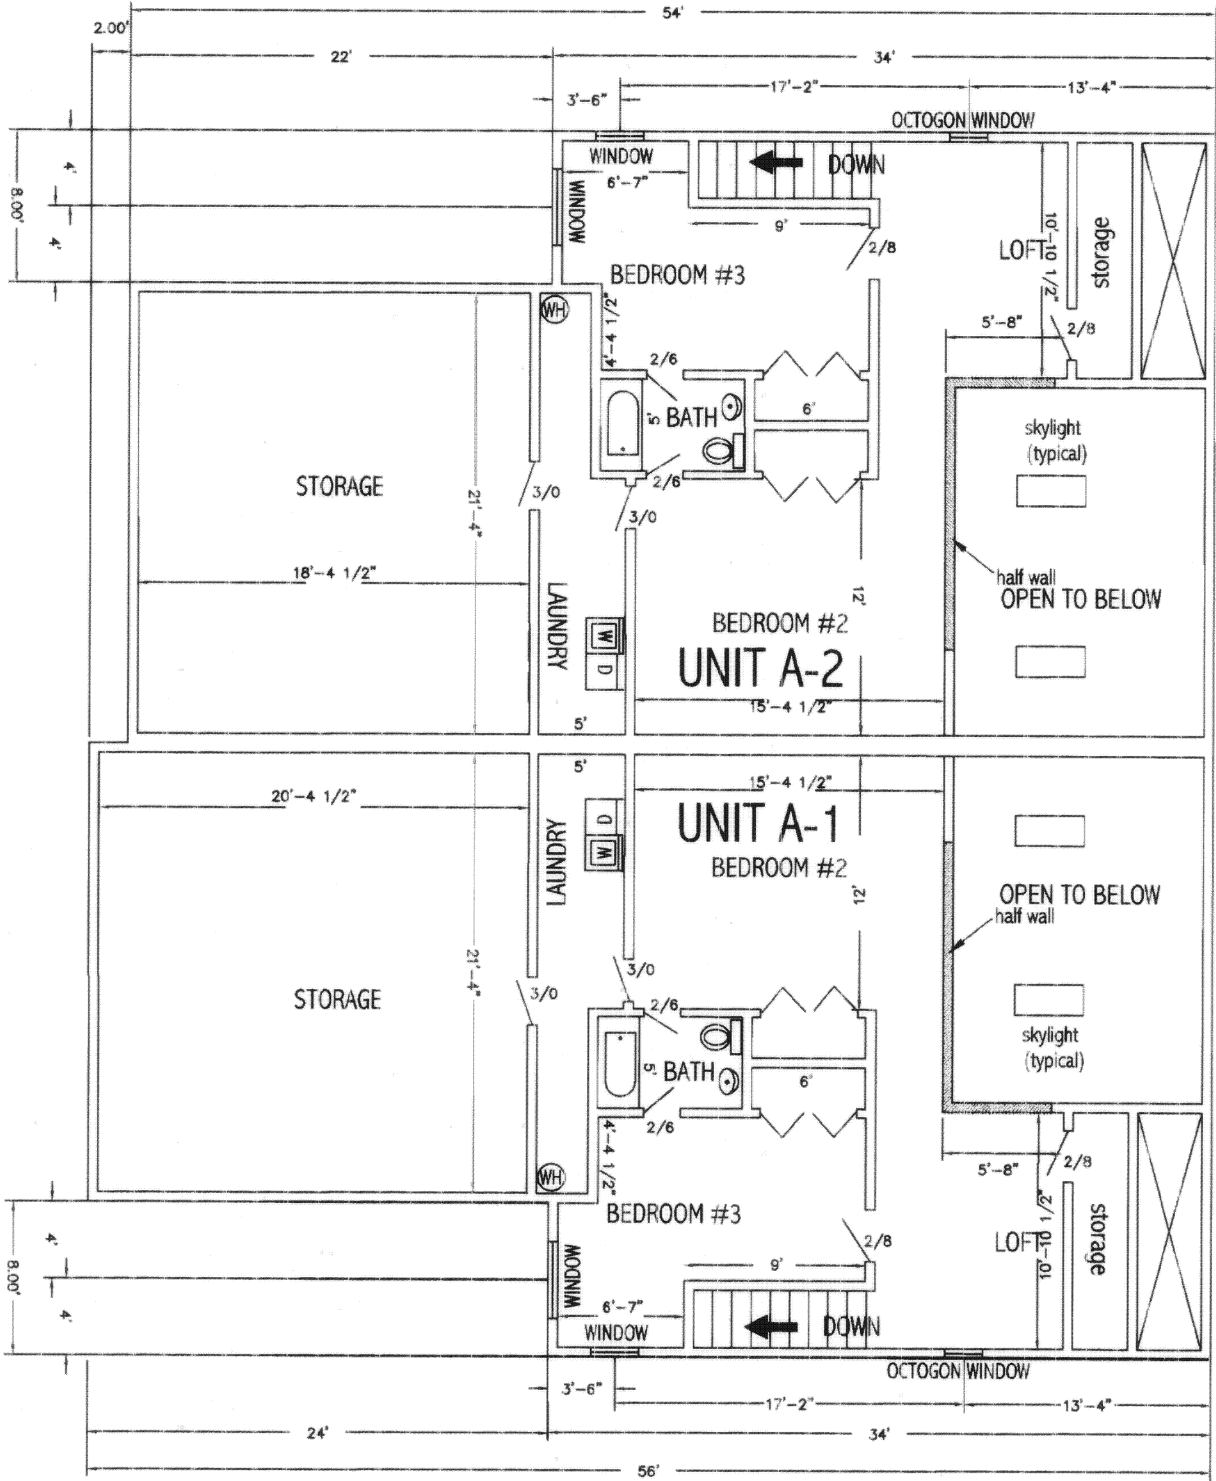

SECOND FLOOR
785 square ft. living space

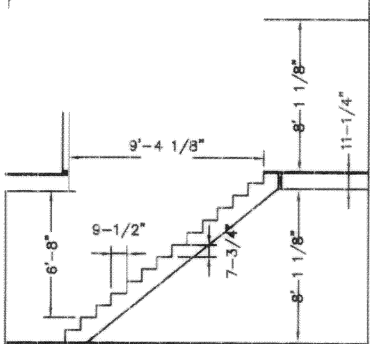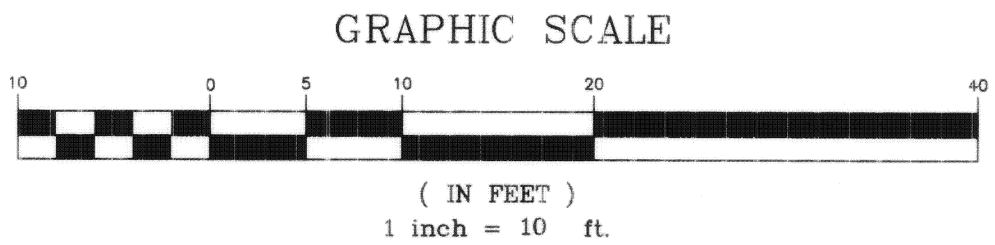

kent surveying, inc.
acad - Marsh Pointe Condos
drawing # 4572
June 15, 2005
revised December 6, 2005