

PARK PLACE CONDOMINIUM No. 6


BEING LOT NO. 39 OF PARK PLACE SUBDIVISION, PHASE FOUR, AS
REPLATTED, IN VILLAGE OF MINSTER, AUGLAIZE COUNTY, OHIO

TRANSFERRED AND NUMBERED THIS 4 DAY OF April, 2006.

AUGLAIZE COUNTY AUDITOR # 2334

FILED THIS 4 DAY OF April, 2006, AT 3:54 O'CLOCK P.M.
RECORDED THIS 4 DAY OF April, 2006
PLAT CABINET D, SLIDE 77.

Don Bellinger
AUGLAIZE COUNTY RECORDER

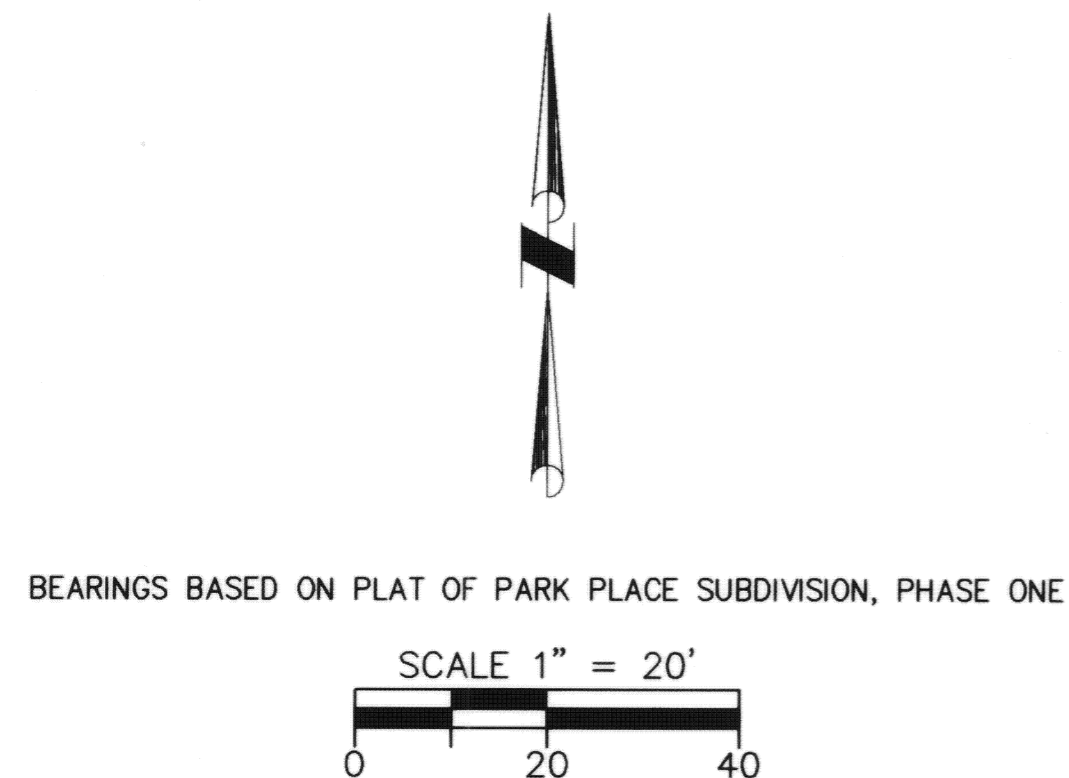

LEGEND

- 5/8"x 30" REBAR W/CAP SET
- IRON PIN FOUND


ENABLING DECLARATION ESTABLISHING A PLAN
FOR CONDOMINIUM OWNERSHIP RECORDED IN
OR VOL. 539, PAGE 285.

BYLAWS OF PARK PLACE CONDOMINIUM ARE RECORDED
IN OR VOL. 539, PAGE 301.

OWNER LOT NO. 39: WEIGANDT LAND CO., LTD., O.R. VOL. 413, PG. 209

PARK PLACE SUBDIVISION, PHASE ONE, RECORDED IN PLAT CAB. C, SLIDE 244

REPLAT OF LOTS 39, 40 AND 41, PARK PLACE SUBDIVISION, PHASE FOUR AND LOT 41
PARK PLACE SUBDIVISION, PHASE THREE, RECORDED IN PLAT CAB. C, SLIDE ____

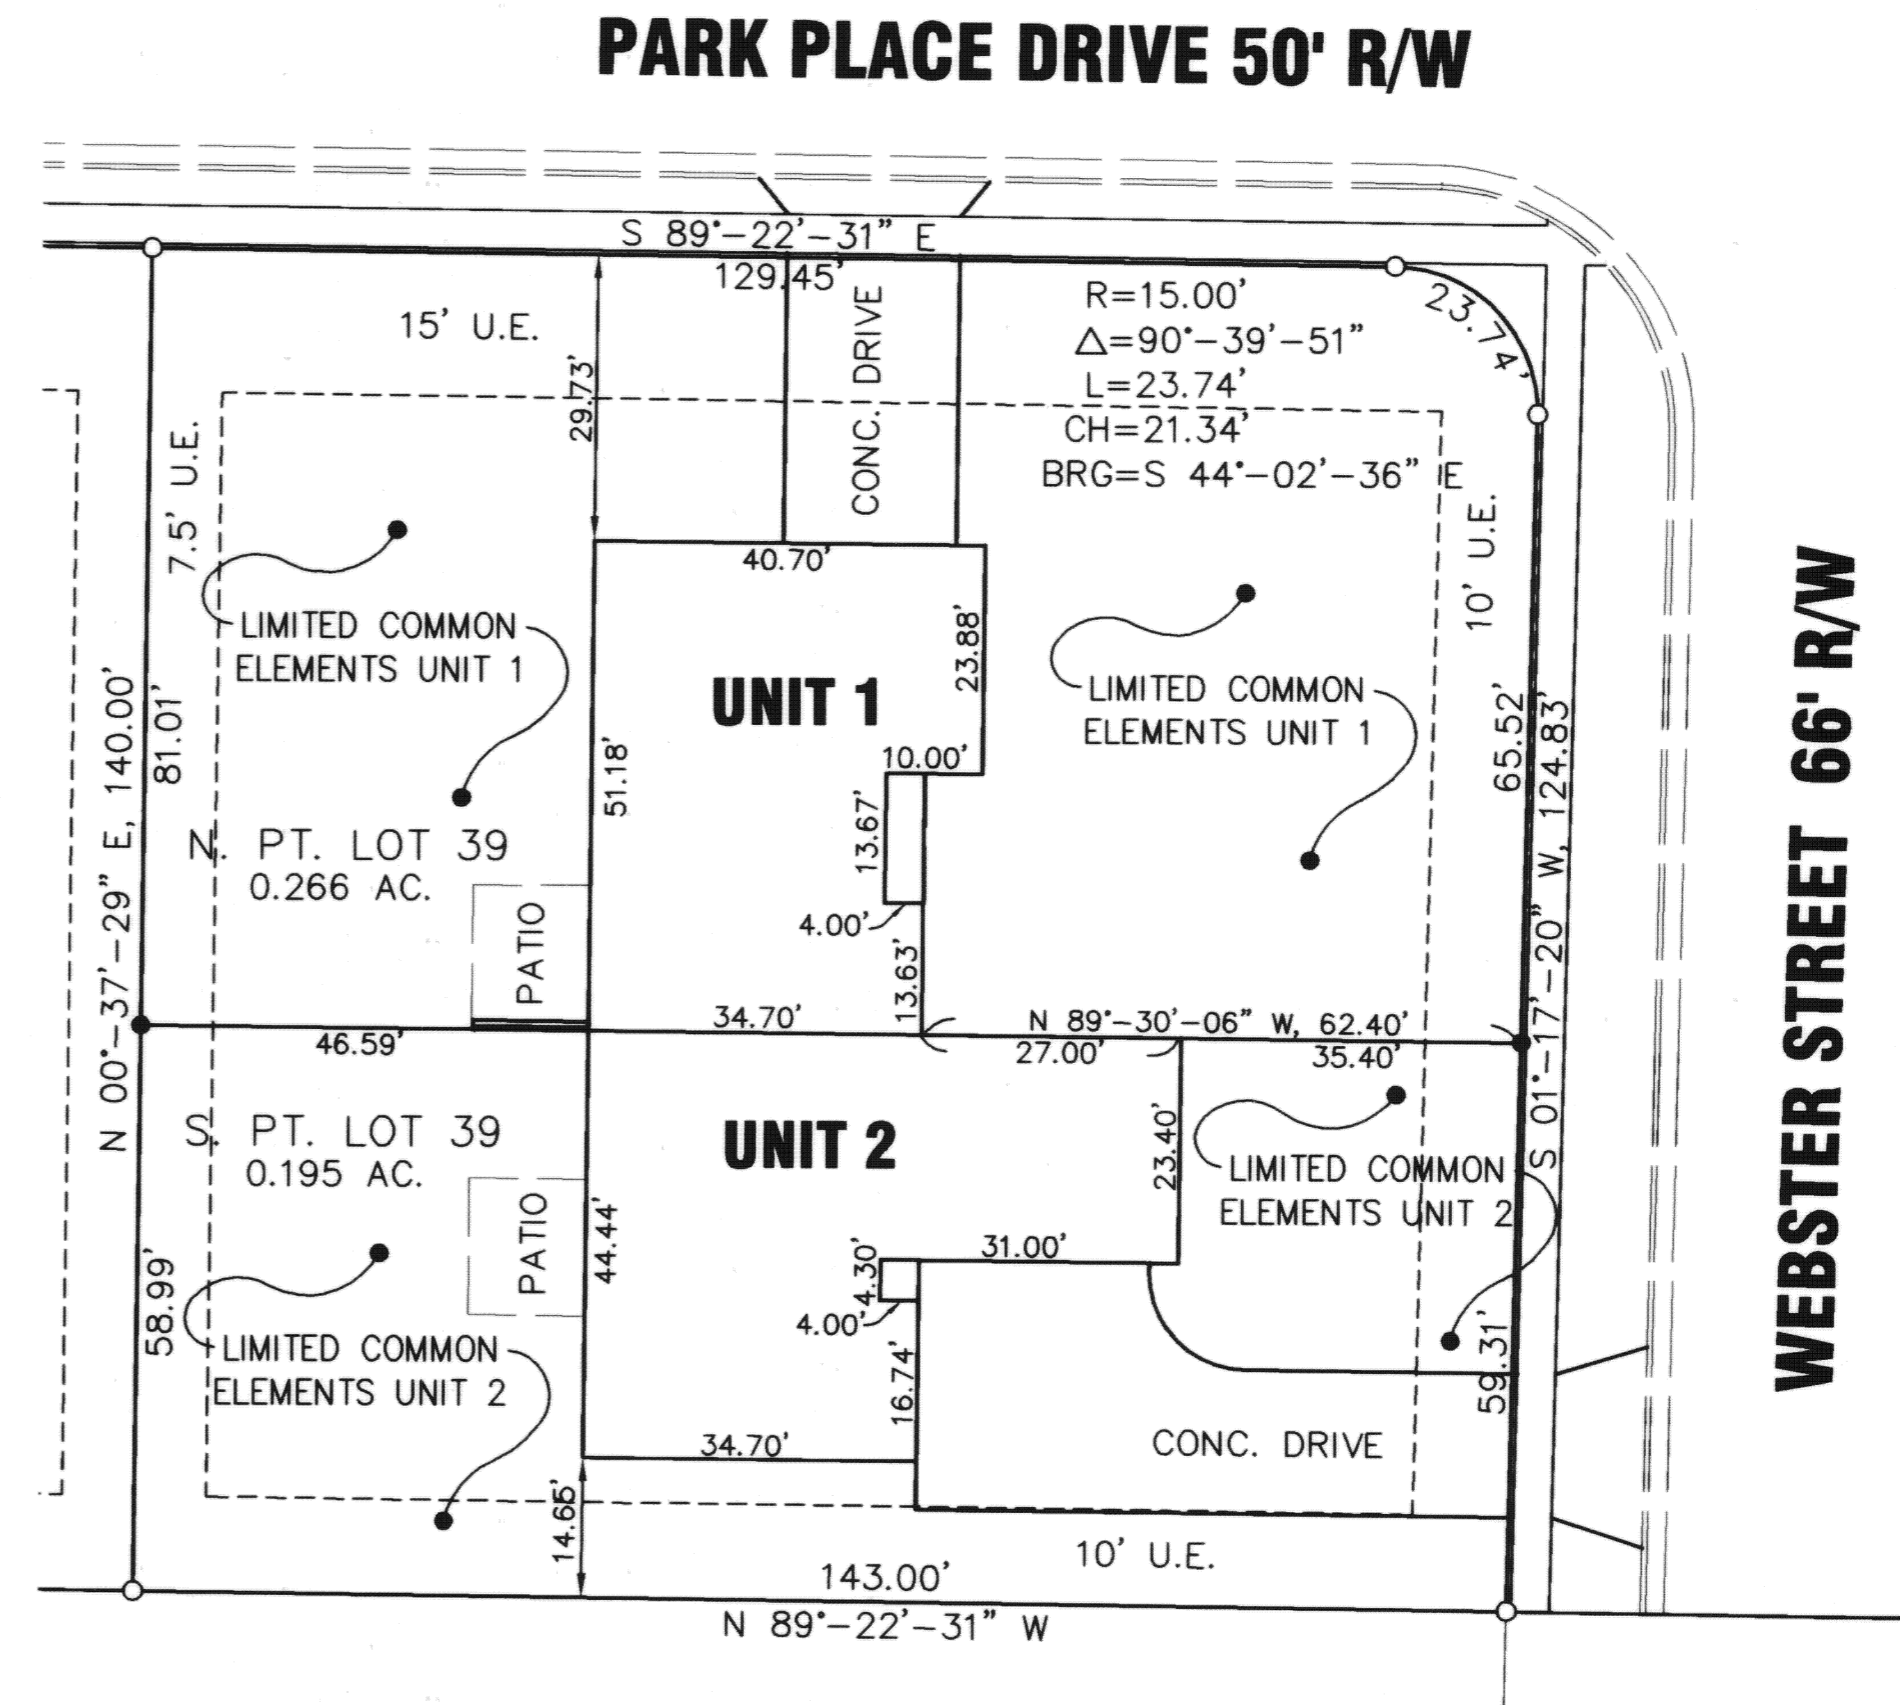


CERTIFICATION

THE DIMENSIONS SHOWN ON THE UNITS ARE FOR
THE FINISHED EXTERIOR AS CONSTRUCTED UPON
LOT 39 AND ARE ACCURATELY SHOWN HEREON.

Jeffrey S. Puthoff
JEFFREY S. PUTHOFF, P.E. #61619

3/17/06
DATE

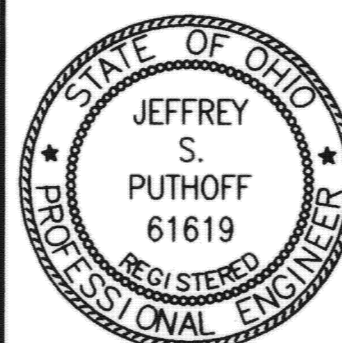


CERTIFICATION

THE DIMENSIONS SHOWN ON THE UNITS ARE FOR
THE FINISHED EXTERIOR AS CONSTRUCTED UPON
LOT 39 AND ARE ACCURATELY SHOWN HEREON.

Steven E. Bowersox
STEVEN E. BOWERSOX, P.S. #7059

3-17-2006
DATE

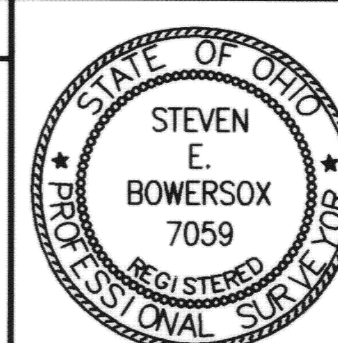

CHOICE ONE ENGINEERING
the choice that exceeds ...

440 E. HOEWISHER ROAD
SIDNEY, OHIO 45365
(937) 497-0200 • FAX (937) 497-0300
www.choiceoneengineering.com

date:
03-17-2006

drawn by:
seb

job number:
AugMin0112