

SEVENTH STREET CONDOMINIUM



BEING TRACT 2 OF THE REPLAT FOR SUBDIVISION OF LOTS 69 THRU 72, BLOCK B,
IN VILLAGE OF MINSTER, AUGLAIZE COUNTY, OHIO

TRANSFERRED AND NUMBERED THIS 18 DAY OF May, 2007.


Janet Schuler JK
AUGLAIZE COUNTY AUDITOR

FILED THIS 18 DAY OF May, 2007 AT 11:25 O'CLOCK A.M.
RECORDED THIS 18 DAY OF May, 2007
PLAT CABINET D, SLIDE 138-142

Ann Bellinger
AUGLAIZE COUNTY RECORDER

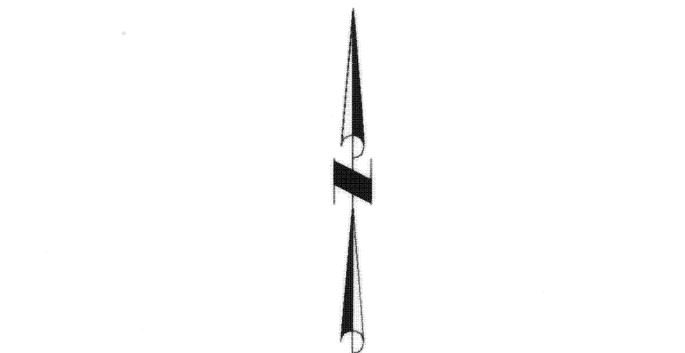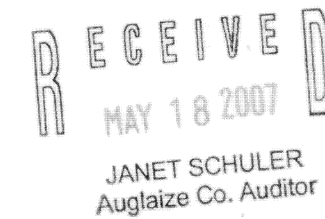

BEARINGS BASED ON AN ASSUMED MERIDIAN

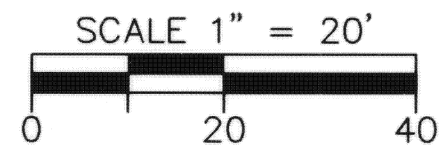

LEGEND

- 5/8"x 30" REBAR W/CAP SET
- IRON PIN FOUND


ENABLING DECLARATION ESTABLISHING A PLAN
FOR CONDOMINIUM OWNERSHIP RECORDED IN
RS VOL. 554, PAGE 1078.

BYLAWS OF SEVENTH STREET CONDOMINIUM ARE RECORDED
IN RS VOL. 554, PAGE 1092.

OWNER TRACT 2: WEIGANDT LAND CO., LTD., O.R. VOL. 536, PG. 624

REPLAT FOR THE SUBDIVISION OF LOTS 69 THRU 72, BLOCK B
AS RECORDED IN PLAT CAB. C, SLIDE 330

LINCOLN STREET

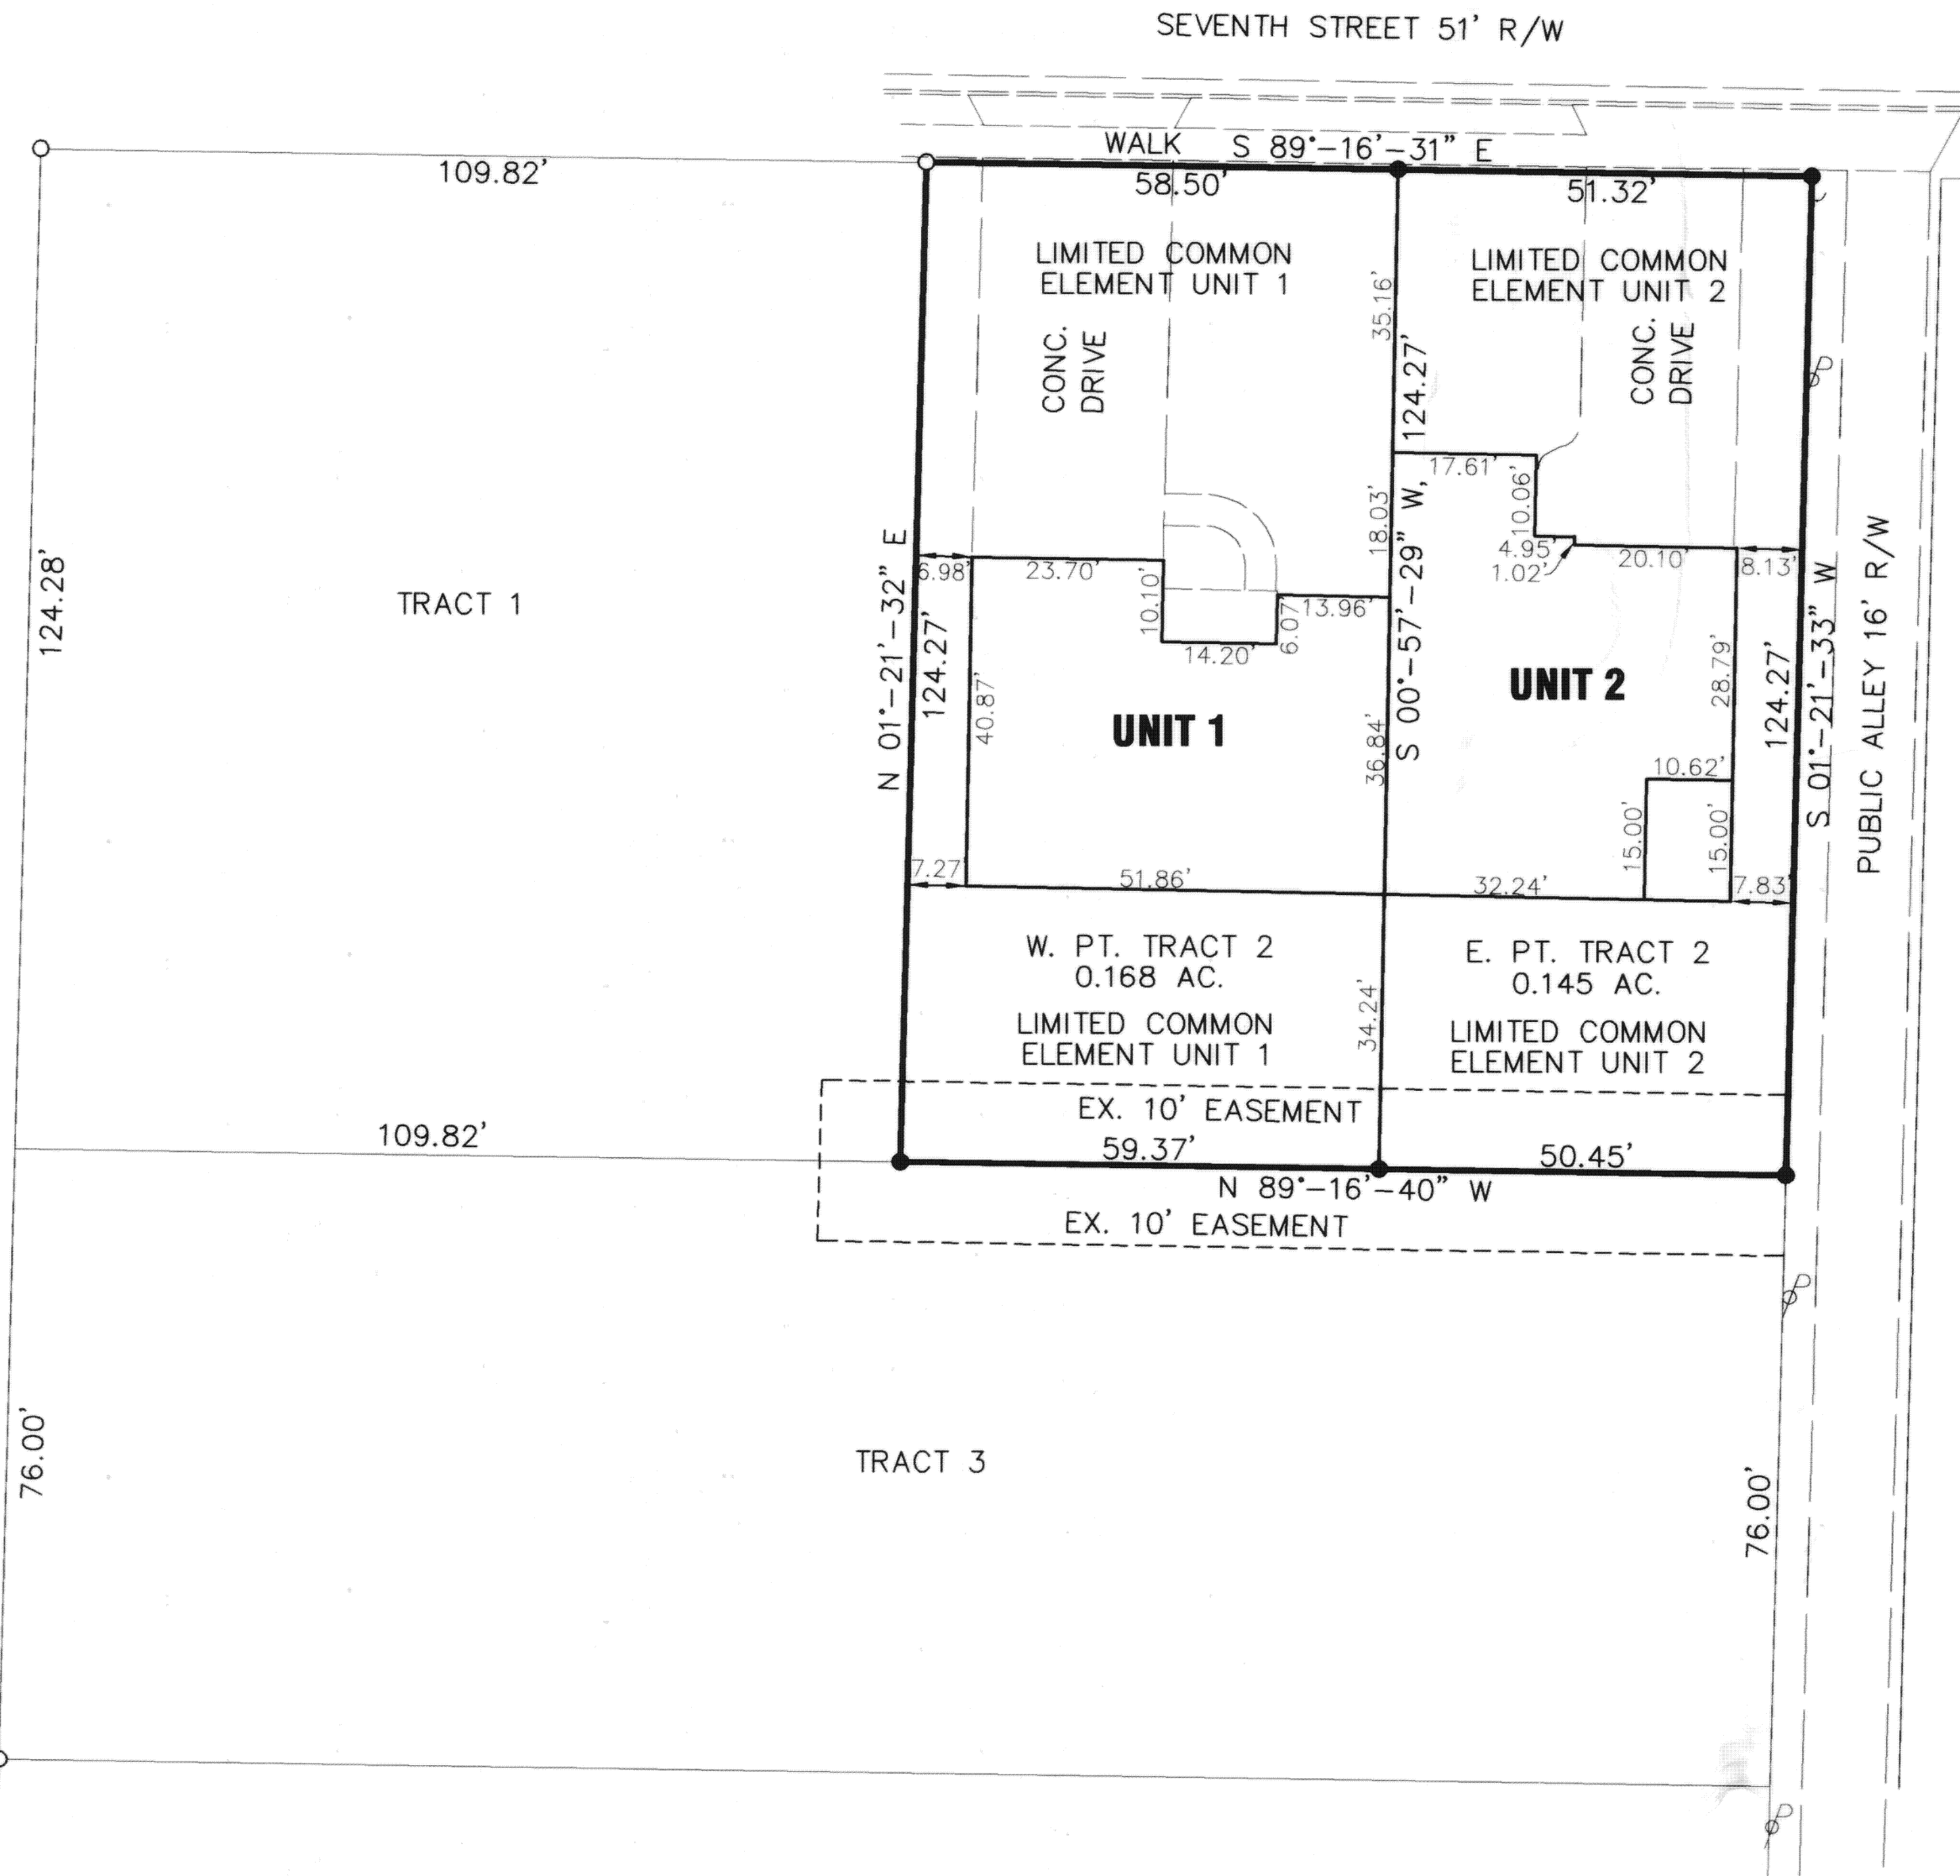


CERTIFICATION

THE DIMENSIONS SHOWN ON THE UNITS ARE FOR
THE FINISHED EXTERIOR AS CONSTRUCTED UPON
TRACT 2 AND ARE ACCURATELY SHOWN HEREON.
AND SHEETS 1, 2, 3 & 4

Jeffrey S. Puthoff
JEFFREY S. PUTHOFF, P.E. #61619

DATE

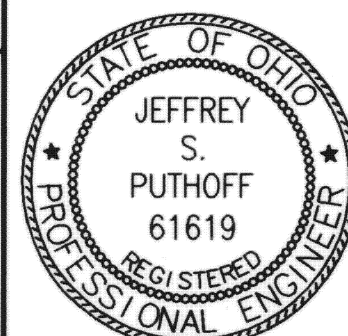


CERTIFICATION

THE DIMENSIONS SHOWN ON THE UNITS ARE FOR
THE FINISHED EXTERIOR AS CONSTRUCTED UPON
TRACT 2 AND ARE ACCURATELY SHOWN HEREON.
AND SHEETS 1, 2, 3 & 4

Steven E. Bowersox
STEVEN E. BOWERSOX, P.S. #7059


DATE

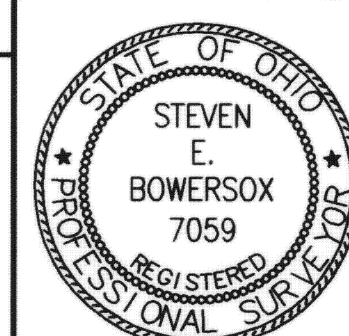

CHOICE **ONE**
ENGINEERING

440 E. HOEWISHER ROAD, SIDNEY, OHIO 45365
(937) 497-0200 FAX (937) 497-0300
www.choiceoneengineering.com

DATE:
04-20-2007
DRAWN BY:
seb
JOB NUMBER:
AUGMIN0703
SHEET NUMBER
1 OF 1

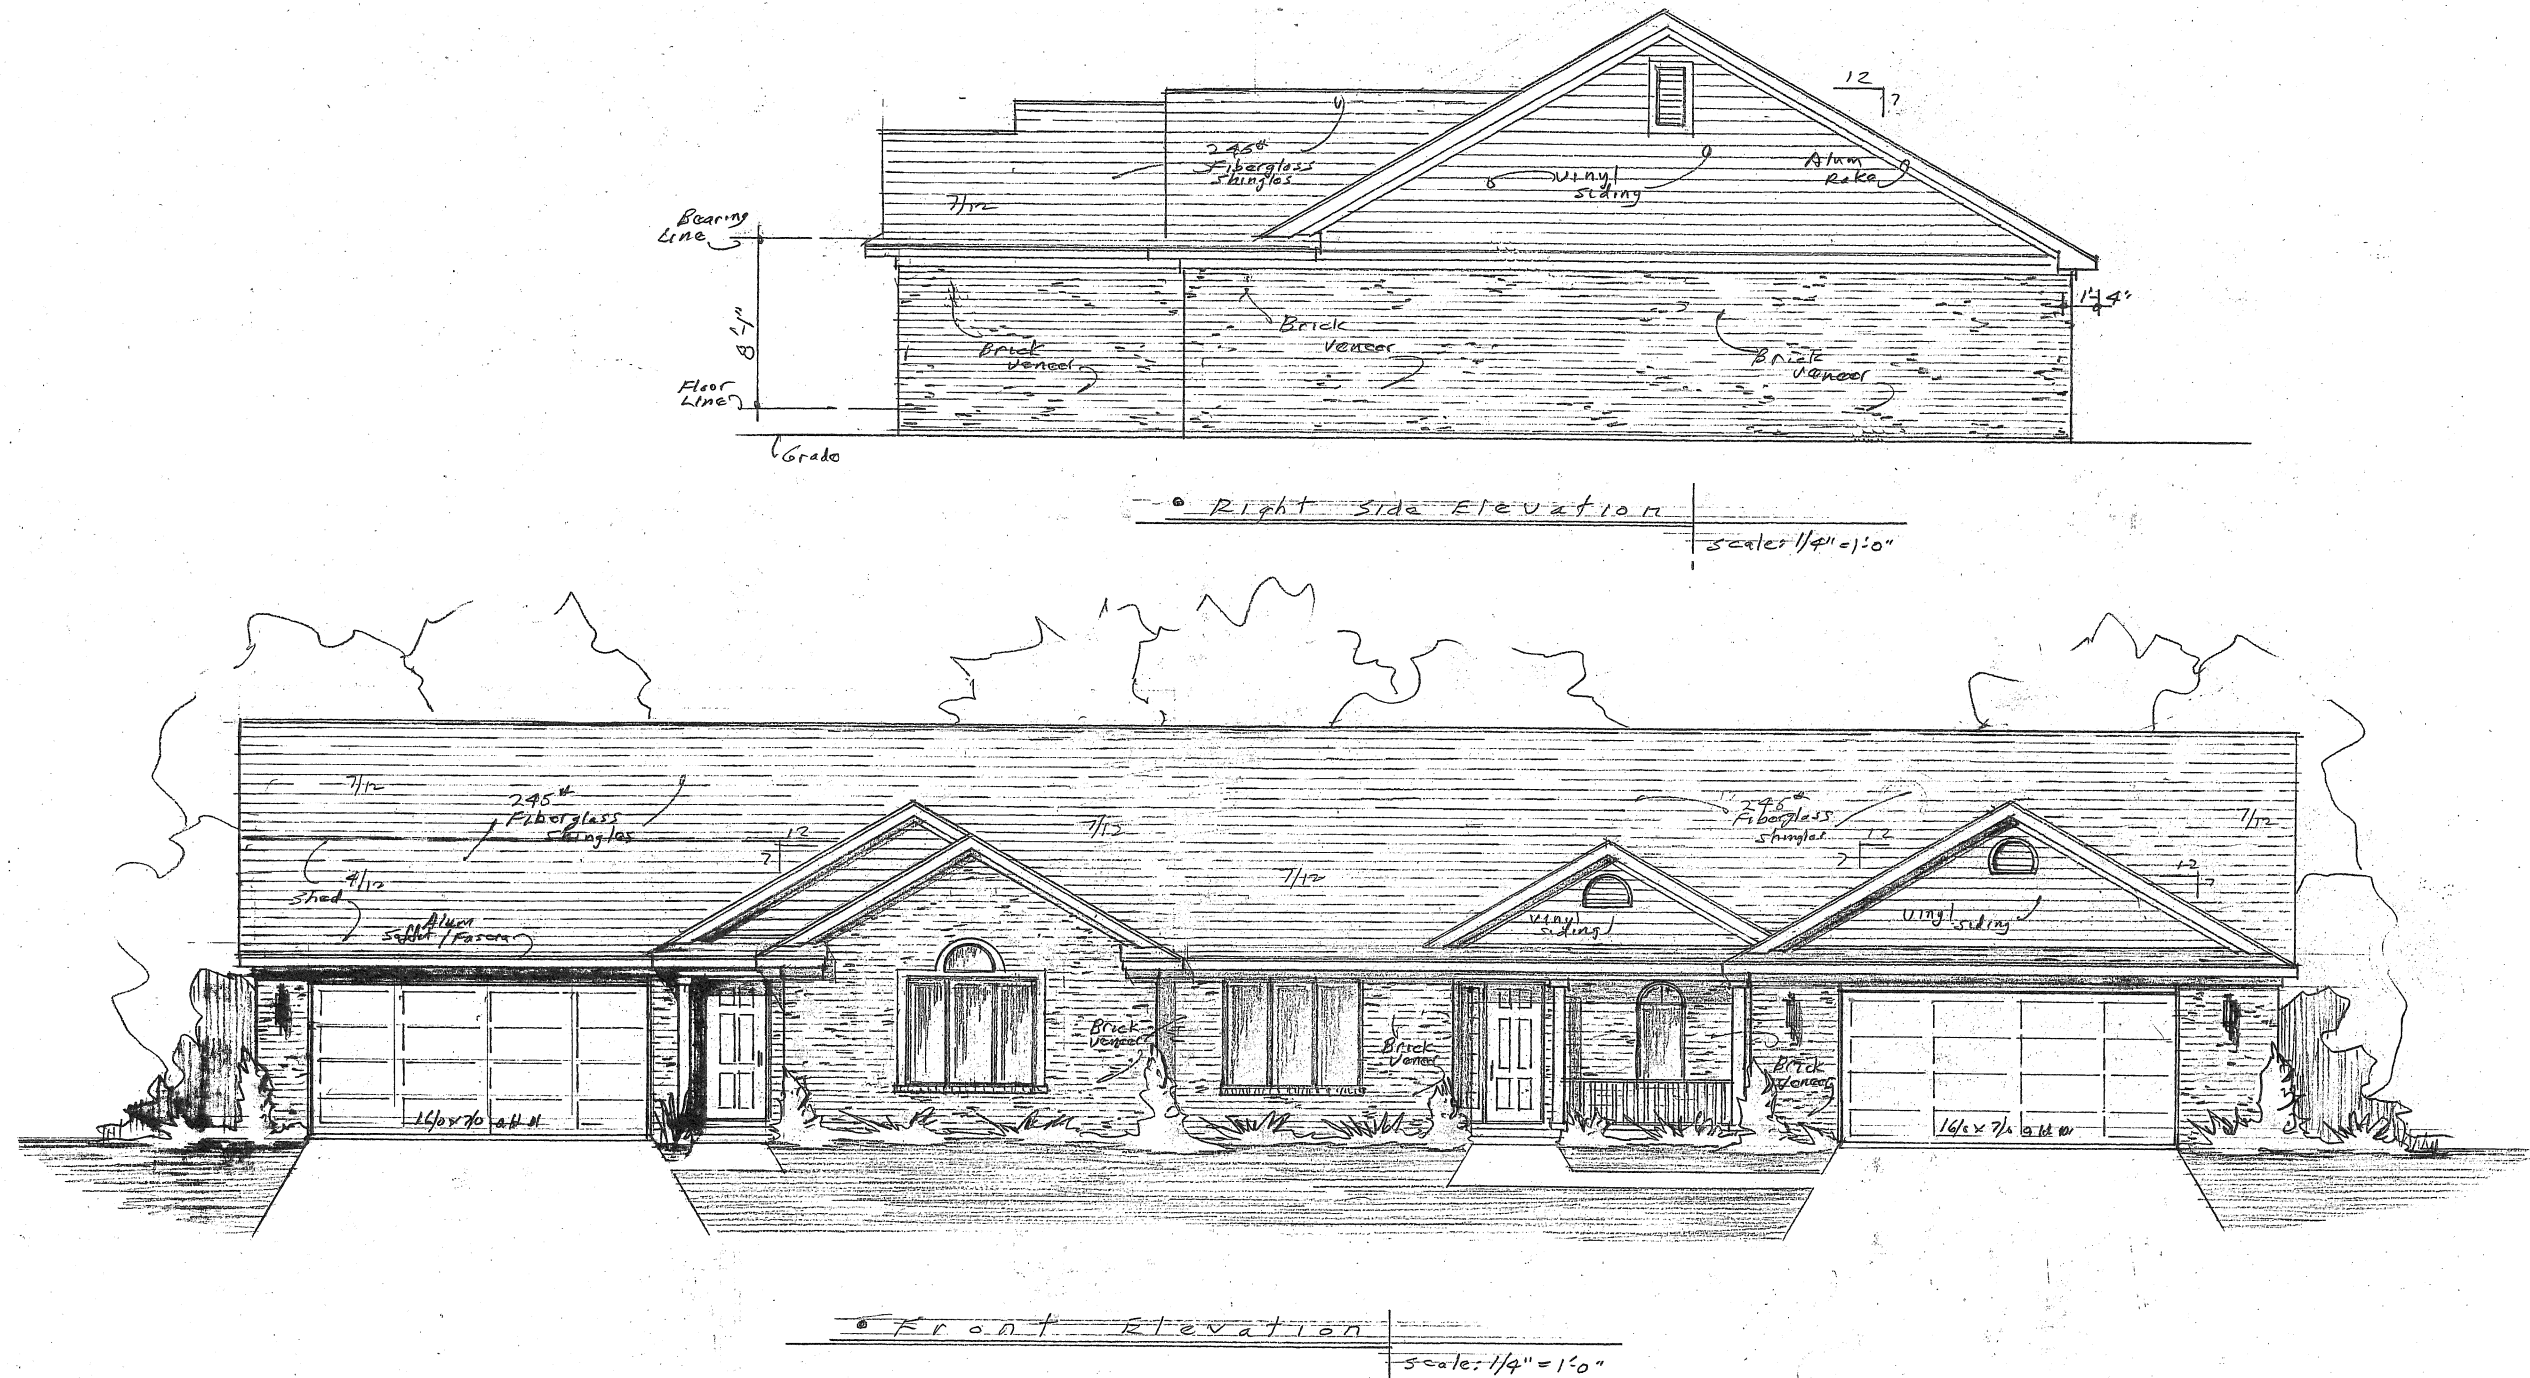


Property of
Dave & Linda
Kuhn Design Group

Design
By: L. Kuhn
Celina Oh. 419-586-8861


BARRHURST 2
WEIGANDT CONST.

Scale: 1/4" = 1'-0"
Drawn: D.L.K.
Date: July 1998

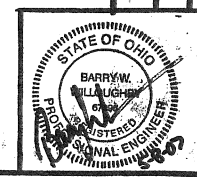


BARRHURST/F06T 7th St.

Sheet
1 of 4

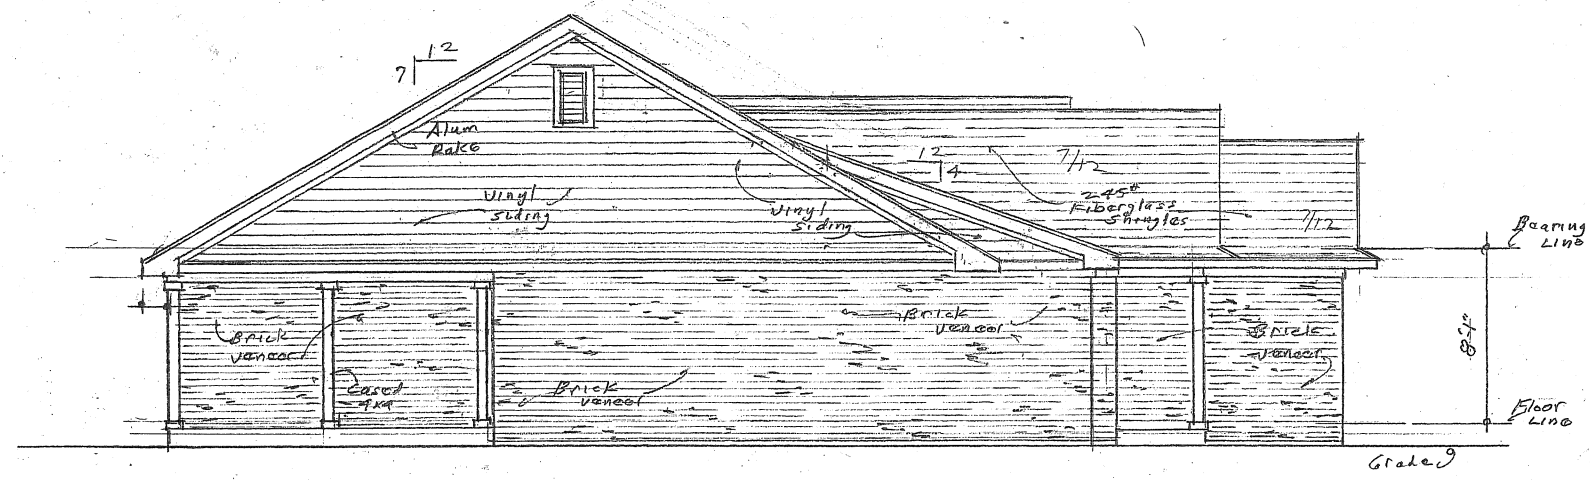

Left side Elevation
Scale: 1/4"=1'-0"

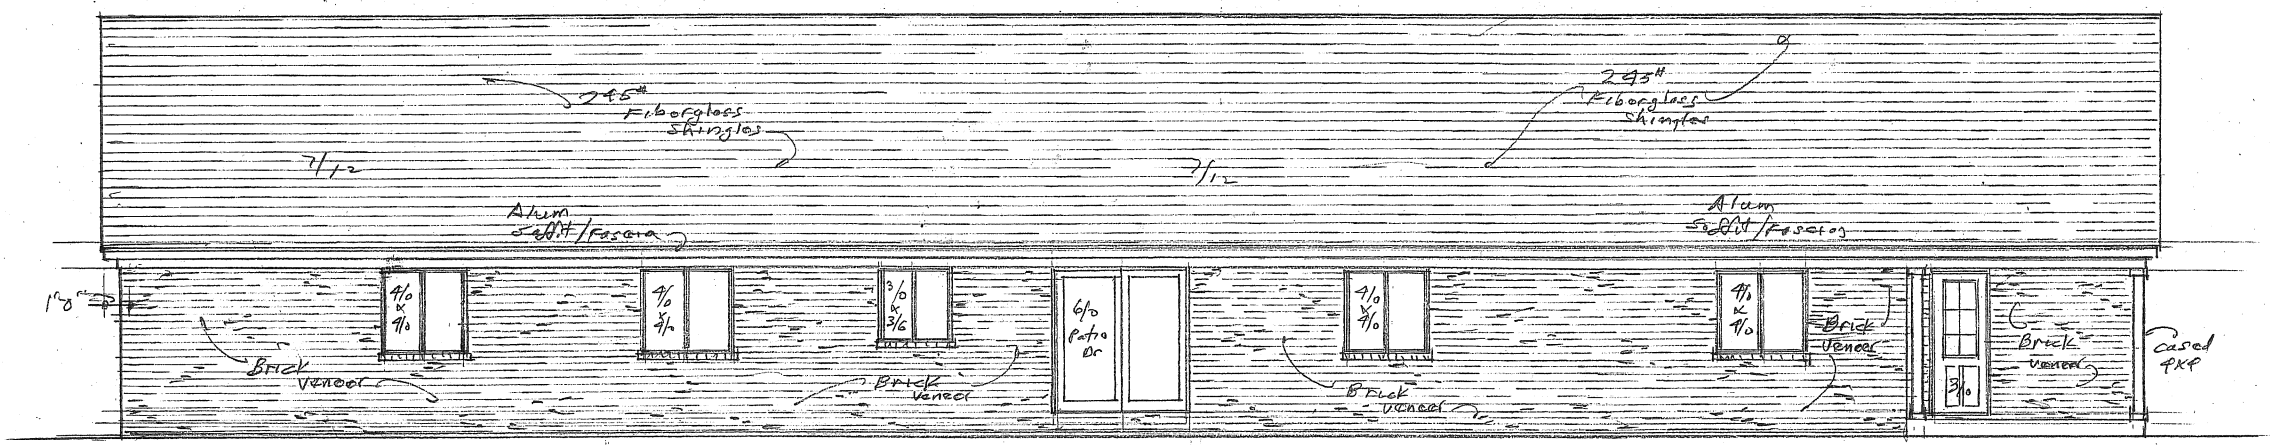

Rear Elevation
Scale: 1/4"=1'-0"

Property of
Dave & L. Kuhn

KUHN DESIGN GROUP

Sheet

2

of

4

Design

Dave L. Kuhn

Celina Oh. 419-586-8861


BARHORST 2


WEIGANDT CONST.

Scale: 1/4"=1'-0"

Drawn: D.L.K.

Date: July, 06

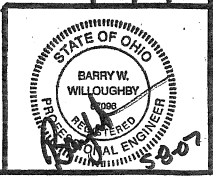

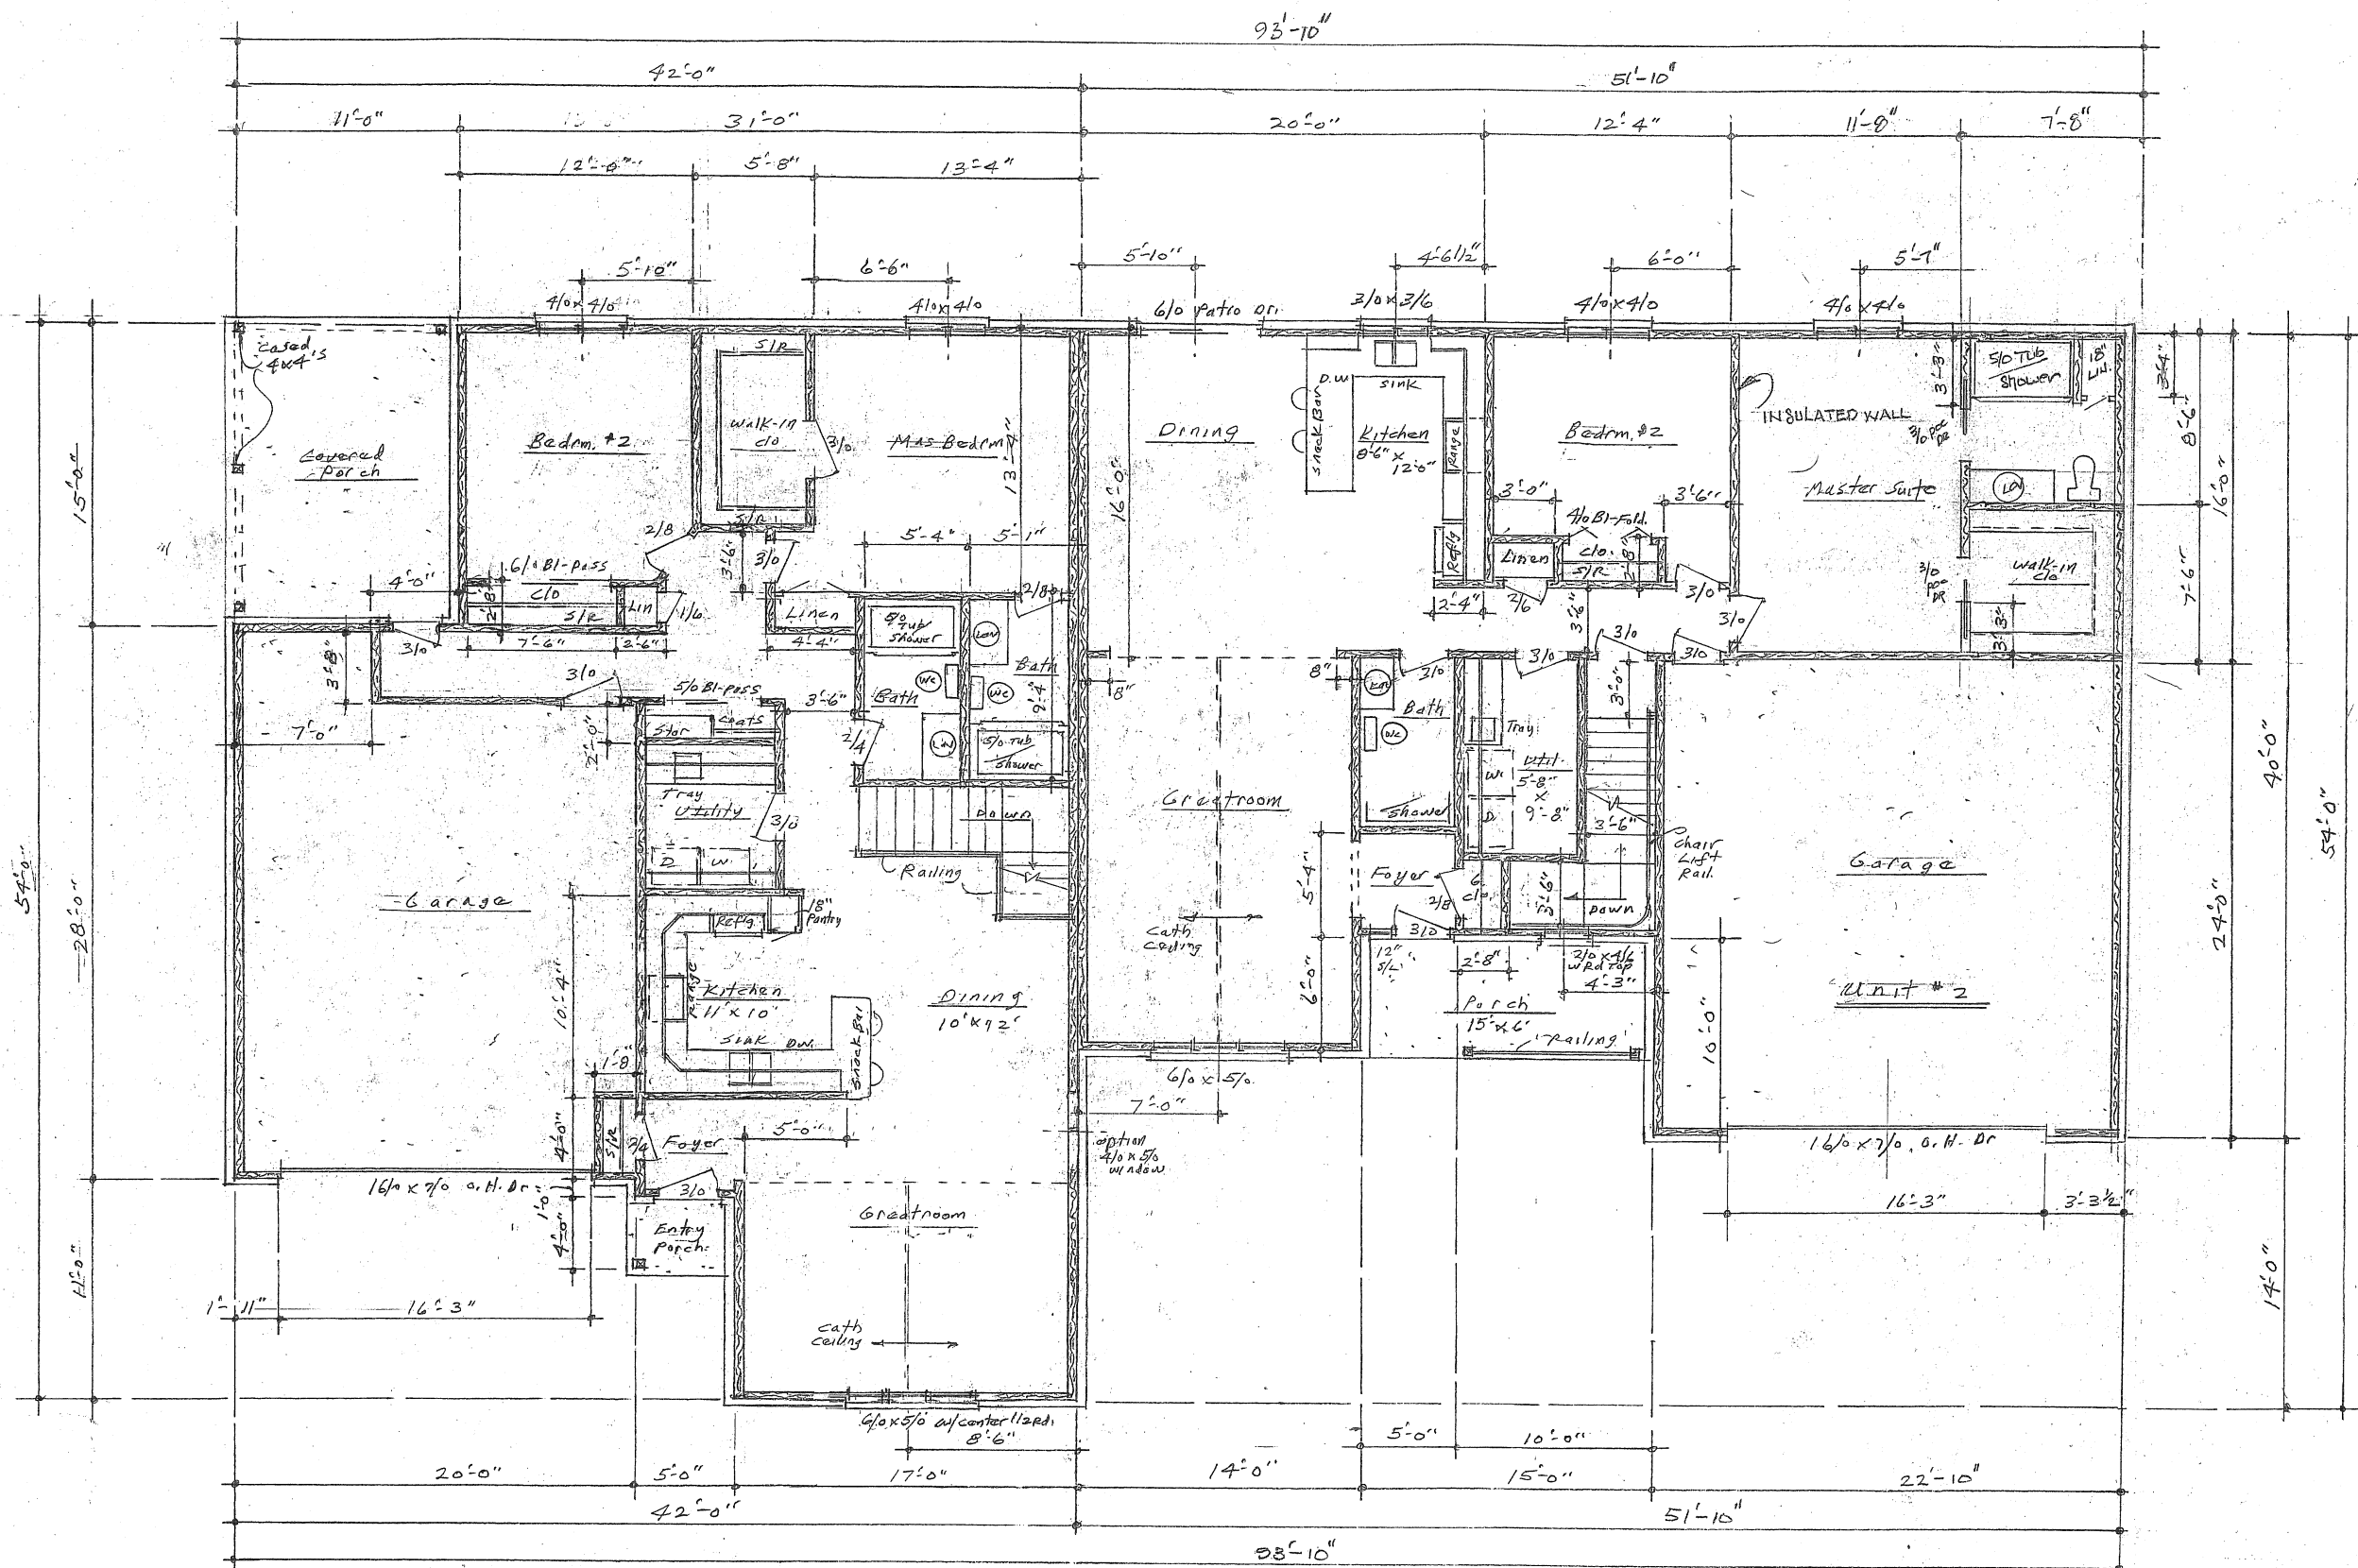

Floor Plan

Scale: 1/4" = 1'-0"
 1216 Unit #1 SQ. FT.
 1268 Unit #2 SQ. FT.


KUHN DESIGN GROUP
 Property of
 Dave & L. Kuhn

Sheet
 3 of 4

Design
 Dave L. Kuhn
 Celina Oh. 419-586-8861

BARHORST 2
 WELGANDT CONST.

Scale: 1/4" = 1'-0"
 Drawn: DLK
 Date: July '02

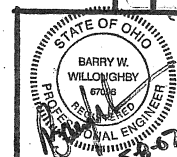

EE

