

AMSTERDAM CONDOMINIUM No. 1

BEING LOT NUMBER 35 OF DEERFIELD RUN SUBDIVISION – PHASE 5
IN VILLAGE OF NEW BREMEN, AUGLAIZE COUNTY, OHIO

TRANSFERRED AND NUMBERED THIS 20 DAY OF June, 2007

JANET SCHULER
AUGLAIZE COUNTY AUDITOR


FILED THIS 20 DAY OF June, 2007, AT 10:37 O'CLOCK A.M.
RECORDED THIS 20 DAY OF June, 2007.
PLAT CABINET D, SLIDE 145-148

ANN BILLINGS
AUGLAIZE COUNTY RECORDER
200700004094
Filed for Record in
AUGLAIZE COUNTY, OHIO
06-20-2007 At 10:37 am.
PLAT 172.80

RECEIVED
JUN 20 2007
JANET SCHULER
Auglaize Co. Auditor



BEARINGS BASED ON DEERFIELD RUN SUBD.
PHASE 5, PLAT CAB. D, SLIDE 20

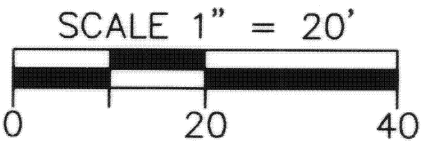

LEGEND


- 5/8"x 30" REBAR W/CAP SET
- IRON PIN FOUND

ENABLING DECLARATION ESTABLISHING A PLAN
FOR CONDOMINIUM OWNERSHIP RECORDED IN
___ VOL. ORSSS, PAGE 1824.

BYLAWS OF AMSTERDAM CONDOMINIUM ARE RECORDED
IN ___ VOL. ORSSS, PAGE 1839.

OWNER LOT 35: WEIGANDT LAND CO., LTD., O.R. VOL. 530, PG. 2080

DEERFIELD RUN SUBDIVISION – PHASE 5
AS RECORDED IN PLAT CAB. D, SLIDE 20

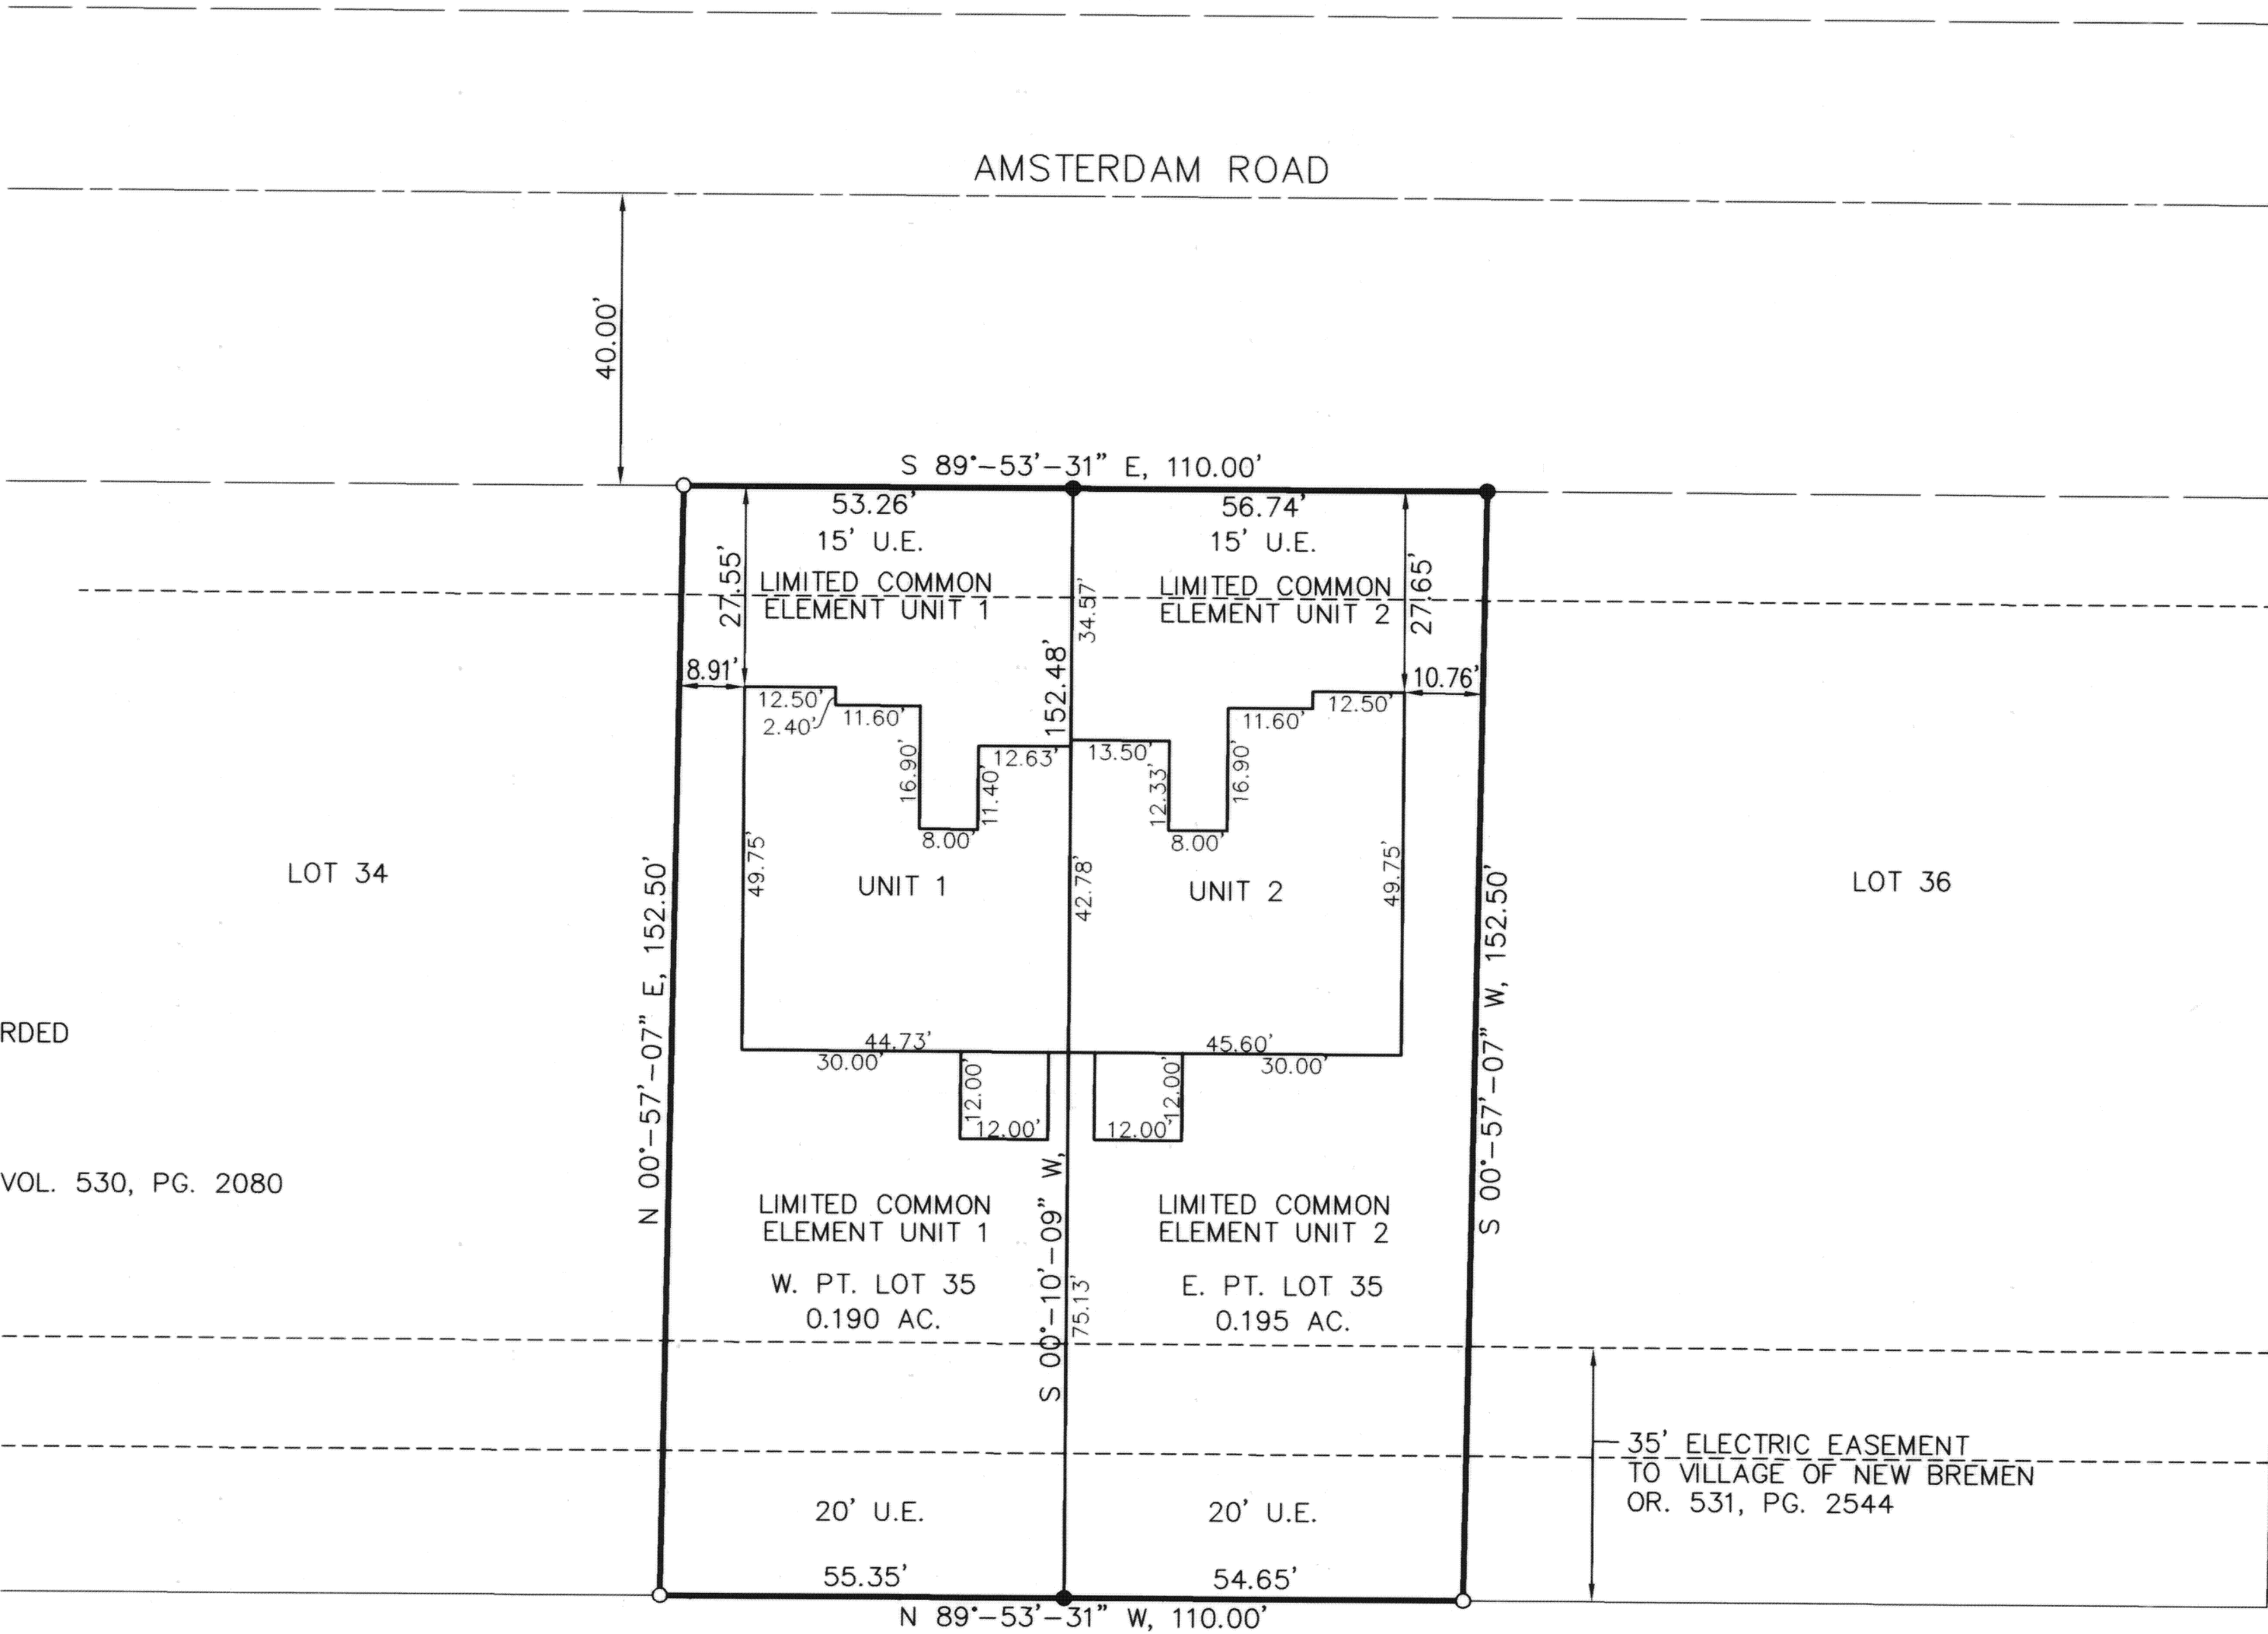


35' ELECTRIC EASEMENT
TO VILLAGE OF NEW BREMEN
OR. 531, PG. 2544

CERTIFICATION

THE DIMENSIONS SHOWN ON THE UNITS ARE FOR
THE FINISHED EXTERIOR AS CONSTRUCTED UPON
LOT 35 AND ARE ACCURATELY SHOWN HEREON.
and sheets 1, 3, 4

JEFFREY S. PUTHOFF, P.E. #61619

6/5/07
DATE

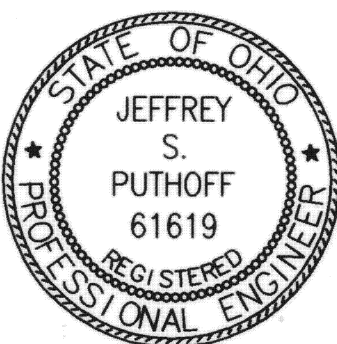


CERTIFICATION

THE DIMENSIONS SHOWN ON THE UNITS ARE FOR
THE FINISHED EXTERIOR AS CONSTRUCTED UPON
LOT 35 AND ARE ACCURATELY SHOWN HEREON.
and sheets 1, 3, 4

STEVEN E. BOWERSOX, P.S. #7059

6/05/2007
DATE

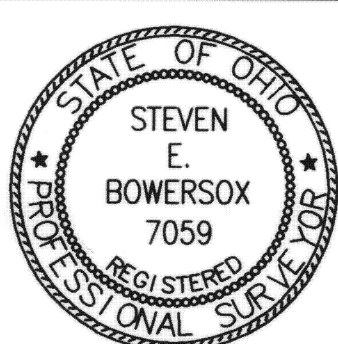


CHOICE ONE
ENGINEERING

440 E. HOEWISHER ROAD, SIDNEY, OHIO 45365
(937) 497-0200 FAX (937) 497-0300
www.choiceoneengineering.com

DATE:
06-05-2007
DRAWN BY:
seb
JOB NUMBER:
AUGMIN0112
SHEET NUMBER

1 OF 1

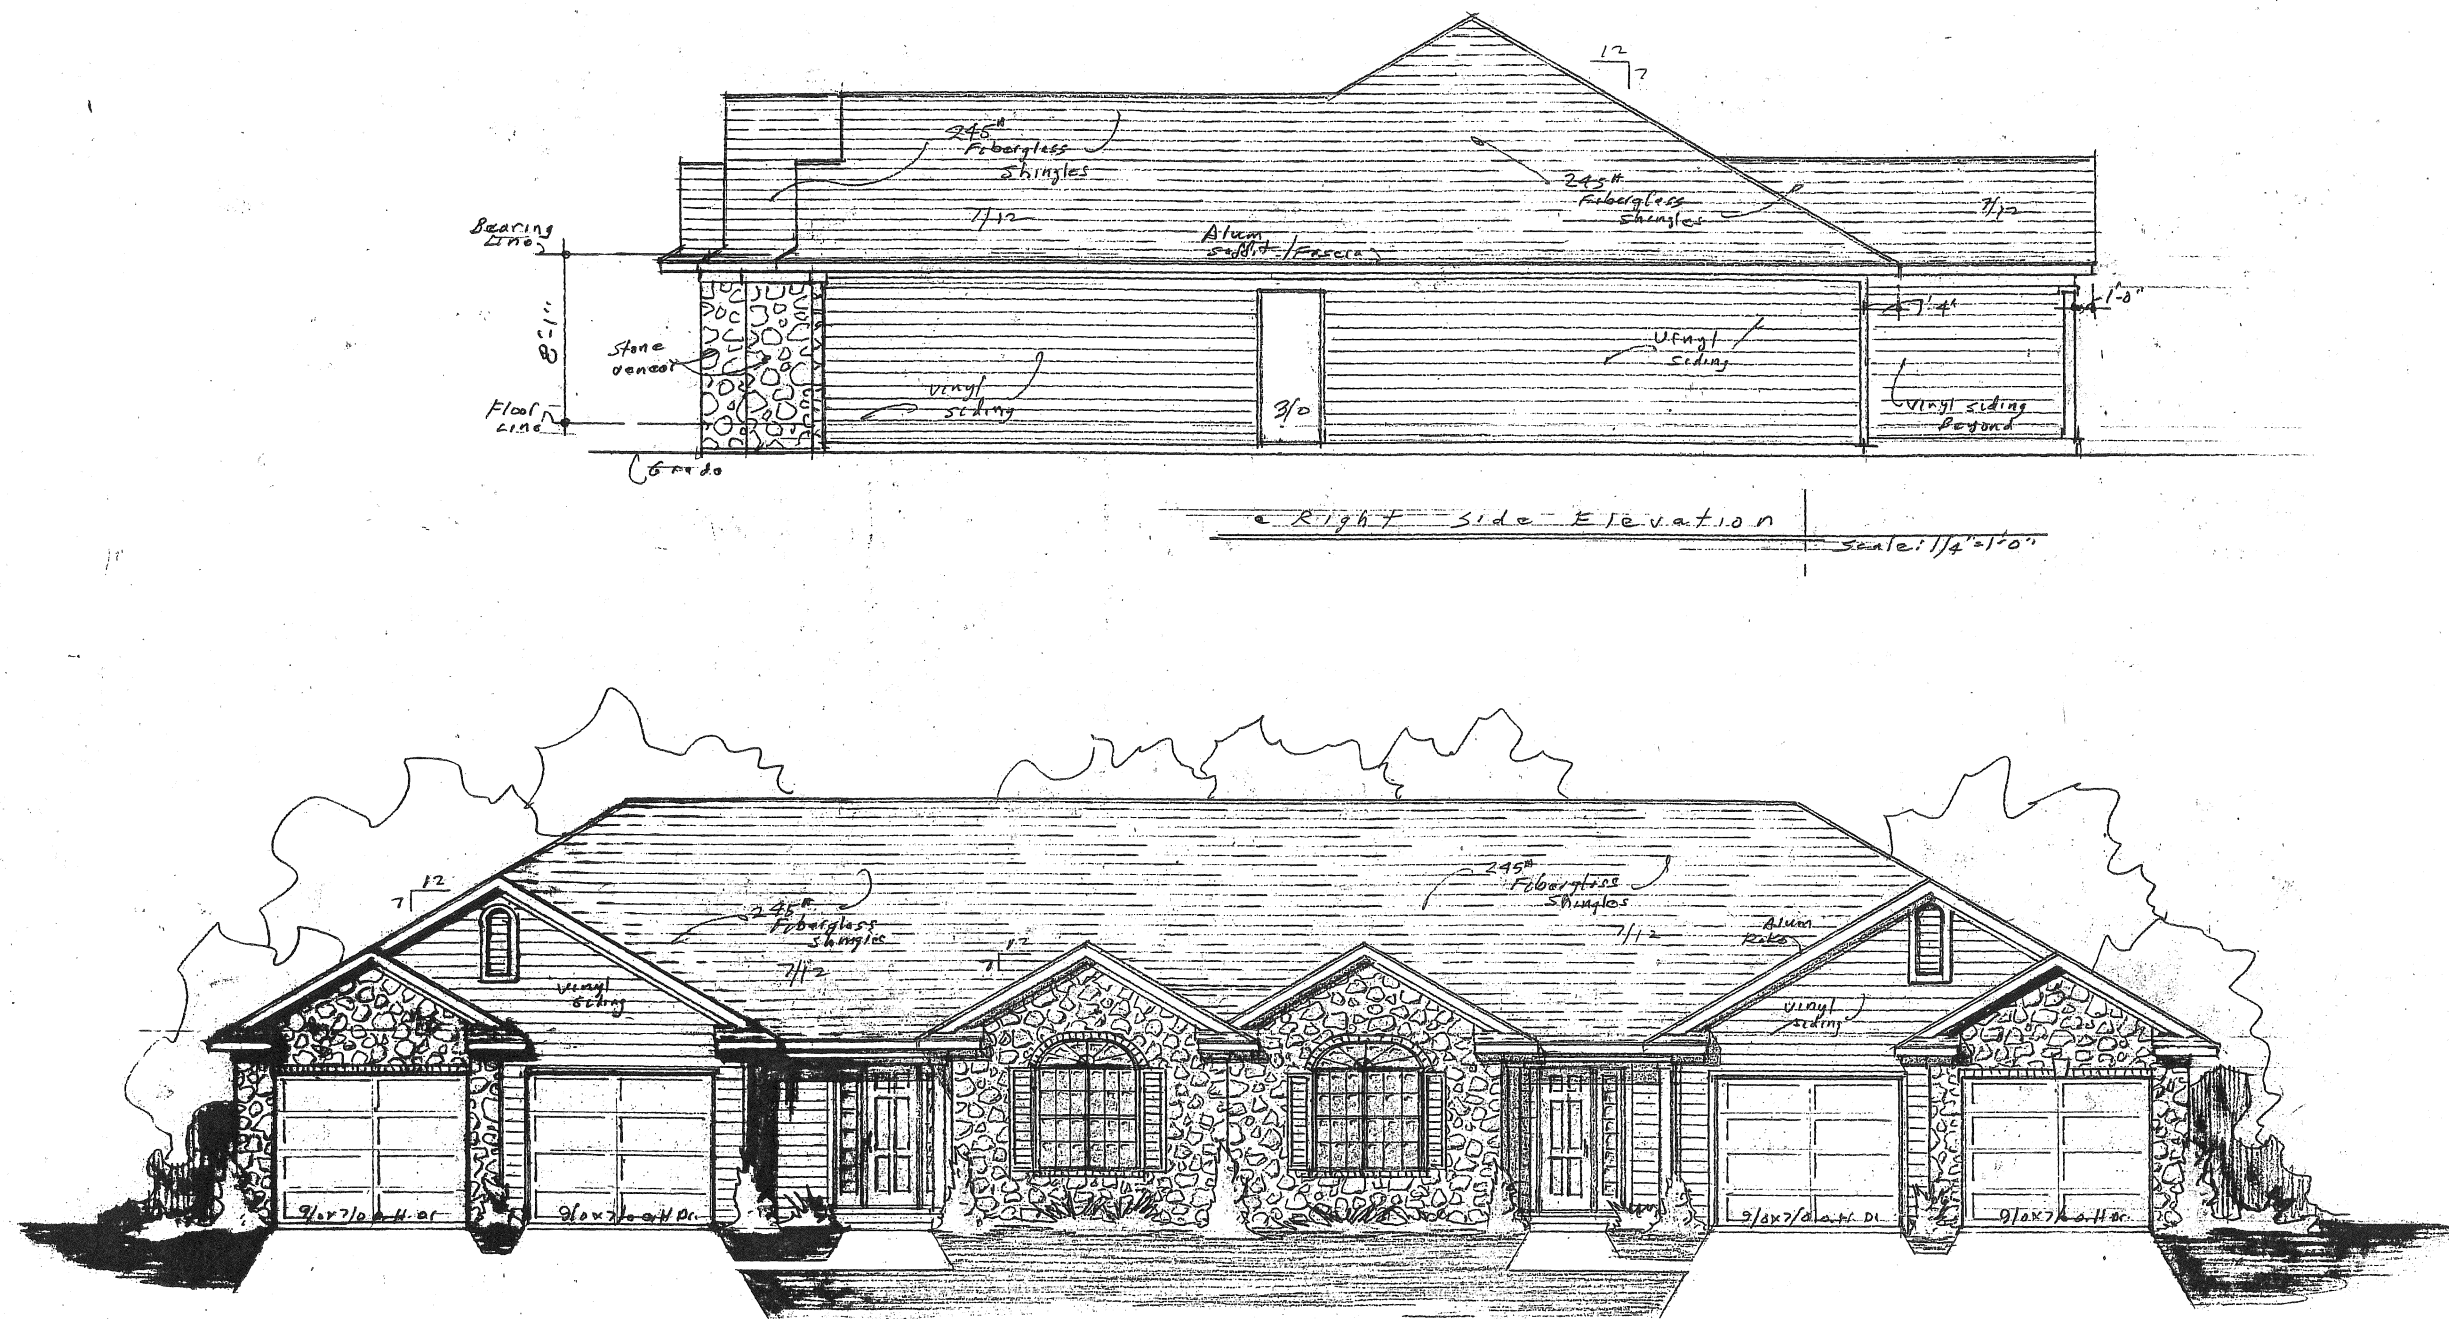

Property of
Dave L. Kuhn


KUHN DESIGN GROUP

Design
Dave L. Kuhn
Cajina Oh. 419-586-8861

Rev. 2/16/06

AMSTERDAM "GREYER UNIT"
WEIGANDT CONST.

Scale: 1/4" = 1'-0"
Drawn: D.L.K.
Date: Dec. 05


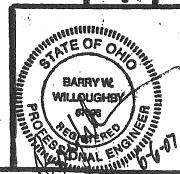


Property of
Dave L. Kuhn


KUHN DESIGN GROUP
Design
Dave L. Kuhn
Celina Oh. 419-586-8861

WEIGANDT CONST.

Scale: 1/4" = 1'-0"
Drawn: D.L.K.
Date: Mar. 06

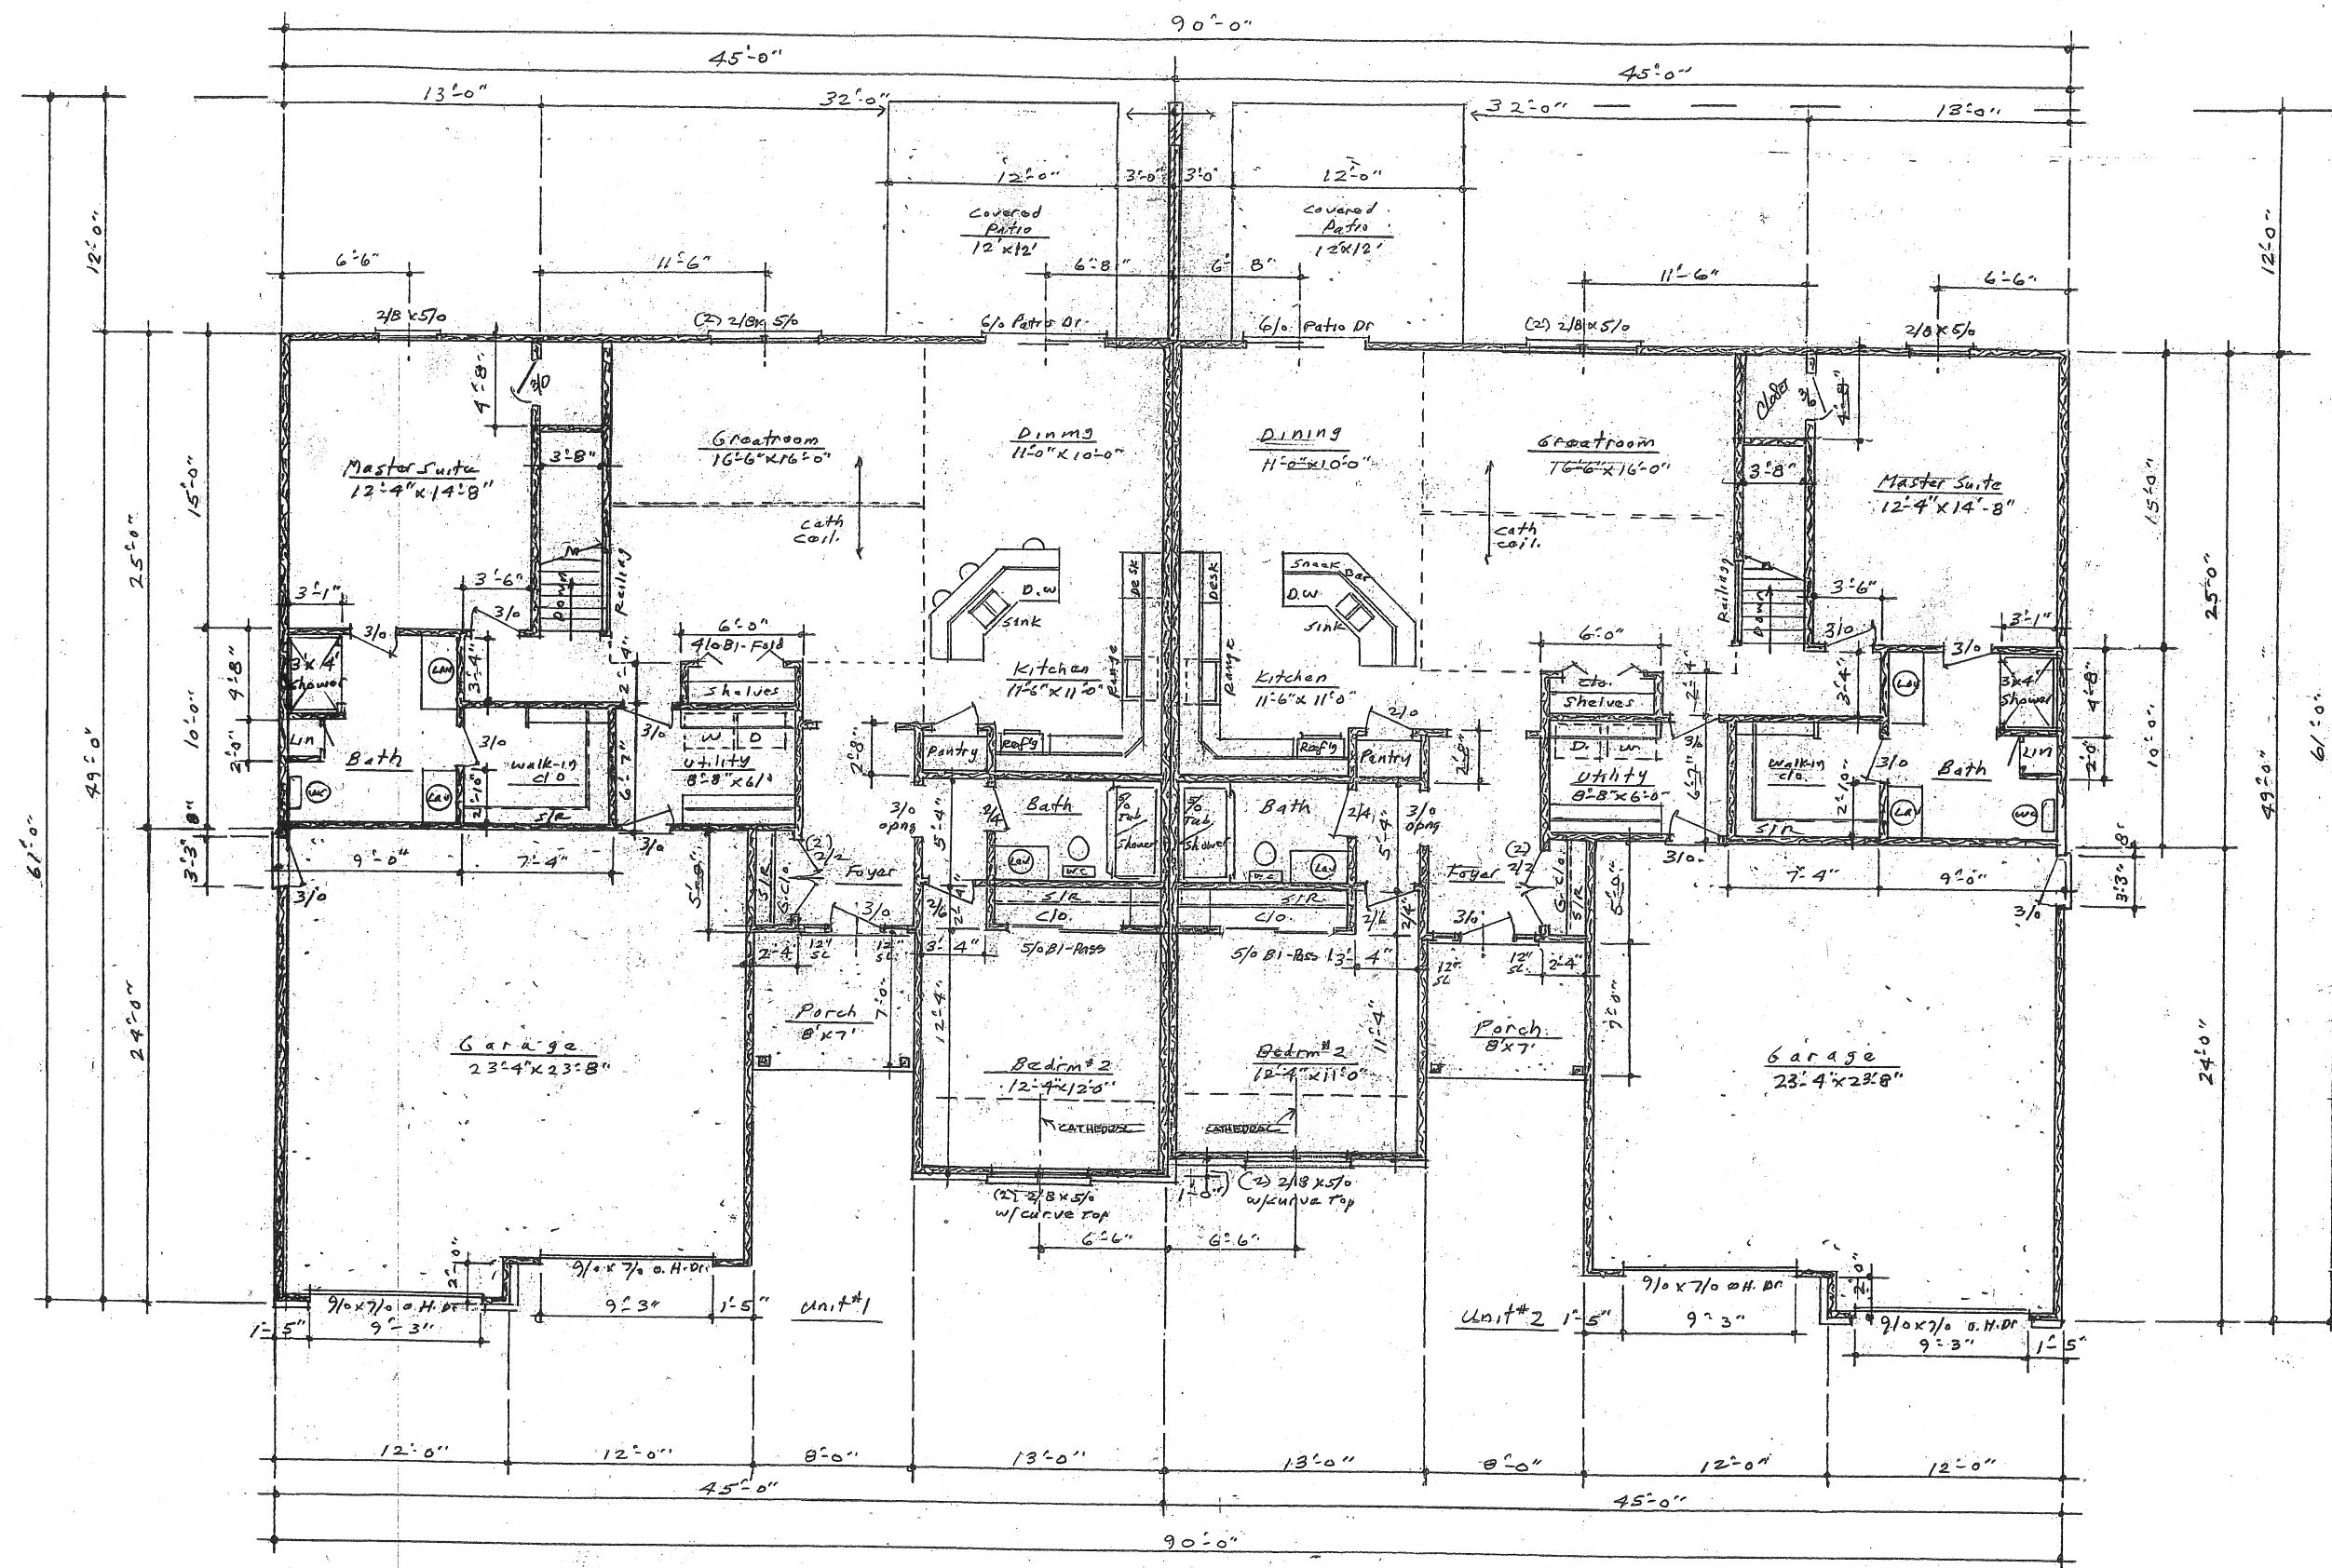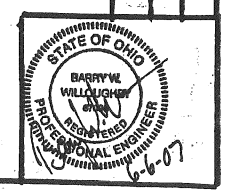

FLOOR PLAN
Scale: 1/4" = 1'-0"
1386 sq. ft. unit #1
1373 sq. ft. unit #2

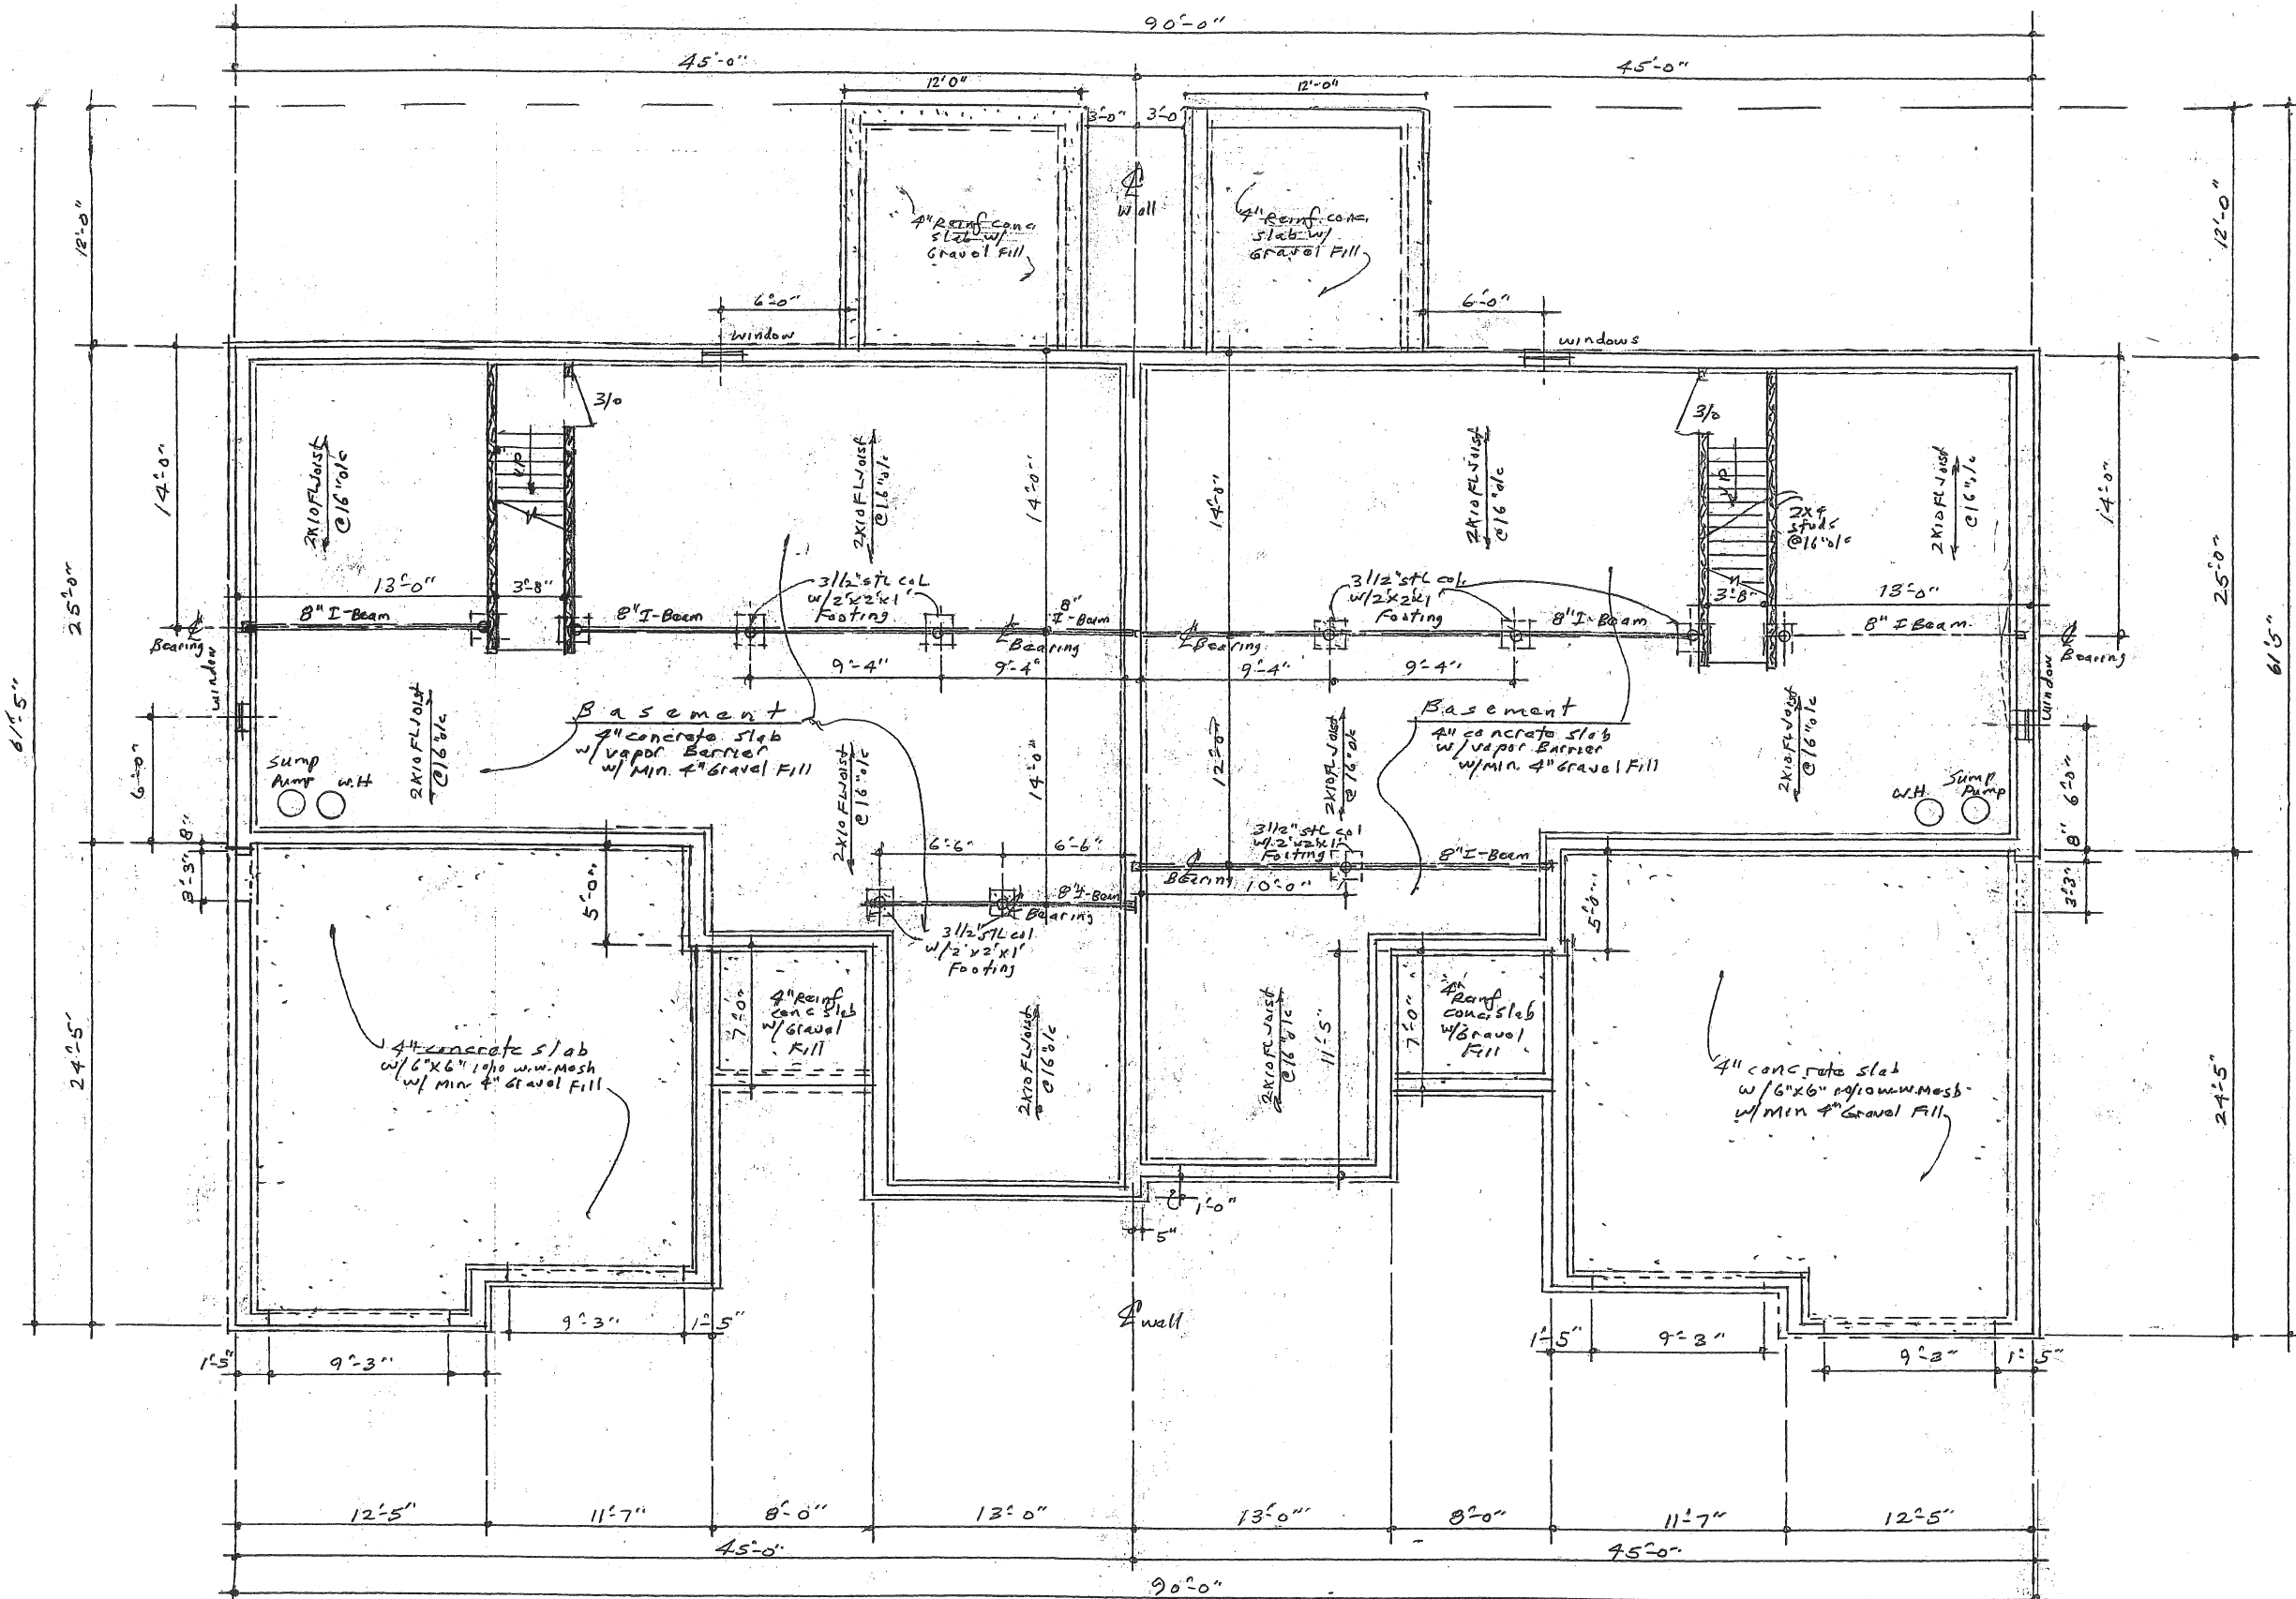

KUHN DESIGN GROUP

Property of
Dave L. Kuhn

Design
Dave L. Kuhn
Celina Oh. 419-596-8861

Sheet

4 of 4

WEIGANDT CONST

Scale: 1/4" = 1'-0"
Drawn: D. L. K.
Date: Mar. '06

