


Woodridge Drive Condominiums

Lot 110 of Rolling Hills Estates, 8th Addition,
situate in the SE 1/4 of Section 33,

An Expandable Condominium situate in the NE 1/4 of Section 34,
Town-5-South, Range-4-East, Noble Township,
City of St. Marys, Auglaize County, Ohio.

SHEET ONE OF THREE

200900003686
Filed for Record in
AUGLAIZE COUNTY, OHIO
ANN BILLINGS
05-21-2009 At 10:25 am.
PLAT 129.60
Book D Page 217-219

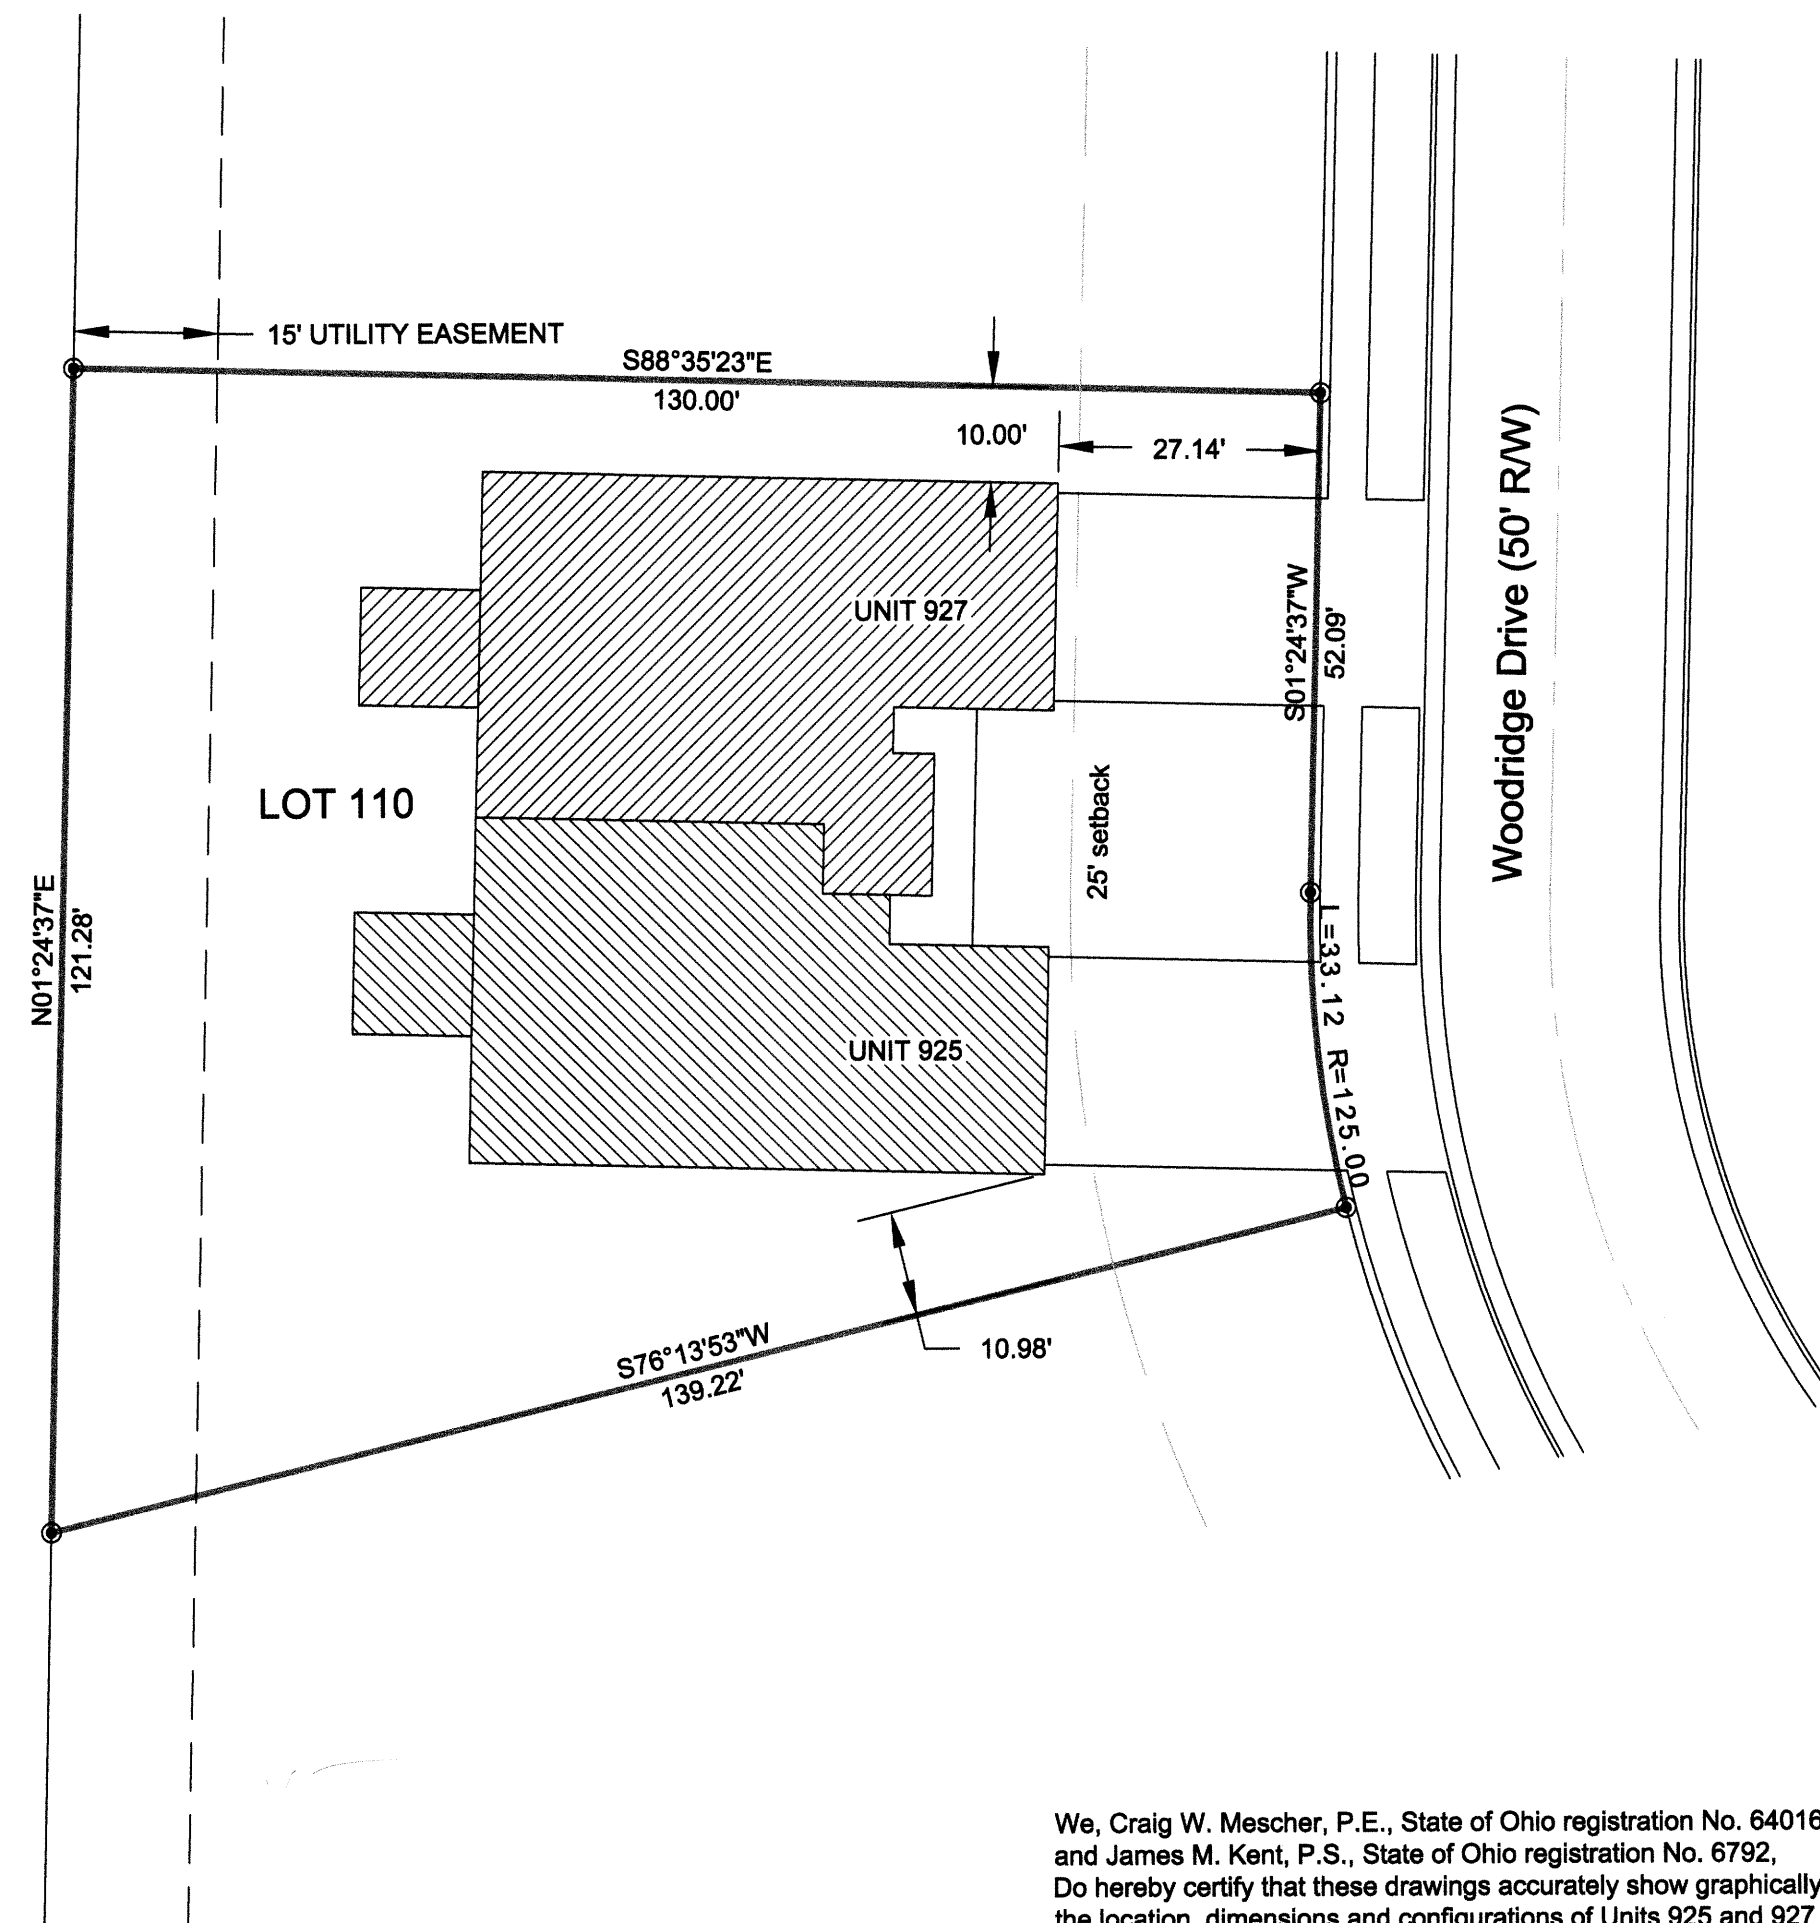


We, Craig W. Mescher, P.E., State of Ohio registration No. 64016,
and James M. Kent, P.S., State of Ohio registration No. 6792,
Do hereby certify that these drawings accurately show graphically
the location, dimensions and configurations of Units 925 and 927 of
Woodridge Drive Condominiums, as constructed.

Dated at Celina, Ohio on April 21, 2009

By: Craig W. Mescher
Craig W. Mescher, Professional Engineer No. 64016


By: James M. Kent
James M. Kent, Professional Surveyor No. 6792

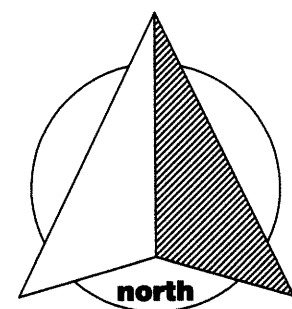

GRAPHIC SCALE




(IN FEET)
1 inch = 20 ft.

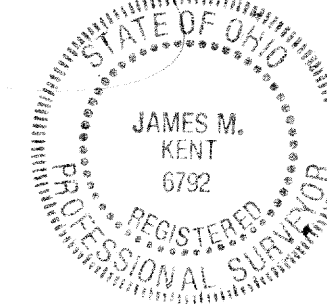


kent surveying, inc.
AutoCAD ~ Broyles Condo
drawing #5112
April 17, 2009

Woodridge Drive Condominiums

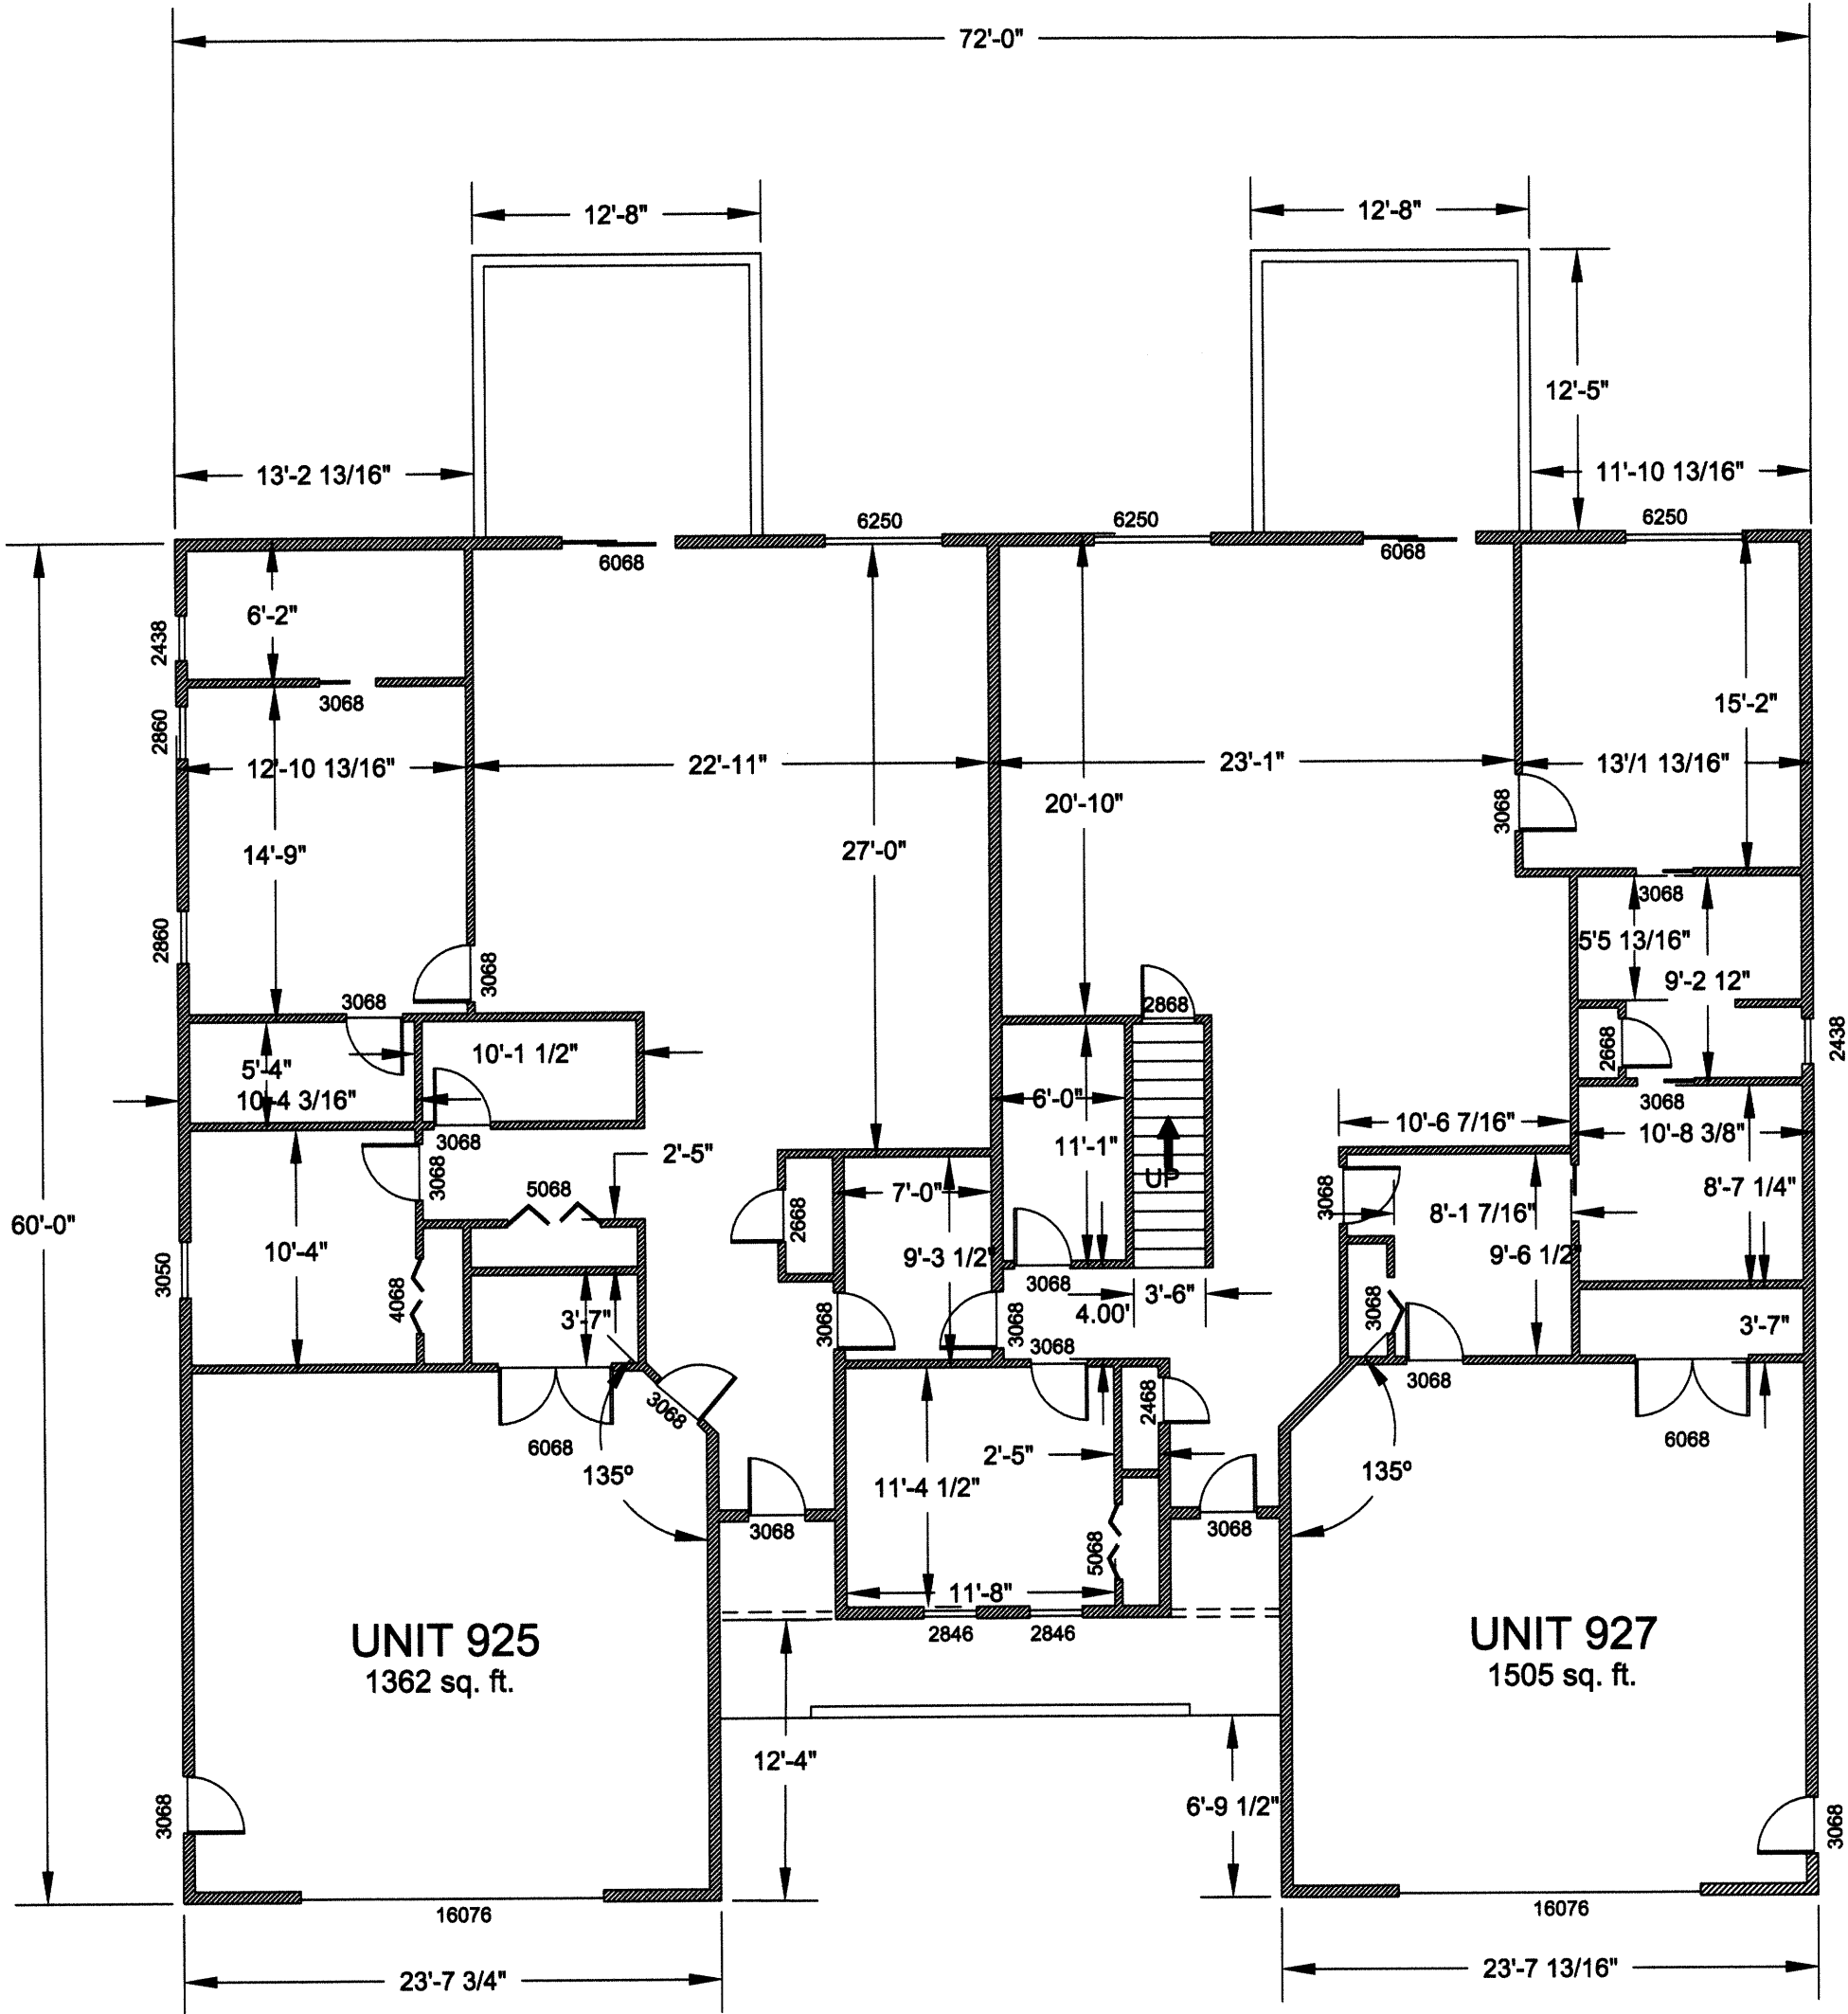

UNIT FLOOR PLAN

SCALE 1/8" = 1'

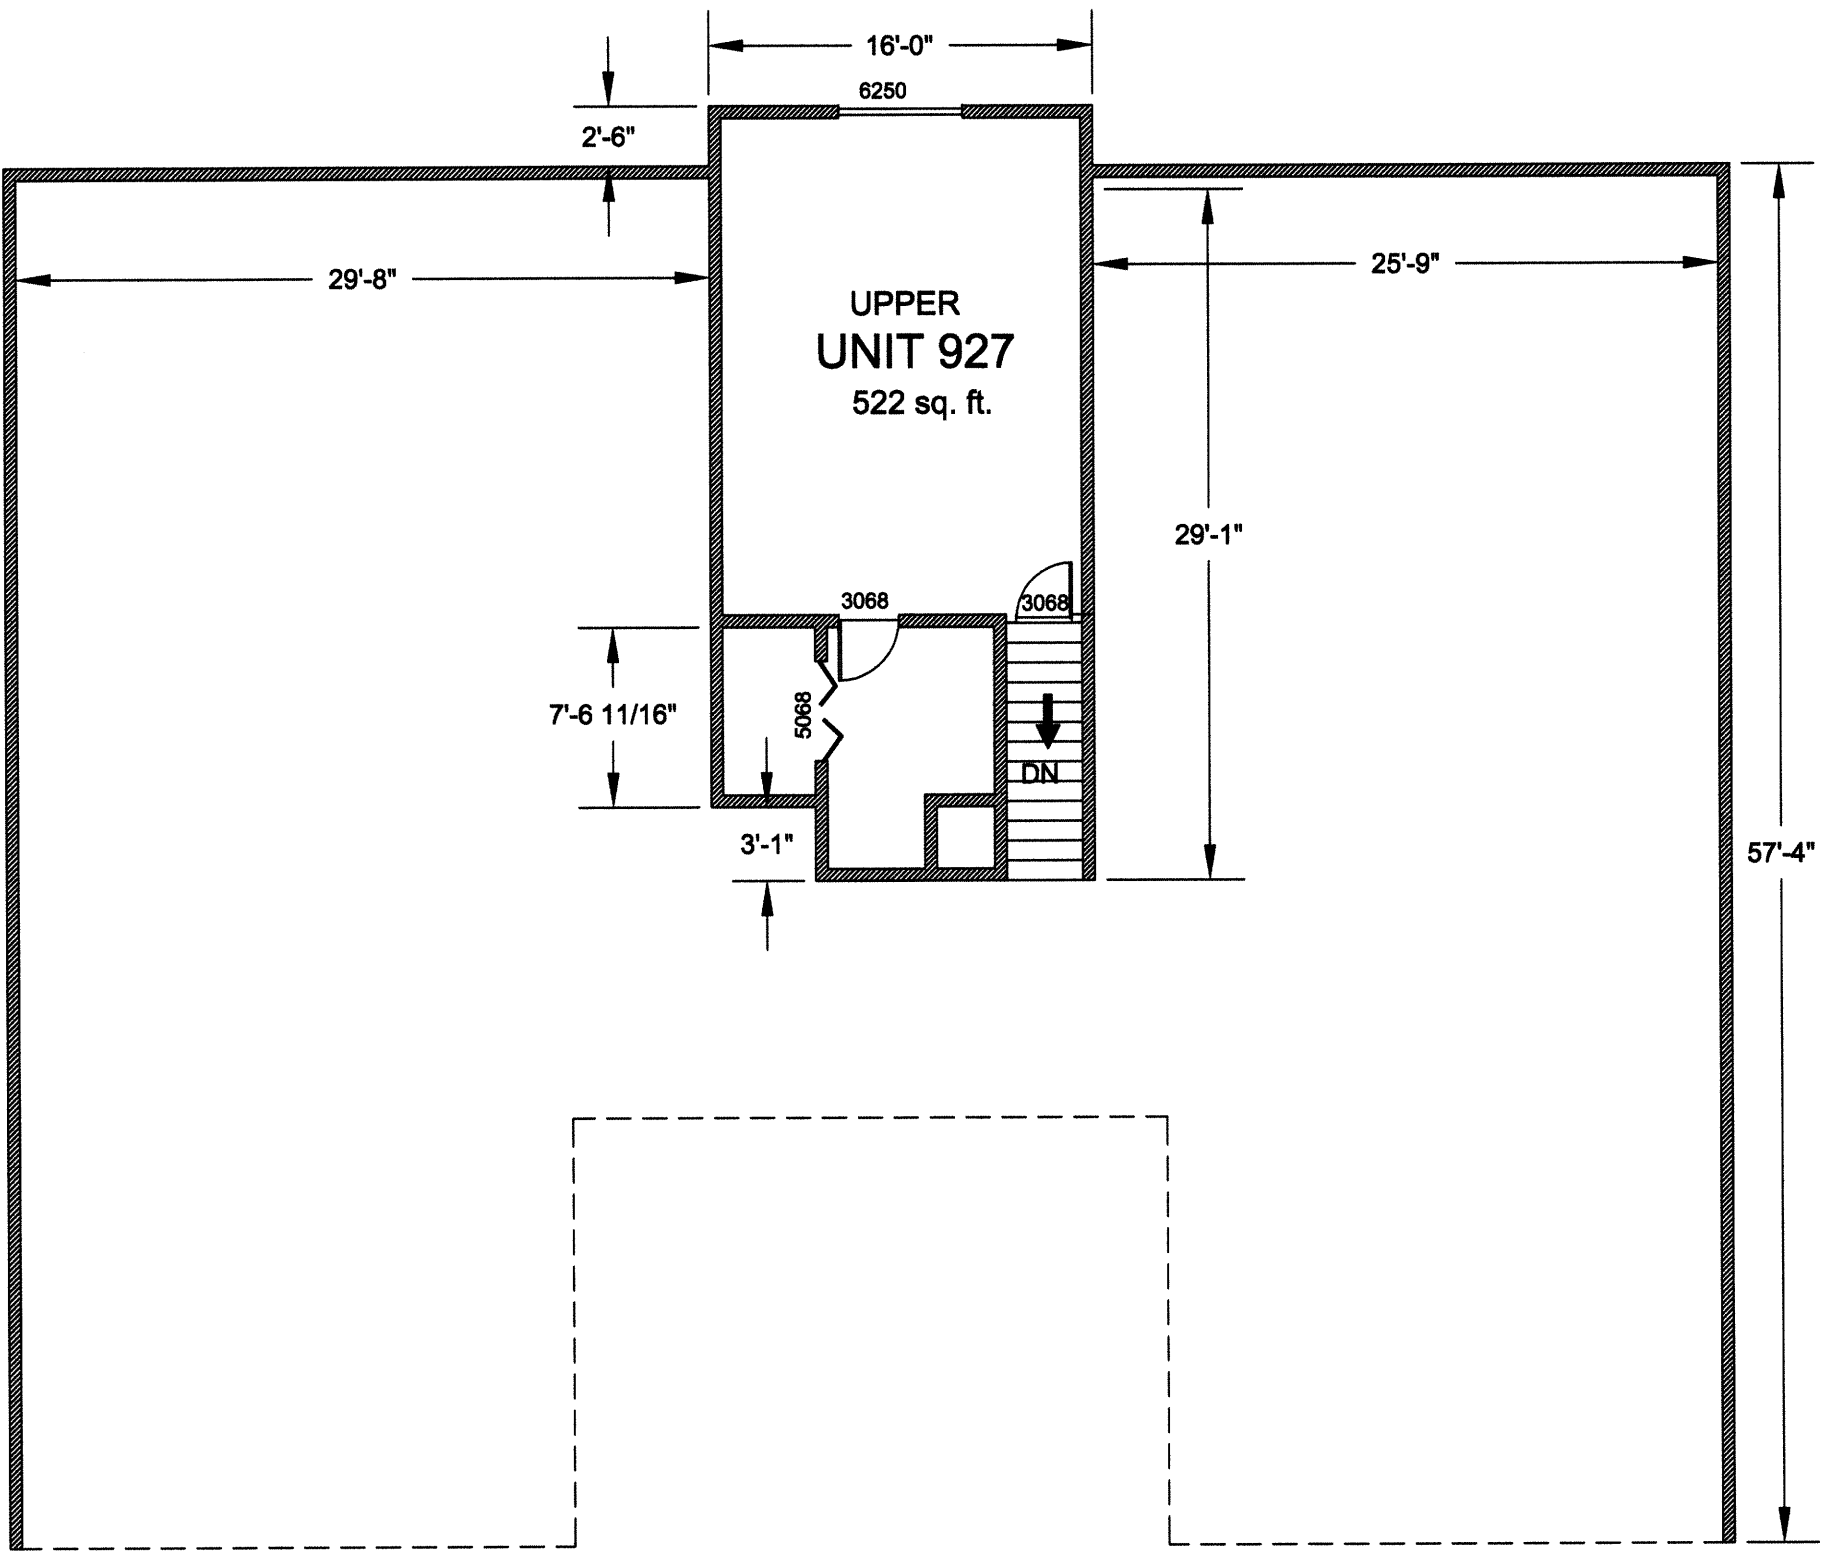

Woodridge Drive Condominiums



EAST ELEVATION



NORTH ELEVATION



WEST ELEVATION



SOUTH ELEVATION

SCALE 1/8" = 1'