

BEING A CONDOMINIUM OF LOT 34 OF DEERFIELD RUN SUBDIVISION, PHASE 5
IN THE VILLAGE OF NEW BREMEN, AUGLAIZE COUNTY, OHIO

Jane Schuler BM,
AUGLAIZE COUNTY AUDITOR


FILED THIS 21 DAY OF April, 2011, AT 2:13 O'CLOCK P.M.
RECORDED THIS 21 DAY OF April, 2011.
PLAT CABINET D, SLIDE 238 # 2084

Ann Billings
AUGLAIZE COUNTY RECORDER T.A.S.



BEARINGS ARE BASED ON PLAT
CABINET D, SLIDE 20.

SCALE 1" = 20'

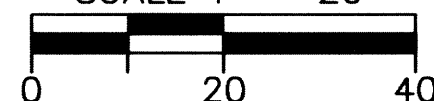

LEGEND


○ IRON PIN FOUND

ENABLING DECLARATION ESTABLISHING A PLAN
FOR CONDOMINIUM OWNERSHIP RECORDED IN

VOL. 603, PAGE 1164.

VOL. 003, PAGE 004.
AMSTERDAM NO. 2
BYLAWS OF DEERFIELD RUN CONDOMINIUM OF

LOT ~~34~~ ARE RECORDED IN ____ VOL. 603, PAGE 1209.

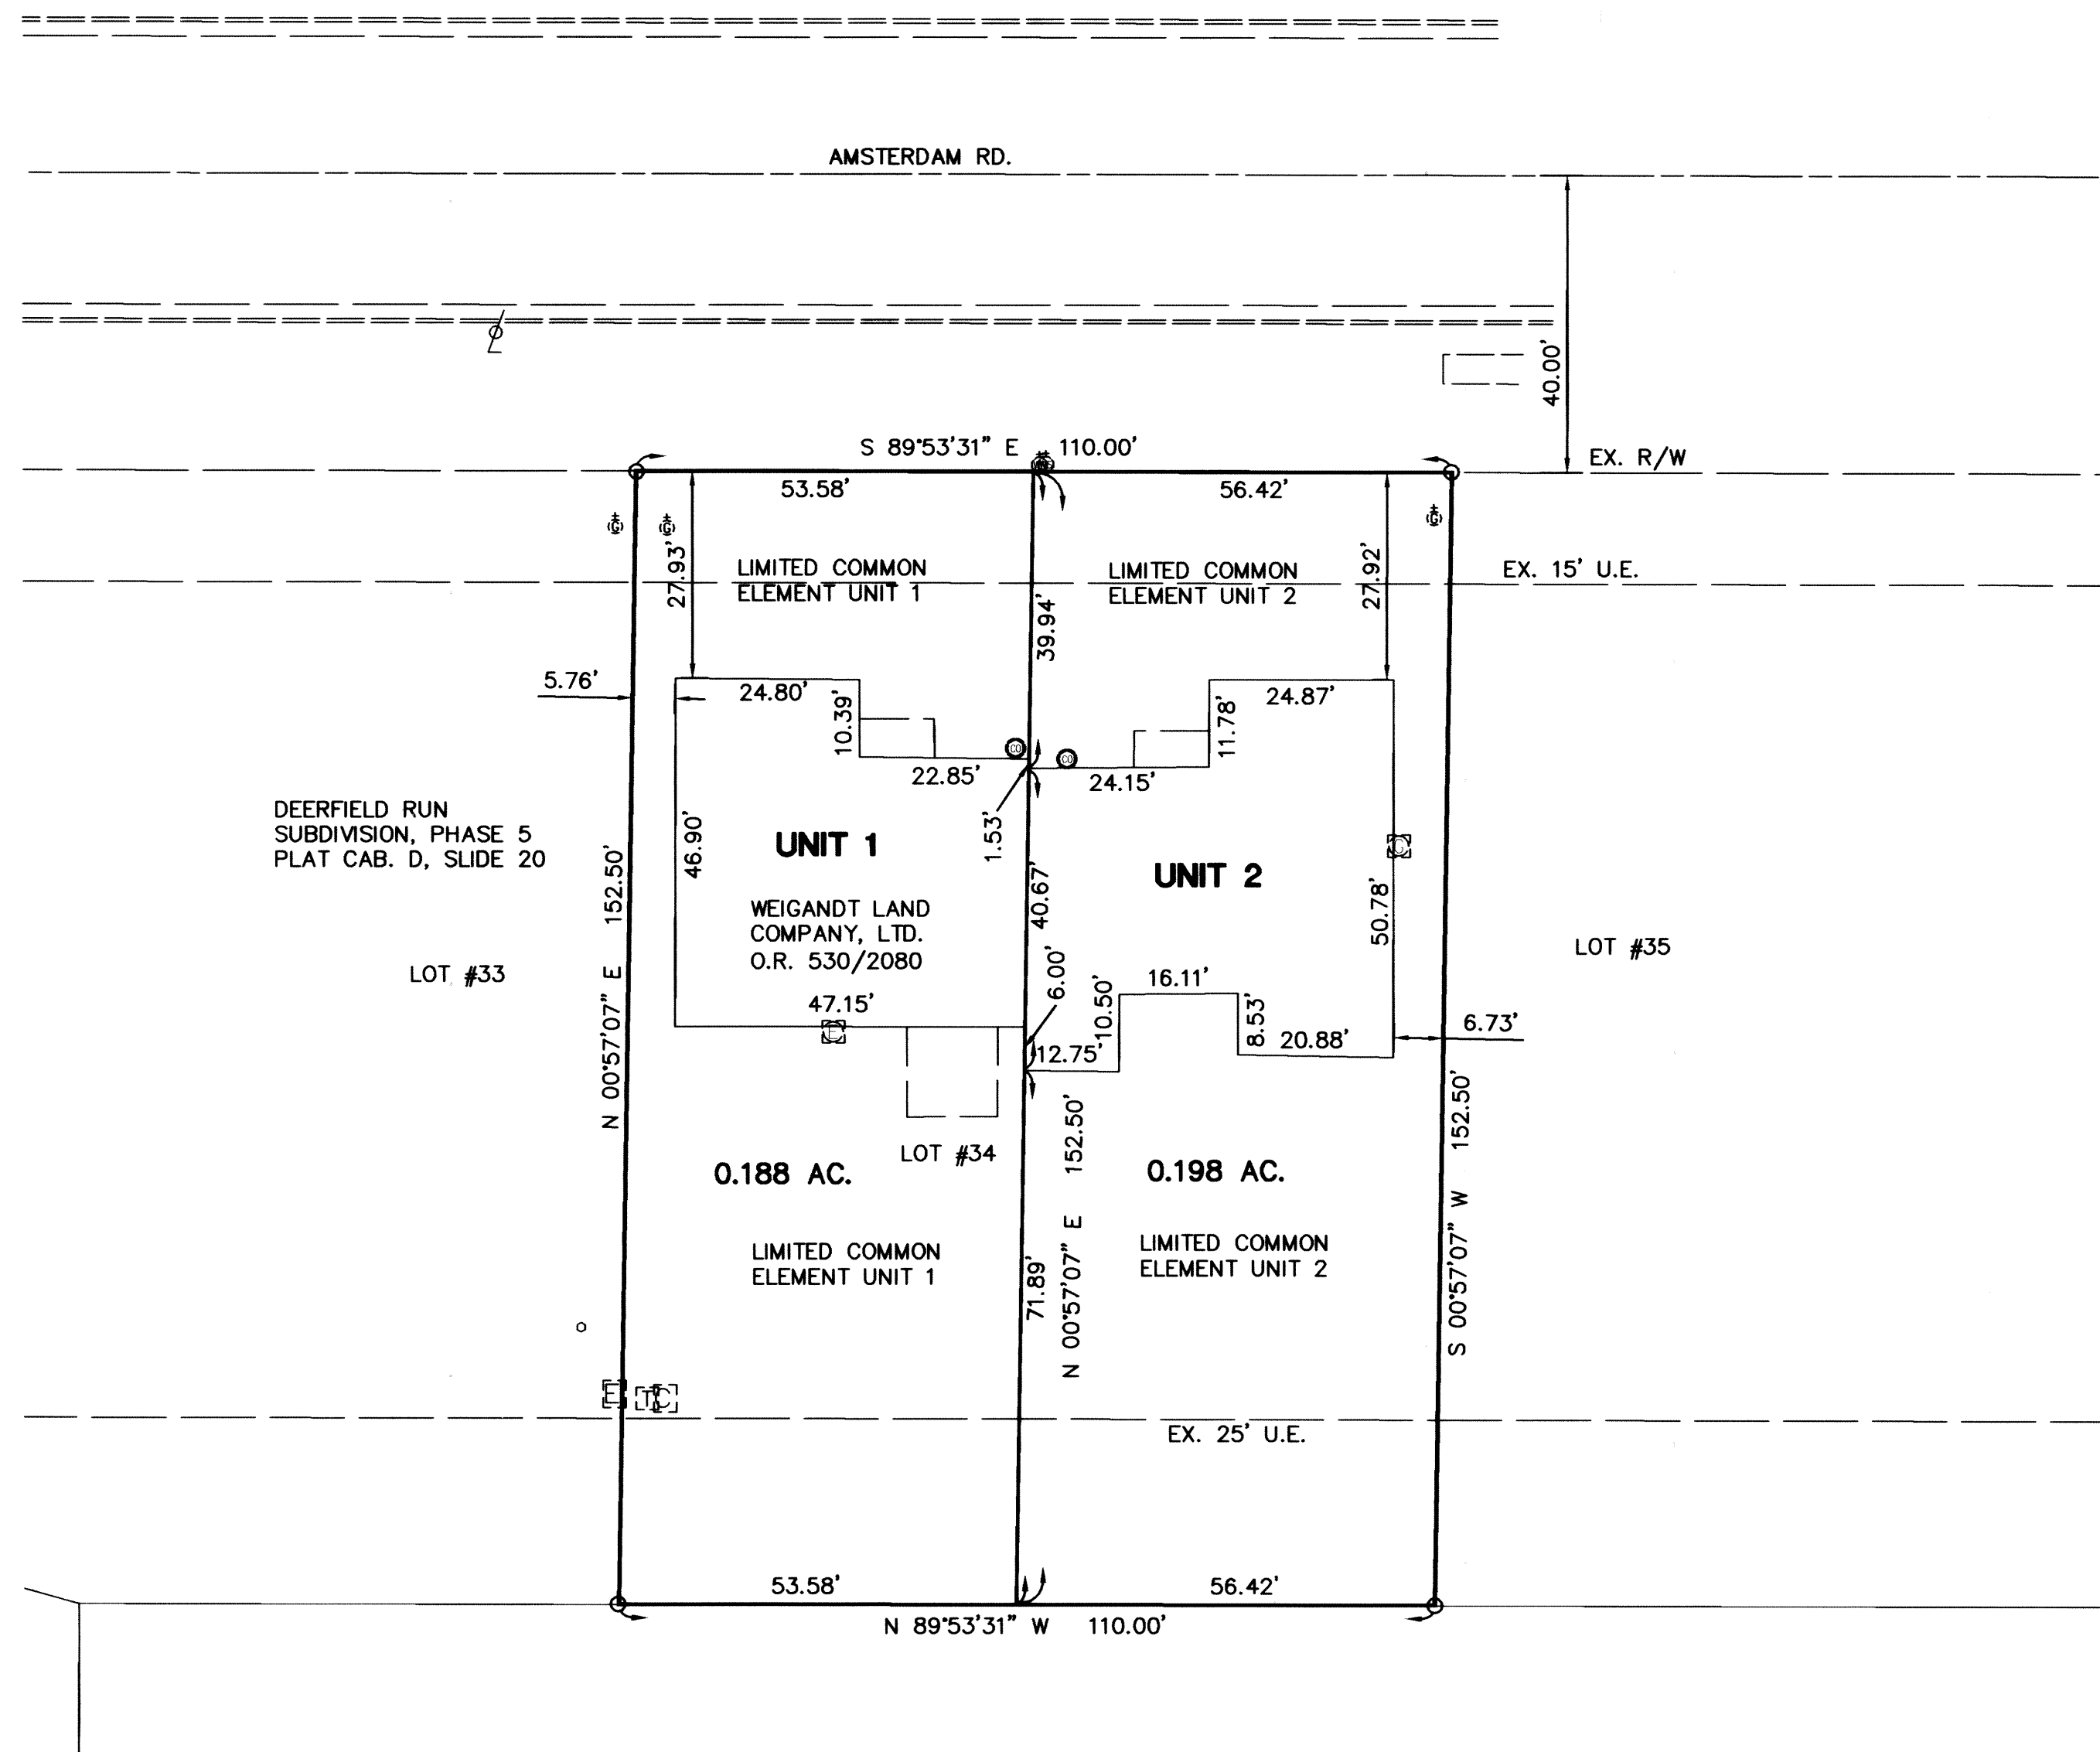


ENGINEER'S CERTIFICATION

THE DIMENSIONS SHOWN ON THE UNITS ARE FOR THE FINISHED EXTERIOR AS CONSTRUCTED UPON LOT 34 AND ARE ACCURATELY SHOWN HEREON.

JEFFREY S. PUTHOFF, P.E. #61619

31/11/18

DATE _____

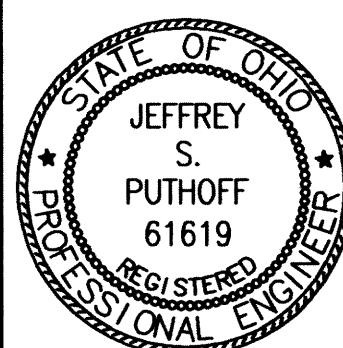


SURVEYOR'S CERTIFICATION

THE DIMENSIONS SHOWN ON THE UNITS ARE FOR THE FINISHED EXTERIOR AS CONSTRUCTED UPON LOT 34 AND ARE ACCURATELY SHOWN HEREON.

WESLEY D. GOUBEUX, P.S. #8254

1/31/2011

DATE _____

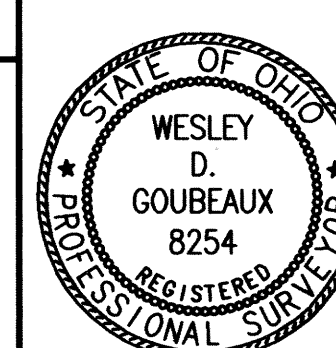

CHOICE **ONE**
ENGINEERING

440 E. HOEWISHER ROAD, SIDNEY, OHIO 45365
(937) 497-0200 FAX (937) 497-0300
www.choiceoneengineering.com

DATE:
01-13-2011

DRAWN BY:
JMK

JOB NUMBER:
AUGNBR1101

SHEET NUMBER

1 OF 1