


AMENDMENT TO HANOVER PLACE CONDOMINIUM DRAWINGS

THIS IS TO CERTIFY THAT A COPY OF
THESE DRAWINGS HAS BEEN FILED WITH
THE AUGLAIZE COUNTY, OHIO AUDITOR.
Janet Schuler PM
AUGLAIZE COUNTY AUDITOR

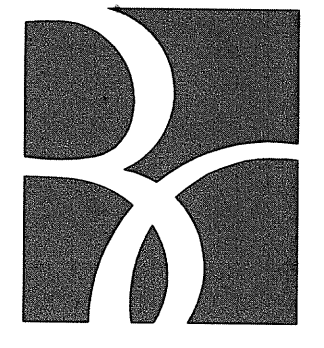


BAUMER
CONSTRUCTION, INC.

285 SOUTH OHIO STREET
P.O. BOX 3
MINSTER, OHIO 45865
PHONE: 419-628-3364
FAX: 419-628-2911
www.baumerconstruction.com

LEGEND	
A	- CONDOMINIUM UNIT
	- PATIO, LIMITED COMMON AREA
	- DRIVE, LIMITED COMMON AREA

THE UNDERSIGNED, A REGISTERED PROFESSIONAL ENGINEER,
CERTIFIES IN ACCORDANCE WITH RC §5311.07(B)(1) THAT
THESE DRAWINGS, CONSISTING OF PAGES HP-1, HP-2 & HP-3,
ACCURATELY SHOW EACH BUILDING AS BUILT OR CONSTRUCTED.

Ben G. Baumer 10/27/11
REGISTERED PROFESSIONAL ENGINEER

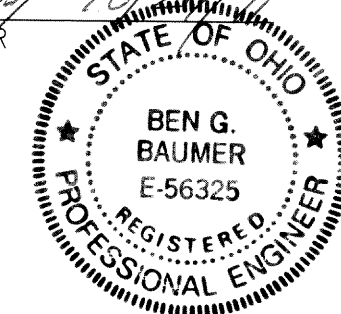

THE UNDERSIGNED, A REGISTERED PROFESSIONAL SURVEYOR,
CERTIFIES IN ACCORDANCE WITH RC §5311.07(B)(2) THAT
THESE DRAWINGS, CONSISTING OF PAGES HP-1, HP-2 & HP-3,
ACCURATELY REFLECT THE LOCATION OF IMPROVEMENTS AND
RECORDED EASEMENTS.

Steven E. Bowersox 10/27/2011
REGISTERED PROFESSIONAL SURVEYOR



2011-5672
Plot filed Oct 31, 2011
Cob D Pages 249-251
Chris Lambert - Recorder

AMENDMENT TO
HANOVER PLACE CONDOMINIUM DRAWINGS

SITE PLAN

REVISIONS

PROJECT NUMBER

DRAWN BY
DJS

DATE
10-3-11



DRAWING NUMBER

HP-1


HANOVER STREET


ALLEY

ADDED GARAGE AND DRIVE
TO UNIT A.
NO REVISIONS TO UNIT B OR UNIT C.

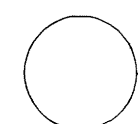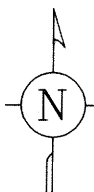

SITE PLAN
Scale: 1"=20'

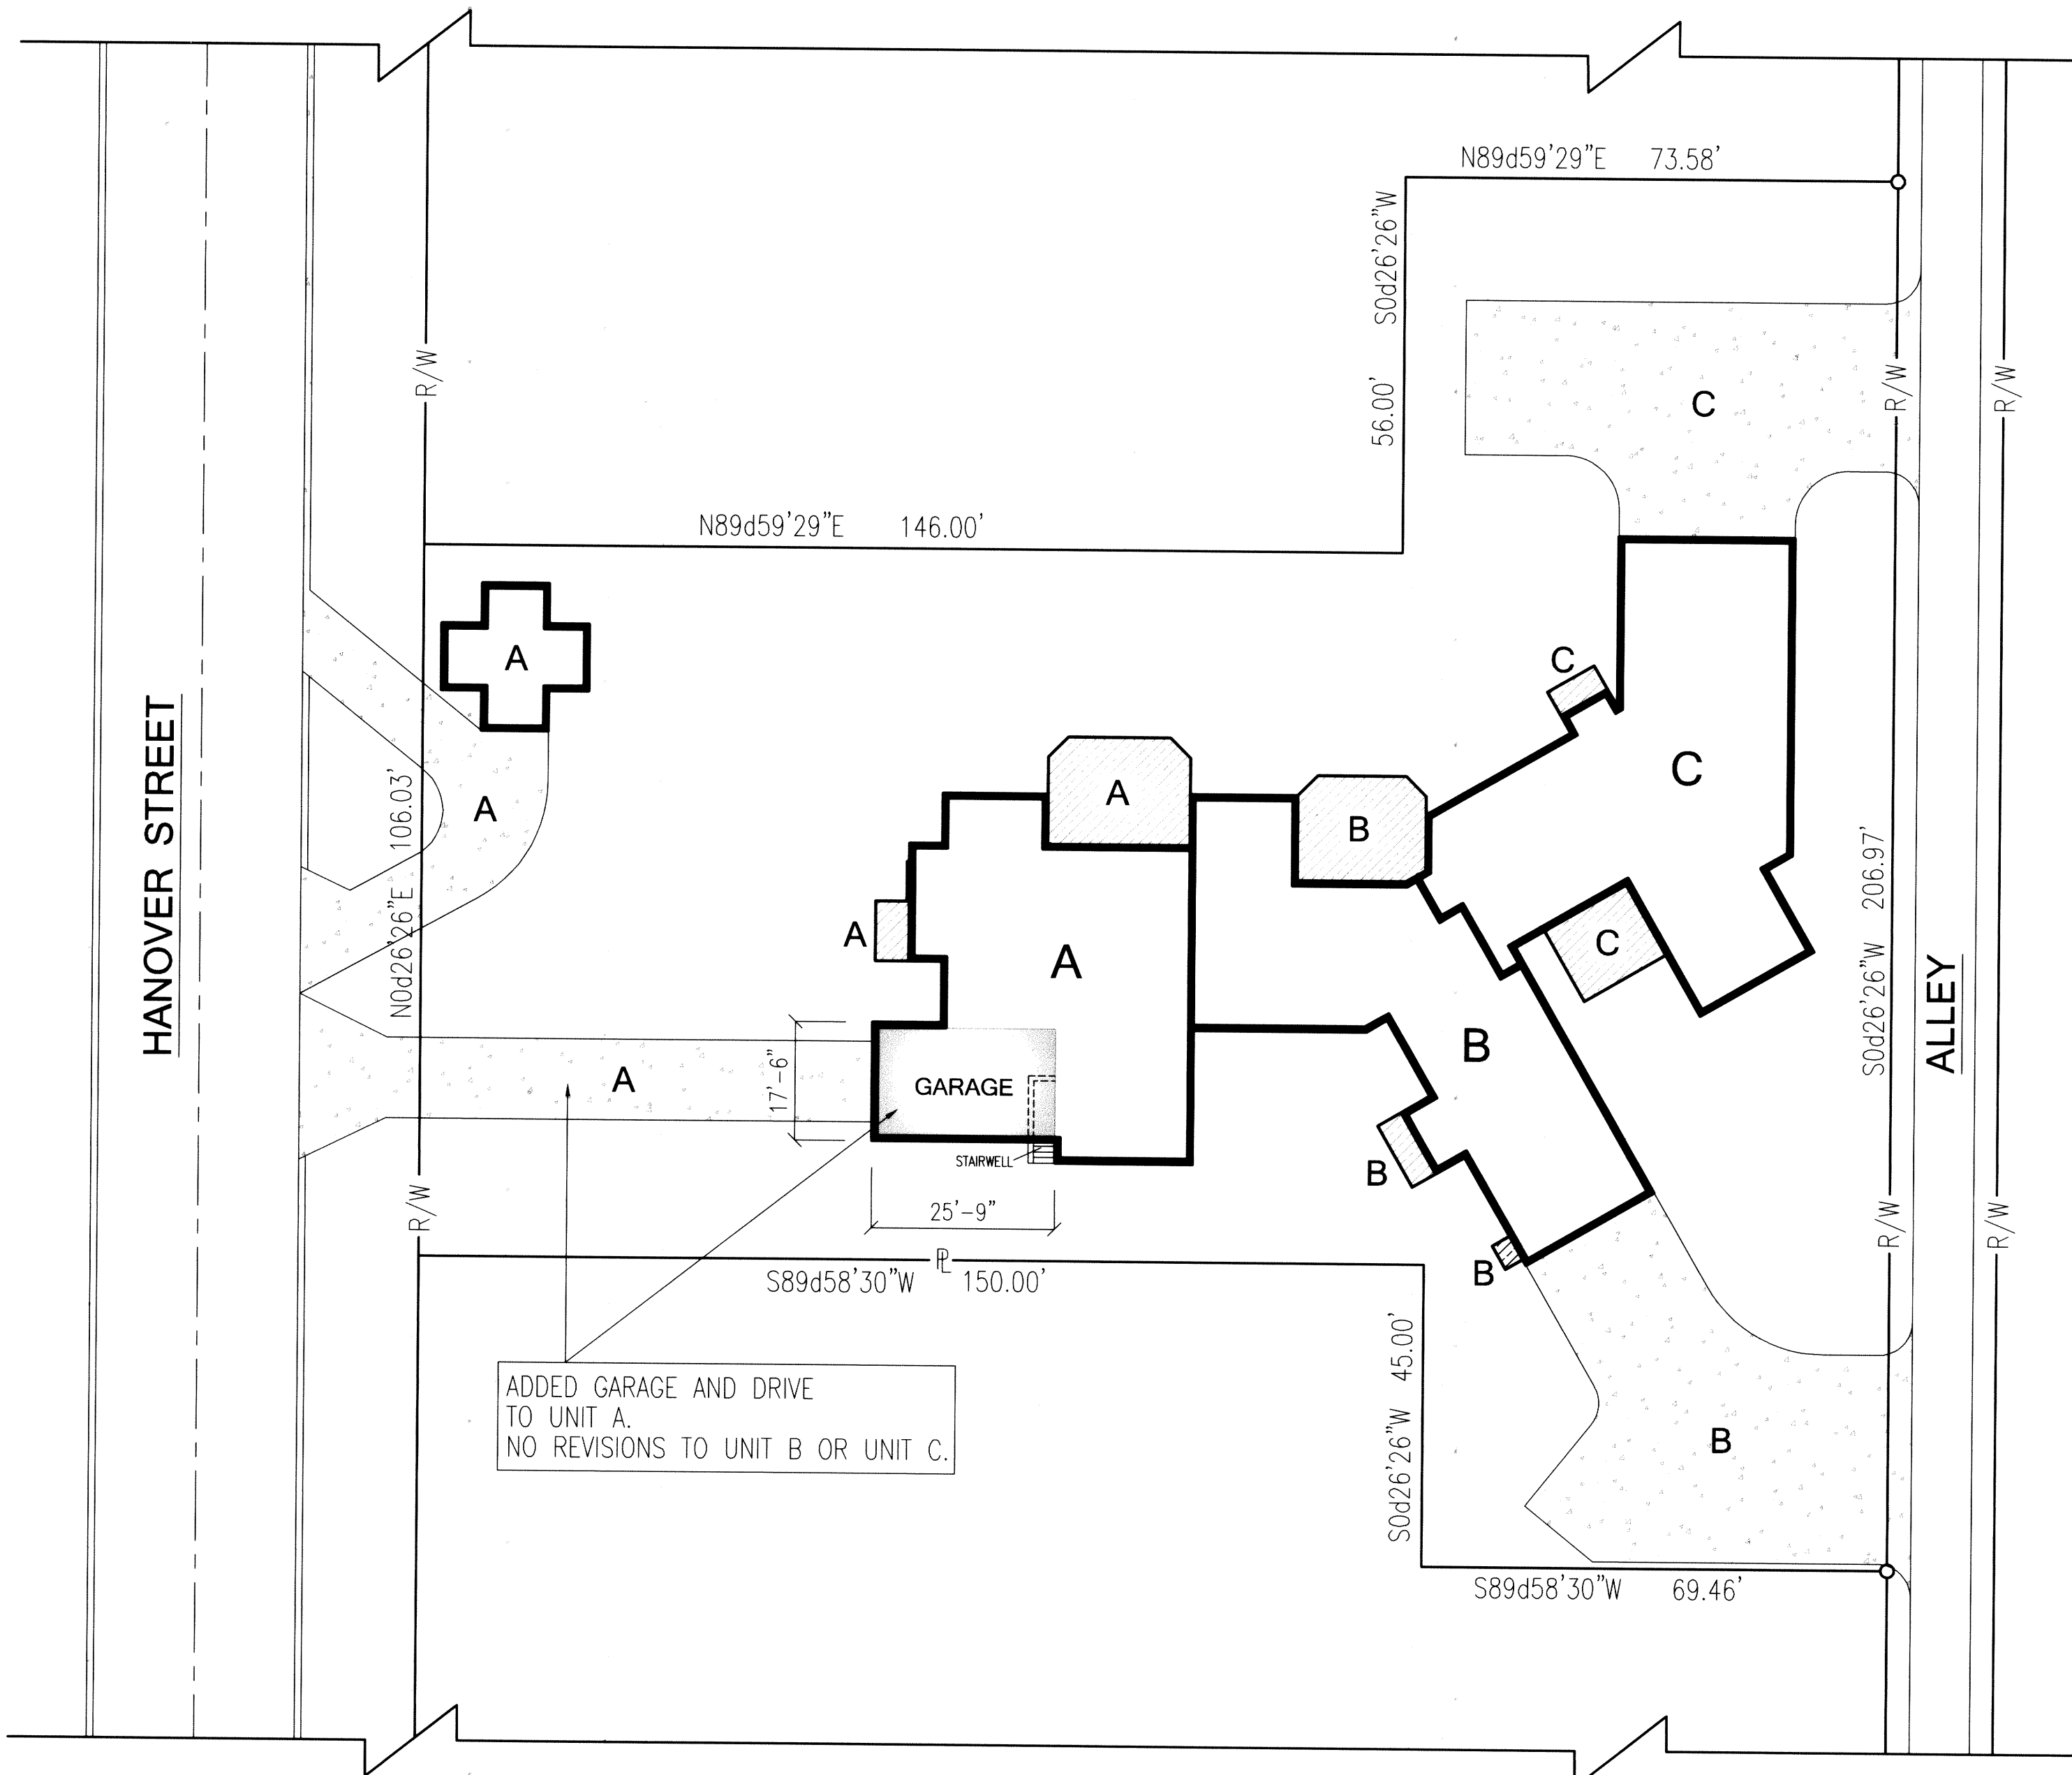

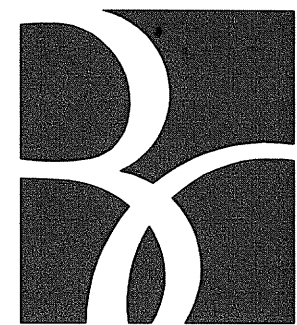

BAUMER
CONSTRUCTION, INC.

285 SOUTH OHIO STREET
P.O. BOX 3
MINSTER, OHIO 45865
PHONE: 419-628-3364
FAX: 419-628-2911
www.baumerconstruction.com

AMENDMENT TO
HANOVER PLACE CONDOMINIUM DRAWINGS

FLOOR PLAN/ FOUNDATION PLAN & ELEVATIONS

REVISIONS

PROJECT NUMBER

--

DRAWN BY


DJS

DATE

10-3-11

DRAWING NUMBER


HP-2

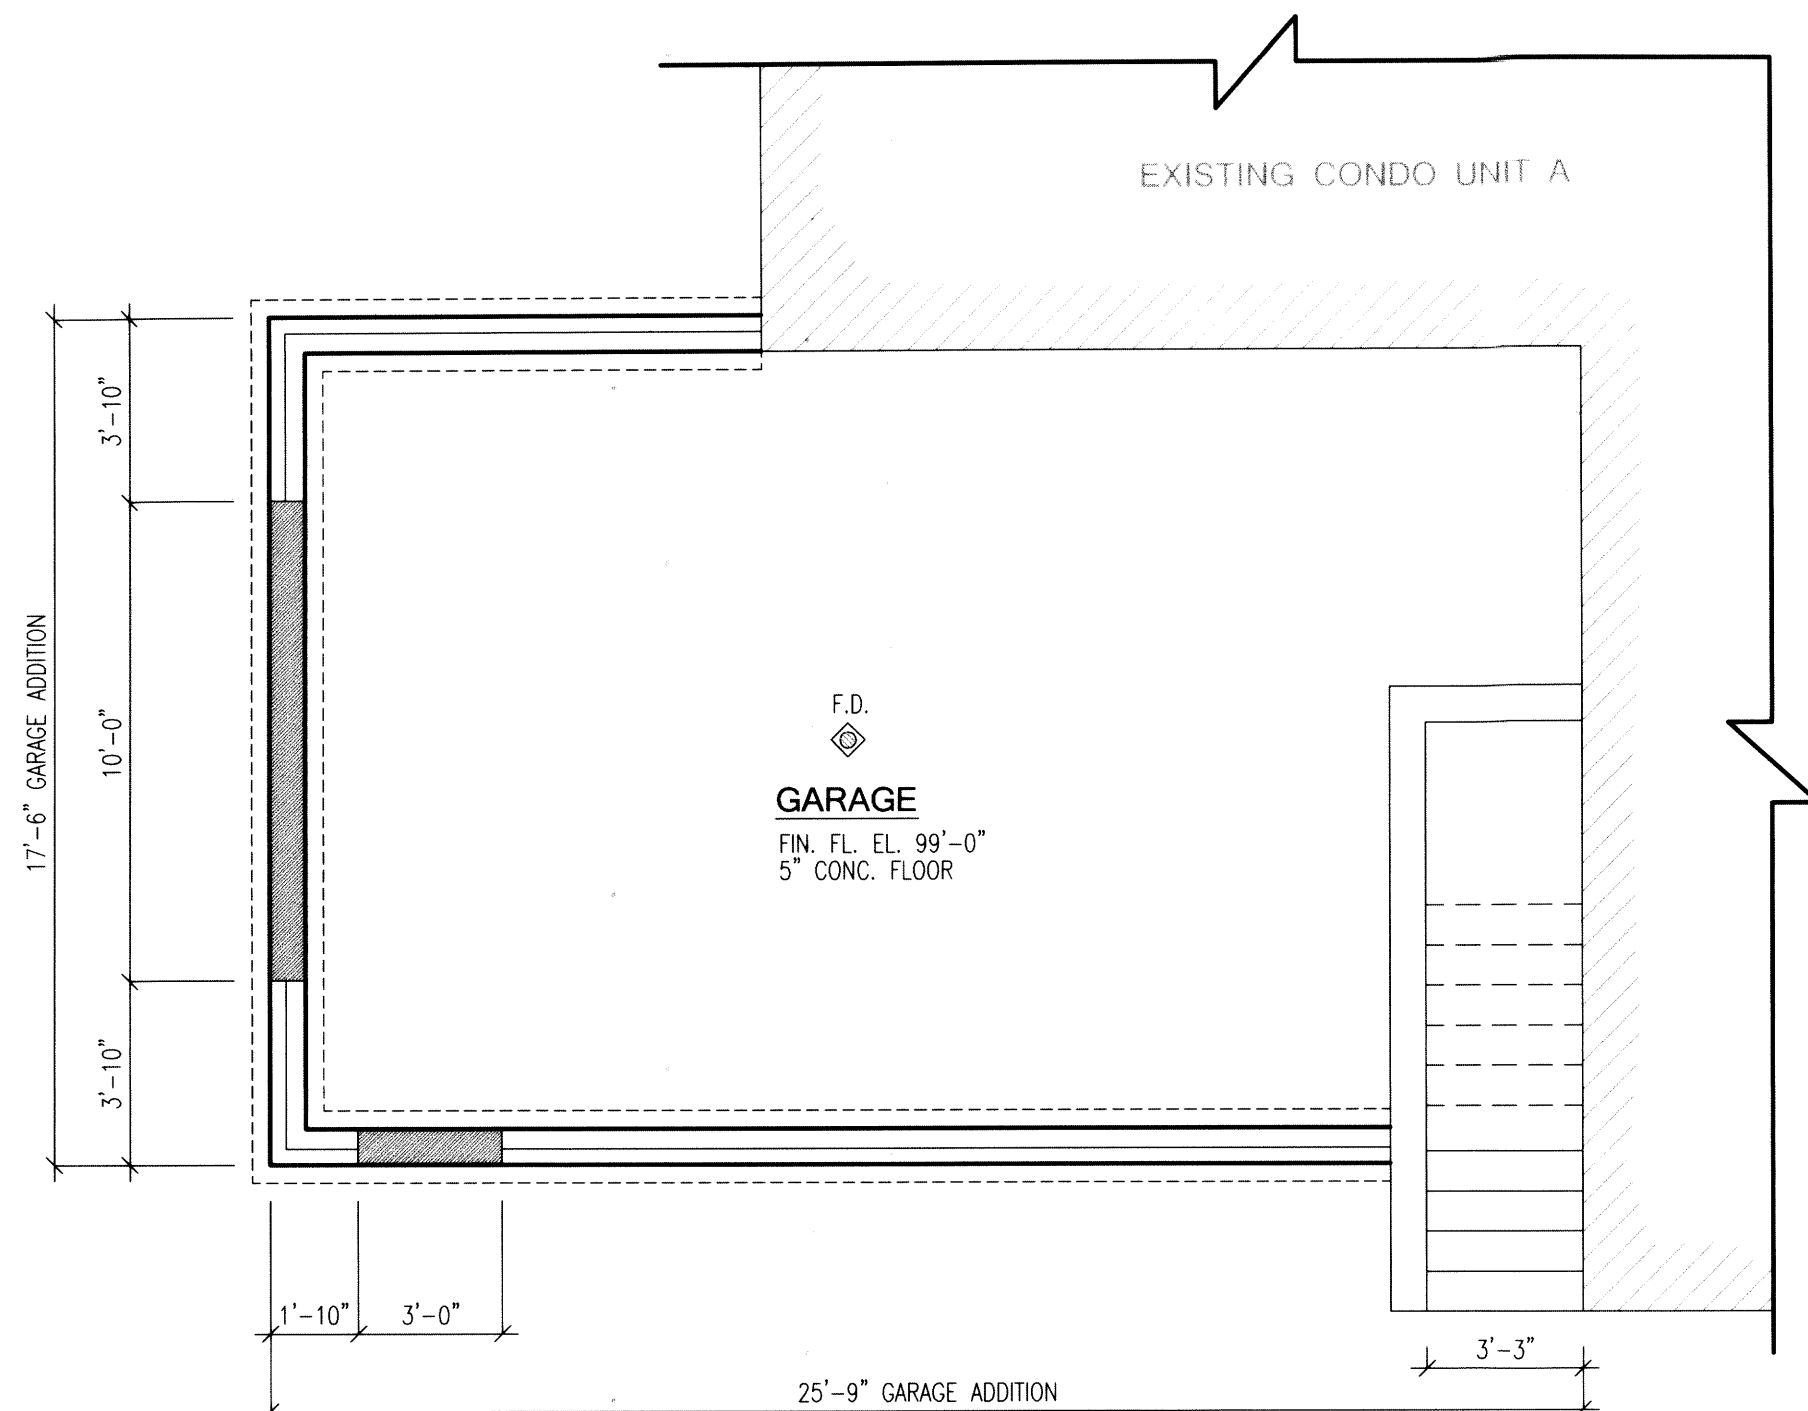

1

FOUNDATION PLAN


Scale: 1/4"=1'-0"

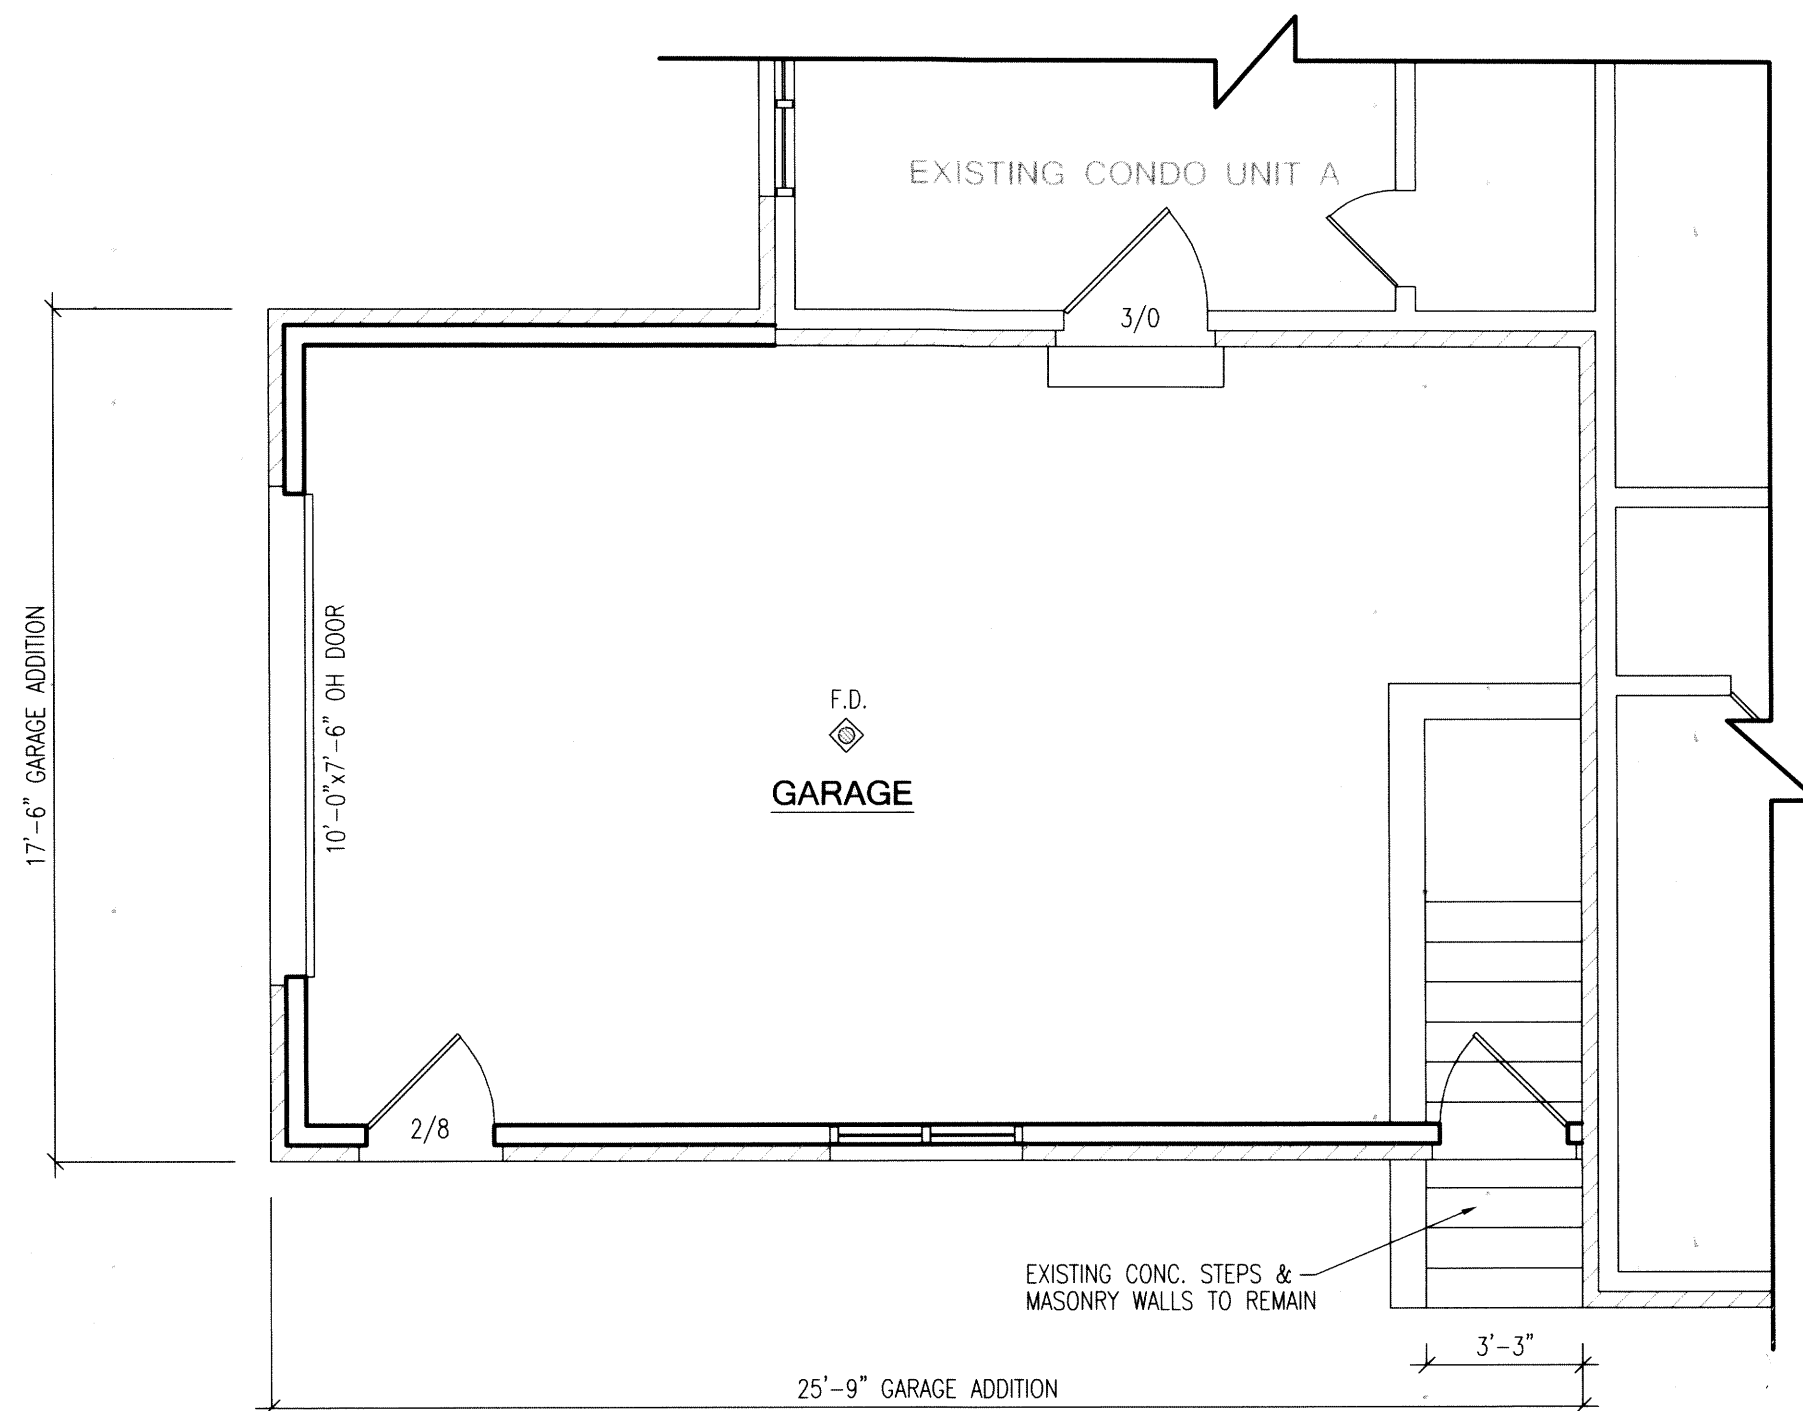


1

FLOOR PLAN

Scale: 1/4"=1'-0"

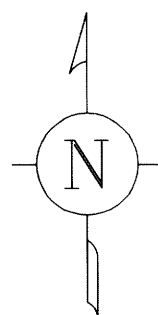


NOTE: NEW WALLS TO MATCH TYPICAL WALL SECTION PREVIOUSLY FILED.

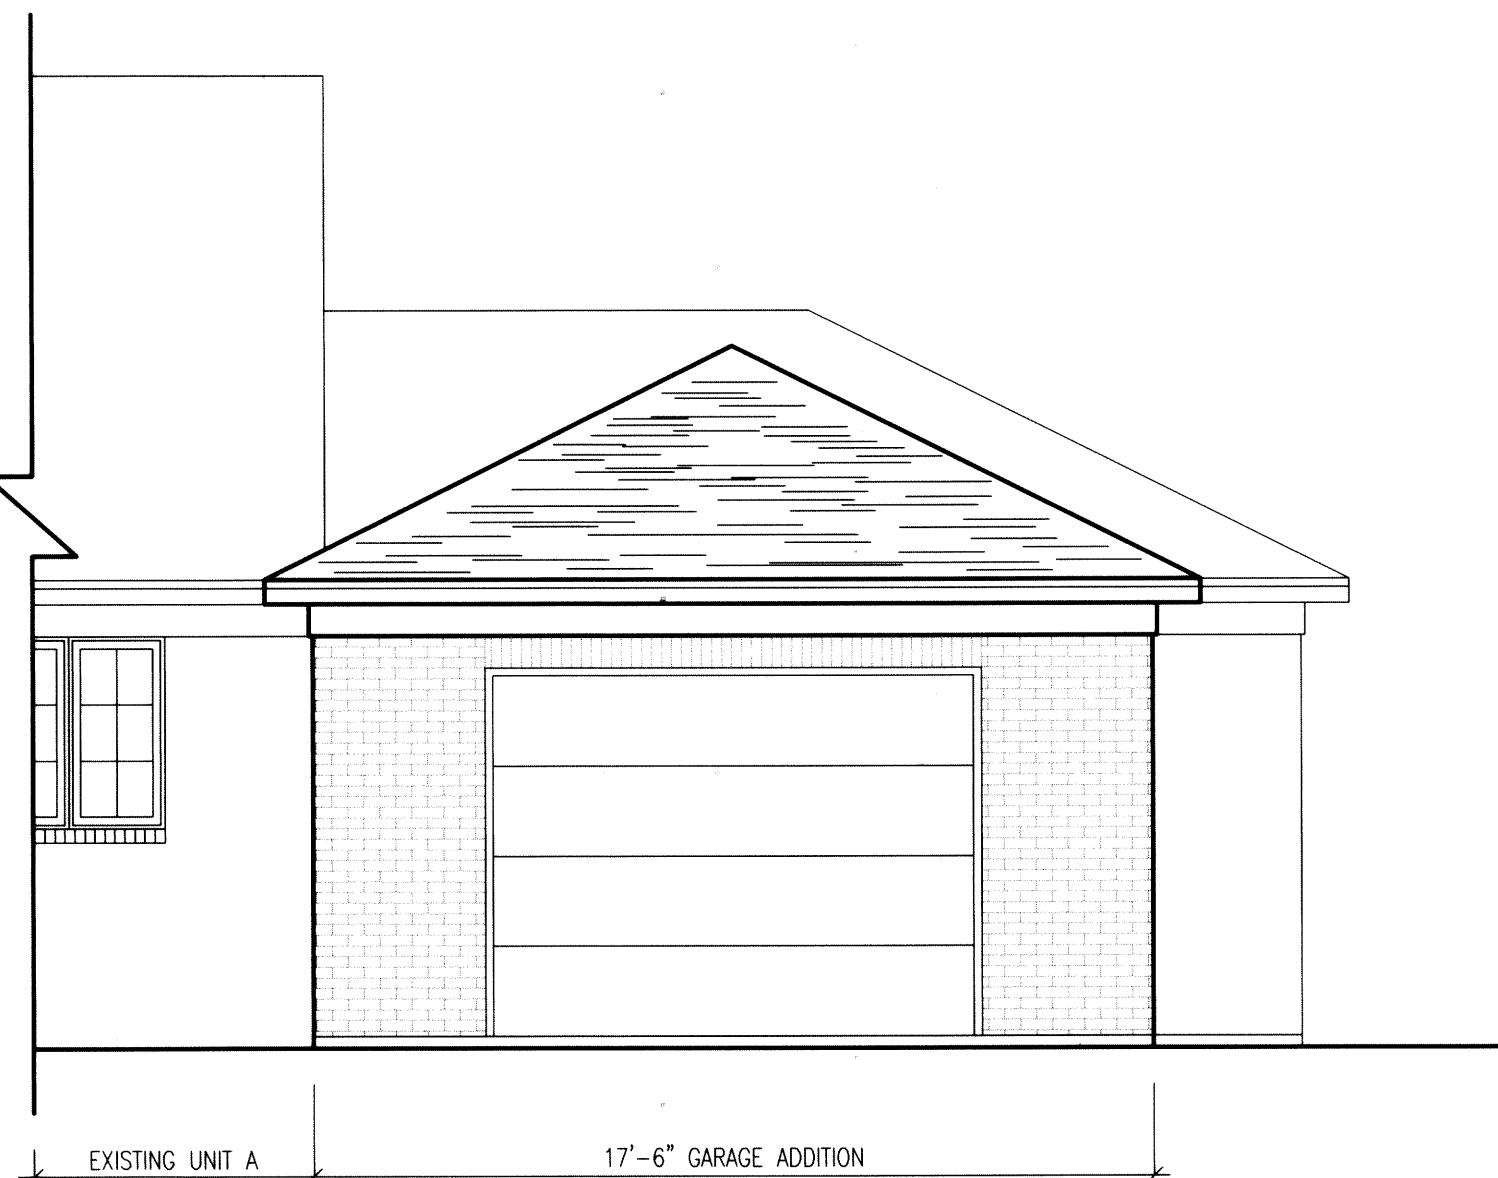


WEST ELEVATION

Scale: 1/4"=1'-0"

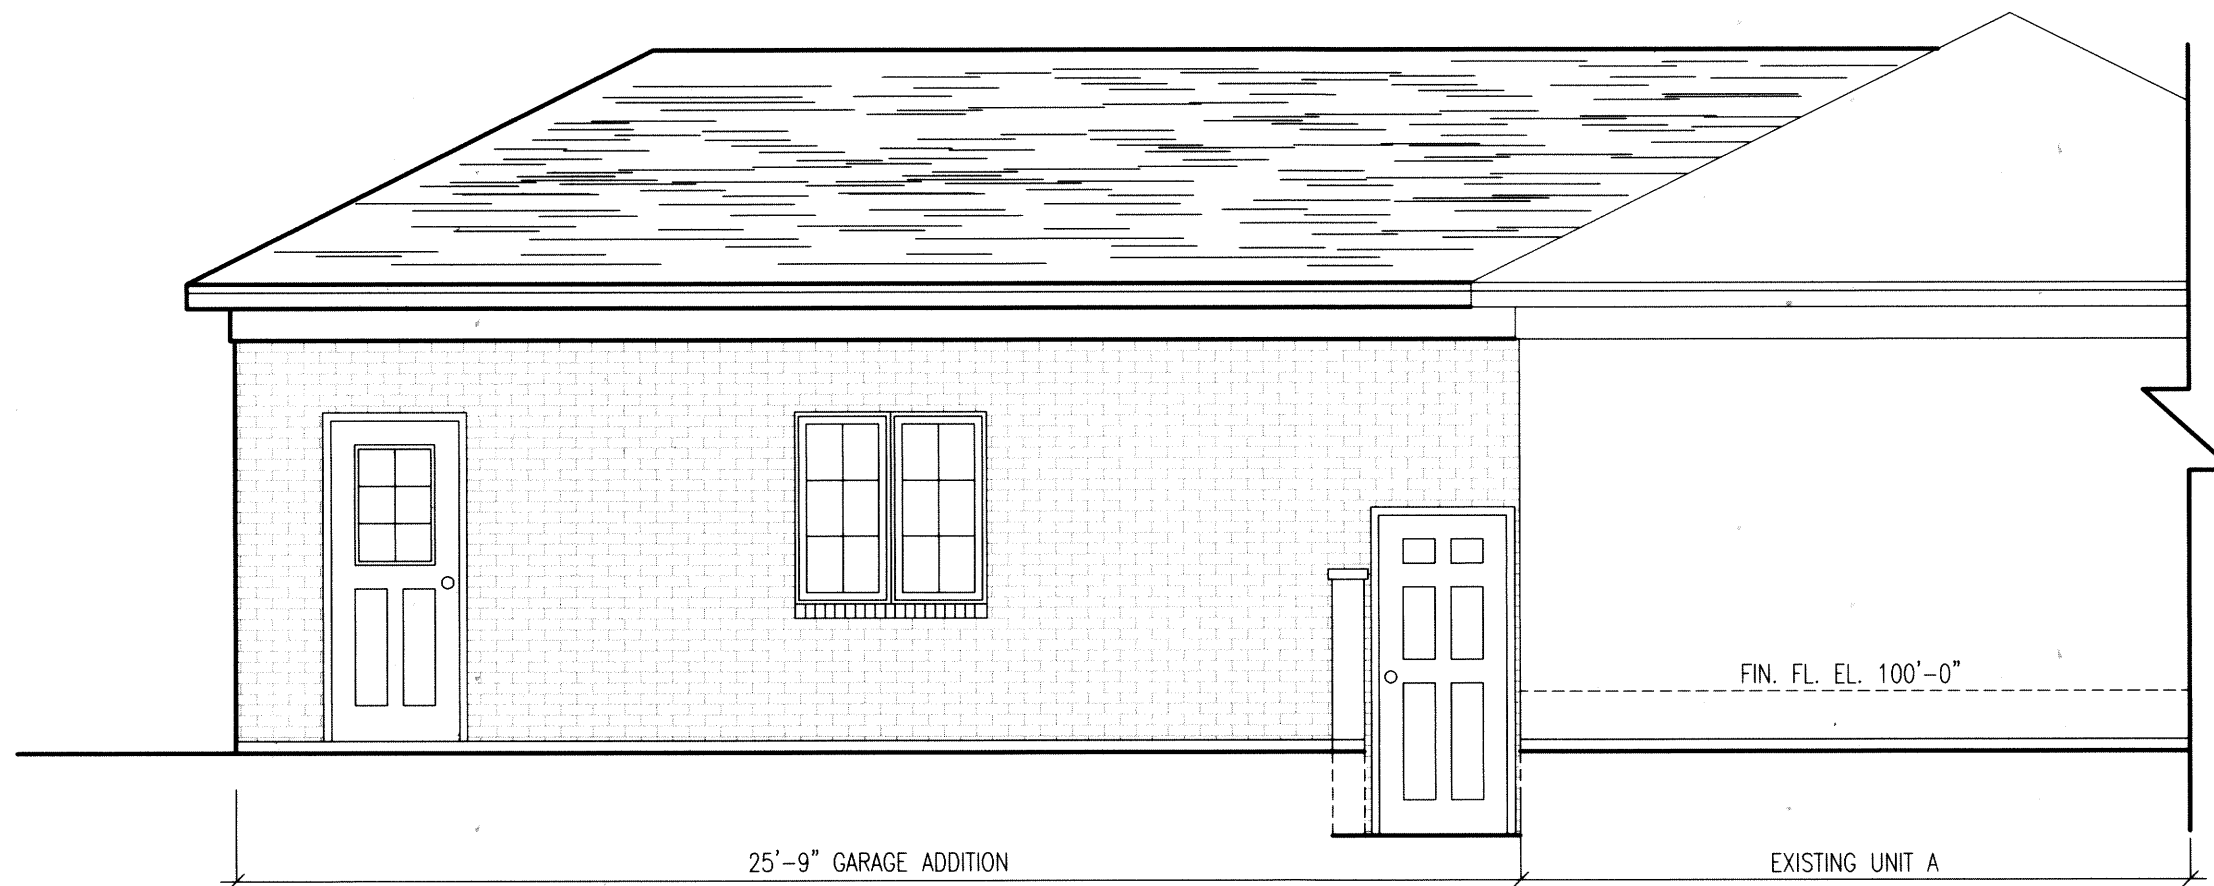

SOUTH ELEVATION

Scale: 1/4"=1'-0"

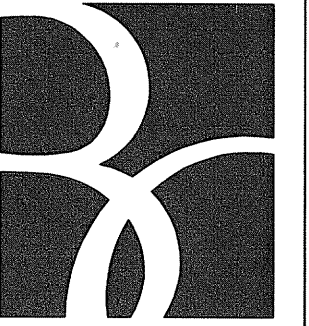

BAUMER
CONSTRUCTION, INC.

285 SOUTH OHIO STREET
P.O. BOX 3
MINSTER, OHIO 45865
PHONE: 419-628-3364
FAX: 419-628-2911
www.baumerconstruction.com

AMENDMENT TO
HANOVER PLACE CONDOMINIUM DRAWINGS

ROOF PLAN

REVISIONS

PROJECT NUMBER

--

DRAWN BY

DJS


DATE

10-3-11


DRAWING NUMBER

HP-3


LEGEND

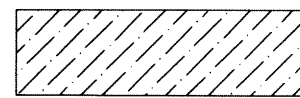


— ROOF TO UNIT A

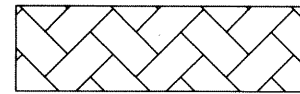

— ROOF TO UNIT B

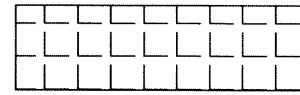

— ROOF TO UNIT C

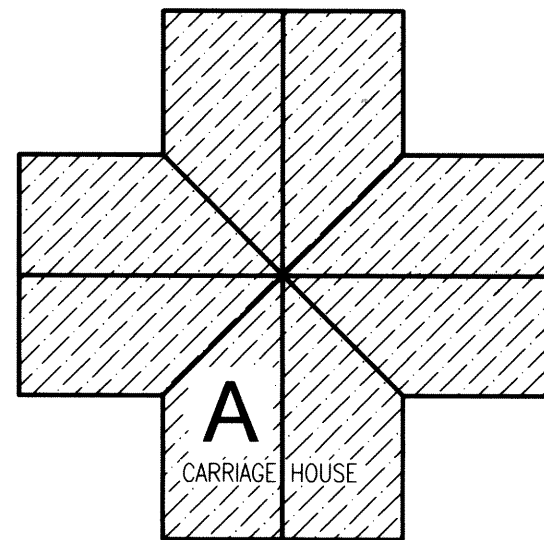



A

CARRIAGE HOUSE

A

B

C

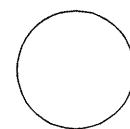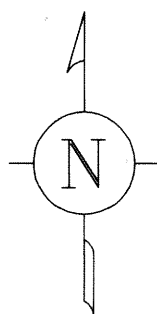

CONDOMINIUM ROOF PLAN

Scale: 1/8"=1'-0"