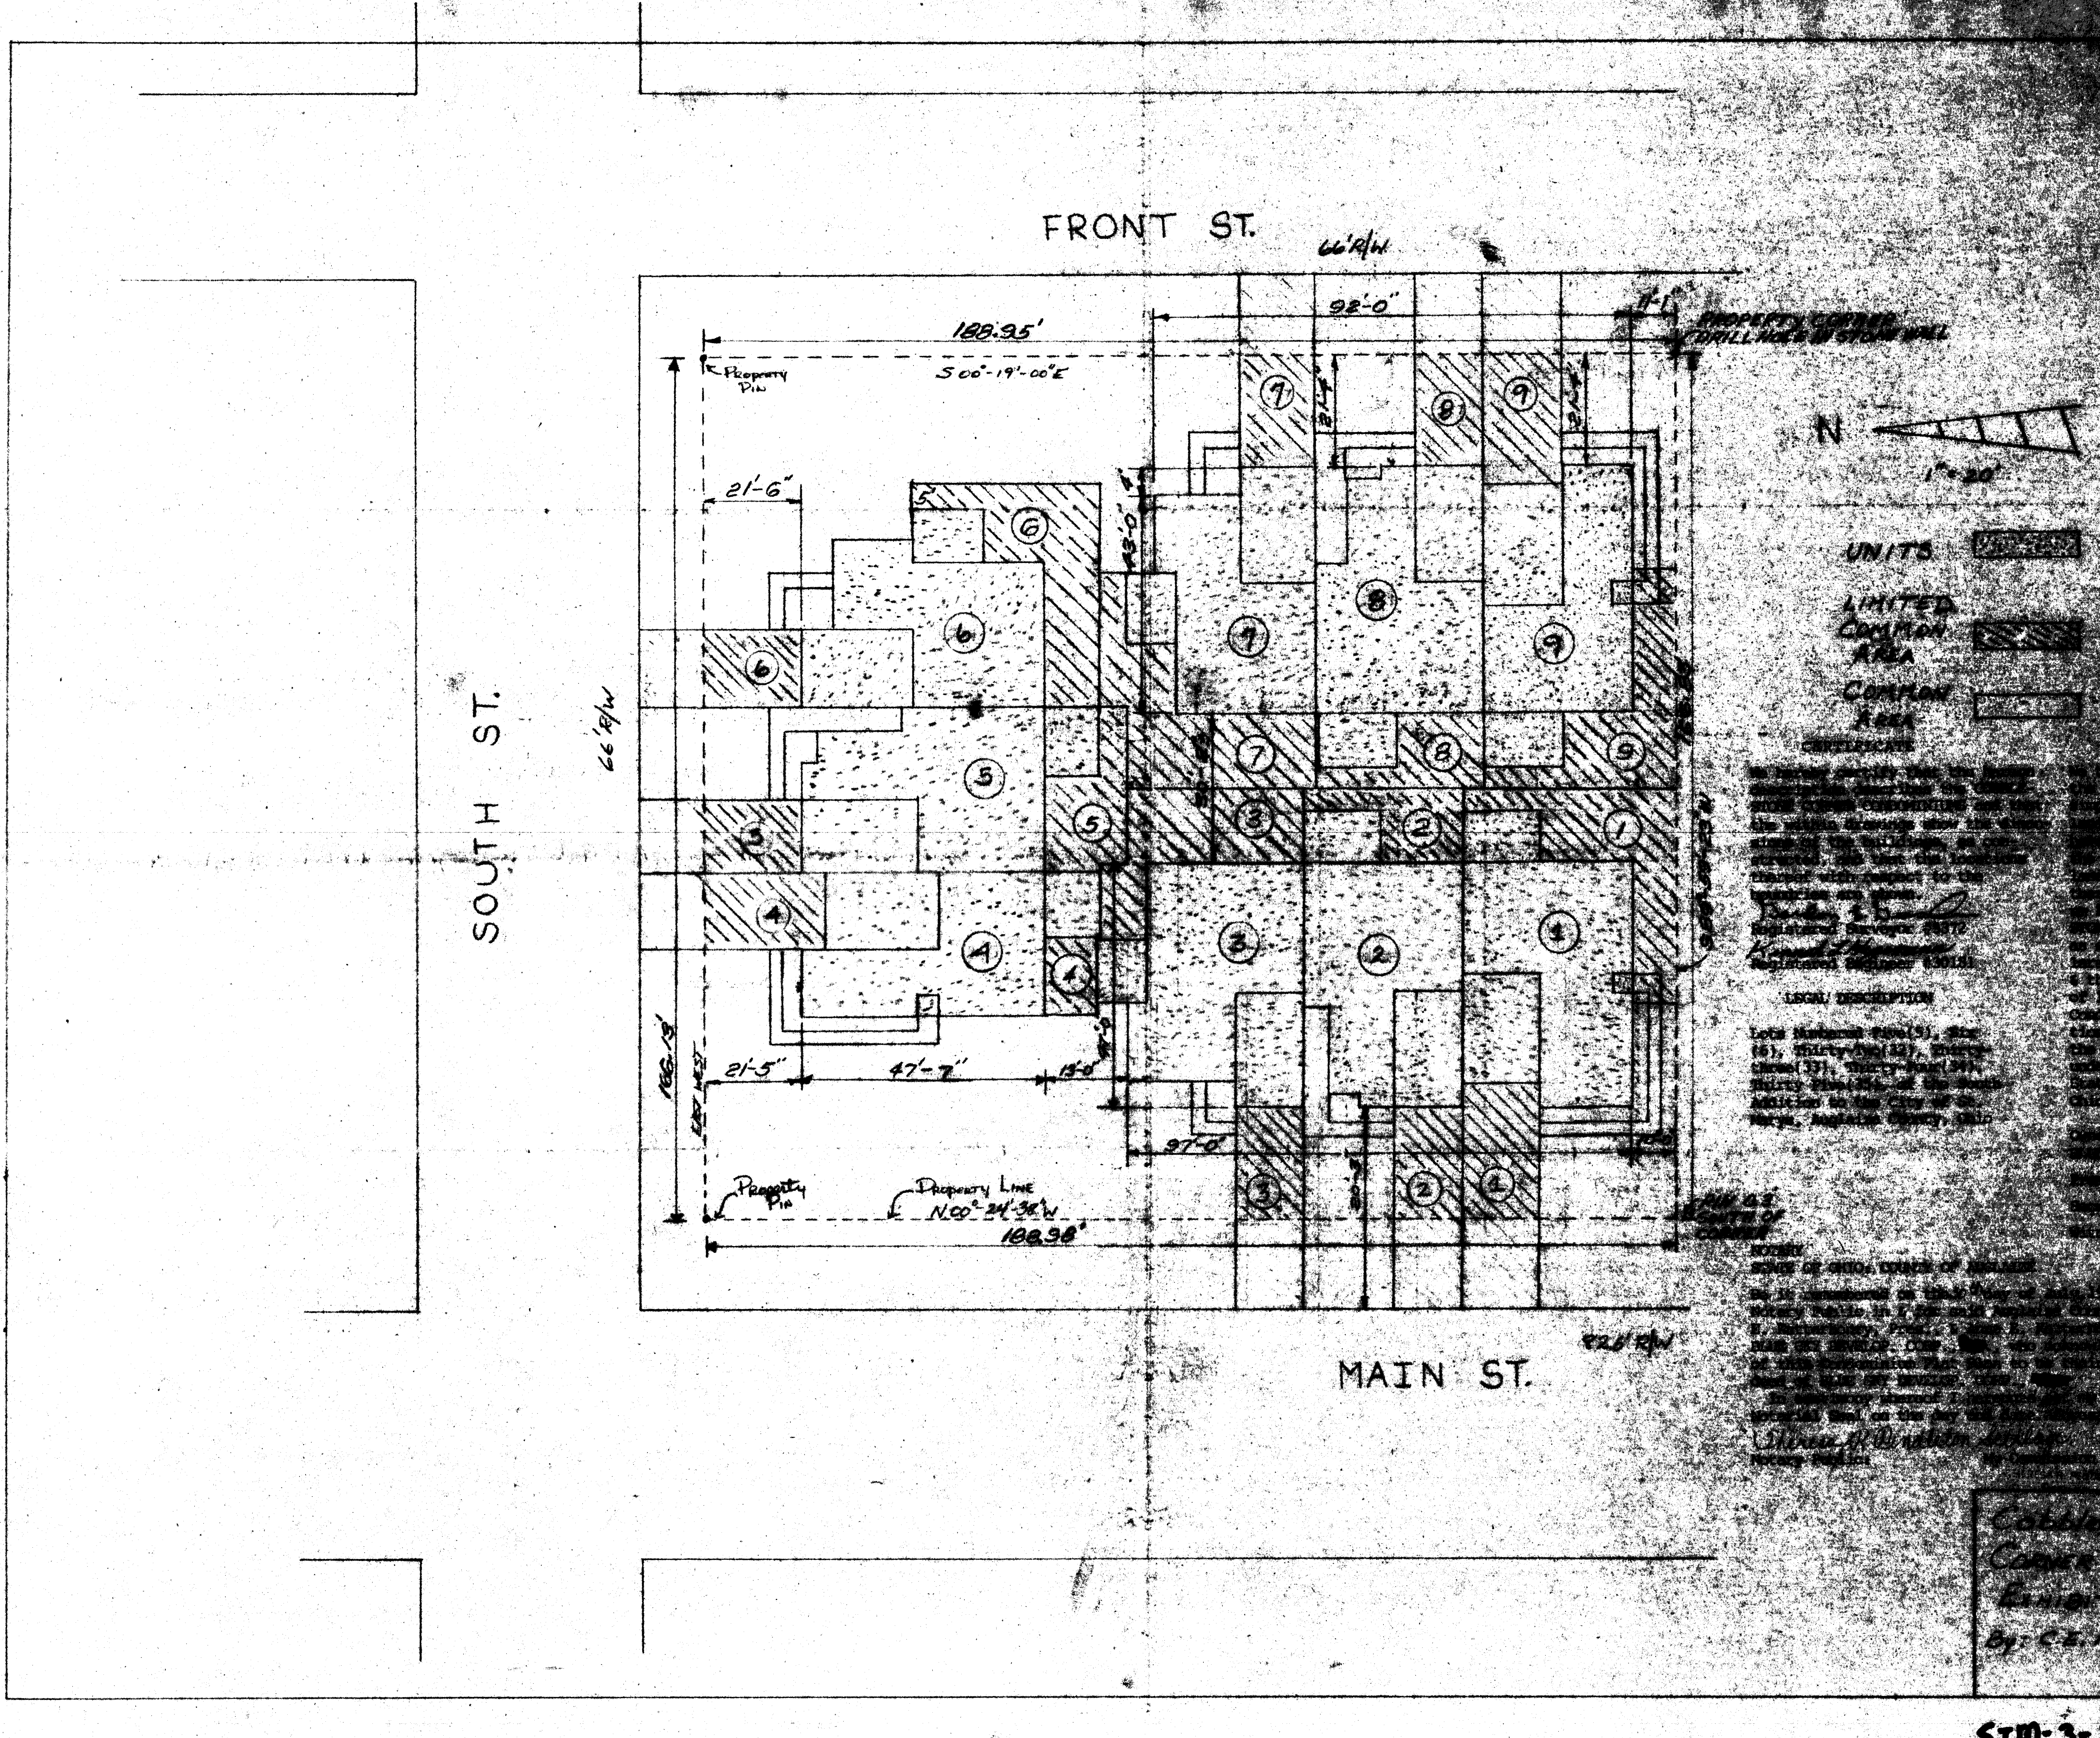
FRONT ST.
66'R/W
SOUTH ST.
66'R/W
MAIN ST.
66'R/W
188.95'
S 00°-19'-00"E
Property Pin
92'-0"
1'-1"
PROPERTY CORNER DRILL HOLE IN STONE WALL
21'-6"
43'-0"
4'
2'-4"
2'-4"
166.13'
EAST WEST
21'-5"
47'-7"
15'-0"
97'-0"
Property Pin
Property Line N00°-24'-38"W
188.98'
PIN 0.3 SOUTH OF CORNER
1
2
3
4
5
6
7
8
9
N
1"=20'
UNITS
LIMITED COMMON AREA
COMMON AREA

CERTIFICATE

We hereby certify that the foregoing description describes the COBBLESTONE CORNER CONDOMINIUM and that the within drawings show the dimensions of the buildings, as constructed, and that the location thereof with respect to the boundaries are shown.

[illegible]
Registered Surveyor #5372
Kenneth [illegible]
Registered Engineer #30181

LEGAL DESCRIPTION

Lots Numbered Five(5), Six(6), Thirty-Two(32), Thirty-three(33), Thirty-Four(34), Thirty Five(35), of the South Addition to the City of St. Marys, Auglaize County, Ohio

[illegible] Ohio.

Owner

[illegible]

NOTARY
STATE OF OHIO, COUNTY OF AUGLAIZE

Be it remembered on this [illegible] day of [illegible] Notary Public in & for said Auglaize County, [illegible]

[illegible]
Notary Public
My Commission Expires

Cobblestone
Corner Condominium
Exhibit "C"
By: C.E. FARLEY [illegible]

STM-3-13

3